ANNEXED
VOL. 1
A - E
1925

✓780
1760

6

N. DISTRICT 6

PORTION OF CITY

EAST OF 31ST STREET & NORTH OF "H" STREET.
Scale: 1 Inch = 500 feet.

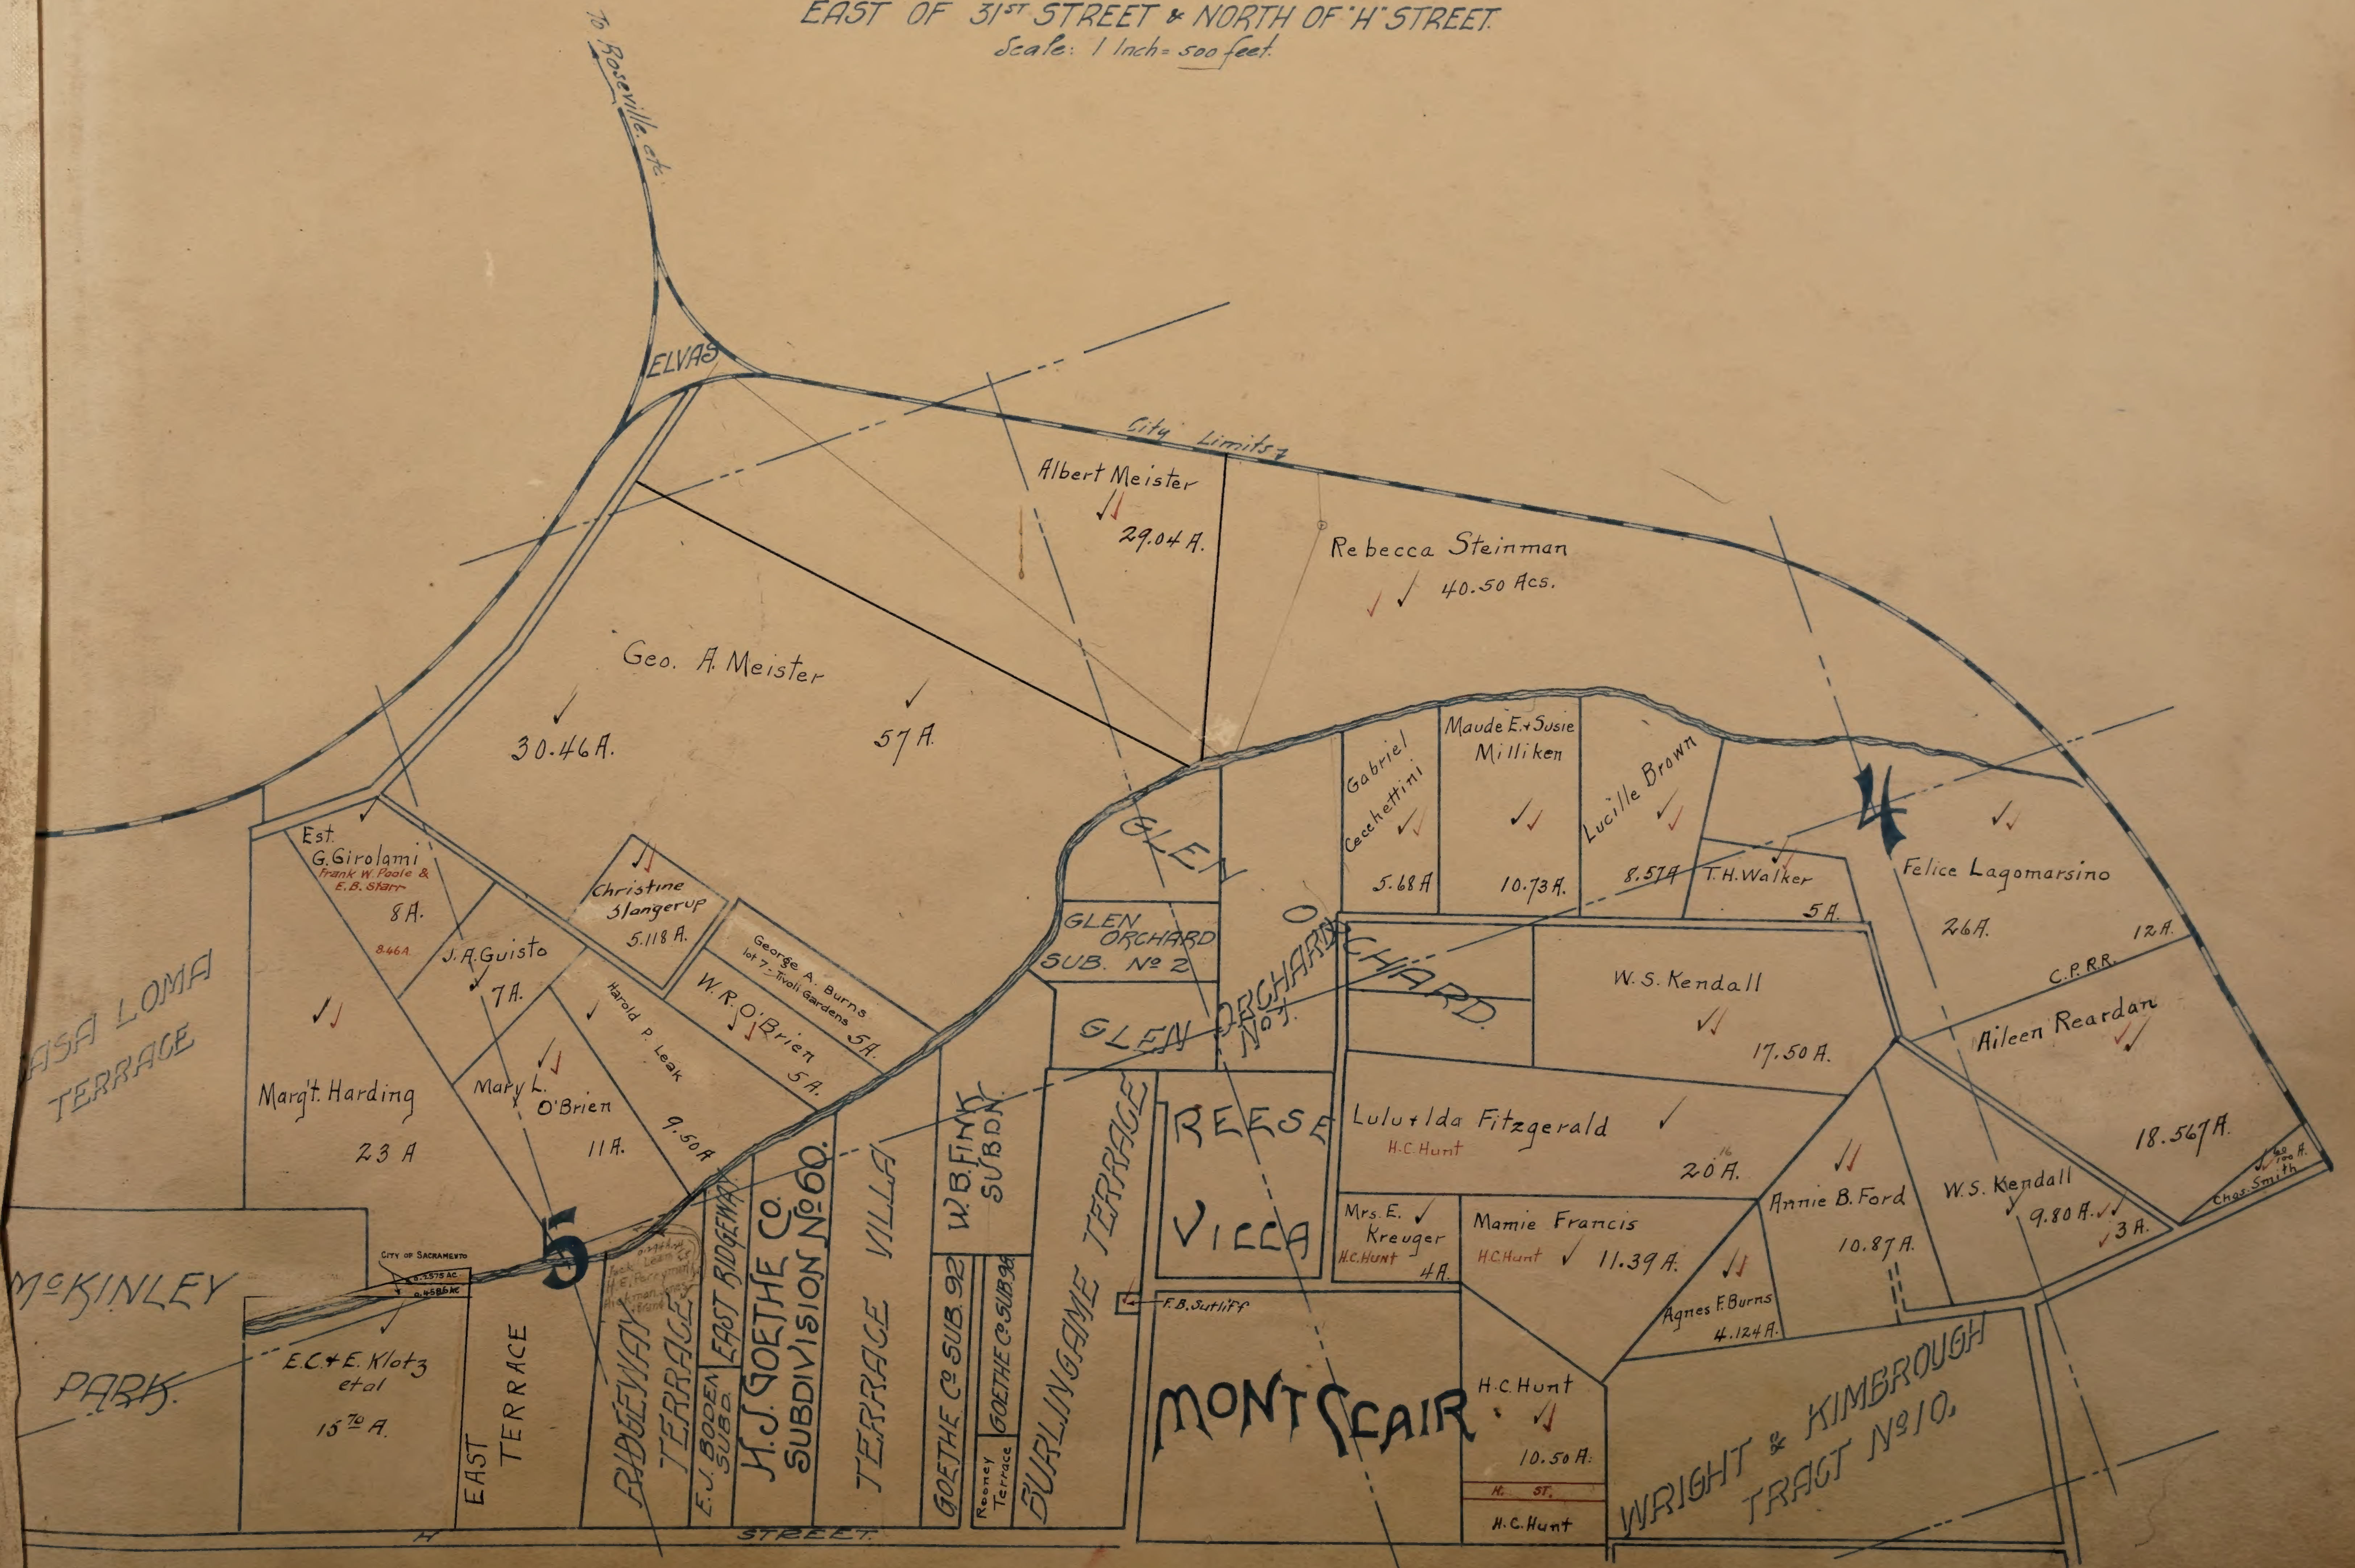
To Roseville etc.
ELVAS
City Limits
Albert Meister
29.04 A.
Rebecca Steinman
40.50 Acs.
Geo. A. Meister
30.46 A.
57 A.
Est. G. Girolami
Frank W. Poole & E.B. Starr
8 A.
8.46 A.
J. A. Guisto
7 A.
Christine Slangerup
5.118 A.
George A. Burns lot 7 - Tivoli Gardens
5 A.
W. R. O'Brien
5 A.
Harold P. Leak
9.50 A
Mary L. O'Brien
11 A.
Marg't. Harding
23 A
CASA LOMA TERRACE
McKINLEY PARK
City of Sacramento
0.2575 AC
0.4586 AC
E.C. & E. Klotz et al
15 70 A.
EAST TERRACE
5
Jack Lean Co. H. E. Perryman Hickman, Jones & Brand
RIDGEWAY TERRACE
E. J. BODEN SUBD.
EAST RIDGEWAY
H. J. GOETHE CO. SUBDIVISION No 60.
TERRACE VILLA
W. B. FINK SUBDN.
GOETHE Co SUB. 92
GOETHE Co SUB 94
Rooney Terrace
BURLINGAME TERRACE
GLEN ORCHARD SUB. No 2
GLEN ORCHARD No 1
REESE VILLA
F. B. Sutliff
MONT CLAIR
Gabriel Cecchettini
5.68 A
Maude E. & Susie Milliken
10.73 A.
Lucille Brown
8.57 A
T. H. Walker
5 A.
4
Felice Lagomarsino
26 A.
12 A.
C. P. R.R.
W. S. Kendall
17.50 A.
Aileen Reardan
18.567 A.
Lulu & Ida Fitzgerald
H. C. Hunt
20 16 A.
Mrs. E. Kreuger
H.C. Hunt
4 A.
Mamie Francis
H.C. Hunt
11.39 A.
Annie B. Ford
10.87 A.
W. S. Kendall
9.80 A.
3 A.
60/100 A.
Chas. Smith
Agnes F. Burns
4.124 A.
H. C. Hunt
10.50 A.
H. ST.
H. C. Hunt
WRIGHT & KIMBROUGH TRACT No 10.
H STREET.

City assessed lots N½ block H-I @ 900 ea
" S½ " H-I @ 700 ea
" N½ " I-J @ 700 ea
" S½ " I-J @ 1750 ea

100' = 1 inch

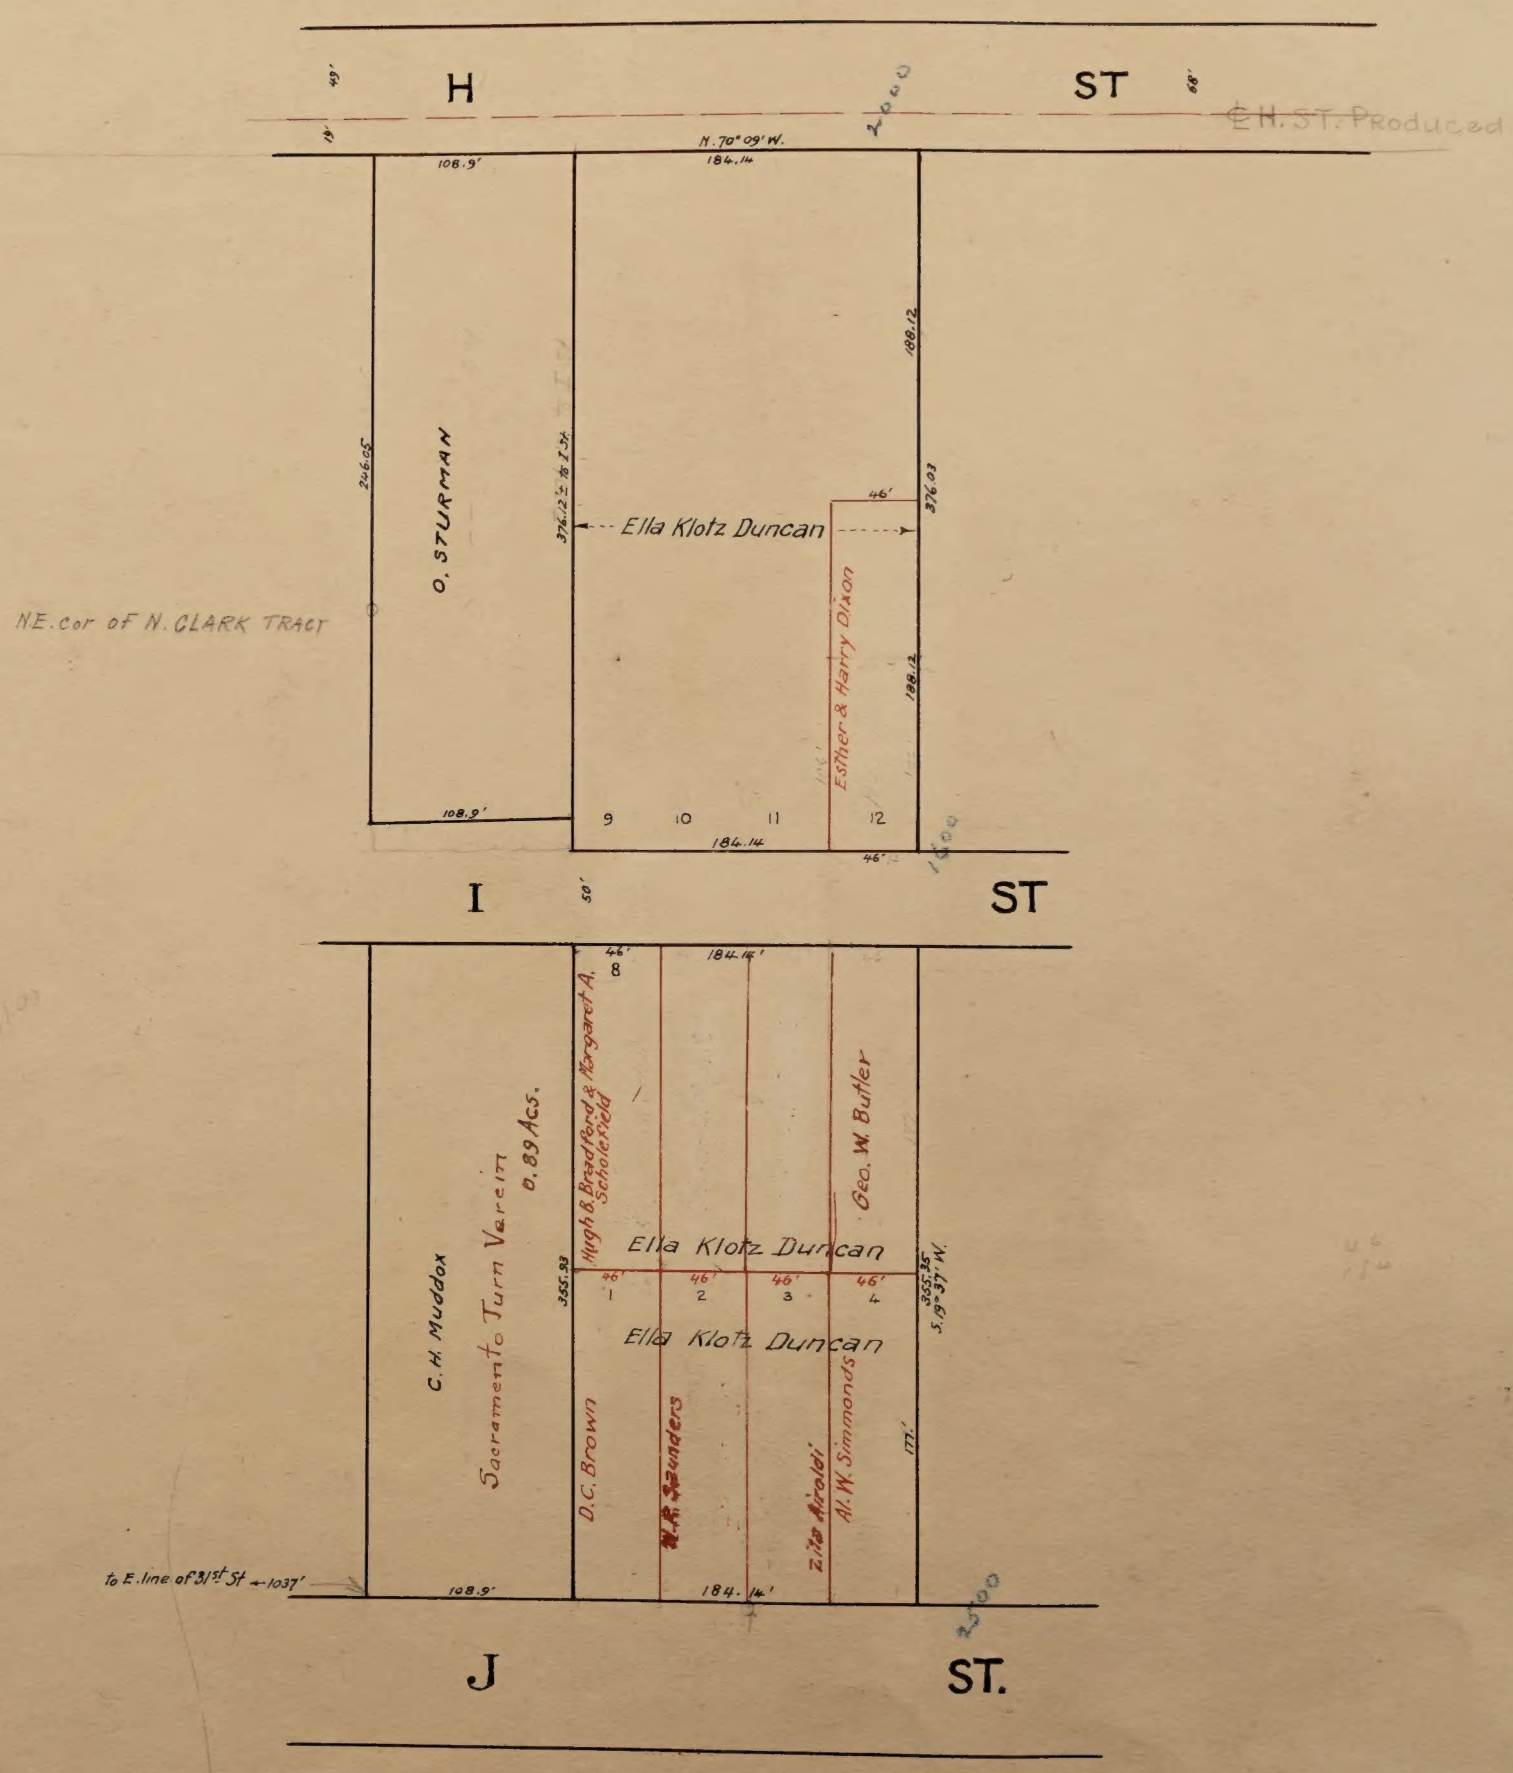
H ST
49'
19'
68'
2000
℄ H. ST. Produced
N. 70° 09' W.
184.14
108.9'
246.05
O. STURMAN
376.12 ± to I St.
Ella Klotz Duncan
46'
376.03
188.12
188.12
Esther & Harry Dixon
NE. cor of N. CLARK TRACT
108.9'
9
10
11
12
184.14
46'
1600
I ST
50'
46'
8
184.14'
C. H. Muddox
Sacramento Turn Verein
0.89 Acs.
Hugh B. Bradford & Margaret A. Scholefield
Geo. W. Butler
Ella Klotz Duncan
355.93
46'
46'
46'
46'
1
2
3
4
355.35
S. 19° 37' W.
Ella Klotz Duncan
D. C. Brown
W. R. Saunders
Zita Airoldi
Al. W. Simmonds
177'
To E. line of 31st St ← 1037'
108.9'
184.14'
2500
J ST.

1191.00

1037

86

3

6

N. DISTRICT 6

PORTION OF CITY

Scale: 1 Inch = 500 feet.

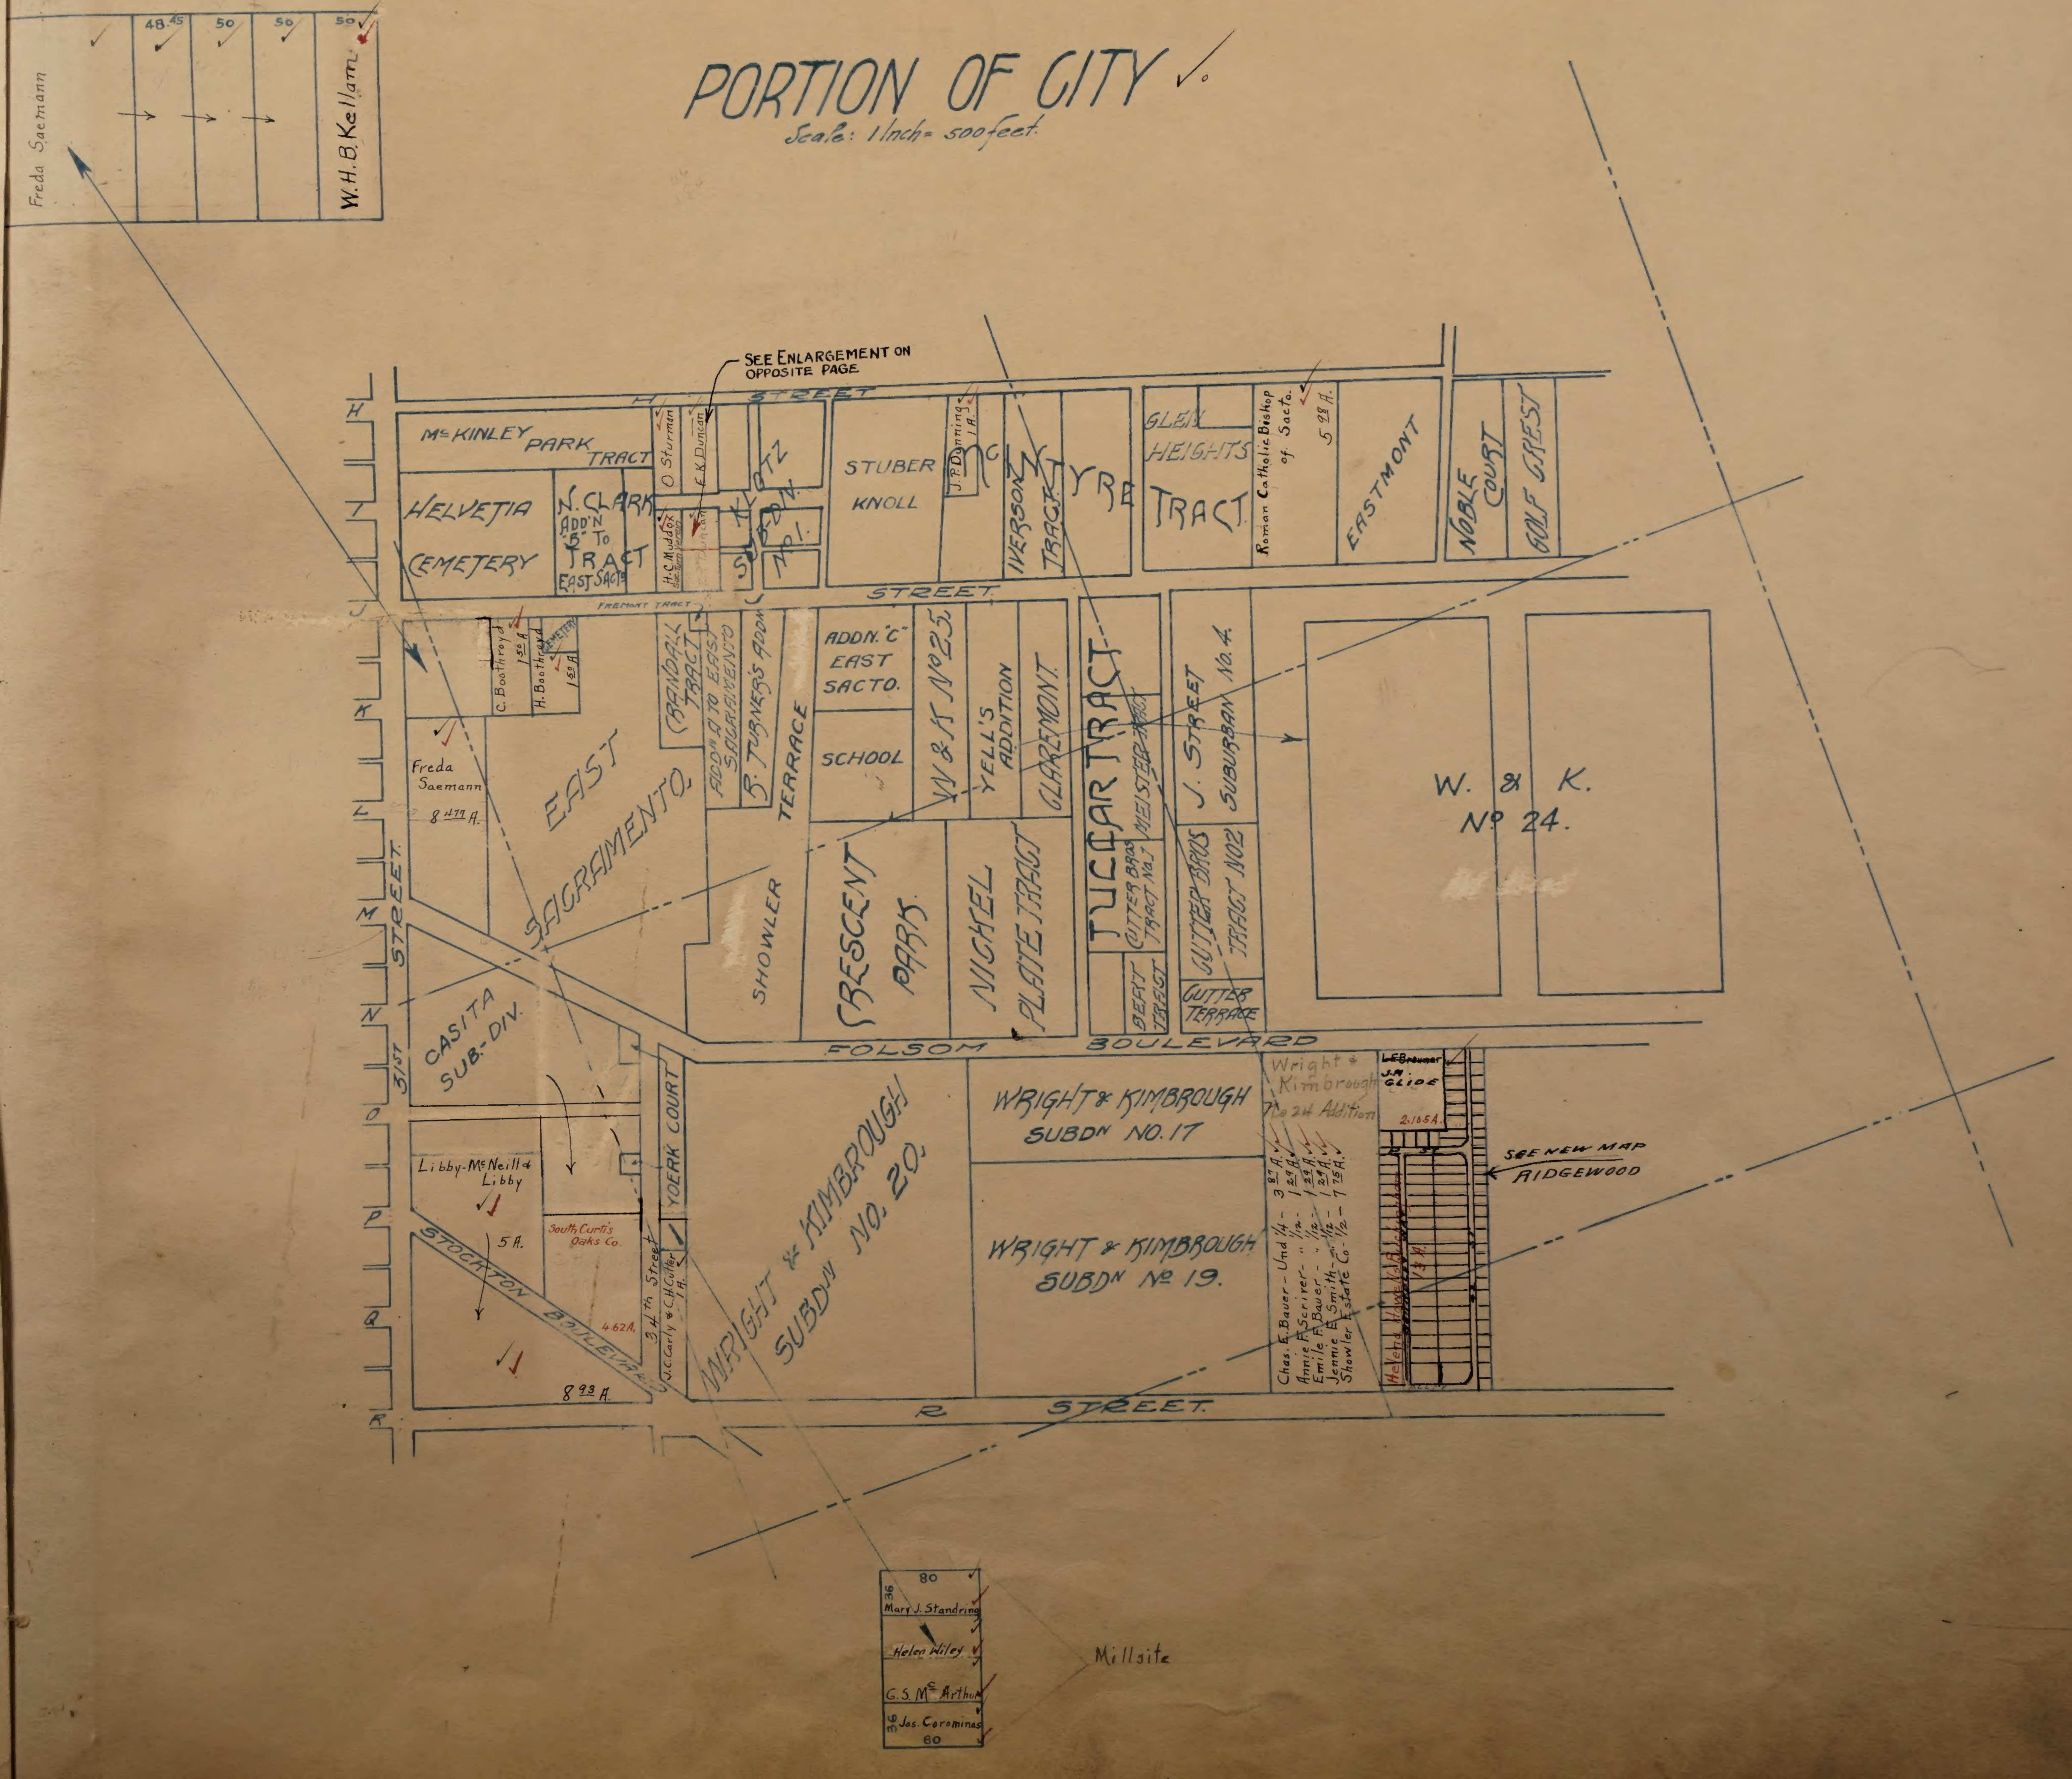
Freda Saemann
48.45
50
50
50
W. H. B. Kellam
SEE ENLARGEMENT ON OPPOSITE PAGE
H STREET
McKINLEY PARK TRACT
HELVETIA CEMETERY
N. CLARK ADD'N "B" TO TRACT EAST SACTO
O. Sturmin
E. K. Duncan
H. C. Muddox
Sac. Turn Verein
KURTZ SUBD'N No. 1
STUBER KNOLL
J. P. Dunning 1 A.
McINTYRE TRACT
IVERSON TRACT
GLEN HEIGHTS TRACT
Roman Catholic Bishop of Sacto.
5 28 A.
EASTMONT
NOBLE COURT
GOLF CREST
J STREET
FREMONT TRACT
C. Boothroyd
1 50 A
H. Boothroyd
CEMETERY
1 50 A
Freda Saemann
8 477 A.
EAST SACRAMENTO
CRANDALL TRACT
ADD'N "A" TO EAST SACRAMENTO
R. TURNER'S ADD'N
TERRACE
ADDN. "C" EAST SACTO.
SCHOOL
W & K No 25
YELL'S ADDITION
CLAREMONT
TUCCAR TRACT
MEISTER TRACT
CUTTER BROS TRACT No 1
BERT TRACT
J. STREET SUBURBAN No. 4
CUTTER BROS TRACT No 2
CUTTER TERRACE
W. & K. No 24.
SHOWLER
CRESCENT PARK
NICKEL PLATE TRACT
K
L
M
N
O
P
Q
R
31st STREET
CASITA SUB-DIV.
FOLSOM BOULEVARD
Libby-McNeill & Libby
5 A.
South Curtis Oaks Co.
4 62 A.
STOCKTON BOULEVARD
8 93 A.
34th Street
J. C. Carly & C. H. Cutter 1 A.
YOERK COURT
WRIGHT & KIMBROUGH SUBD'N NO. 20.
WRIGHT & KIMBROUGH SUBD'N NO. 17
WRIGHT & KIMBROUGH SUBD'N No 19.
Wright & Kimbrough Co 24 Addition
Chas. E. Bauer - Und 1/4 - 3 87 A.
Annie F. Scriver - " 1/12 - 1 29 A.
Emile F. Bauer - " 1/12 - 1 29 A.
Jennie E. Smith - " 1/12 - 1 29 A.
Showler Estate Co - 1/2 - 7 75 A.
L. E. Brauner
J. M. GLIDE
2.165 A.
Helvetia Home Nursery Add'n
13 A.
SEE NEW MAP RIDGEWOOD
R STREET
80
36
Mary J. Standring
Helen Wiley
G. S. McArthur
Jos. Coromina
36
60
Millsite

4

6

N. DISTRICT 6

PORTION OF CITY ✓.

Scale: 1 Inch = 500 feet

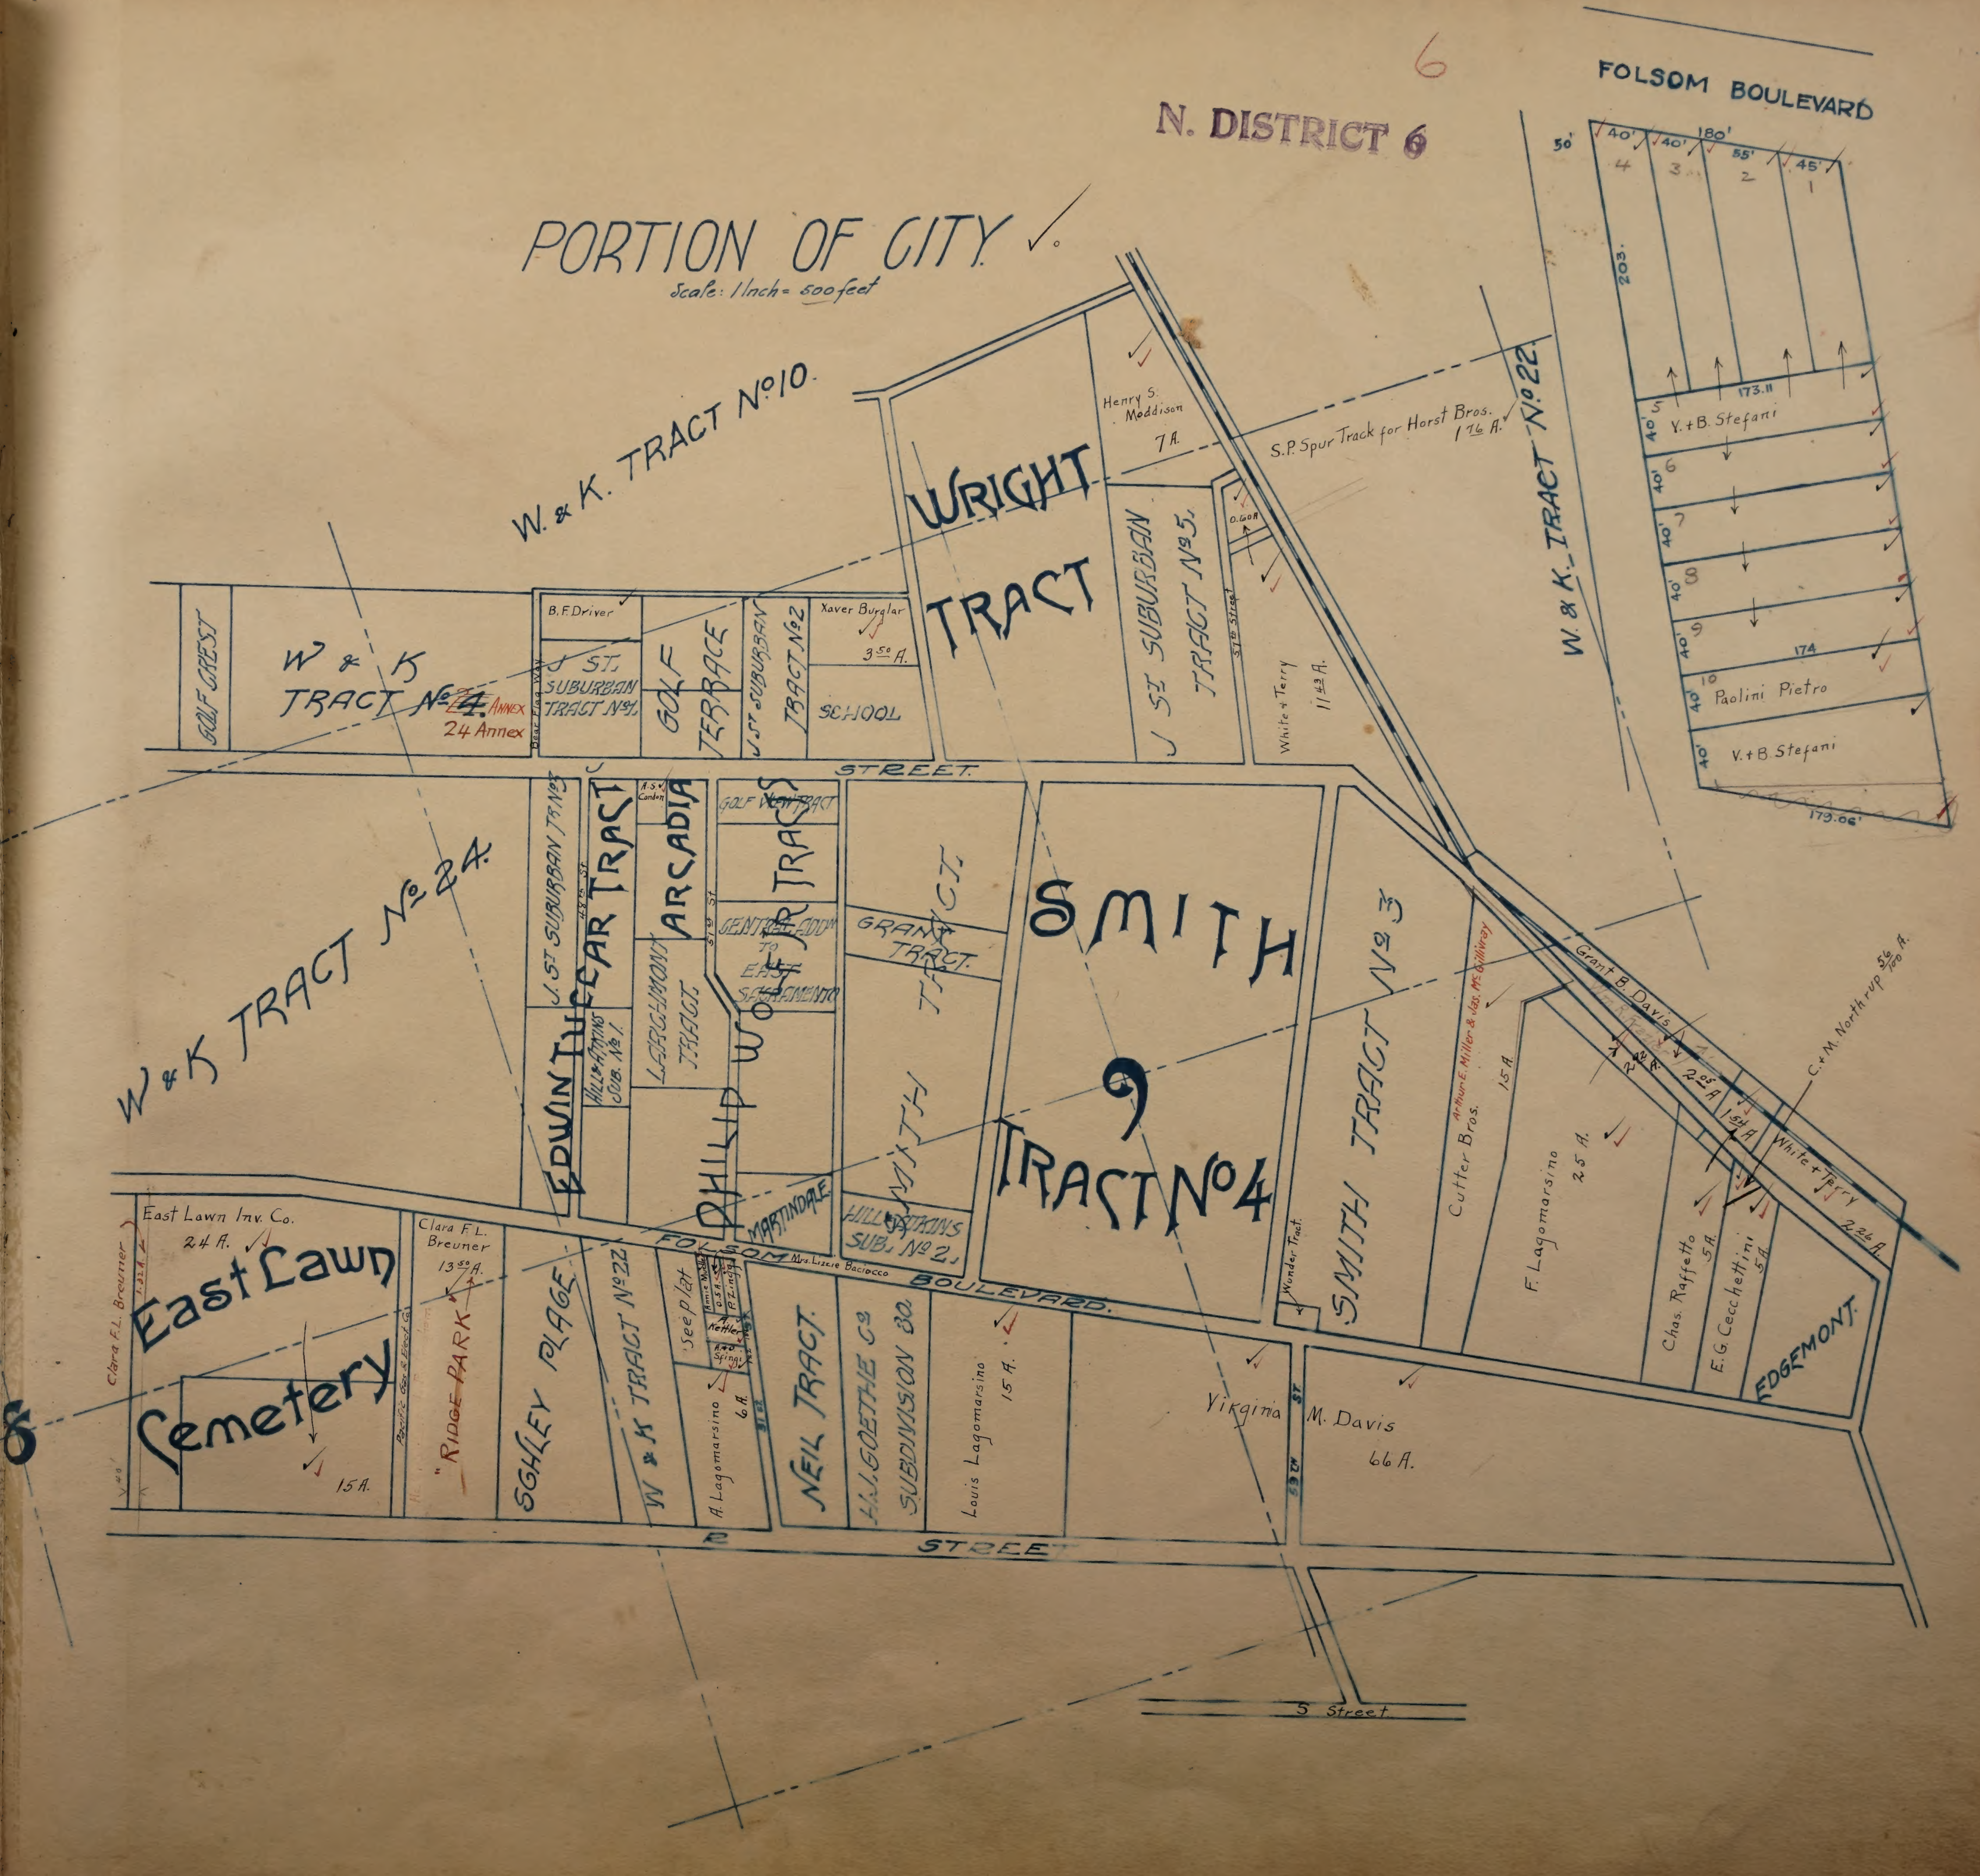
FOLSOM BOULEVARD
50'
40'
40'
180'
55'
45'
4
3
2
1
203.
173.11
5
Y. + B. Stefani
6
7
8
9
174
10
Paolini Pietro
V. + B. Stefani
40'
173.06'
W. & K. TRACT No. 22.
Henry S. Maddison
7 A.
S.P. Spur Track for Horst Bros.
1 76 A.
D. 60 A.
WRIGHT TRACT
J ST. SUBURBAN TRACT No. 5.
57th Street
White + Terry
11 43 A.
W. & K. TRACT No. 10.
GOLF CREST
W & K TRACT No. 24.
24 Annex
24 Annex
Bear Flag Way
B. F. Driver
J ST. SUBURBAN TRACT No. 1.
GOLF TERRACE
J ST. SUBURBAN TRACT No. 2
Xaver Burglar
3 50 A.
SCHOOL
J
STREET.
A.S. Condon
GOLF VIEW TRACT
J. ST. SUBURBAN TR. No. 3
48th St.
EDWIN TUCEAR TRACT
ARCADIA
51st St.
CENTRAL ADDN TO EAST SACRAMENTO
PHILIP WOLF JR TRACT
GRANT TRACT.
SMITH TRACT.
HILL & ATKINS SUB. No. 1.
LARCHMONT TRACT
W & K TRACT No. 24.
SMITH 9 TRACT No. 4
SMITH TRACT No. 3
Arthur E. Miller & Jas. McGillivray
Cutter Bros.
15 A.
Grant B. Davis
C. + M. Northrup 56/100 A.
2 25 A.
2 25 A.
1 54 A.
White + Terry
2 26 A.
F. Lagomarsino
25 A.
Chas. Raffetto
5 A.
E. G. Cecchettini
5 A.
EDGEMONT.
Wonder Tract.
MARTINDALE.
HILL & ATKINS SUB. No. 2.
Mrs. Lizzie Baciocco
FOLSOM BOULEVARD.
East Lawn Inv. Co.
24 A.
Clara F. L. Breuner
1.32 A.
Clara F. L. Breuner
13 50 A.
East Lawn Cemetery
15 A.
Pacific Gas & Elect. Co.
"RIDGE PARK"
SCHLEY PLACE
W & K TRACT No. 22
See plat
Annie Mueller
O.S.A.
P. Zingg
A. Kettler
A. + O. Sfingi
A. Lagomarsino
6 A.
51st St.
NEIL TRACT.
H. J. GOETHE Co. SUBDIVISION 30.
Louis Lagomarsino
15 A.
Virginia M. Davis
66 A.
59th St.
R
STREET
S Street
8

S. DISTRICT 5

PORTION OF CITY ✓

Scale: 1 Inch = 500 feet

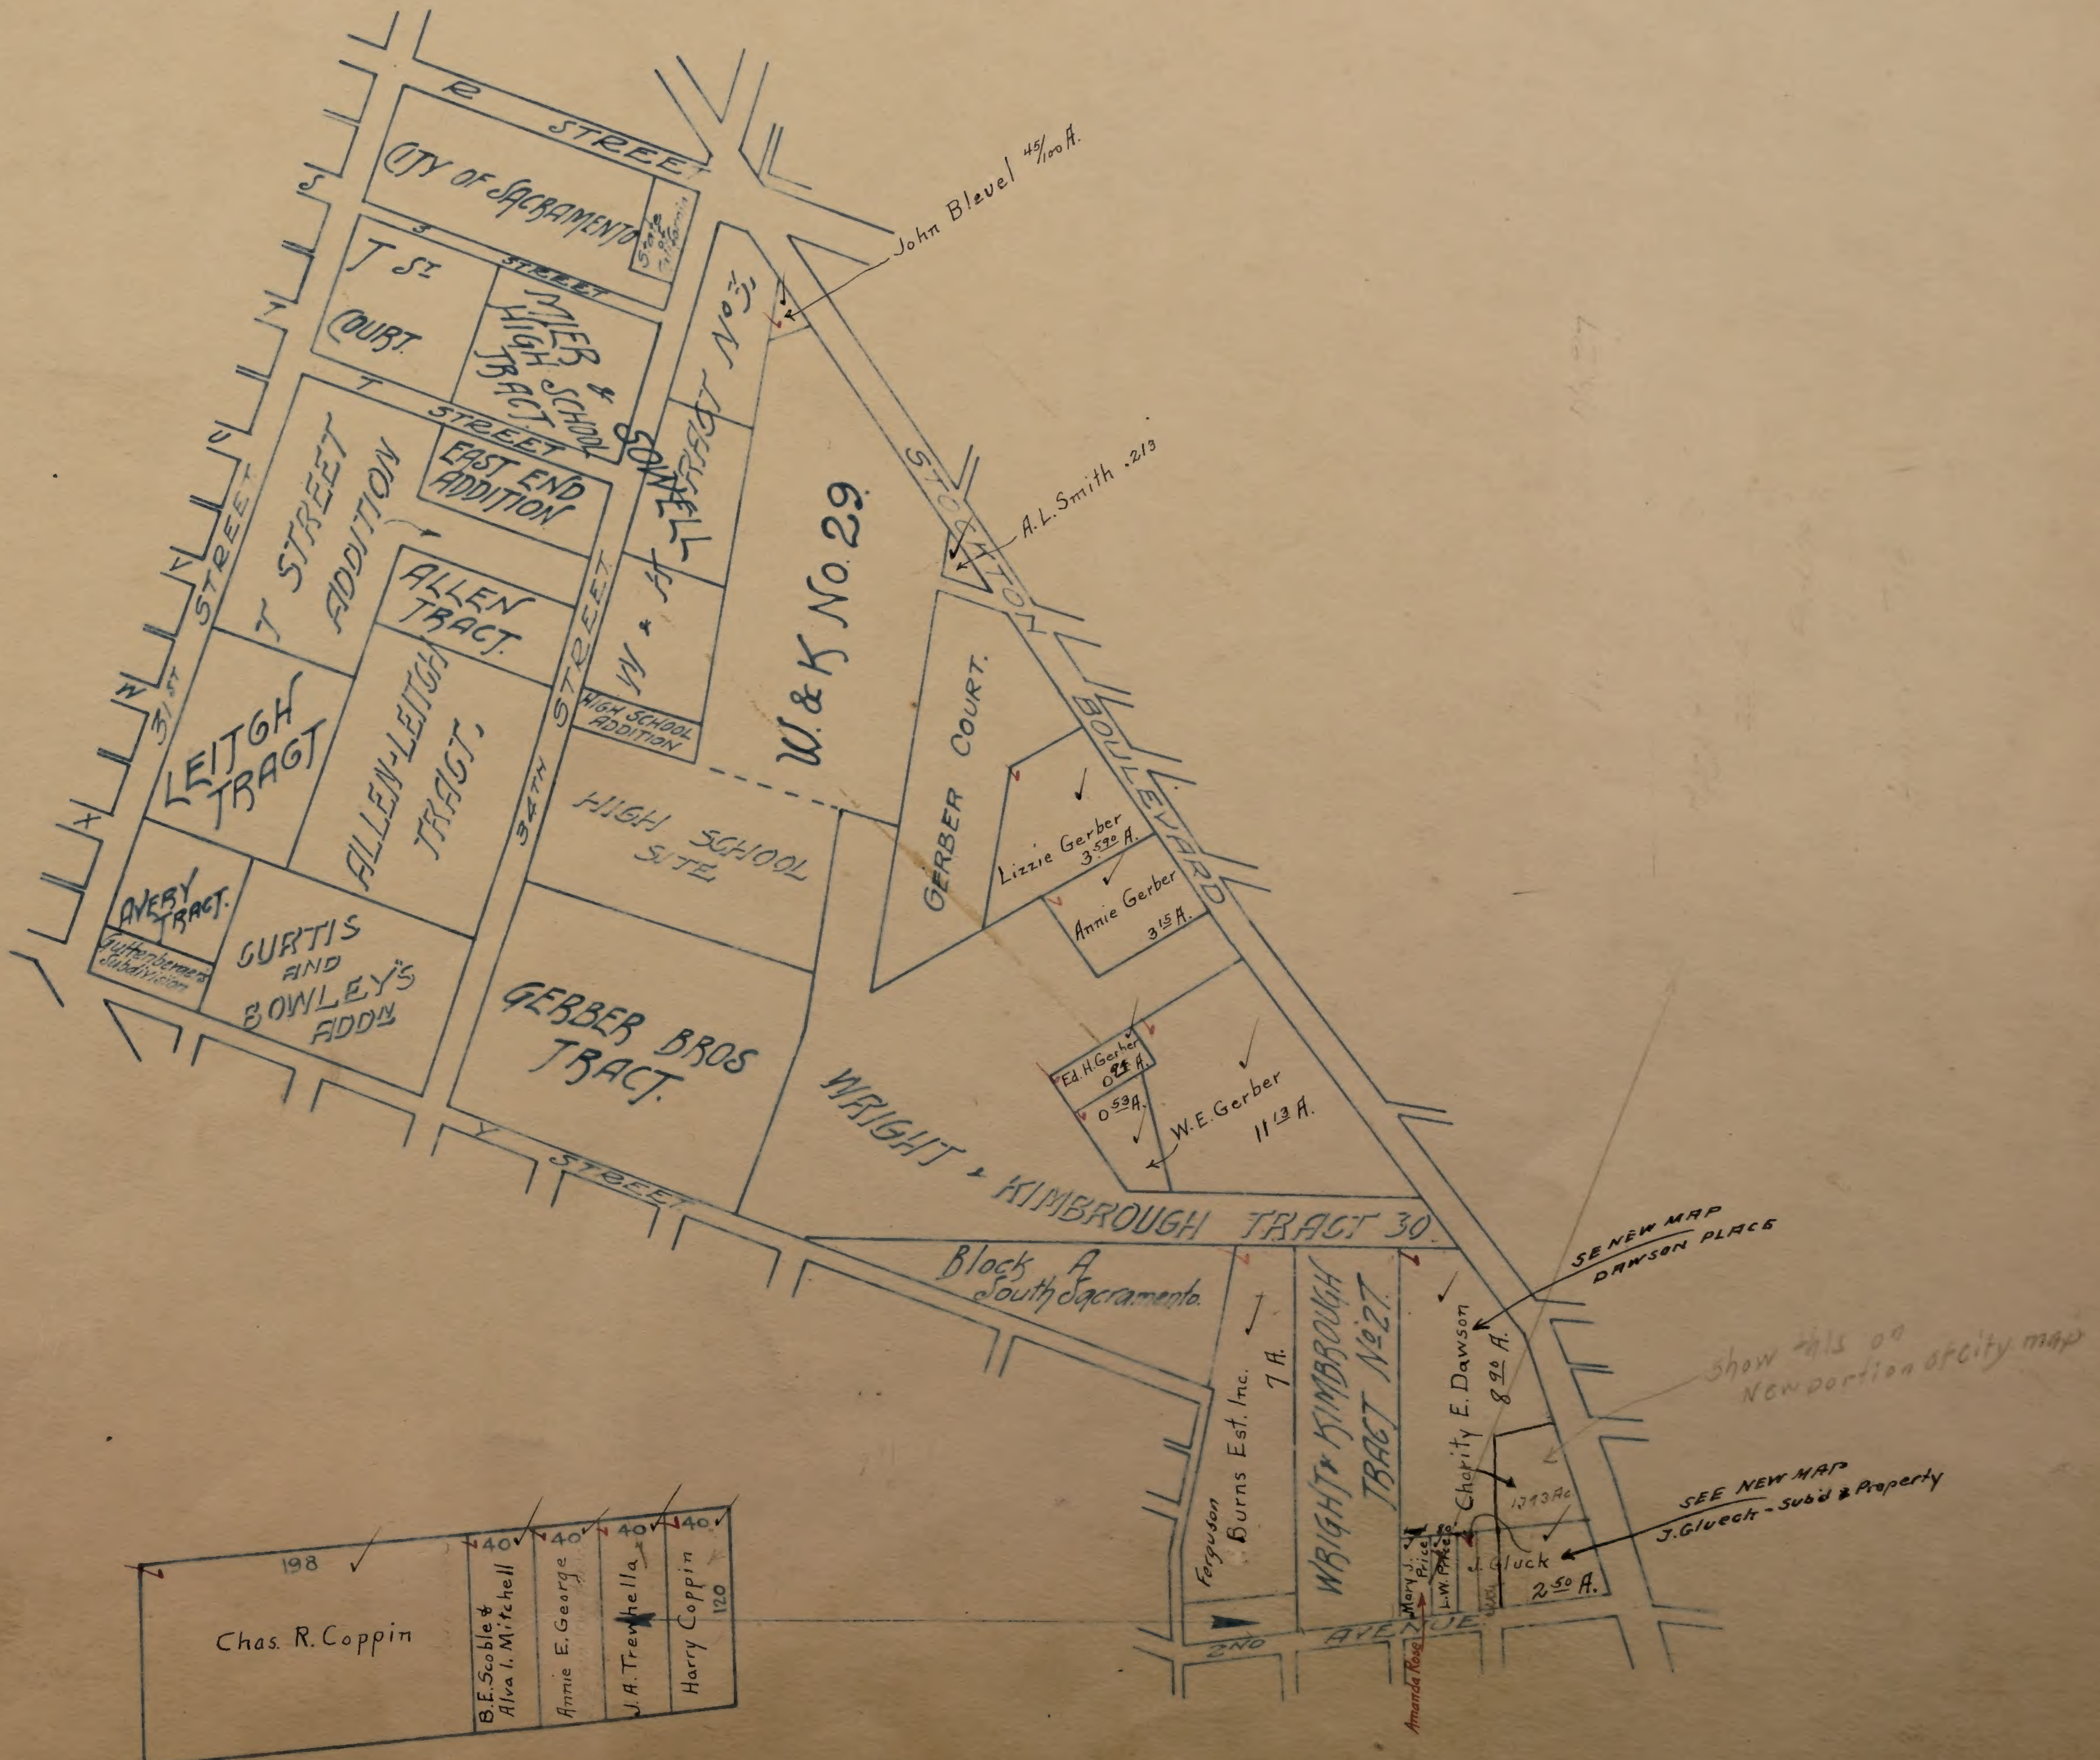
R STREET
S STREET
T STREET
Y STREET
31st STREET
34th STREET
STOCKTON BOULEVARD
2ND AVENUE
J
K
L
M
N
W
X
CITY OF SACRAMENTO
State of California
T St. COURT.
MAIER & HIGH SCHOOL TRACT.
SOUWELL
W & K TRACT No. 3
T STREET ADDITION
EAST END ADDITION
ALLEN TRACT.
W & K
HIGH SCHOOL ADDITION
W. & K. NO. 29.
John Bleuel 45/100 A.
A.L. Smith .213
GERBER COURT.
LEITCH TRACT
ALLEN-LEITCH TRACT.
HIGH SCHOOL SITE
Lizzie Gerber 3.50 A.
Annie Gerber 3.15 A.
AVERY TRACT.
Guttenberger Addition
CURTIS AND BOWLEY'S ADDN
GERBER BROS TRACT.
Ed. H. Gerber 0.94 A.
0.53 A.
W.E. Gerber 11.13 A.
WRIGHT & KIMBROUGH TRACT 30.
Block A South Sacramento.
Ferguson
Burns Est. Inc.
7 A.
WRIGHT & KIMBROUGH TRACT No. 27.
Charity E. Dawson 8.90 A.
SE NEW MAP DAWSON PLACE
Show this on New portion of city map
12.13 Ac.
SEE NEW MAP J. Glueck - Sub'd & Property
Mary J. Price
L.W. Price
J. Gluck 2.50 A.
Amanda Rose
198
40
40
40
40
120
Chas. R. Coppin
B.E. Scoble & Alva I. Mitchell
Annie E. George
J.A. Trewhella
Harry Coppin

PORTION OF CITY ✓

Scale: 1 inch = 660 feet.

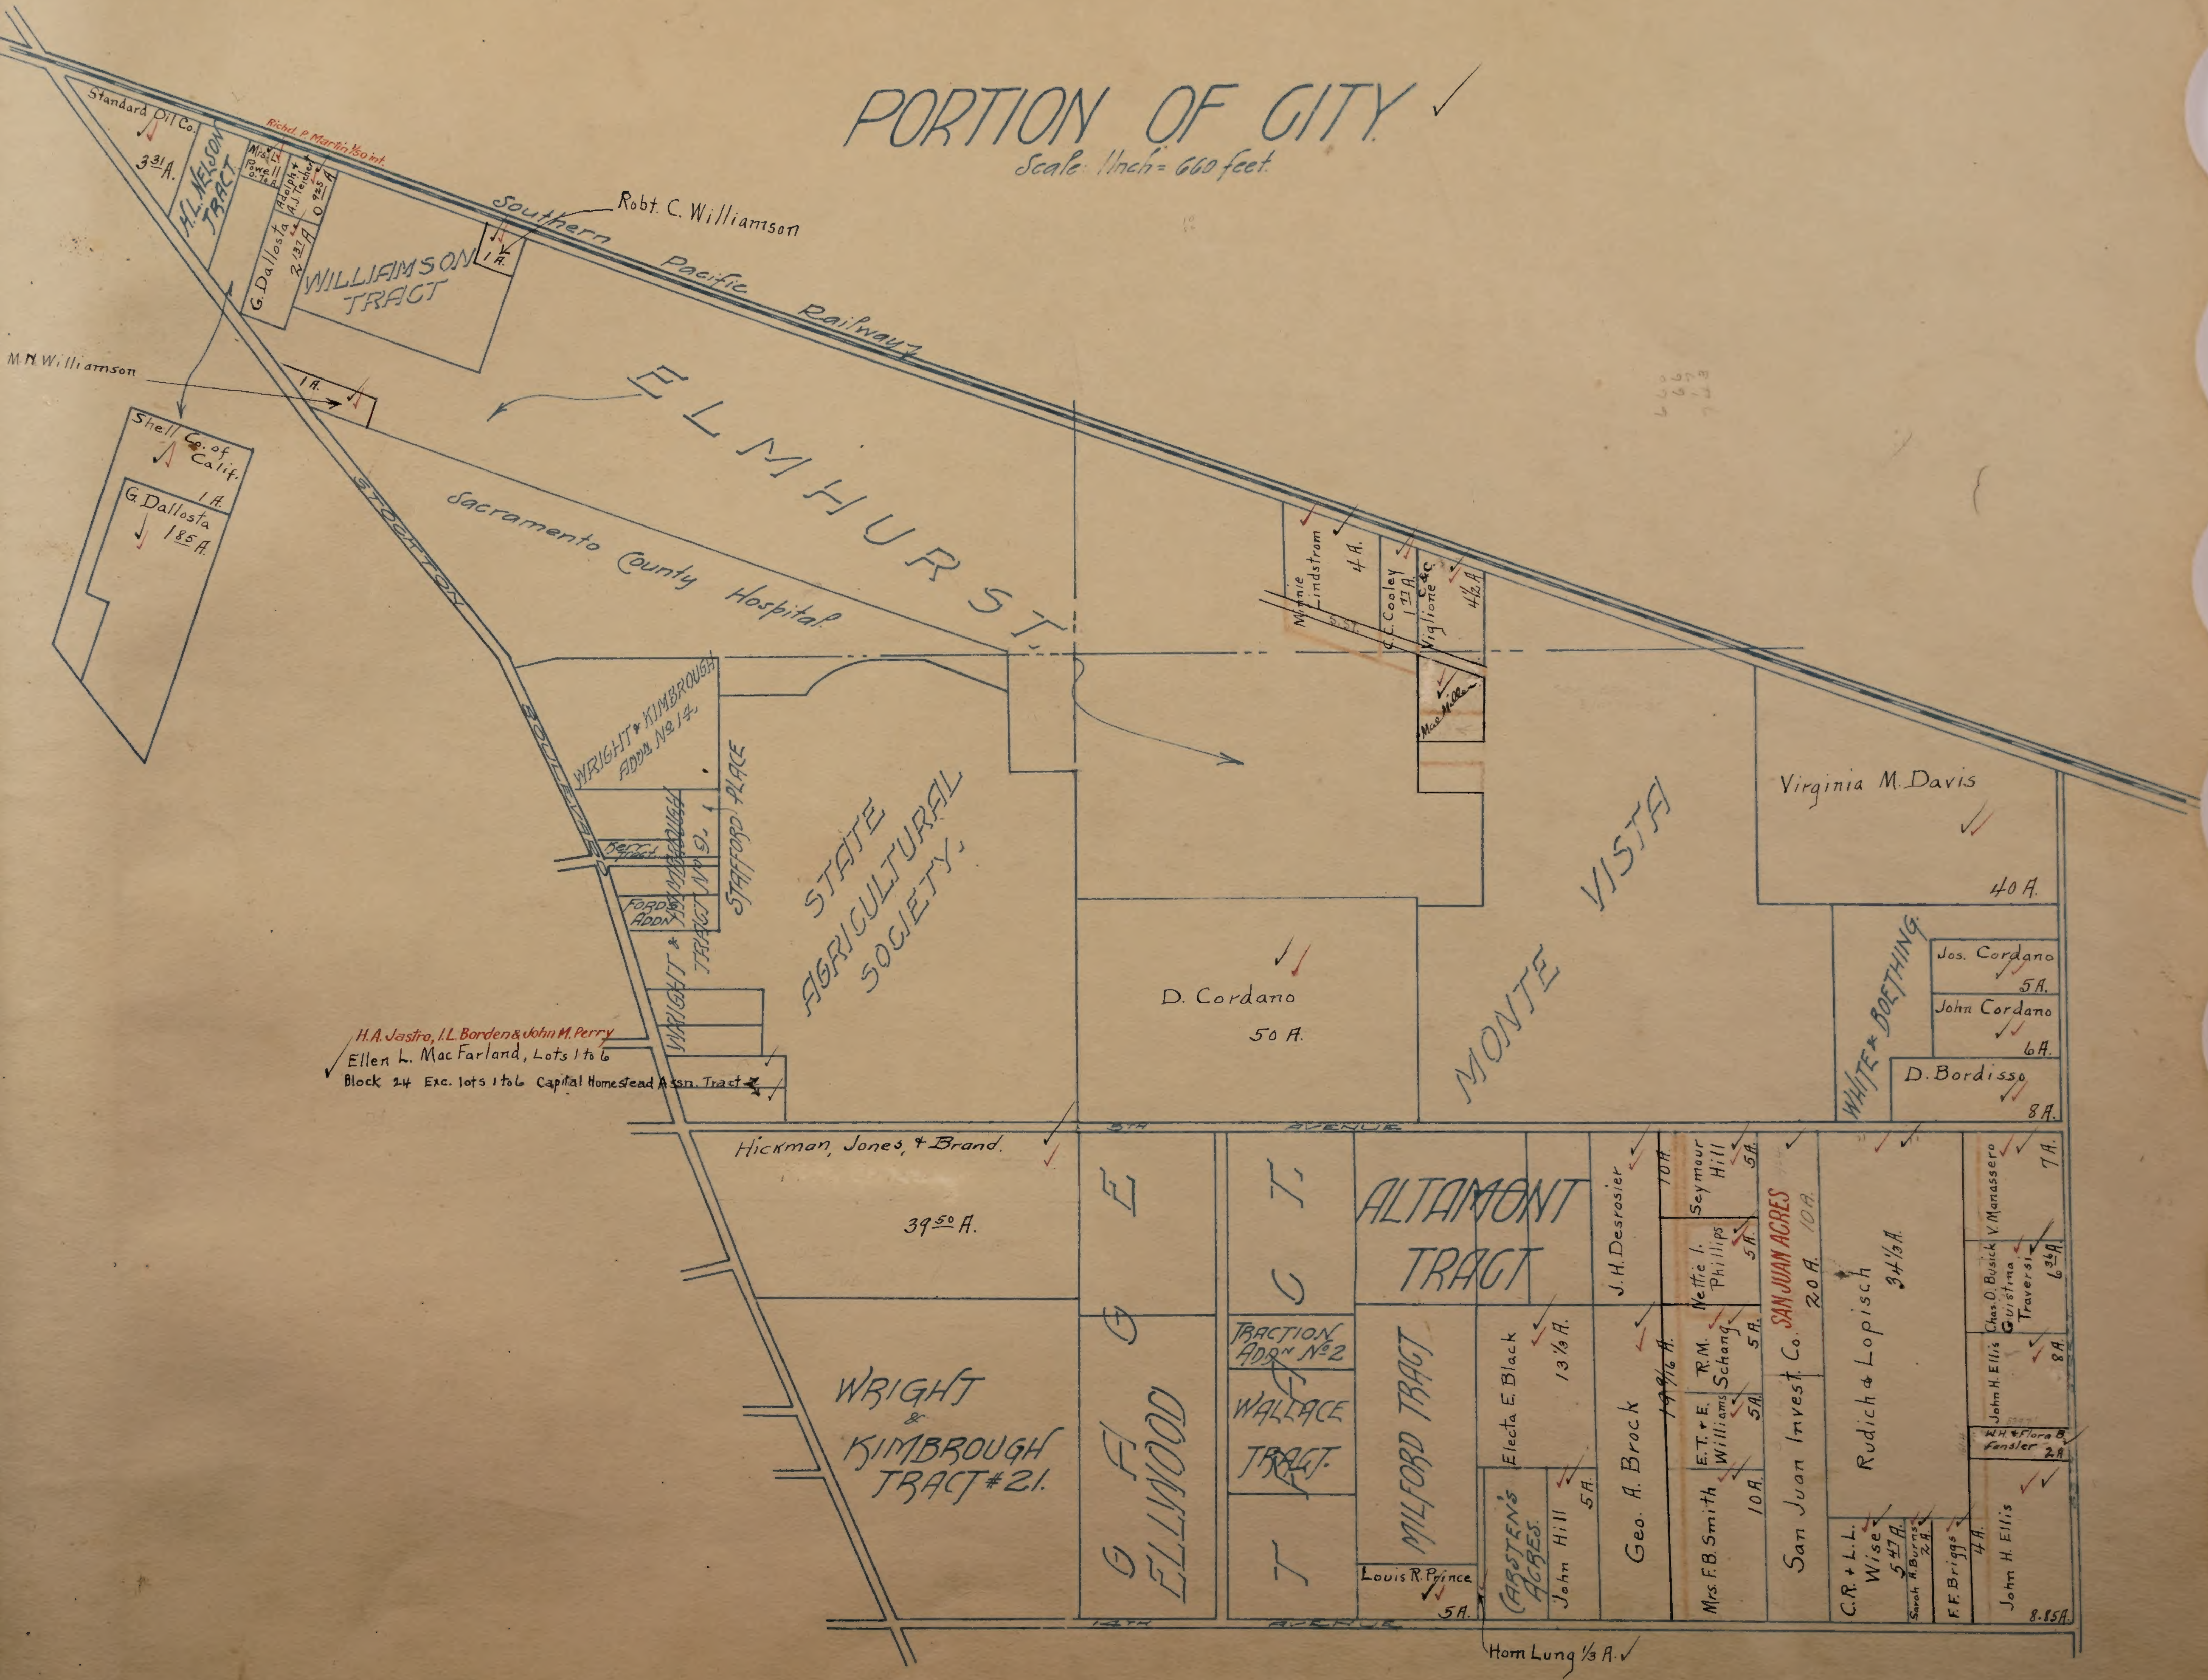
Standard Oil Co.
3 31/100 A.
H.L. NELSON TRACT
Richd. P. Martin 1/50 int.
Mrs. L. Powell 0.70 A.
Adolph + A.J. Teichert
0 925 A
G. Dallosta
2 137 A
WILLIAMSON TRACT
Robt. C. Williamson
1 A.
Southern Pacific Railway
M N Williamson
1 A.
Shell Co. of Calif.
1 A.
G. Dallosta
185 A.
ELMHURST.
STOCKTON BOULEVARD
Sacramento County Hospital
Minnie Lindstrom
4 A.
C.C. Cooley
1 77 A.
C & C Viglione
4 1/2 A
S. ST.
Mae Miller
WRIGHT & KIMBROUGH ADDN No 14.
Kerr Tract.
FORD'S ADDN
WRIGHT & KIMBROUGH TRACT No 9.
STAFFORD PLACE
STATE AGRICULTURAL SOCIETY.
H.A. Jastro, I.L. Borden & John M. Perry
Ellen L. MacFarland, Lots 1 to 6
Block 24 Exc. lots 1 to 6 Capital Homestead Assn. Tract
D. Cordano
50 A.
MONTE VISTA
Virginia M. Davis
40 A.
WHITE & BOETHING
Jos. Cordano
5 A.
John Cordano
6 A.
D. Bordisso
8 A.
5TH AVENUE
Hickman, Jones, & Brand.
39 50/100 A.
WRIGHT & KIMBROUGH TRACT # 21.
G A ELLWOOD
T R A C T
TRACTION ADDN No 2
WALLACE TRACT.
ALTAMONT TRACT
MILFORD TRACT
Louis R. Prince
5 A.
Hom Lung 1/3 A. ✓
CARSTEN'S ACRES.
John Hill
5 A.
Electa E. Black
13 1/3 A.
J.H. Desrosier
Geo. A. Brock
19 9/16 A.
10 A.
Seymour Hill
5 A.
Nettie I. Phillips
5 A.
R.M. Schang
5 A.
E.T. + E. Williams
5 A.
Mrs. F.B. Smith
10 A.
SAN JUAN ACRES
San Juan Invest. Co.
20 A.
10 A.
Rudich & Lopisch
34 1/3 A.
C.R. + L.L. Wise
5 47/100 A.
Sarah A. Burns
2 A.
F.F. Briggs
4 A.
V. Manassero
7 A.
Chas. O. Busick
Guistina Traversi
6 36/100 A
John H. Ellis
8 A.
W.H. + Flora B. Fensler
2 A
John H. Ellis
8.85 A.
14TH AVENUE

PORTION OF CITY. ✓


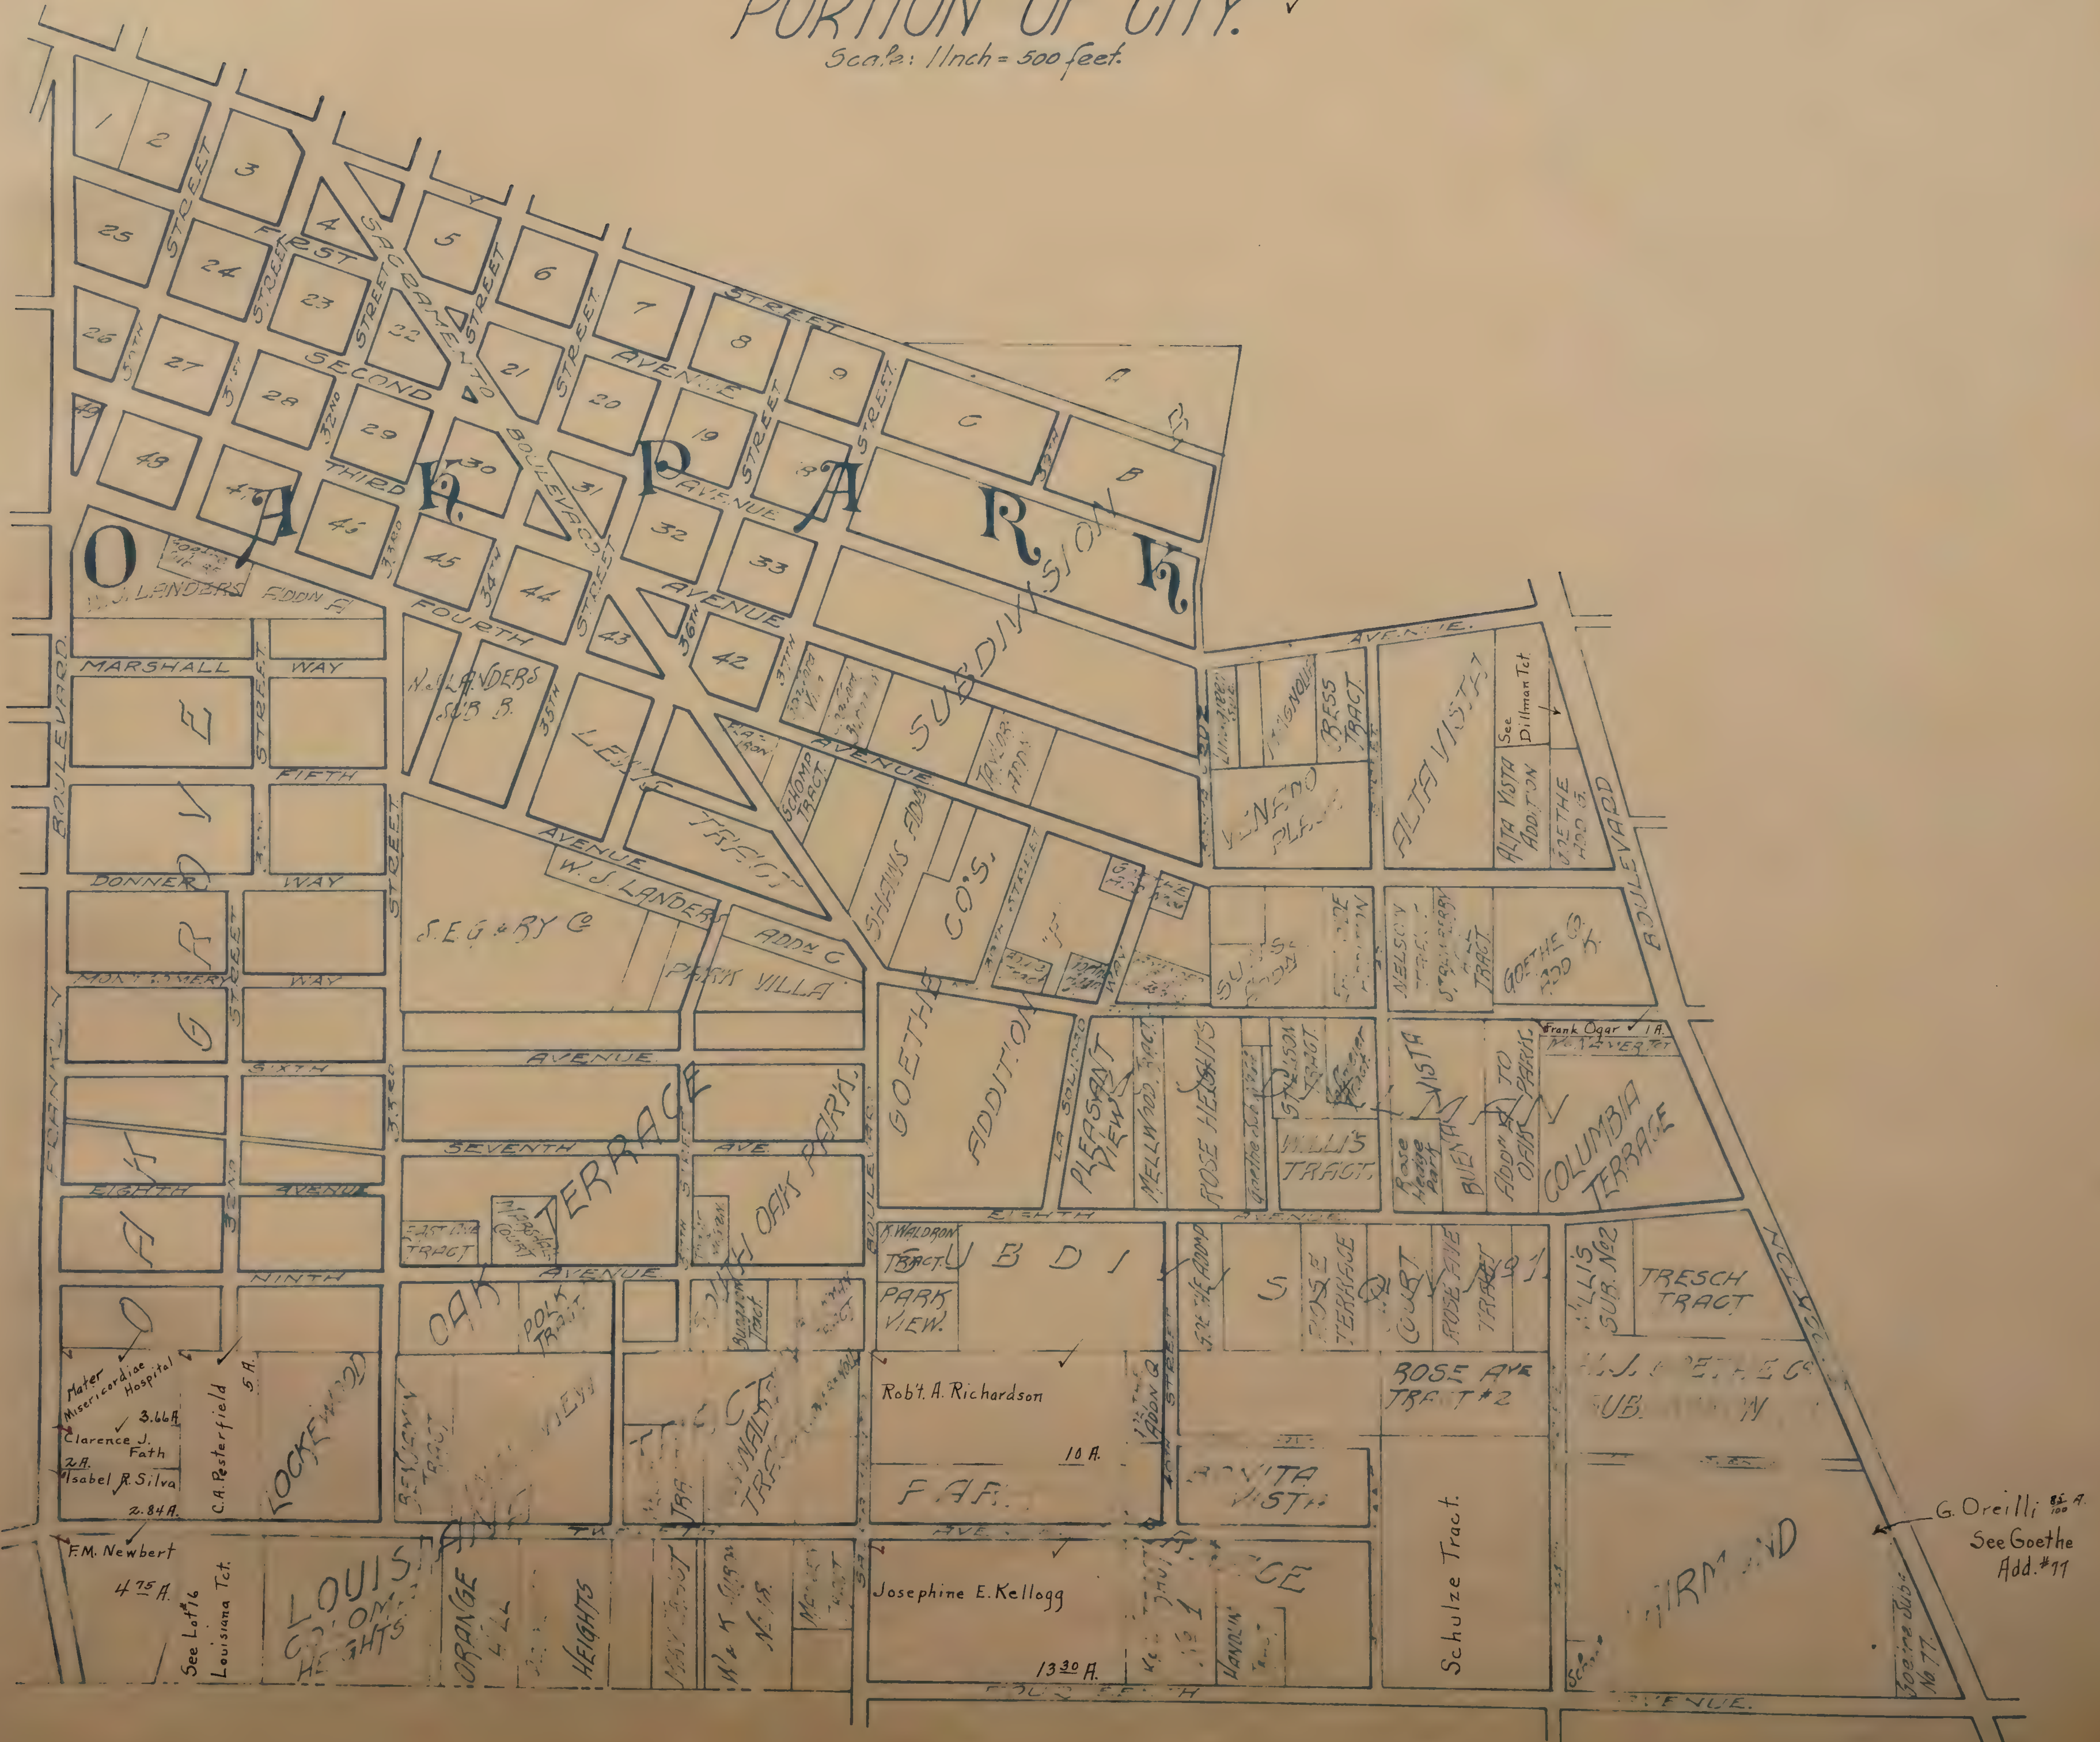

OAK PARK
SUBDIVISION
FIRST AVENUE
SECOND AVENUE
THIRD AVENUE
FOURTH AVENUE
FIFTH AVENUE
SIXTH AVENUE
SEVENTH AVE.
EIGHTH AVENUE
NINTH AVENUE
FOURTEENTH AVENUE
SACRAMENTO BOULEVARD
FRANKLIN BOULEVARD
STOCKTON BOULEVARD
MARSHALL WAY
DONNER WAY
MONTGOMERY WAY
31ST STREET
32ND STREET
33RD STREET
34TH STREET
35TH STREET
36TH STREET
37TH STREET
1
2
3
4
5
6
7
8
9
19
20
21
22
23
24
25
26
27
28
29
30
31
32
33
42
43
44
45
46
47
48
49
A
B
C
OAK GROVE
W. J. LANDERS ADDN A.
W. J. LANDERS SUB. B.
W. J. LANDERS ADDN C.
LEWIS TRACT
S. E. G. & RY. Co.
PARK VILLA
OAK TERRACE
OAK PARK
SCHOMP TRACT
SHAWS ADD.
TAYLOR ADD.
GOETHE CO'S ADDITION "F"
LA SOLANO
PLEASANT VIEWS
MELLWOOD TRACT
ROSE HEIGHTS
ELLIS TRACT
BUENA VISTA
ADDN TO OAK PARK
COLUMBIA TERRACE
ALTA VISTA
ALTA VISTA ADDITION
See Dillman Tct.
GOETHE ADD. G.
GOETHE CO. ADD. K.
VENADO PLACE
BRESS TRACT
NELSON TRACT
Frank Ogar ✓ 1 A.
McNEVER TCT
ELMHURST SUBDIVISION
K. WALDRON TRACT
PARK VIEW.
ROSE TERRACE
ROSE COURT
ROSE AVE TRACT
ROSE AVE TRACT #2
ELLIS SUB. No 2
TRESCH TRACT
W. J. GOETHE Co. SUBDIVISION
FAIRMOND
Goethe Sub. No. 77.
Schulze Tract.
BONITA VISTA
Rob't. A. Richardson
10 A.
FAIR
Josephine E. Kellogg
13 30/100 A.
LOUISIANA COLONY HEIGHTS
ORANGE HILL HEIGHTS
LOCKEWOOD
POLK TRACT
Mater Misericordiae Hospital
3.66 A.
Clarence J. Fath
2 A.
Isabel R. Silva
2.84 A.
C. A. Pesterfield
5 A.
F. M. Newbert
4 75/100 A.
See Lot #16 Louisiana Tct.
G. Oreilli 85/100 A.
See Goethe Add. #77

PORTION OF CITY ✓

Scale: 1 Inch = 500 feet.

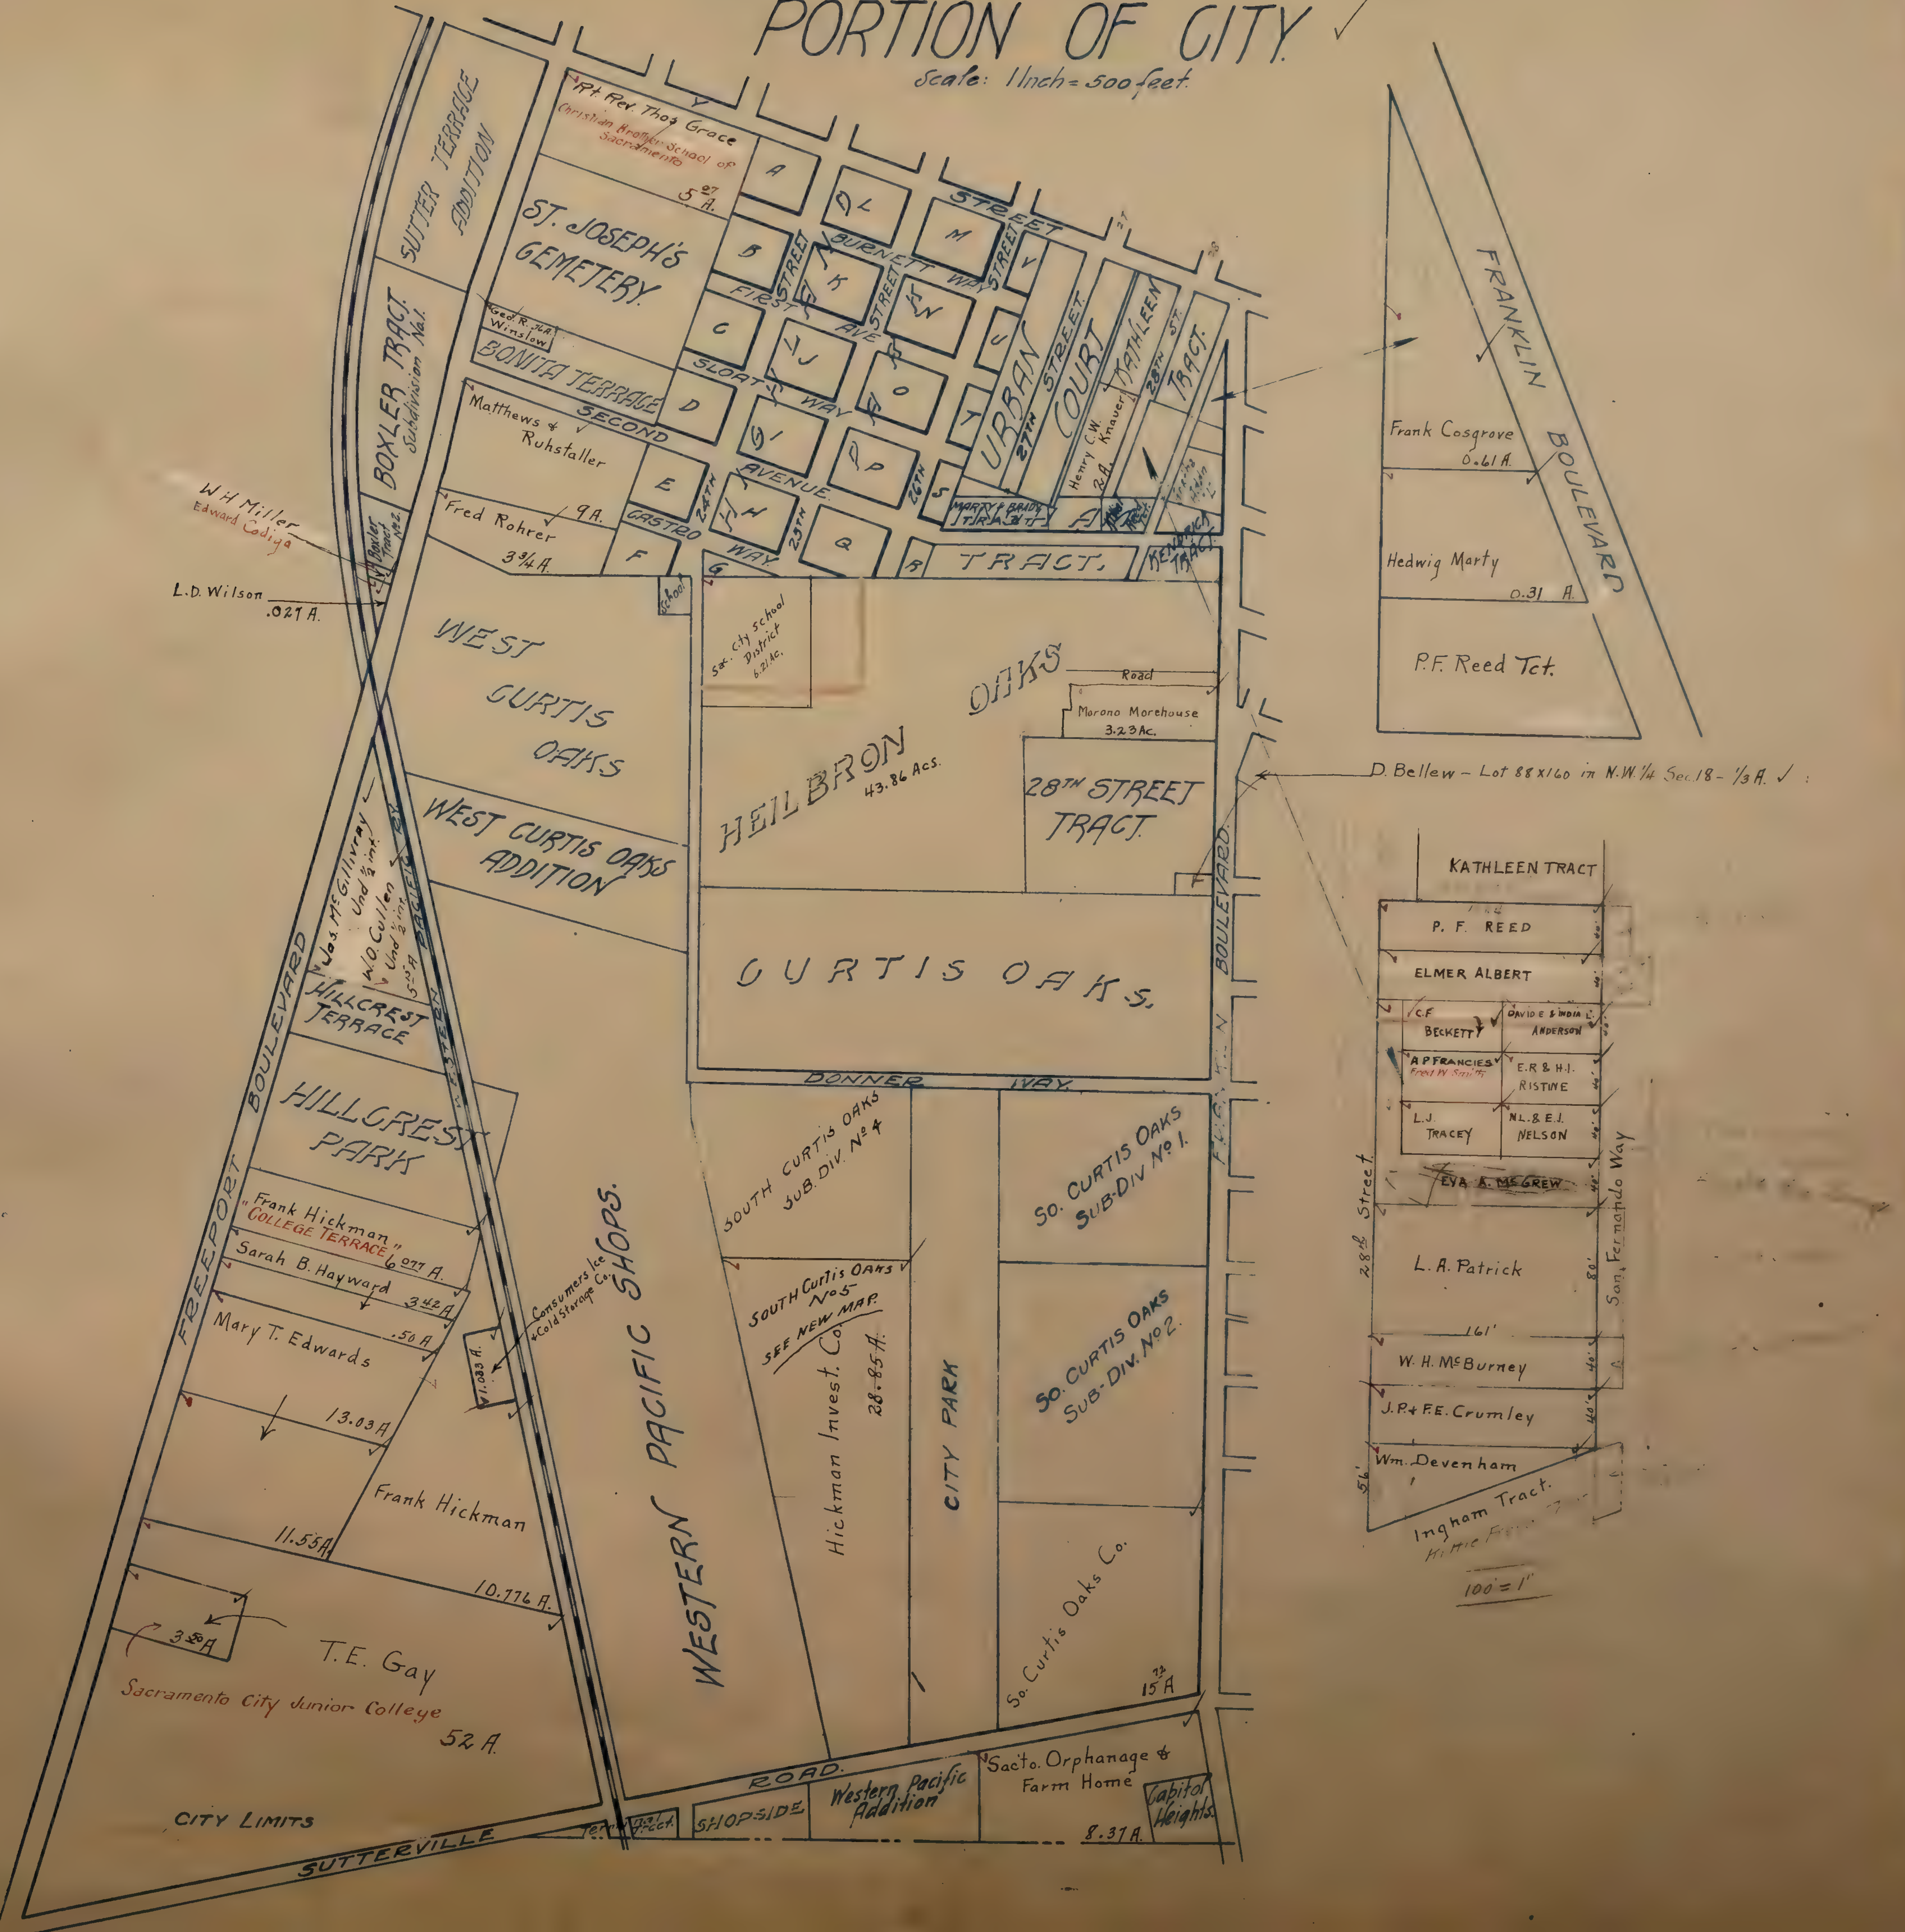
Rt. Rev. Thos Grace
Christian Brother School of Sacramento
5 27 A.
SUTTER TERRACE ADDITION
ST. JOSEPH'S CEMETERY.
BOXLER TRACT. Subdivision No. 1
Boxler Tract No. 2
Geo. R. Winslow .76 A.
BONITA TERRACE
Matthews & Ruhstaller
Fred Rohrer 9 A.
3 3/4 A.
W. H. Miller
Edward Codiga
L. D. Wilson .027 A.
STREET
BURNETT WAY
FIRST AVE
SLOAT WAY
SECOND AVENUE
CASTRO WAY
24TH
25TH
26TH
27TH
28TH ST.
A
B
C
D
E
F
G
H
J
K
L
M
N
O
P
Q
R
S
T
U
V
URBAN
STREET COURT
KATHLEEN TRACT.
Henry C. W. Knauer 2 A.
MARTY & BRADY TRACT
TRACT.
KENDRICK TRACT
School
Sac. City School District 6.21 Ac.
WEST CURTIS OAKS
WEST CURTIS OAKS ADDITION
HEILBRON OAKS 43.86 Acs.
Road
Morono Morehouse 3.23 Ac.
28TH STREET TRACT.
CURTIS OAKS.
DONNER WAY
BOULEVARD
FRANKLIN BOULEVARD
Frank Cosgrove 0.61 A.
Hedwig Marty 0.31 A.
P. F. Reed Tct.
D. Bellew – Lot 88 x 160 in N.W. 1/4 Sec. 18 – 1/3 A. ✓
Jos. McGillivray Und 1/2 int.
W. O. Cullen Und 1/2 int.
5.03 A
WESTERN PACIFIC
HILLCREST TERRACE
HILLCREST PARK
FREEPORT BOULEVARD
Frank Hickman "COLLEGE TERRACE" 6.077 A.
Sarah B. Hayward 3 1/2 A.
Mary T. Edwards .50 A.
13.03 A.
Frank Hickman
11.55 A.
10.776 A.
Consumers Ice & Cold Storage Co.
1.083 A.
WESTERN PACIFIC SHOPS.
SOUTH CURTIS OAKS SUB. DIV. No 4
SOUTH Curtis Oaks No 5 SEE NEW MAP.
Hickman Invest. Co. 28.85 A.
CITY PARK
So. CURTIS OAKS SUB-DIV. No 1.
So. CURTIS OAKS SUB-DIV. No 2.
So. Curtis Oaks Co.
15 72 A
3 20 A
T. E. Gay
Sacramento City Junior College
52 A.
CITY LIMITS
SUTTERVILLE
ROAD.
SHOPSIDE
Western Pacific Addition
Sac'to. Orphanage & Farm Home
8.31 A.
Capitol Heights.
KATHLEEN TRACT
P. F. REED
ELMER ALBERT
C. F. BECKETT
DAVID E & INDIA L. ANDERSON
A P FRANCIES
Fred W. Smith
E. R & H. I. RISTINE
L. J. TRACEY
N. L. & E. J. NELSON
EVA A. McGREW
L. A. Patrick
161'
W. H. McBurney
J. P. & F. E. Crumley
Wm. Devenham
Ingham Tract.
28th Street
San Fernando Way
40'
80'
56'
100' = 1"

PORTION OF CITY ✓

Scale: 1 inch = 500 feet

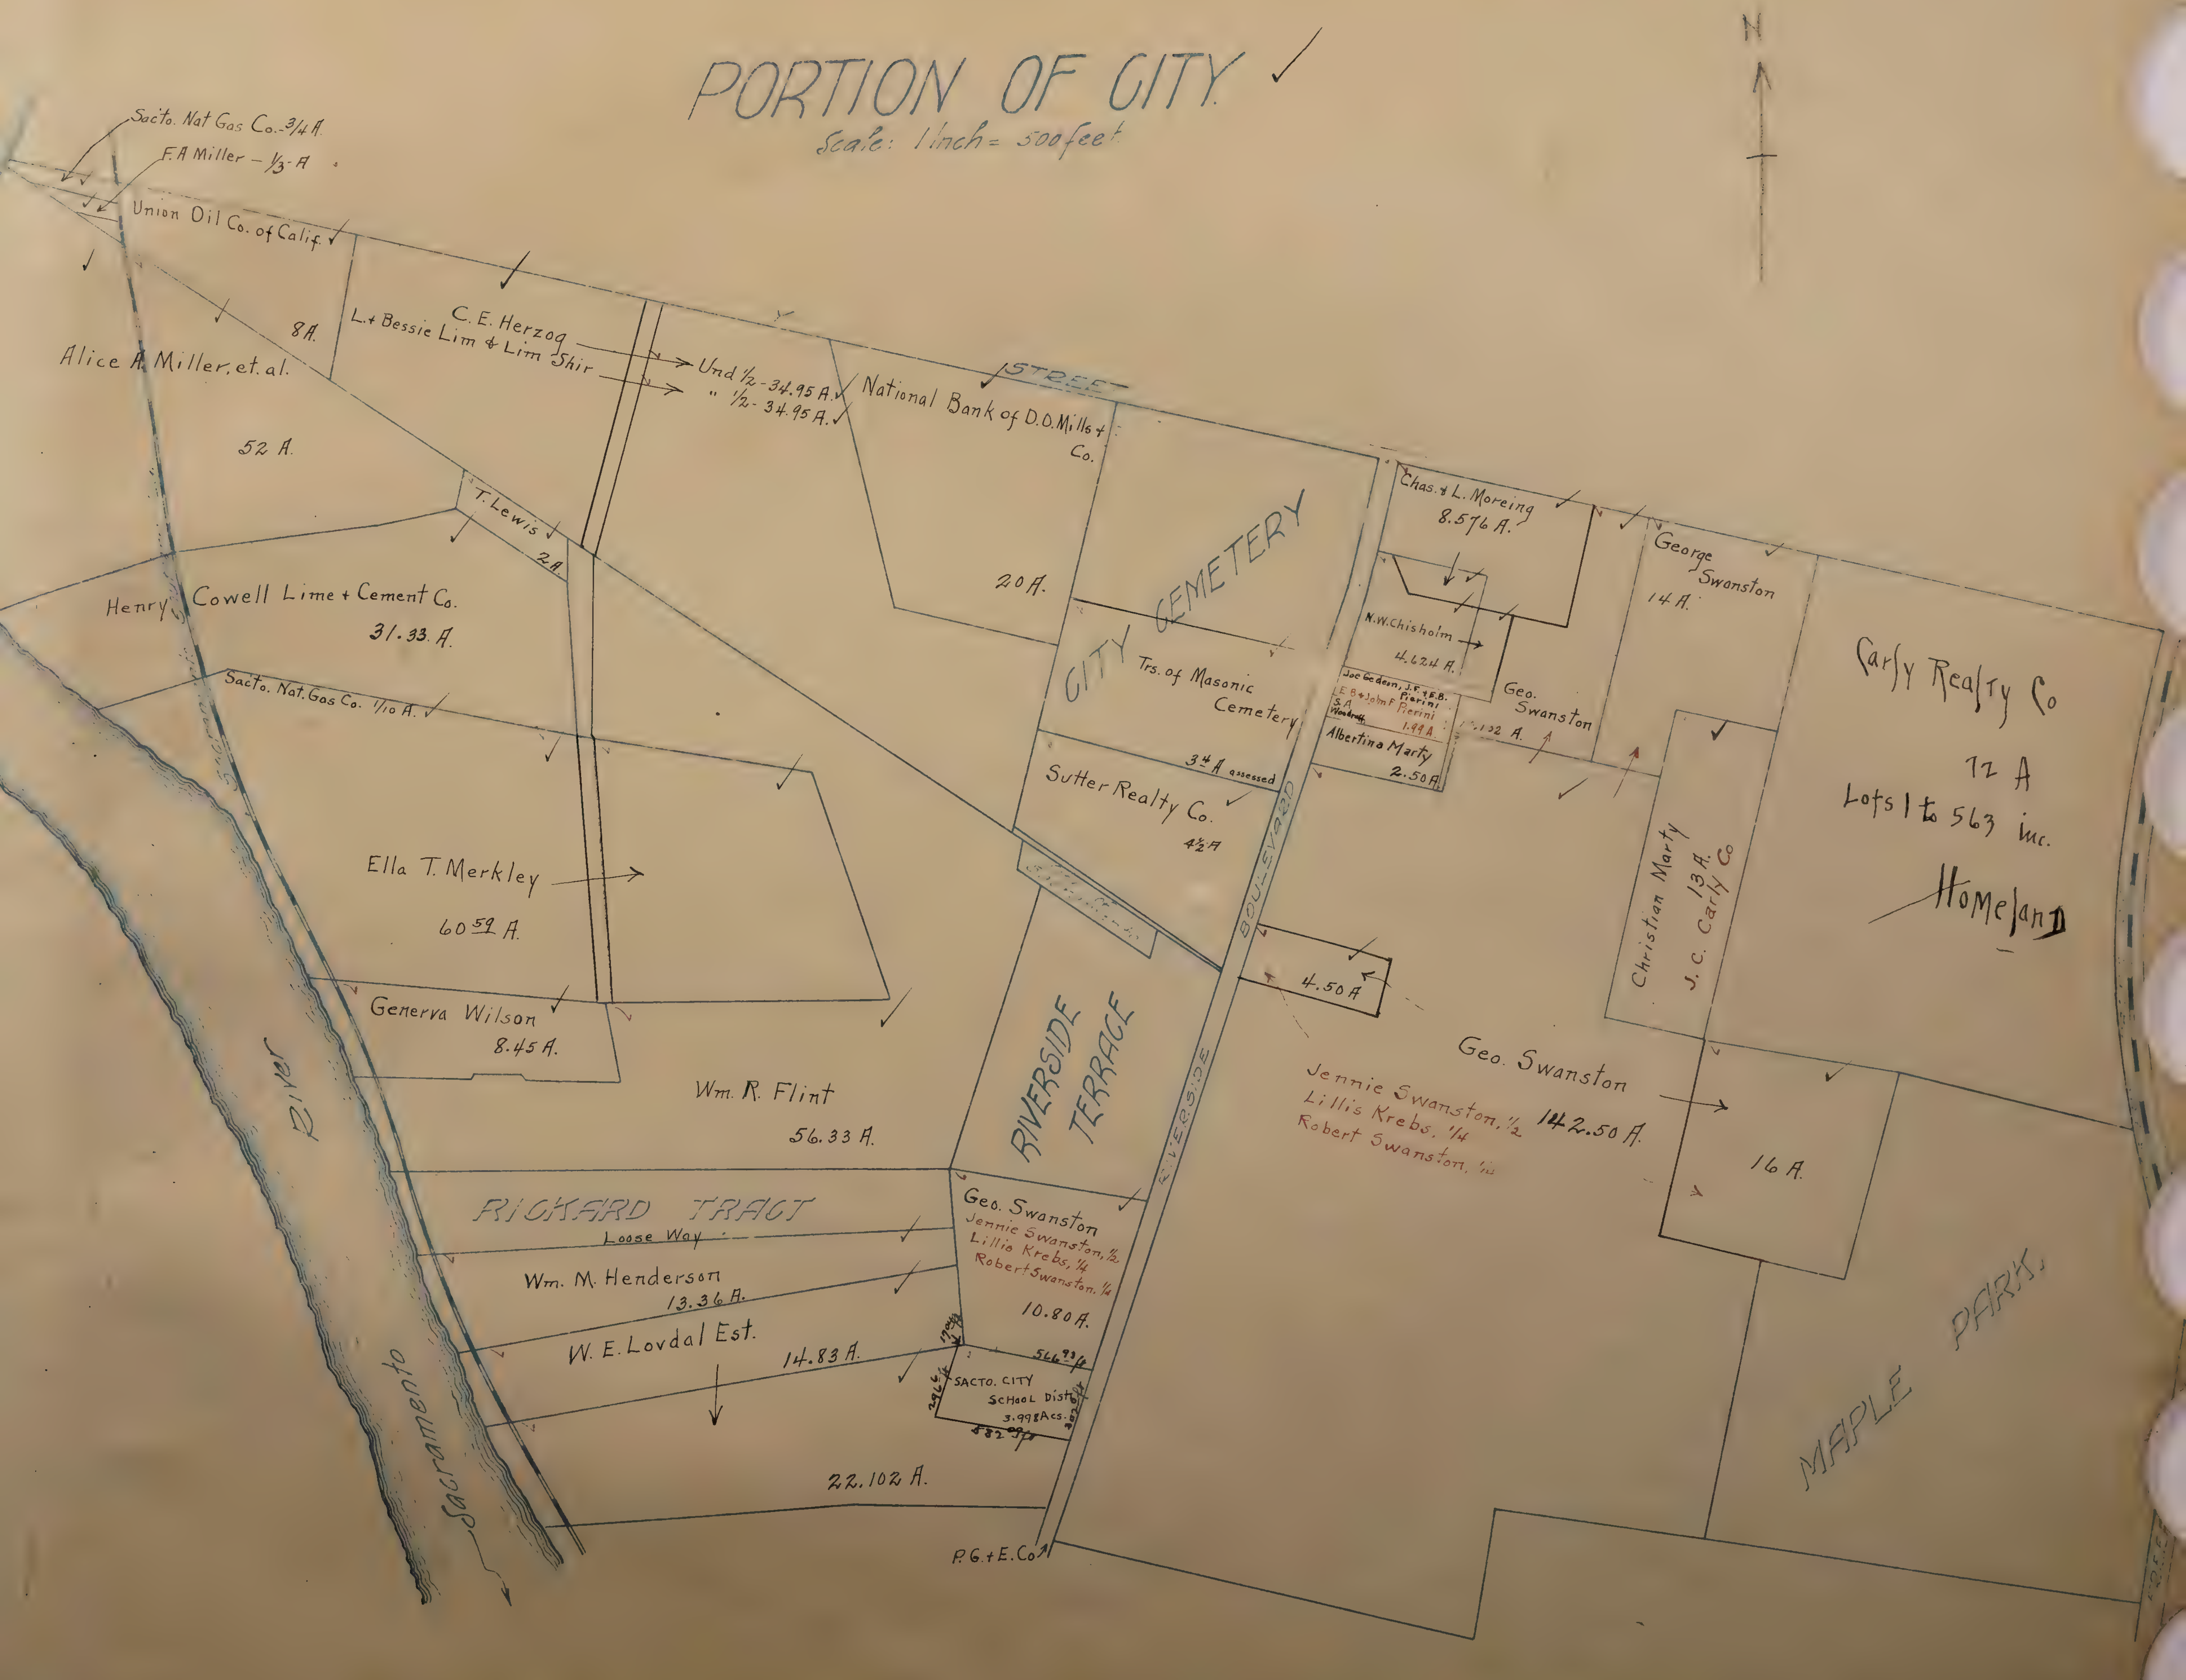

N
Sacto. Nat Gas Co.-3/4 A.
F.A Miller – 1/3 A
Union Oil Co. of Calif.
8 A.
Alice A. Miller, et. al.
52 A.
C.E. Herzog
L. & Bessie Lim & Lim Shir
Und 1/2 - 34.95 A.
" 1/2 - 34.95 A.
National Bank of D.O. Mills & Co.
STREET
20 A.
T. Lewis
2 A
Henry Cowell Lime & Cement Co.
31.33 A.
Sacto. Nat. Gas Co. 1/10 A.
Ella T. Merkley
60.59 A.
Generva Wilson
8.45 A.
Wm. R. Flint
56.33 A.
River
Sacramento
CITY CEMETERY
Trs. of Masonic Cemetery
3¼ A assessed
Sutter Realty Co.
4½ A
RIVERSIDE TERRACE
BOULEVARD
RIVERSIDE
Chas. & L. Moreing
8.576 A.
N.W. Chisholm
4.624 A.
Joe Gedeon, J.F. & E.B. Pierini
E.B. & John F. Pierini
S.A. Woodruff
1.99 A.
Albertina Marty
2.50 A.
Geo. Swanston
.132 A.
George Swanston
14 A.
Carly Realty Co
72 A
Lots 1 to 563 inc.
Homeland
Christian Marty
13 A.
J.C. Carly Co
4.50 A
Geo. Swanston
Jennie Swanston, 1/2
Lillis Krebs, 1/4
Robert Swanston, 1/4
142.50 A.
16 A.
MAPLE PARK
RICKARD TRACT
Loose Way
Wm. M. Henderson
13.36 A.
W. E. Lovdal Est.
14.83 A.
Geo. Swanston
Jennie Swanston, 1/2
Lillie Krebs, 1/4
Robert Swanston, 1/4
10.80 A.
566.93 ft
SACTO. CITY SCHOOL Dist.
3.998 Acs.
296.6 ft
582.09 ft
22.102 A.
P.G. & E. Co

PORTION OF CITY

Scale 1 Inch = 500 Feet

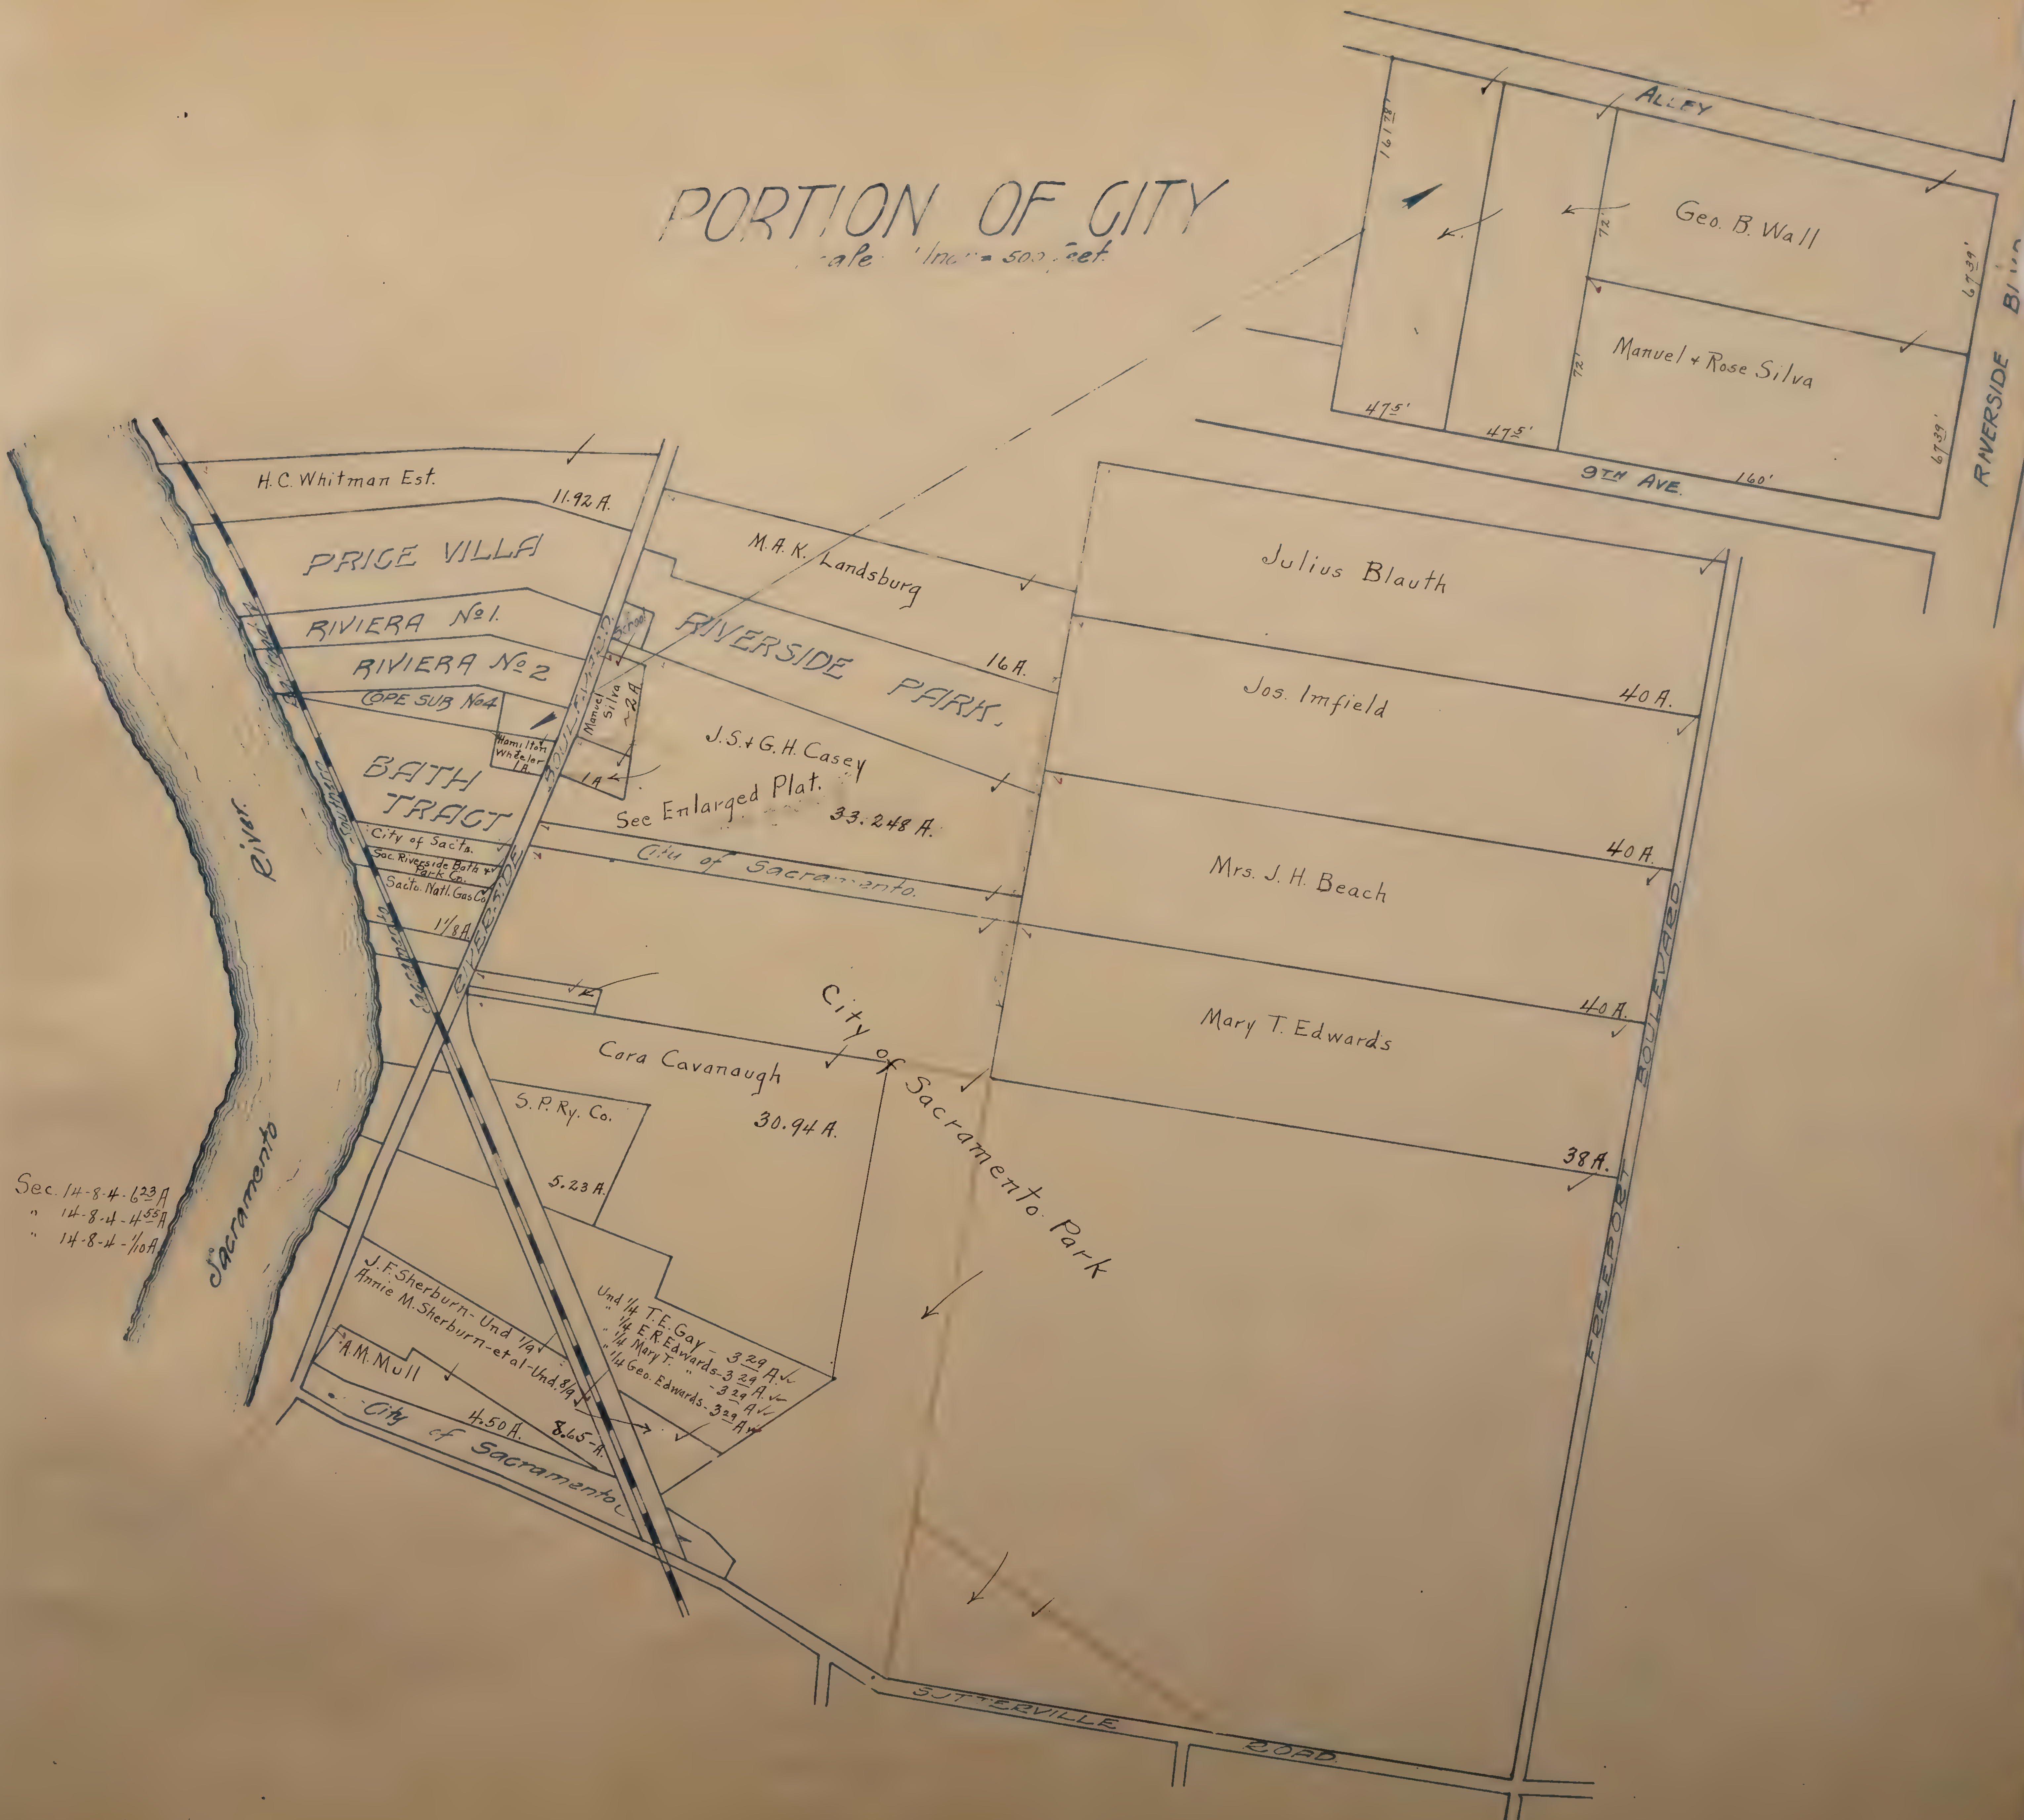

ALLEY
Geo. B. Wall
Manuel + Rose Silva
161 74/100
72'
72'
67 39/100
67 39/100
47.5'
47.5'
160'
9TH AVE.
RIVERSIDE BLVD.
H. C. Whitman Est.
11.92 A.
PRICE VILLA
RIVIERA No 1.
RIVIERA No 2
COPE SUB No 4
BATH TRACT
Hamilton Wheeler 1 A.
Manuel Silva 2 A.
1 A.
BOULEVARD
M. A. K. Landsburg
16 A.
RIVERSIDE PARK.
J. S. + G. H. Casey
See Enlarged Plat.
33.248 A.
City of Sacta.
Sac. Riverside Bath & Park Co.
Sacto. Natl. Gas Co.
1 1/8 A.
City of Sacramento.
RIVERSIDE
Julius Blauth
Jos. Imfield
40 A.
Mrs. J. H. Beach
40 A.
Mary T. Edwards
40 A.
38 A.
FREEPORT BOULEVARD
Cara Cavanaugh
30.94 A.
City of Sacramento Park
S. P. Ry. Co.
5.23 A.
Sacramento River
J. F. Sherburn - Und 1/9
Annie M. Sherburn - et al - Und 8/9
Und 1/4 T. E. Gay - 3.29 A.
" 1/4 E. R. Edwards - 3.29 A.
" 1/4 Mary T. " - 3.29 A.
" 1/4 Geo. Edwards - 3.29 A.
A. M. Mull
4.50 A.
8.65 A.
City of Sacramento
SUTTERVILLE ROAD

✓S P Co Sec. 14-8-4-6^{23}A
✓" " " " 14-8-4-4^{55}A
✓" " " " 14-8-4-1/10A

ADDITION "A" TO OAK PARK.✓

Scale: 1 Inch = 80 feet.

Note: Comprises all of Lot No. 17, M. J. Dillman Sub. No. 1.

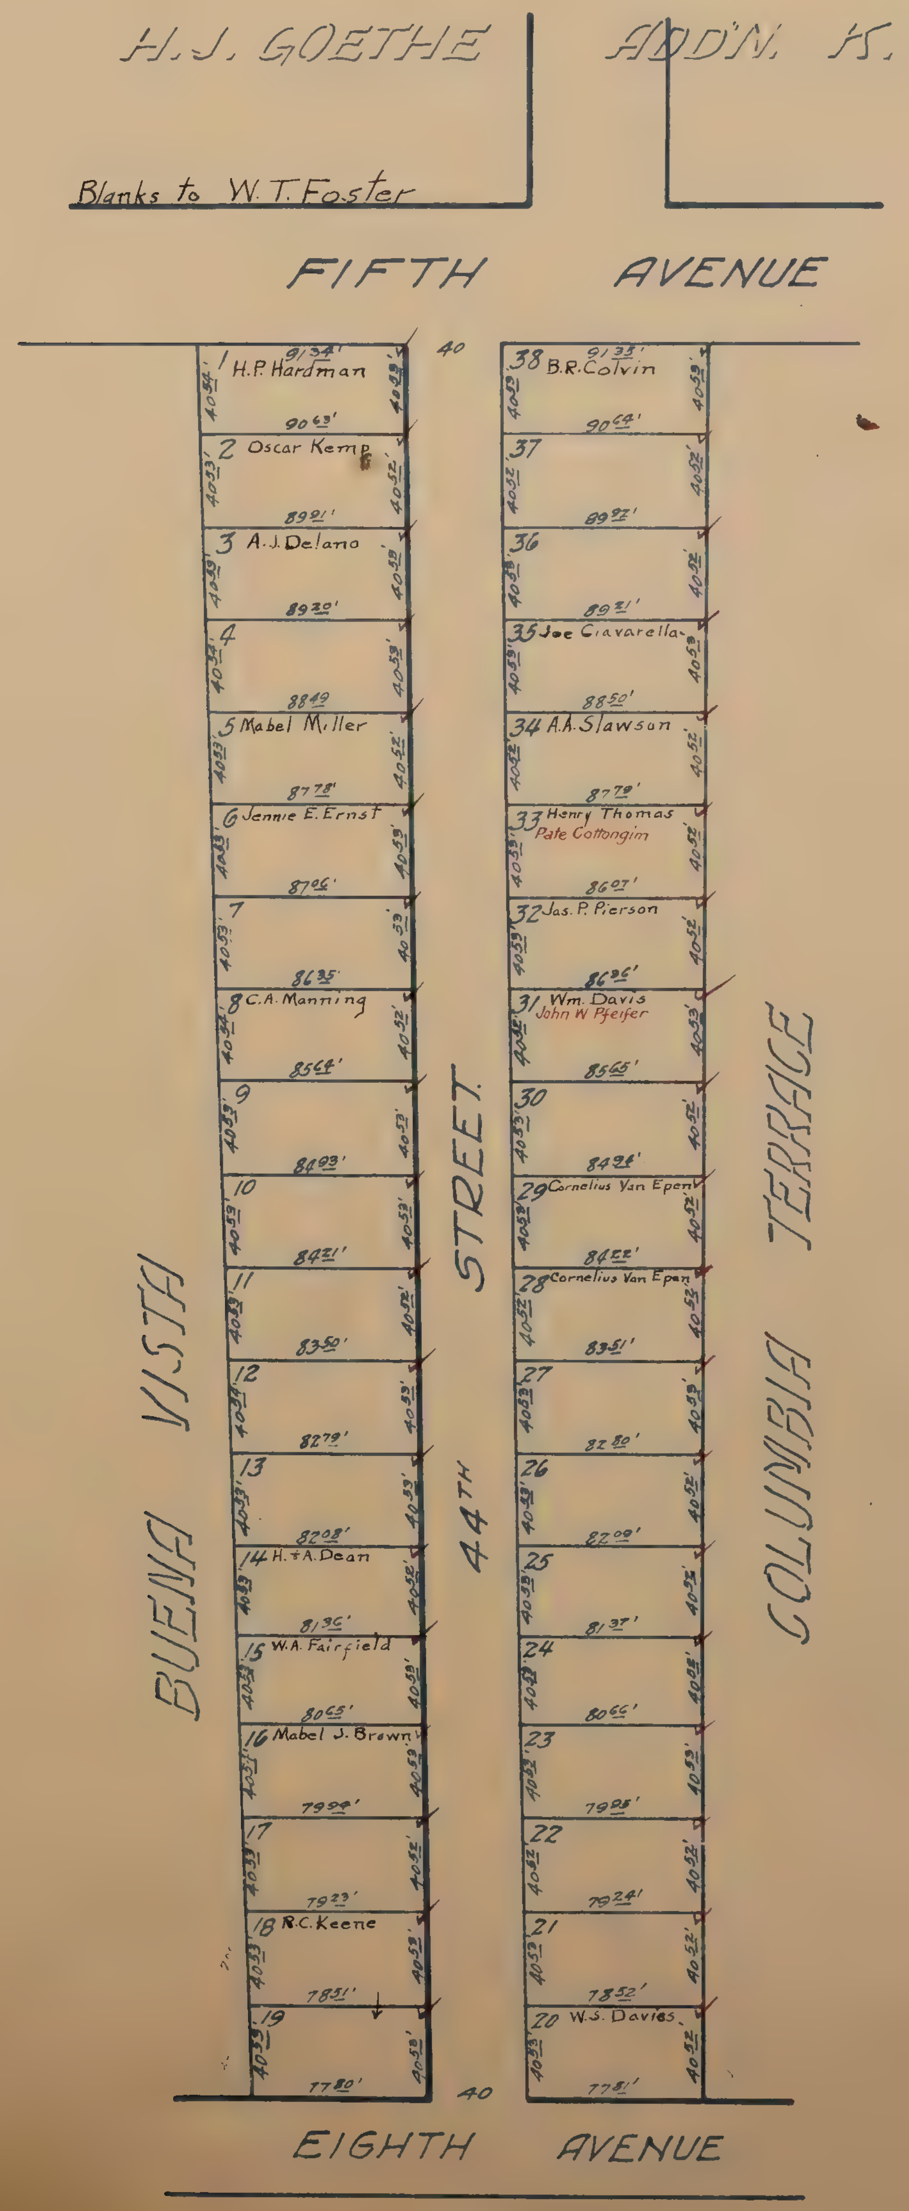
H. J. GOETHE
ADD'N. K.
Blanks to W. T. Foster
FIFTH AVENUE
40
1 H. P. Hardman 91 34' 40 54' 40 53' 90 63'
2 Oscar Kemp 40 53' 40 52' 89 91'
3 A. J. Delano 40 53' 40 53 89 20'
4 40 54' 40 53' 88 49
5 Mabel Miller 40 53' 40 52' 87 78'
6 Jennie E. Ernst 40 53' 40 53' 87 06'
7 40 53' 40 53' 86 35'
8 C. A. Manning 40 54' 40 52' 85 64'
9 40 53' 40 53' 84 93'
10 40 53' 40 53' 84 21'
11 40 53' 40 52' 83 50'
12 40 54' 40 53' 82 79'
13 40 53' 40 53' 82 08'
14 H. & A. Dean 40 53 40 52' 81 36'
15 W. A. Fairfield 40 53 40 53' 80 65'
16 Mabel J. Brown 40 53' 40 53' 79 94'
17 40 53' 40 52' 79 23'
18 R. C. Keene 40 53 40 53' 78 51'
19 40 53' 40 53' 77 80'
38 B. R. Colvin 91 33' 40 53 40 53' 90 64'
37 40 52 40 52' 89 93'
36 40 53' 40 52 89 21'
35 Joe Ciavarella 40 53' 40 53 88 50'
34 A. A. Slawson 40 52 40 52' 87 79'
33 Henry Thomas
Pate Cottongim 40 53' 40 52' 86 07'
32 Jas. P. Pierson 40 53' 40 52 86 36'
31 Wm. Davis
John W. Pfeifer 40 52 40 53' 85 65'
30 40 53' 40 52' 84 94'
29 Cornelius Van Epen 40 52 40 52' 84 22'
28 Cornelius Van Epen 40 52' 40 53' 83 51'
27 40 53' 40 53' 82 80'
26 40 53' 40 52' 82 09'
25 40 53' 40 53' 81 37'
24 40 53 40 52' 80 66'
23 40 53' 40 53' 79 95'
22 40 52' 40 52' 79 24'
21 40 53' 40 52' 78 52'
20 W. S. Davies 40 53' 40 52' 77 81'
BUENA VISTA
44TH STREET
COLUMBIA TERRACE
40
EIGHTH AVENUE

ALLEN TRACT.

Scale 1 Inch = 80 feet.

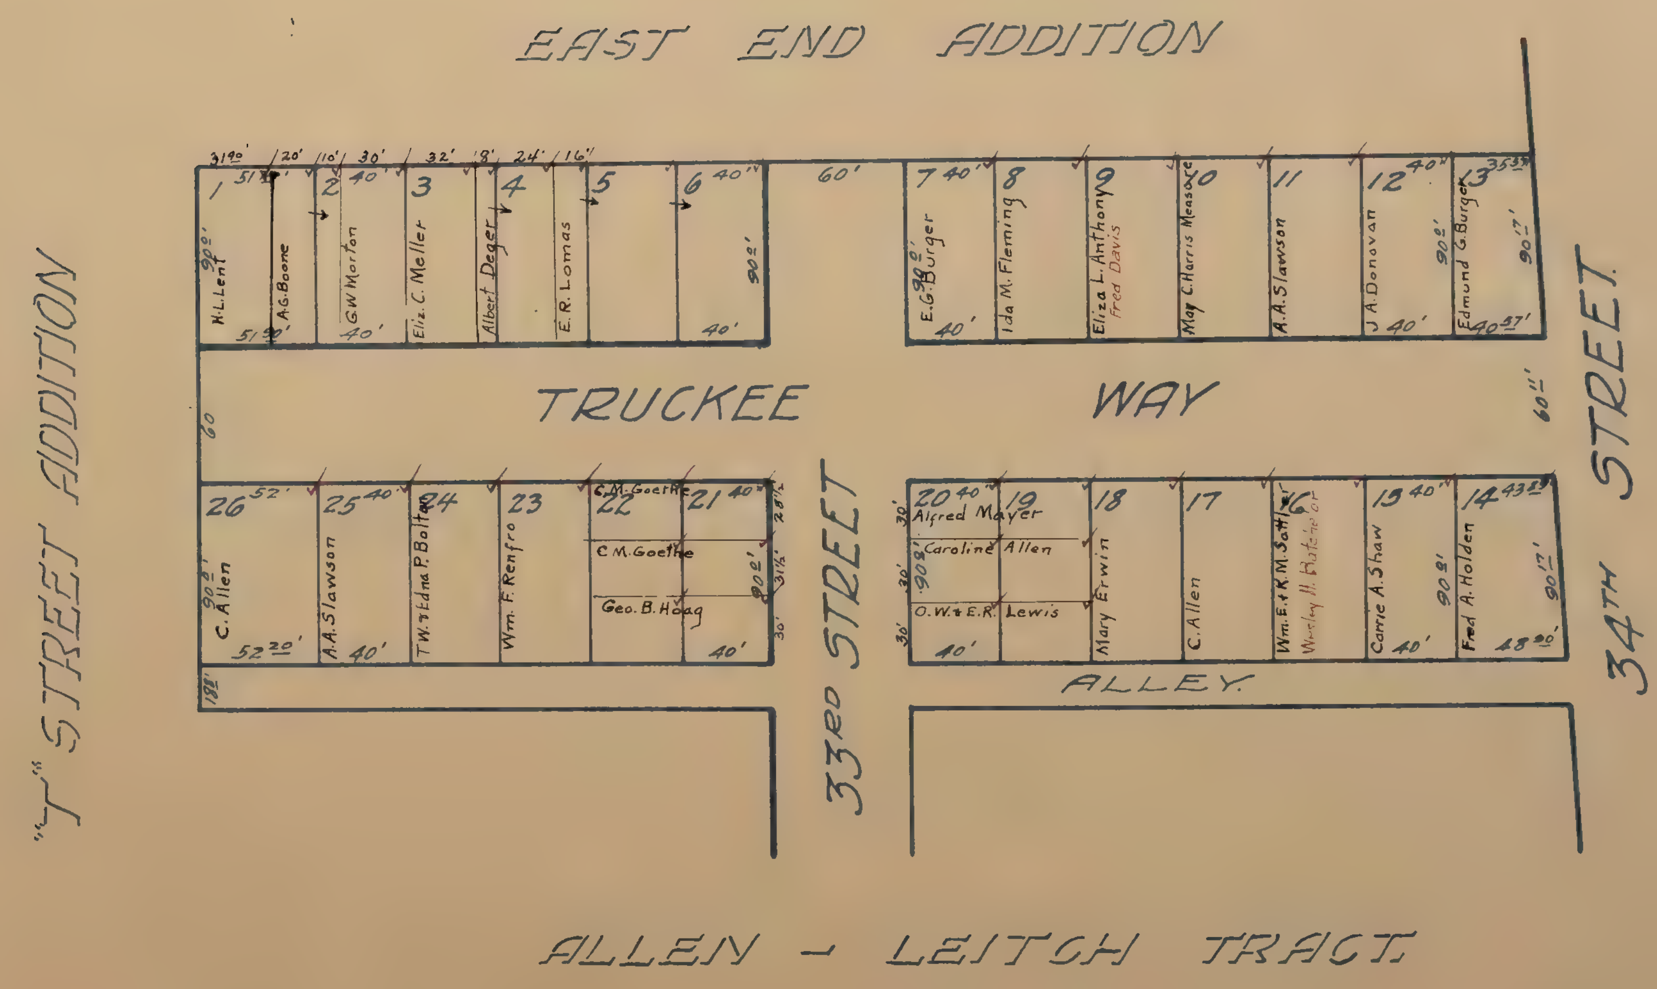
EAST END ADDITION
"T" STREET ADDITION
ALLEN - LEITCH TRACT.
TRUCKEE WAY
33RD STREET
34TH STREET
ALLEY.
1 H.L.Lent
A.G.Boone
2 G.W.Morton
3 Eliz. C. Meller
Albert Deger
4
E.R. Lomas
5
6
7 E.G. Burger
8 Ida M. Fleming
9 Eliza L. Anthony
Fred Davis
10 May C. Harris Measore
11 A.A. Slawson
12 J.A. Donovan
13 Edmund G. Burger
14 Fred A. Holden
15 Carrie A. Shaw
16 Wm. E. & K.M. Sattler
Wesley H. Hutch
17 C. Allen
18 Mary Erwin
19
20 Alfred Mayer
Caroline Allen
O.W. & E.R. Lewis
21
22 C.M. Goethe
C.M. Goethe
Geo. B. Hoag
23 Wm. F. Renfro
24 T.W. & Edna P. Bolton
25 A.A. Slawson
26 C. Allen
31 40'
20'
10'
30'
32'
8'
24'
16'
51 50'
40'
90'
60'
35 37'
90 17'
40 37'
60 11'
60
52'
52 20'
18'
28 1/2'
31 1/2'
30'
43 83'
48 90'

ALLEN & LEITCH TRACT

Scale: 1 Inch = 80 feet.

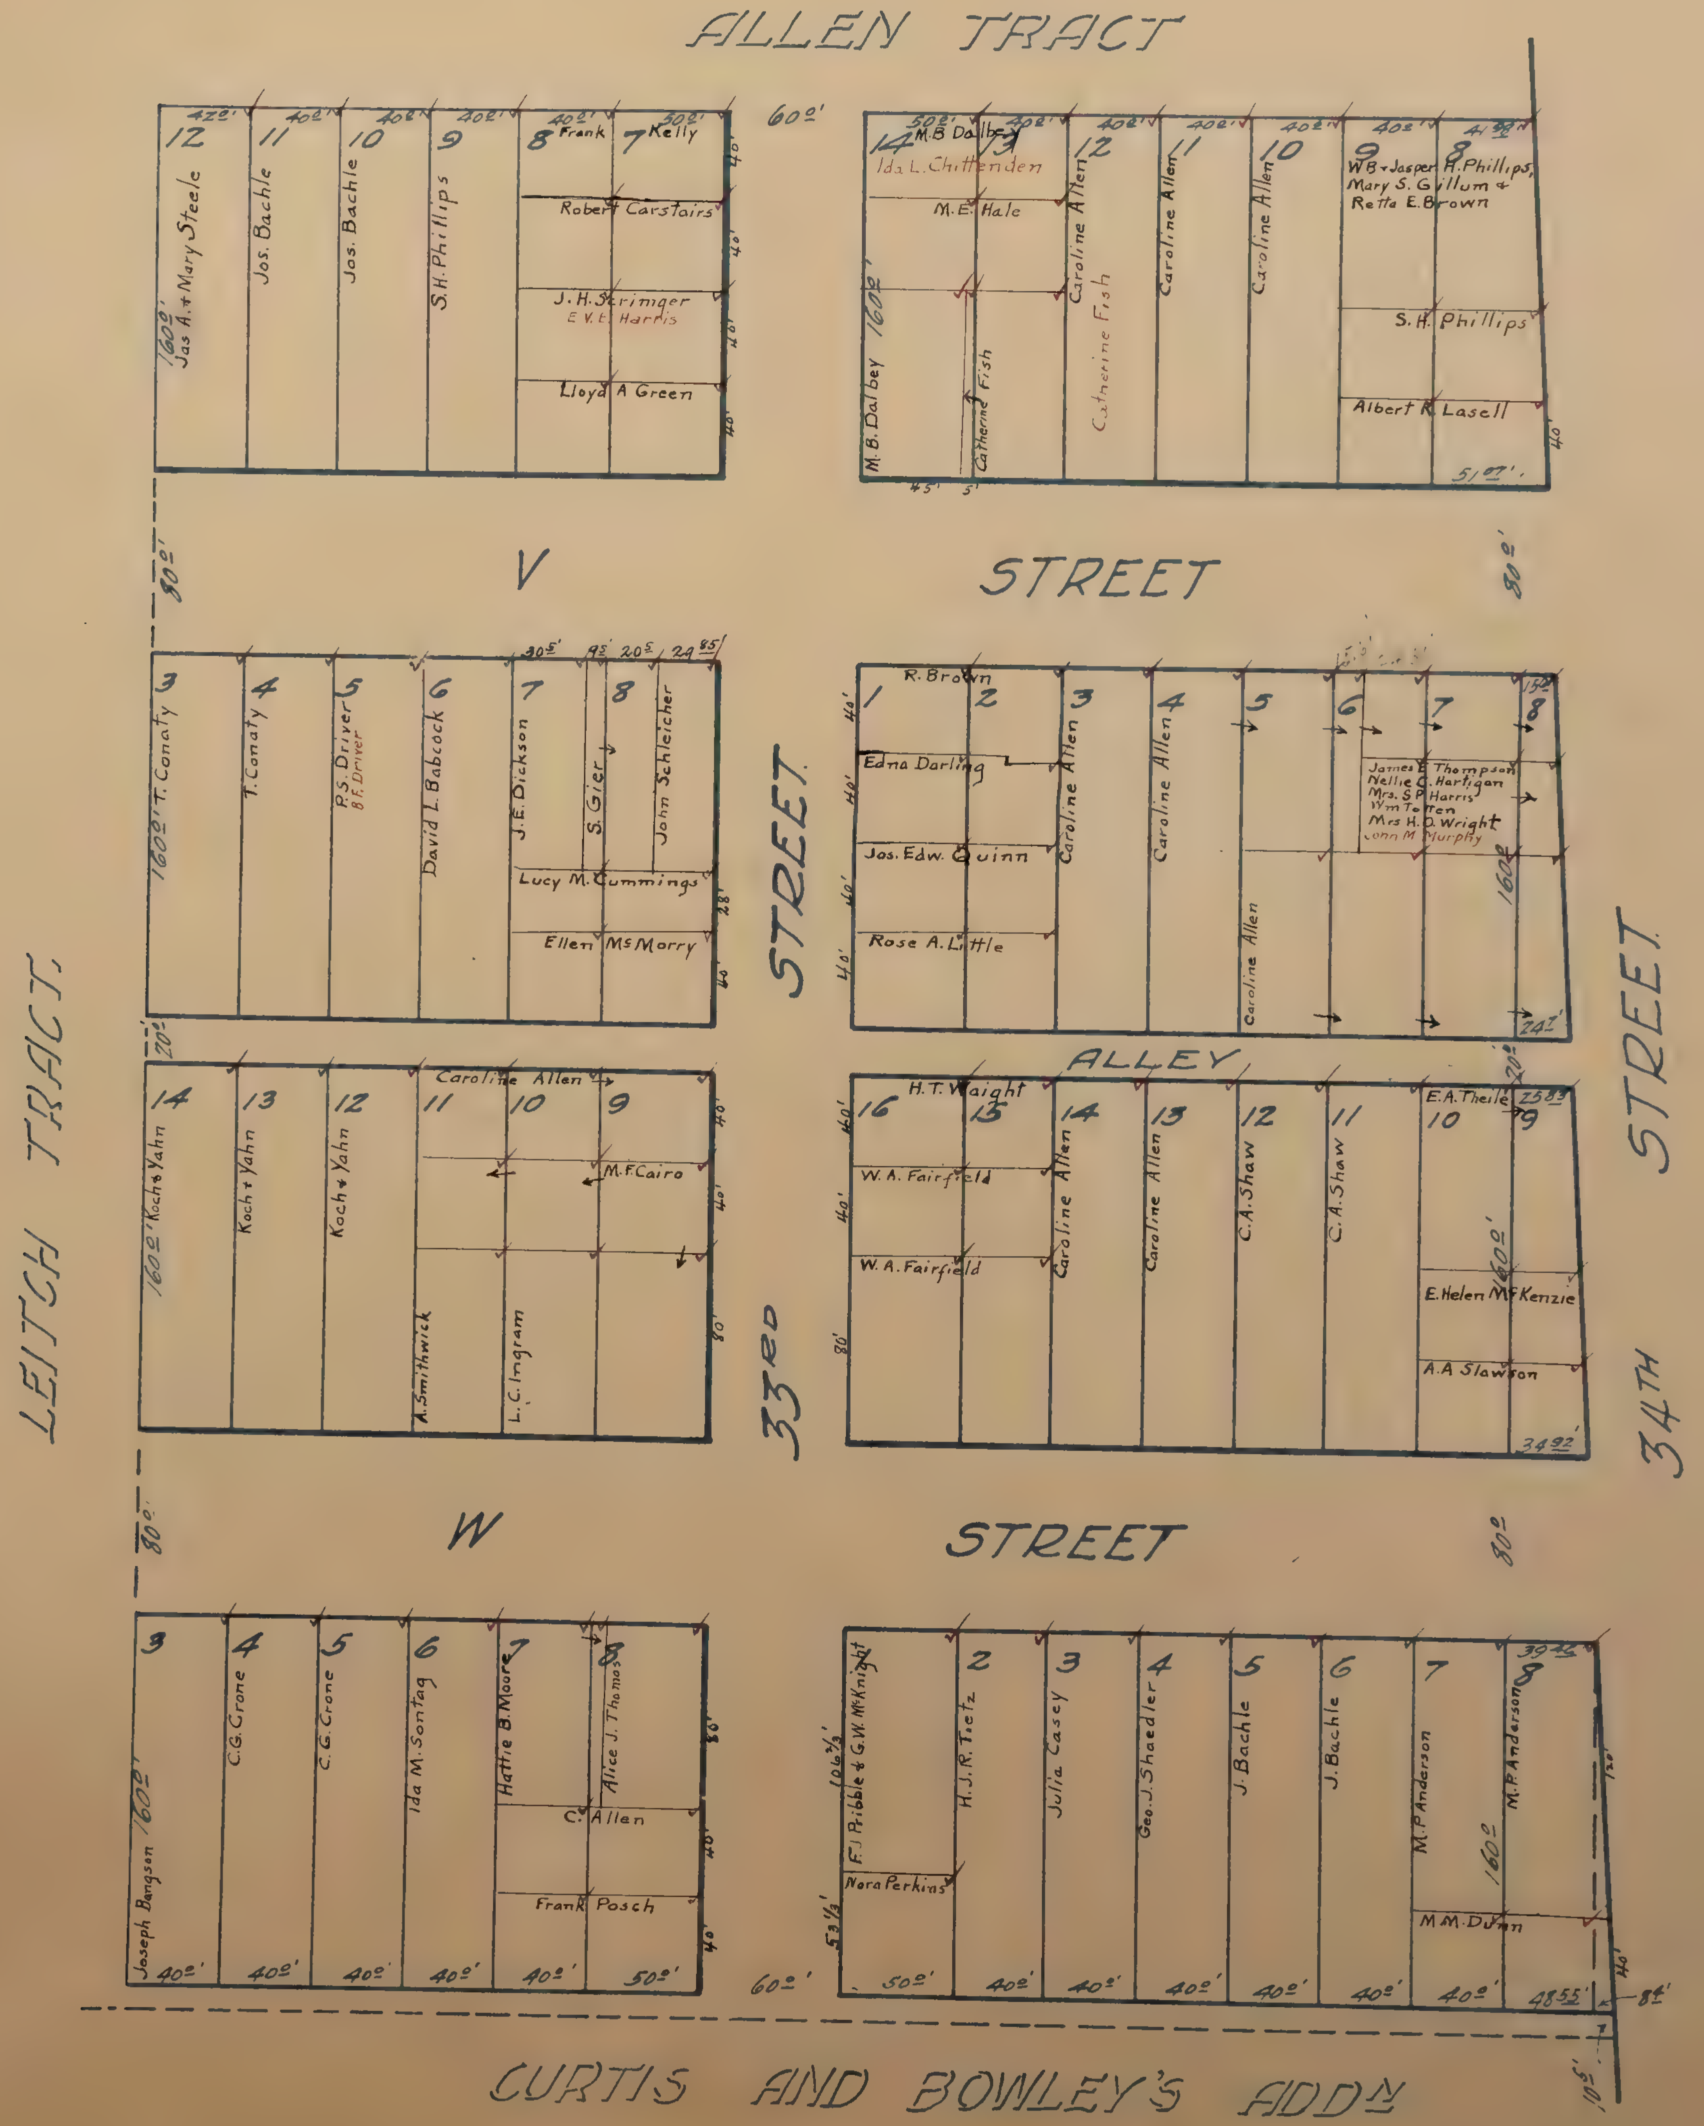

ALLEN TRACT
LEITCH TRACT.
V STREET
W STREET
33RD STREET.
34TH STREET
ALLEY
CURTIS AND BOWLEY'S ADDN
Jas A. + Mary Steele
Jos. Bachle
Jos. Bachle
S.H. Phillips
Frank Kelly
Robert Carstairs
J.H. Scrimger
E.V.E. Harris
Lloyd A Green
M.B. Dalbey
Ida L. Chittenden
M.E. Hale
M.B. Dalbey
Catherine Fish
Caroline Allen
Catherine Fish
Caroline Allen
Caroline Allen
W.B. + Jasper H. Phillips, Mary S. Gillum + Retta E. Brown
S.H. Phillips
Albert R. Lasell
T. Conaty
T. Conaty
P.S. Driver
B.F. Driver
David L. Babcock
J.E. Dickson
S. Gier
John Schleicher
Lucy M. Cummings
Ellen McMorry
R. Brown
Edna Darling
Jos. Edw. Quinn
Rose A. Little
Caroline Allen
Caroline Allen
Caroline Allen
James E. Thompson
Nellie C. Hartigan
Mrs. S.P. Harris
Wm Totten
Mrs H.D. Wright
John M. Murphy
Koch + Yahn
Koch + Yahn
Koch + Yahn
Caroline Allen
M.F. Cairo
A. Smithwick
L.C. Ingram
H.T. Waight
W.A. Fairfield
W.A. Fairfield
Caroline Allen
Caroline Allen
C.A. Shaw
C.A. Shaw
E.A. Theile
E. Helen McKenzie
A.A. Slawson
Joseph Bangson
C.G. Crone
C.G. Crone
Ida M. Sontag
Hattie B. Moore
Alice J. Thomas
C. Allen
Frank Posch
F.J. Pribble + G.W. McKnight
Nora Perkins
H.J.R. Tietz
Julia Casey
Geo. J. Shaedler
J. Bachle
J. Bachle
M.P. Anderson
M.P. Anderson
M.M. Dunn

ALTAMONT TRACT ✓✓

Scale 1 Inch = 120 feet.

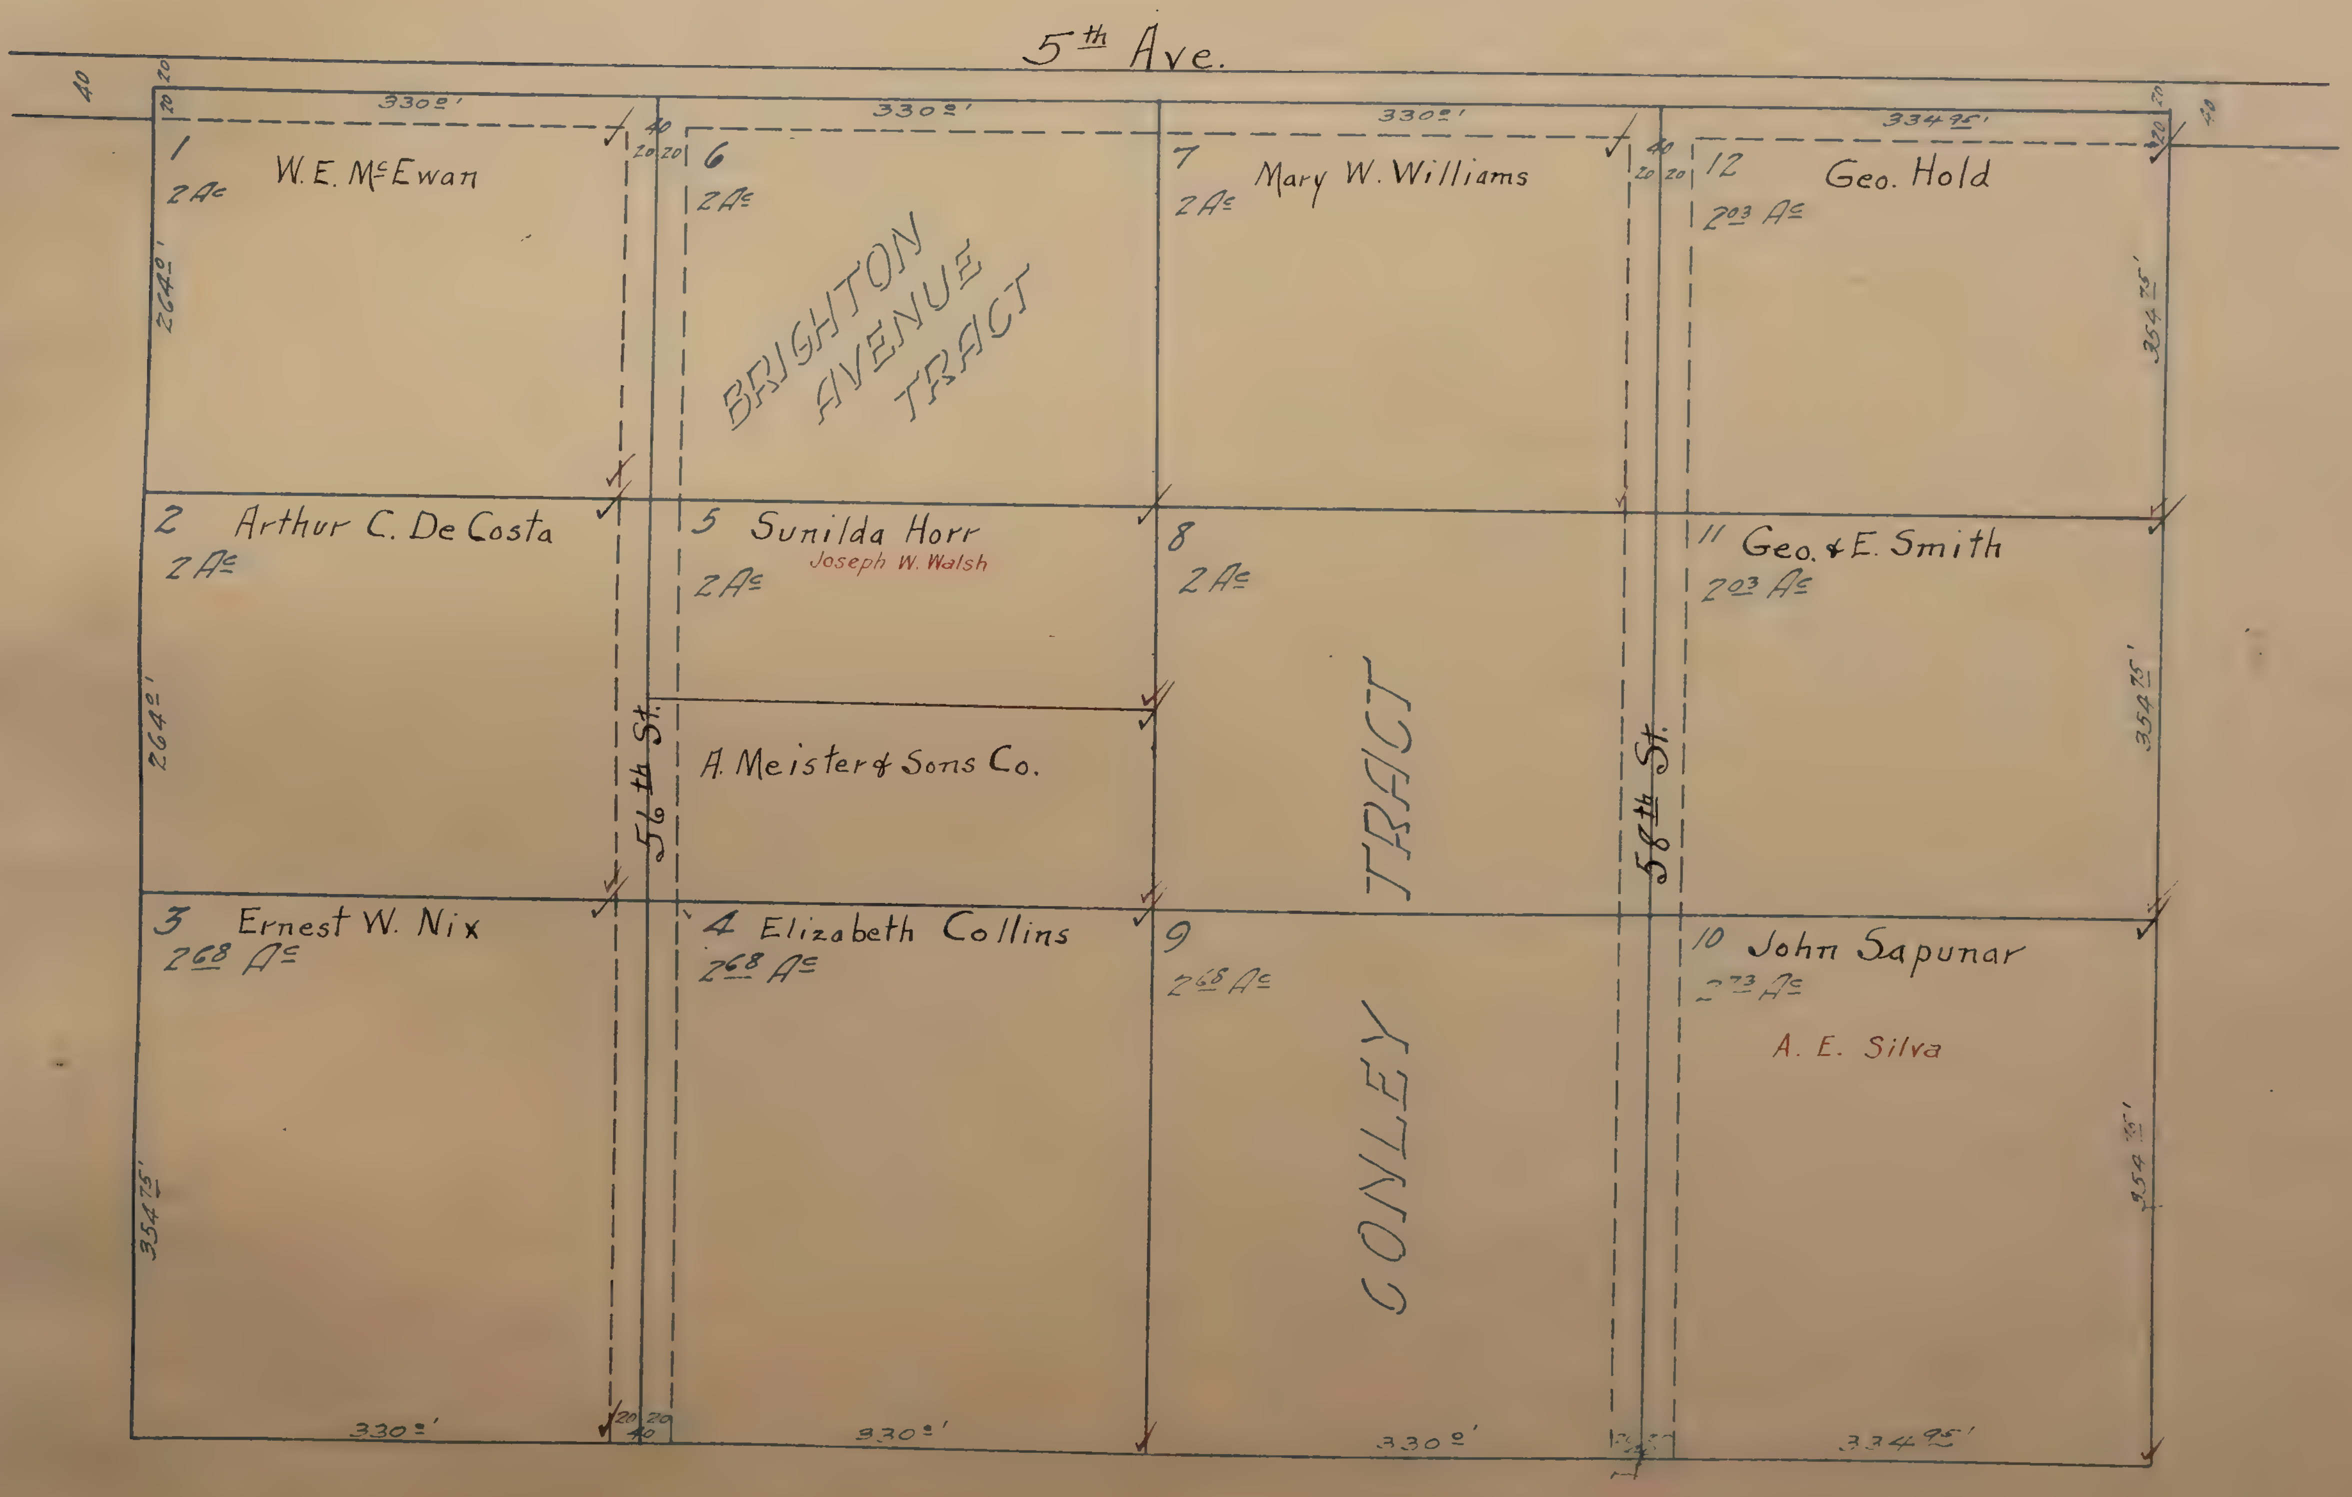
5th Ave.
40
20 20
330'
1 W. E. McEwan
2 Ac
264'
6
2 Ac
BRIGHTON AVENUE TRACT
7 Mary W. Williams
2 Ac
12 Geo. Hold
2.03 Ac
334.95'
354.75'
2 Arthur C. De Costa
2 Ac
5 Sunilda Horr
Joseph W. Walsh
2 Ac
8
2 Ac
11 Geo. & E. Smith
2.03 Ac
A. Meister & Sons Co.
56th St.
58th St.
CONLEY TRACT
3 Ernest W. Nix
2.68 Ac
4 Elizabeth Collins
2.68 Ac
9
2.68 Ac
10 John Sapunar
2.73 Ac
A. E. Silva
354.75'
330'
330'
330'
334.95'

ALTA VISTA AND ADDITION ✓✓

Scale 1 Inch = 80 feet.

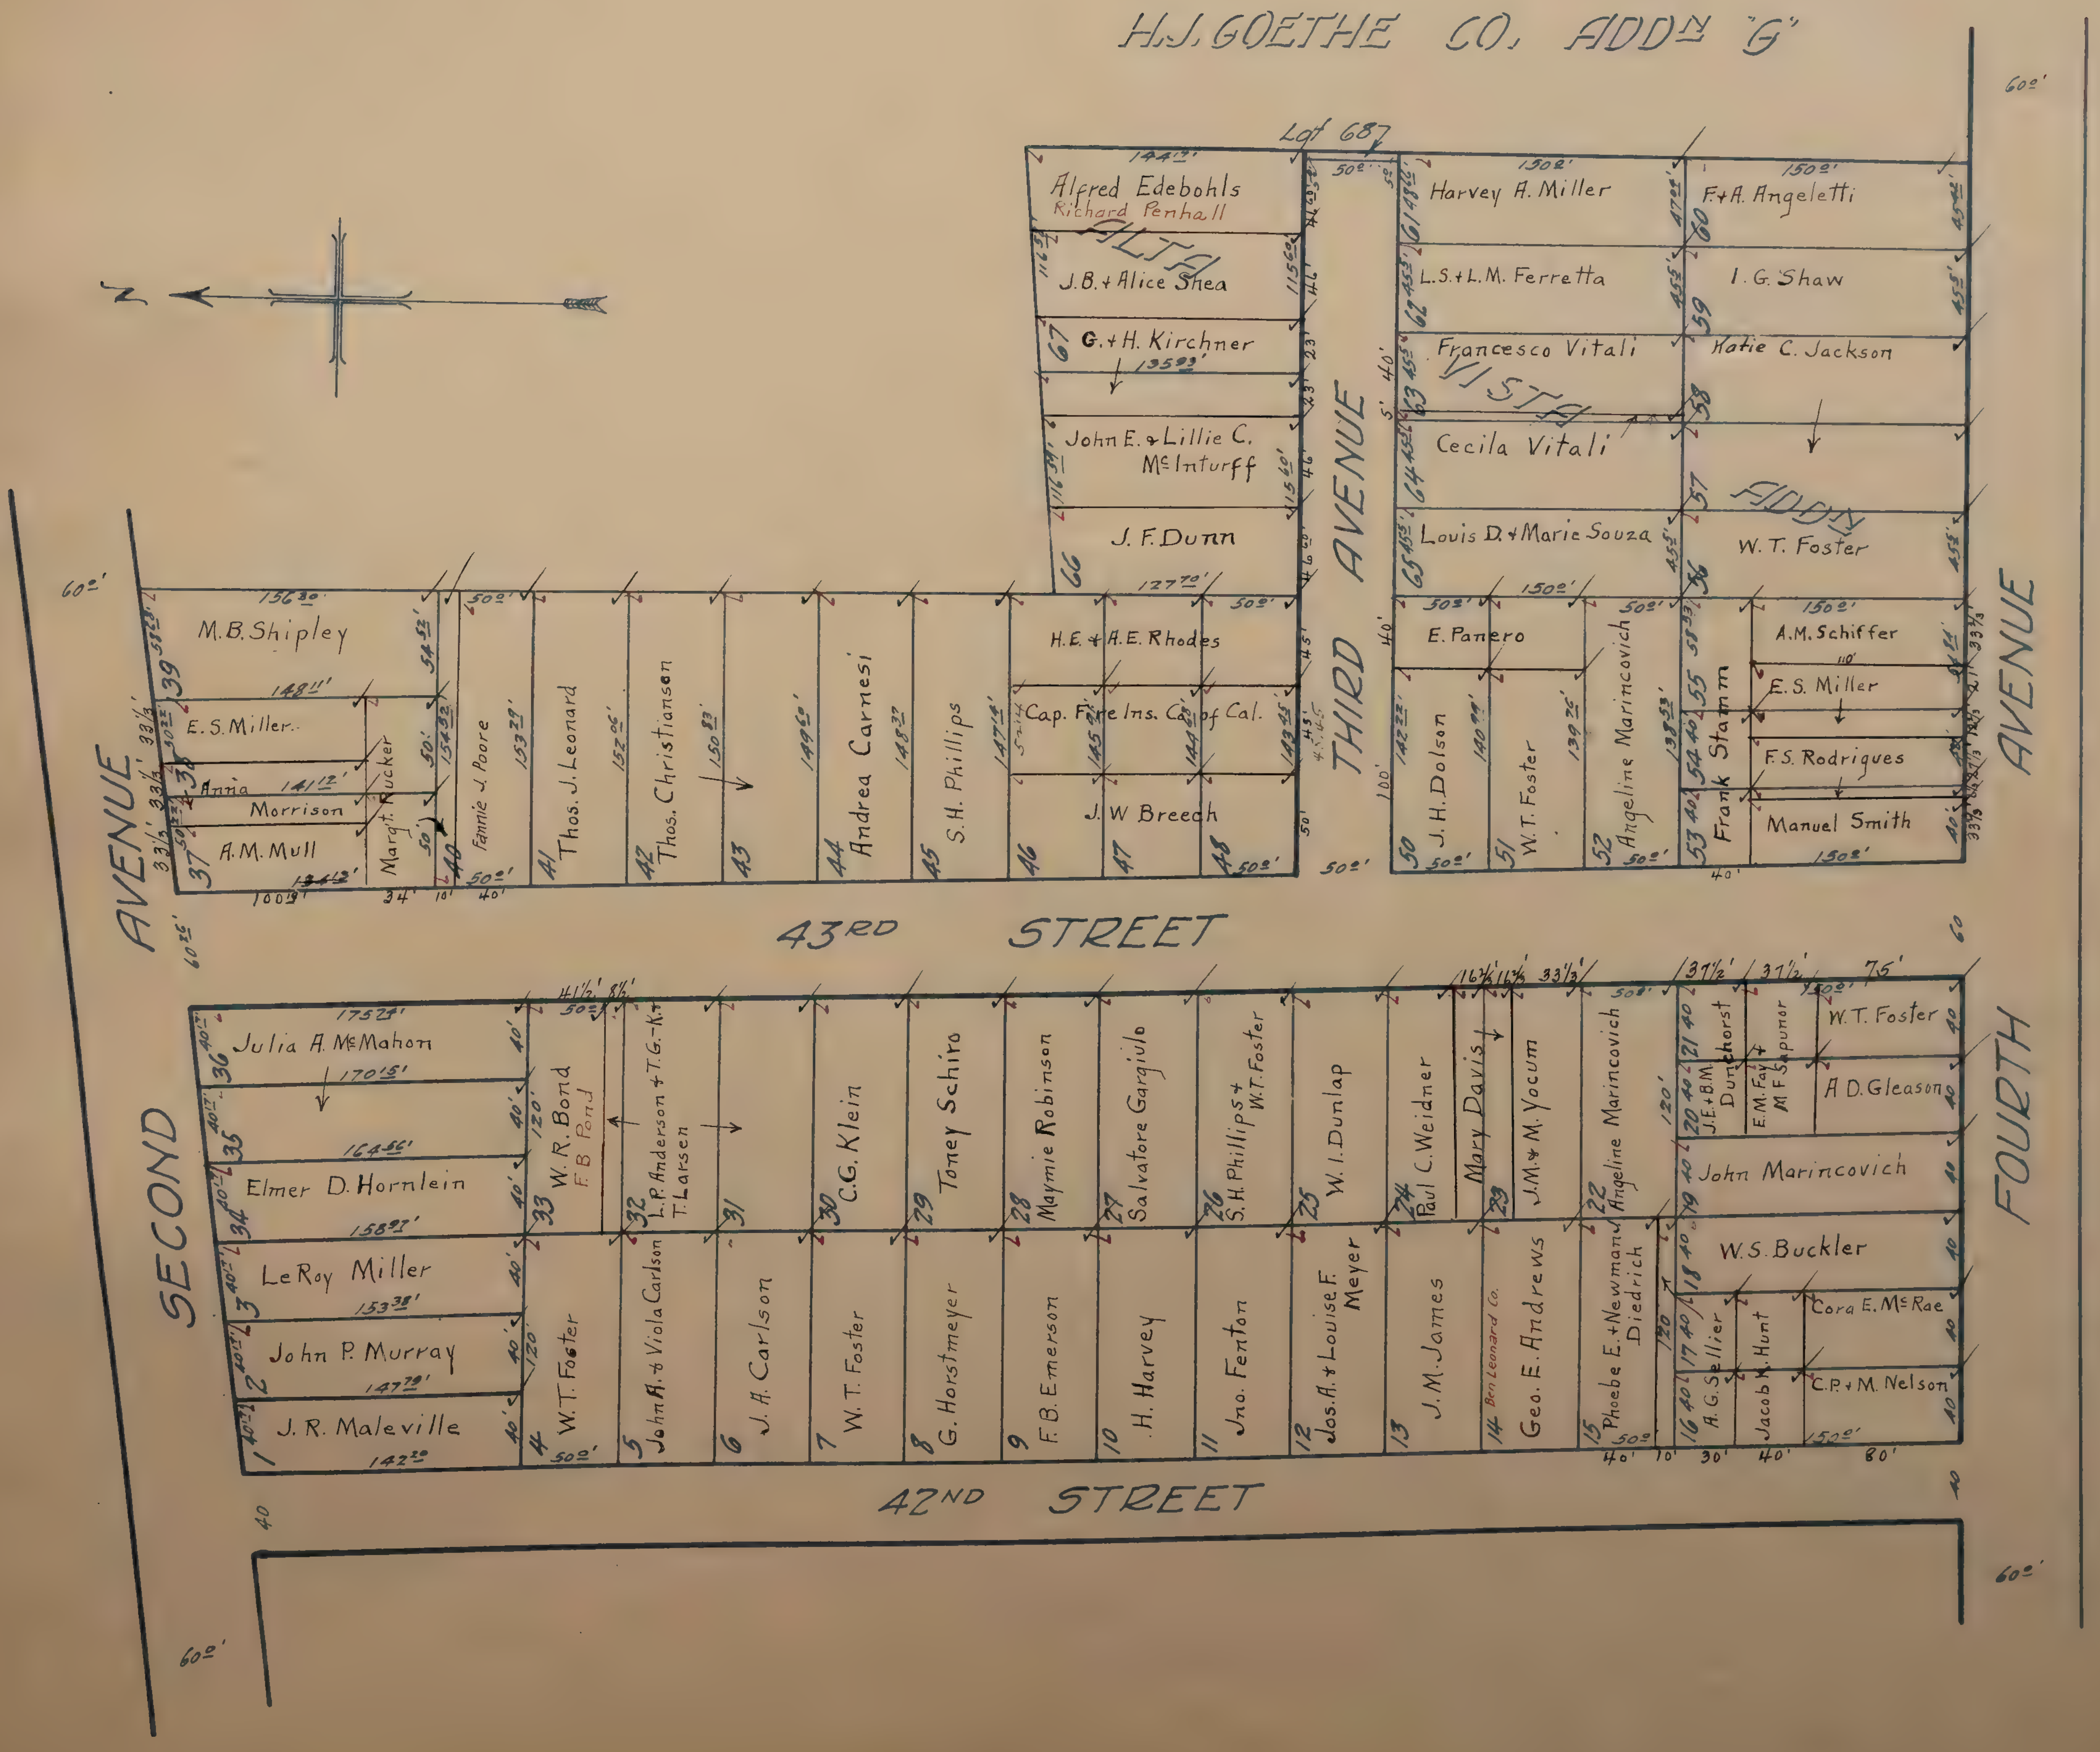
H.J. GOETHE CO. ADDN "G"
N
Lot 687
ALTA VISTA ADDN
SECOND AVENUE
THIRD AVENUE
FOURTH AVENUE
43RD STREET
42ND STREET
Alfred Edebohls
Richard Penhall
J.B. + Alice Shea
G. + H. Kirchner
John E. + Lillie C. McInturff
J. F. Dunn
H.E. + A.E. Rhodes
Cap. Fire Ins. Co. of Cal.
J. W. Breech
Harvey A. Miller
F + A. Angeletti
L.S. + L.M. Ferretta
I. G. Shaw
Francesco Vitali
Katie C. Jackson
Cecila Vitali
Louis D. + Marie Souza
W. T. Foster
E. Panero
A.M. Schiffer
E. S. Miller
F. S. Rodrigues
Manuel Smith
J. H. Dolson
W. T. Foster
Angeline Marincovich
Frank Stamm
M. B. Shipley
E. S. Miller
Anna Morrison
A. M. Mull
Marg't Rucker
Fannie J. Poore
Thos. J. Leonard
Thos. Christianson
Andrea Carnesi
S. H. Phillips
Julia A. McMahon
Elmer D. Hornlein
LeRoy Miller
John P. Murray
J. R. Maleville
W. R. Bond
F.B. Bond
L.P. Anderson + T.G. Kr
T. Larsen
C.G. Klein
Toney Schiro
Maymie Robinson
Salvatore Gargiulo
S.H. Phillips + W.T. Foster
W. I. Dunlap
Paul C. Weidner
Mary Davis
J.M. + M. Yocum
Angeline Marincovich
J.E. + B.M. Dutchorst
E.M. Fay + M.F. Sapuner
W. T. Foster
A. D. Gleason
John Marincovich
W. S. Buckler
Cora E. McRae
C.P. + M. Nelson
W. T. Foster
John A. + Viola Carlson
J. A. Carlson
W. T. Foster
G. Horstmeyer
F. B. Emerson
H. Harvey
Jno. Fenton
Jos. A. + Louise F. Meyer
J. M. James
Ben Leonard Co.
Geo. E. Andrews
Phoebe E. + Newman Diedrich
A. G. Sellier
Jacob K. Hunt
60'
40'
50'
120'
150'
80'
30'
10'

ARCADIA ✓ ✓

Scale: 1 Inch = 80 feet.

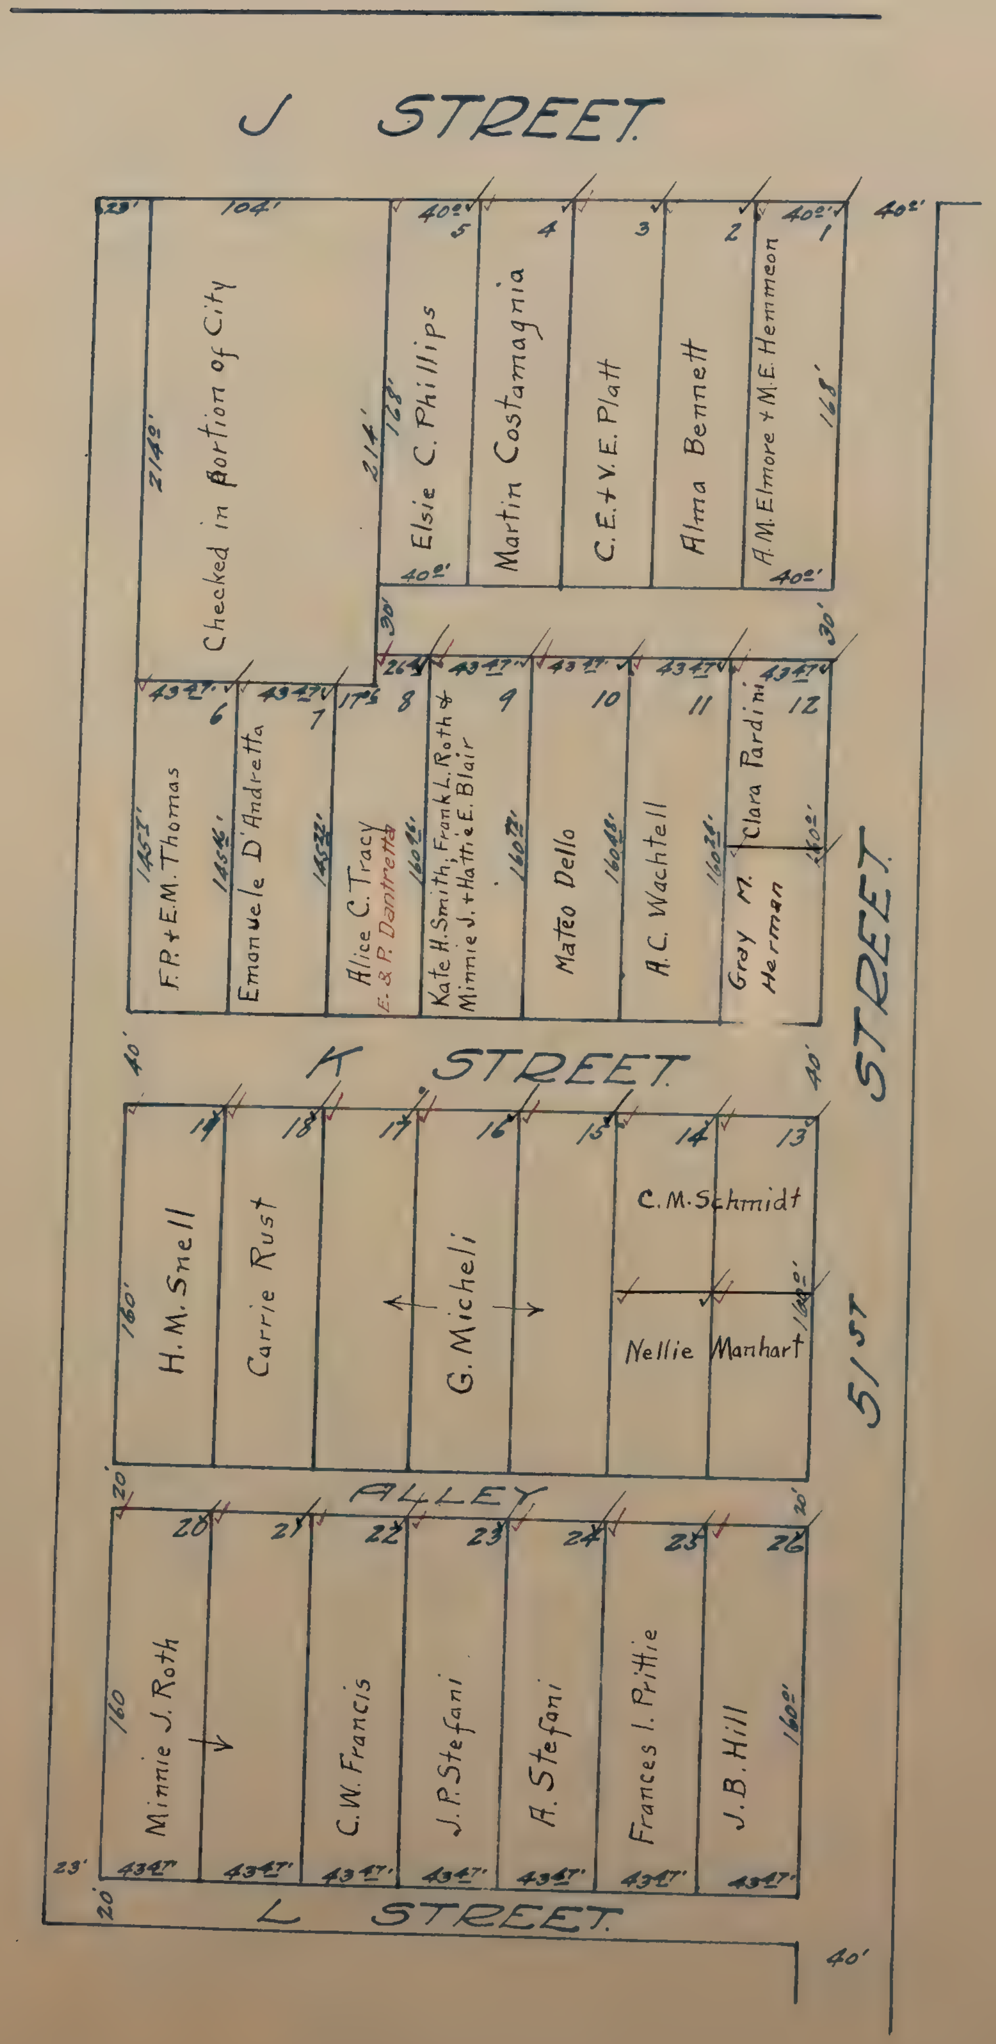
J STREET.
K STREET.
ALLEY
L STREET.
STREET.
51 ST
Checked in Portion of City
104'
23'
214 9'
214'
30'
1 A.M. Elmore + M.E. Hemmeon 168' 40 2'
2 Alma Bennett
3 C.E. + V.E. Platt
4 Martin Costamagnia
5 Elsie C. Phillips 168' 40 2'
40 2'
6 F.P. + E.M. Thomas 145 5' 43 47'
7 Emanuele D'Andretta 145 6' 43 47'
8 Alice C. Tracy 145 32' 17 5
E. & P. Dantretta
Kate H. Smith, Frank L. Roth & Minnie J. + Hattie E. Blair 160 16' 26
9 Mateo Dello 160 7' 43 47'
10 A.C. Wachtell 160 48' 43 47'
11 Gray M. Herman 160 21' 43 47'
12 Clara Pardini 43 47' 160 2'
40'
13
14
C.M. Schmidt
Nellie Manhart
15
16 G. Micheli
17
18 Carrie Rust
19 H.M. Snell 160'
160 2'
20'
20 Minnie J. Roth 160
21
22 C.W. Francis
23 J.P. Stefani
24 A. Stefani
25 Frances I. Prittie
26 J.B. Hill 160 2'
43 47'
23'
20'
40'

Arcadia

AVERY TRACT ✓✓

Scale 1 Inch = 40 feet.

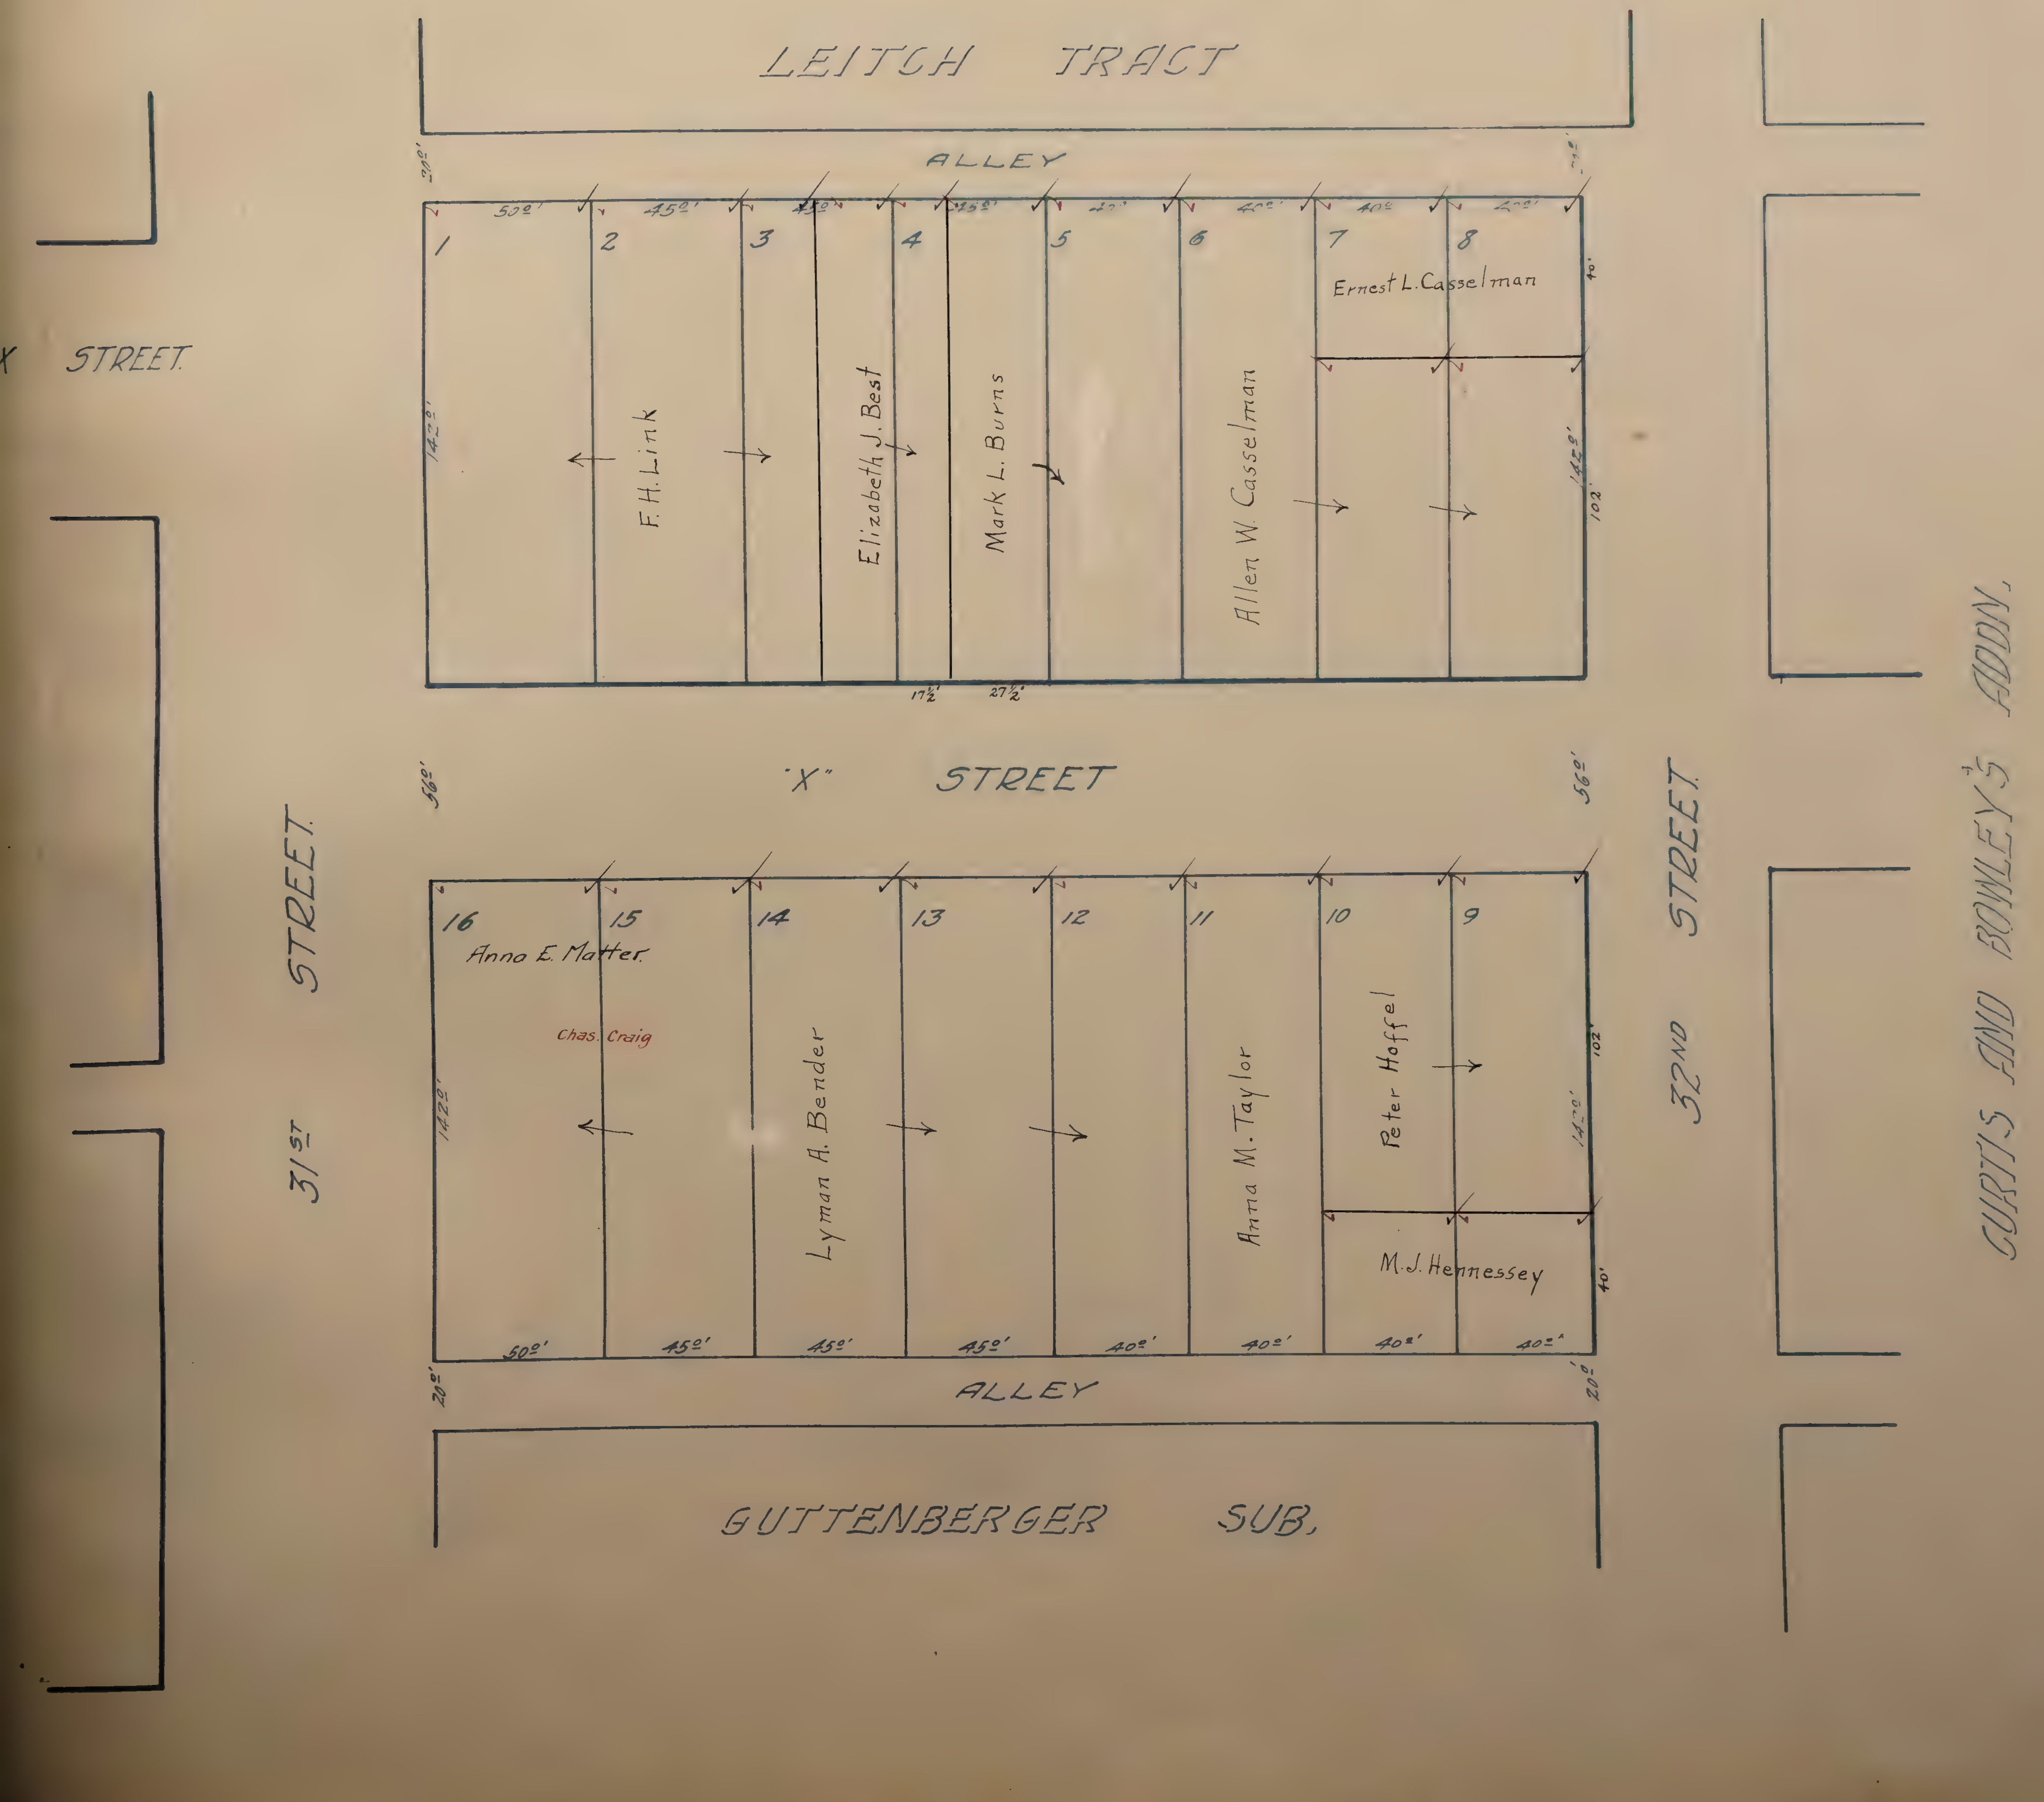
LEITCH TRACT
ALLEY
"X" STREET
X STREET
31ST STREET
32ND STREET
CURTIS AND BOWLEY'S ADDN.
GUTTENBERGER SUB.
ALLEY
1
2
3
4
5
6
7
8
F. H. Link
Elizabeth J. Best
Mark L. Burns
Allen W. Casselman
Ernest L. Casselman
16
15
14
13
12
11
10
9
Anna E. Matter
Chas. Craig
Lyman A. Bender
Anna M. Taylor
Peter Hoffel
M. J. Hennessey
50'
45'
40'
17½'
27½'
142'
102'
56'
20'

BATH TRACT ✓✓

Scale: 1 Inch = 80 feet

Blanks to Sac'to. Riverside Bath & Park Co.

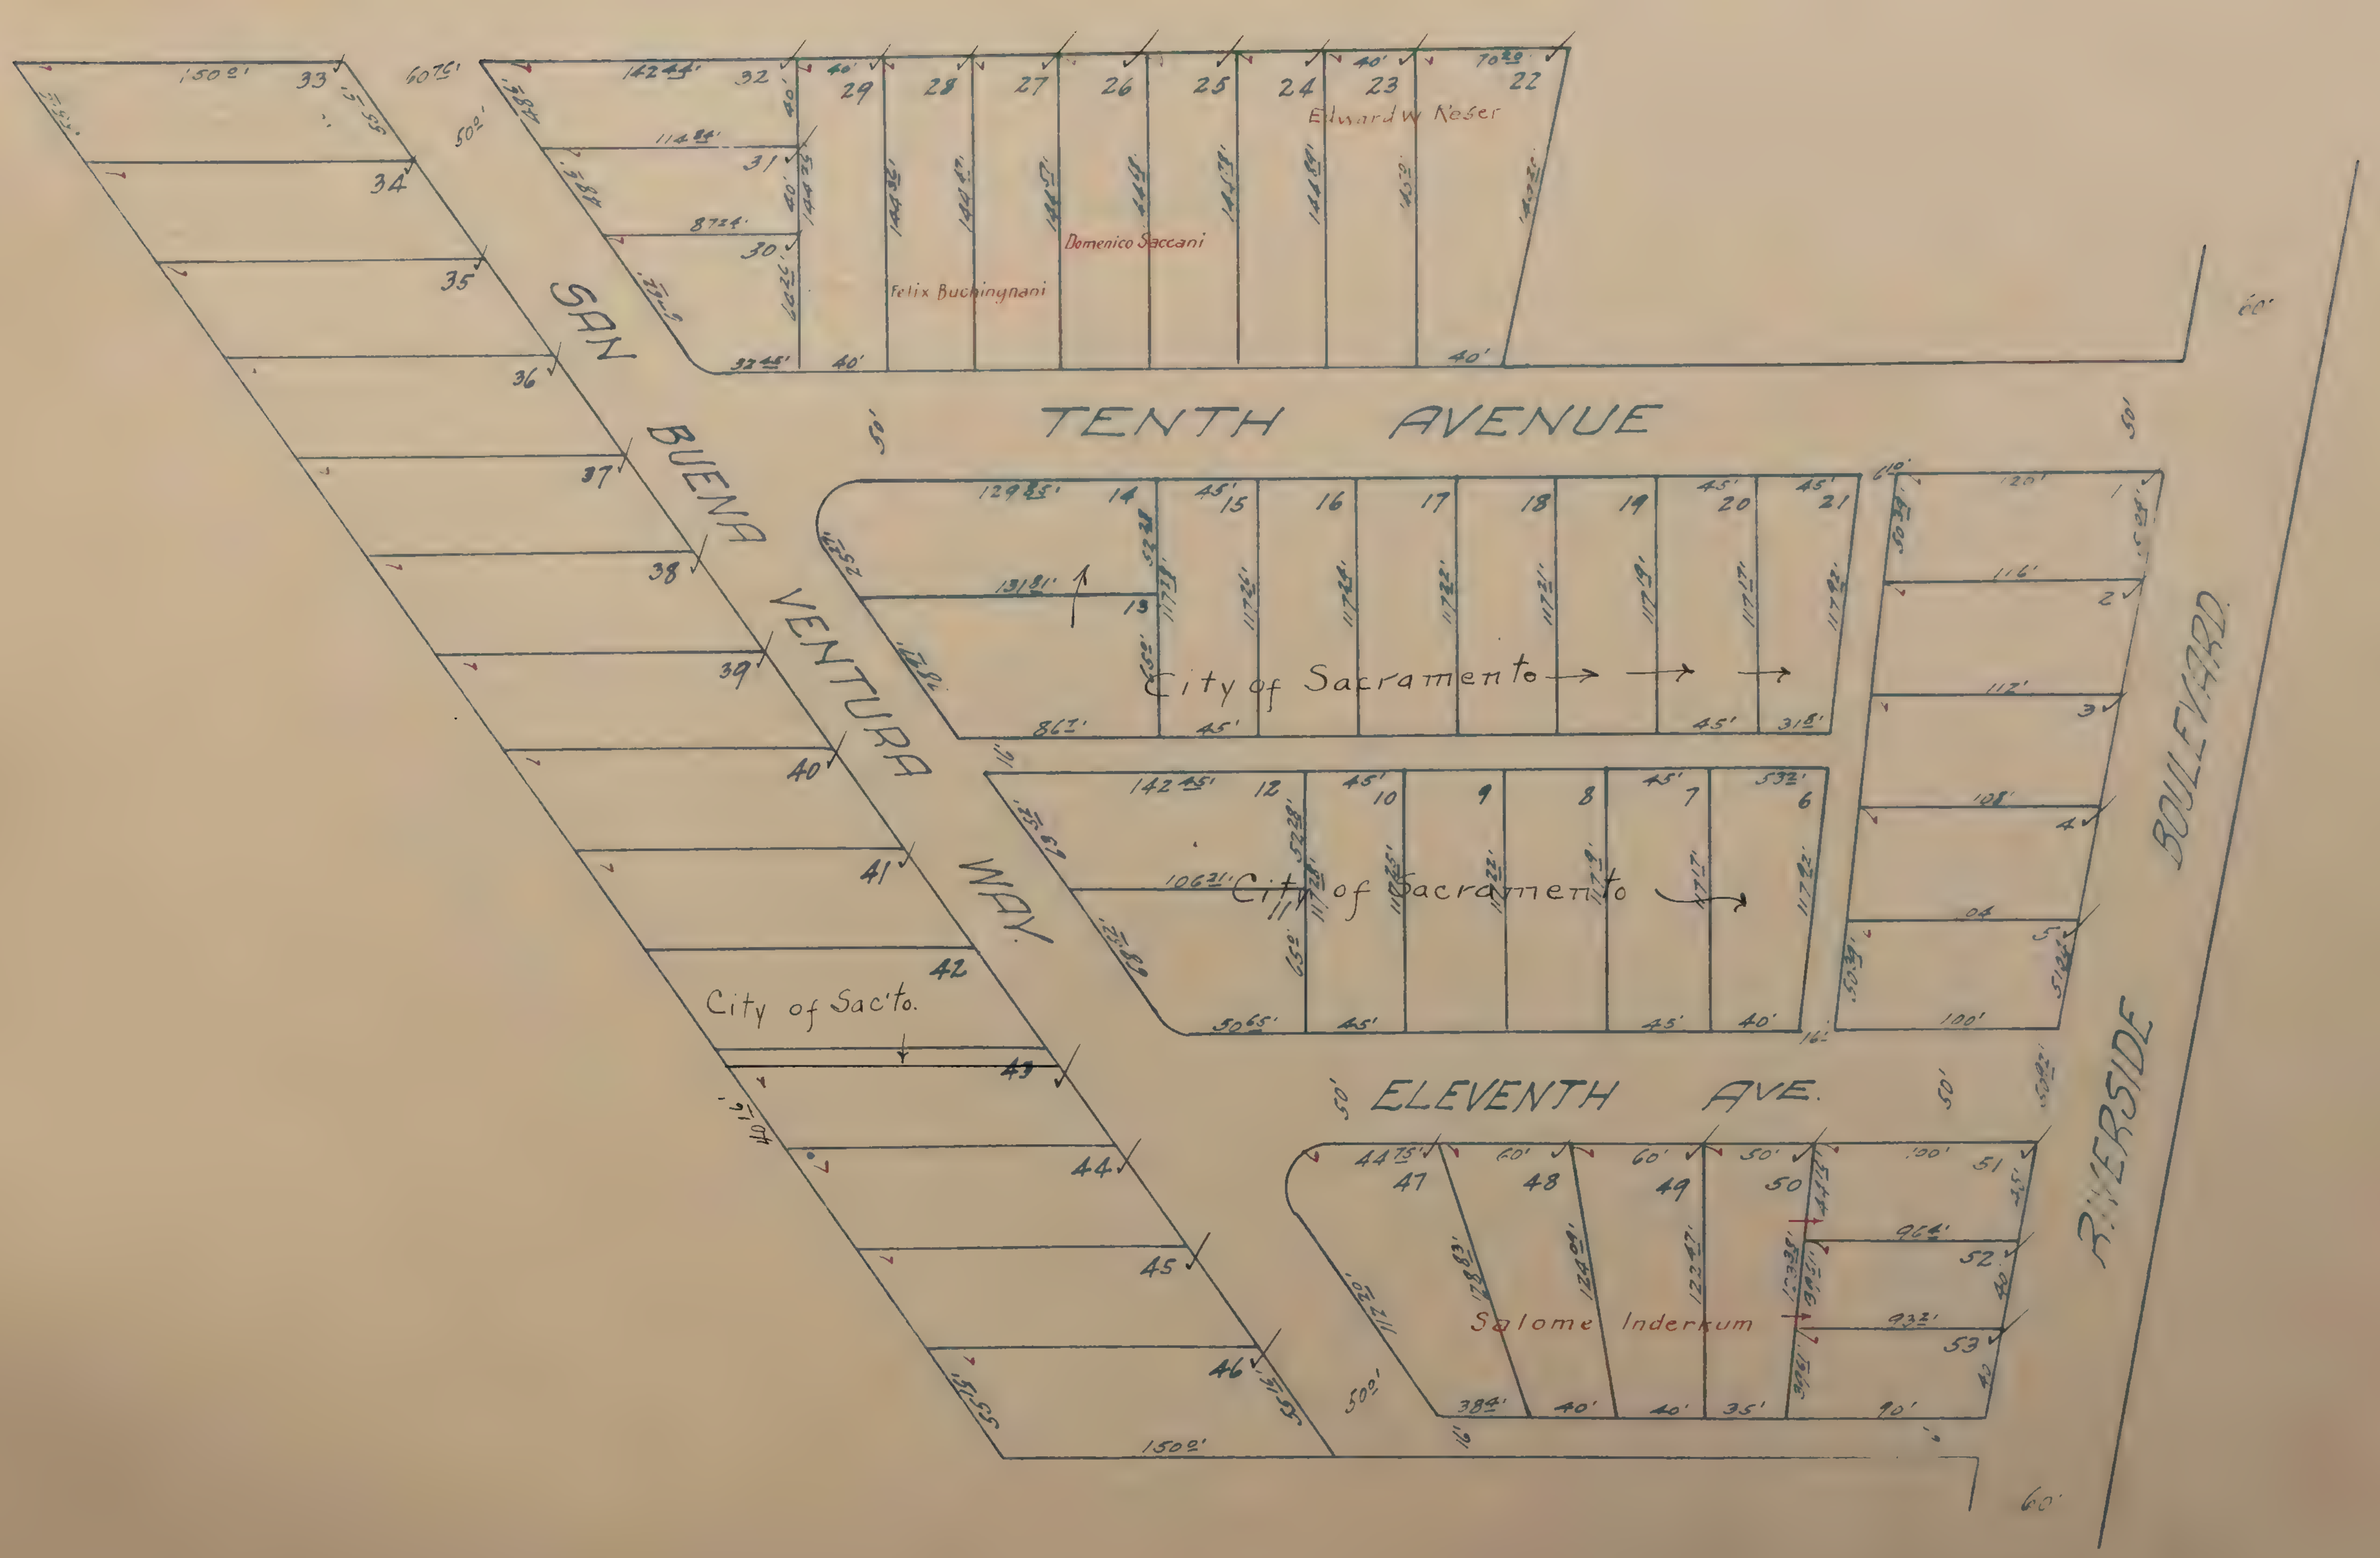

TENTH AVENUE
ELEVENTH AVE.
SAN BUENA VENTURA WAY
RIVERSIDE BOULEVARD
Edward W. Keser
Domenico Saccani
Felix Buchingnani
City of Sacramento
City of Sacramento
City of Sac'to.
Salome Inderkum
1
2
3
4
5
6
7
8
9
10
11
12
13
14
15
16
17
18
19
20
21
22
23
24
25
26
27
28
29
30
31
32
33
34
35
36
37
38
39
40
41
42
43
44
45
46
47
48
49
50
51
52
53
150.2'
150.2'
50'
60'
40'
45'
100'

BATH

BENJAMIN TRACT ✓

Scale: 1 Inch = 80 feet.

Blanks to W. R. Benjamin

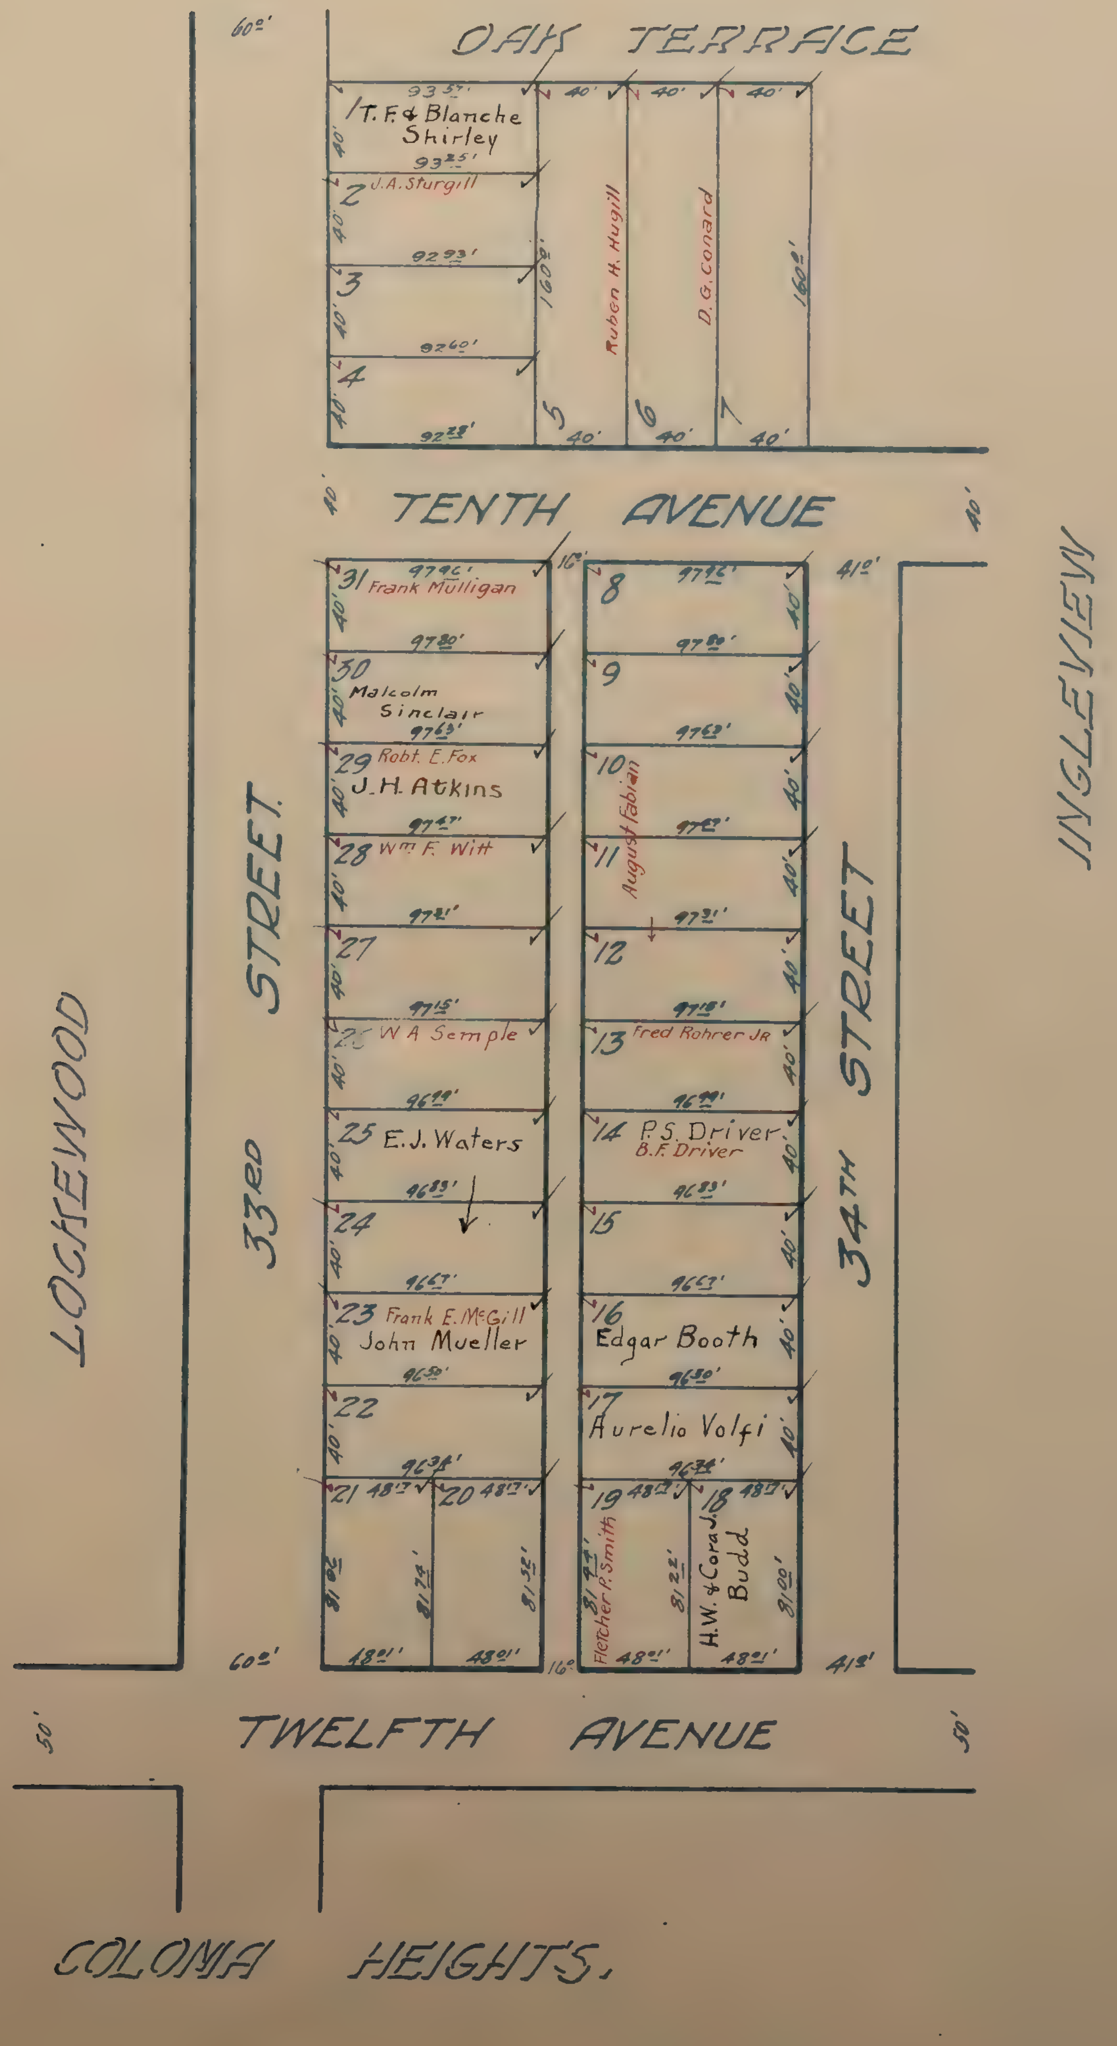
OAK TERRACE
TENTH AVENUE
TWELFTH AVENUE
LOCKEWOOD
33RD STREET
34TH STREET
INGLEVIEW
COLOMA HEIGHTS.
60'
40'
50'
16'
41'
1 T. F. & Blanche Shirley
2 J.A. Sturgill
3
4
5
6
7
Ruben H. Hugill
D.G. Conard
160'
93.55'
93.25'
92.93'
92.60'
92.28'
31 Frank Mulligan
30 Malcolm Sinclair
29 Robt. E. Fox
J.H. Atkins
28 Wm F. Witt
27
26 W A Semple
25 E.J. Waters
24
23 Frank E. McGill
John Mueller
22
21
20
8
9
10
11
August Fabian
12
13 Fred Rohrer JR
14 P.S. Driver
B.F. Driver
15
16 Edgar Booth
17 Aurelio Volfi
19
Fletcher P. Smith
18
H.W. & Cora J. Budd
97.96'
97.80'
97.63'
97.47'
97.31'
97.15'
96.99'
96.83'
96.67'
96.50'
96.34'
48.17'
48.01'
81.93'
81.74'
81.55'
81.22'
81.00'

Benjamin

BERT TRACT ✓✓

Scale: 1 Inch = 40 feet.

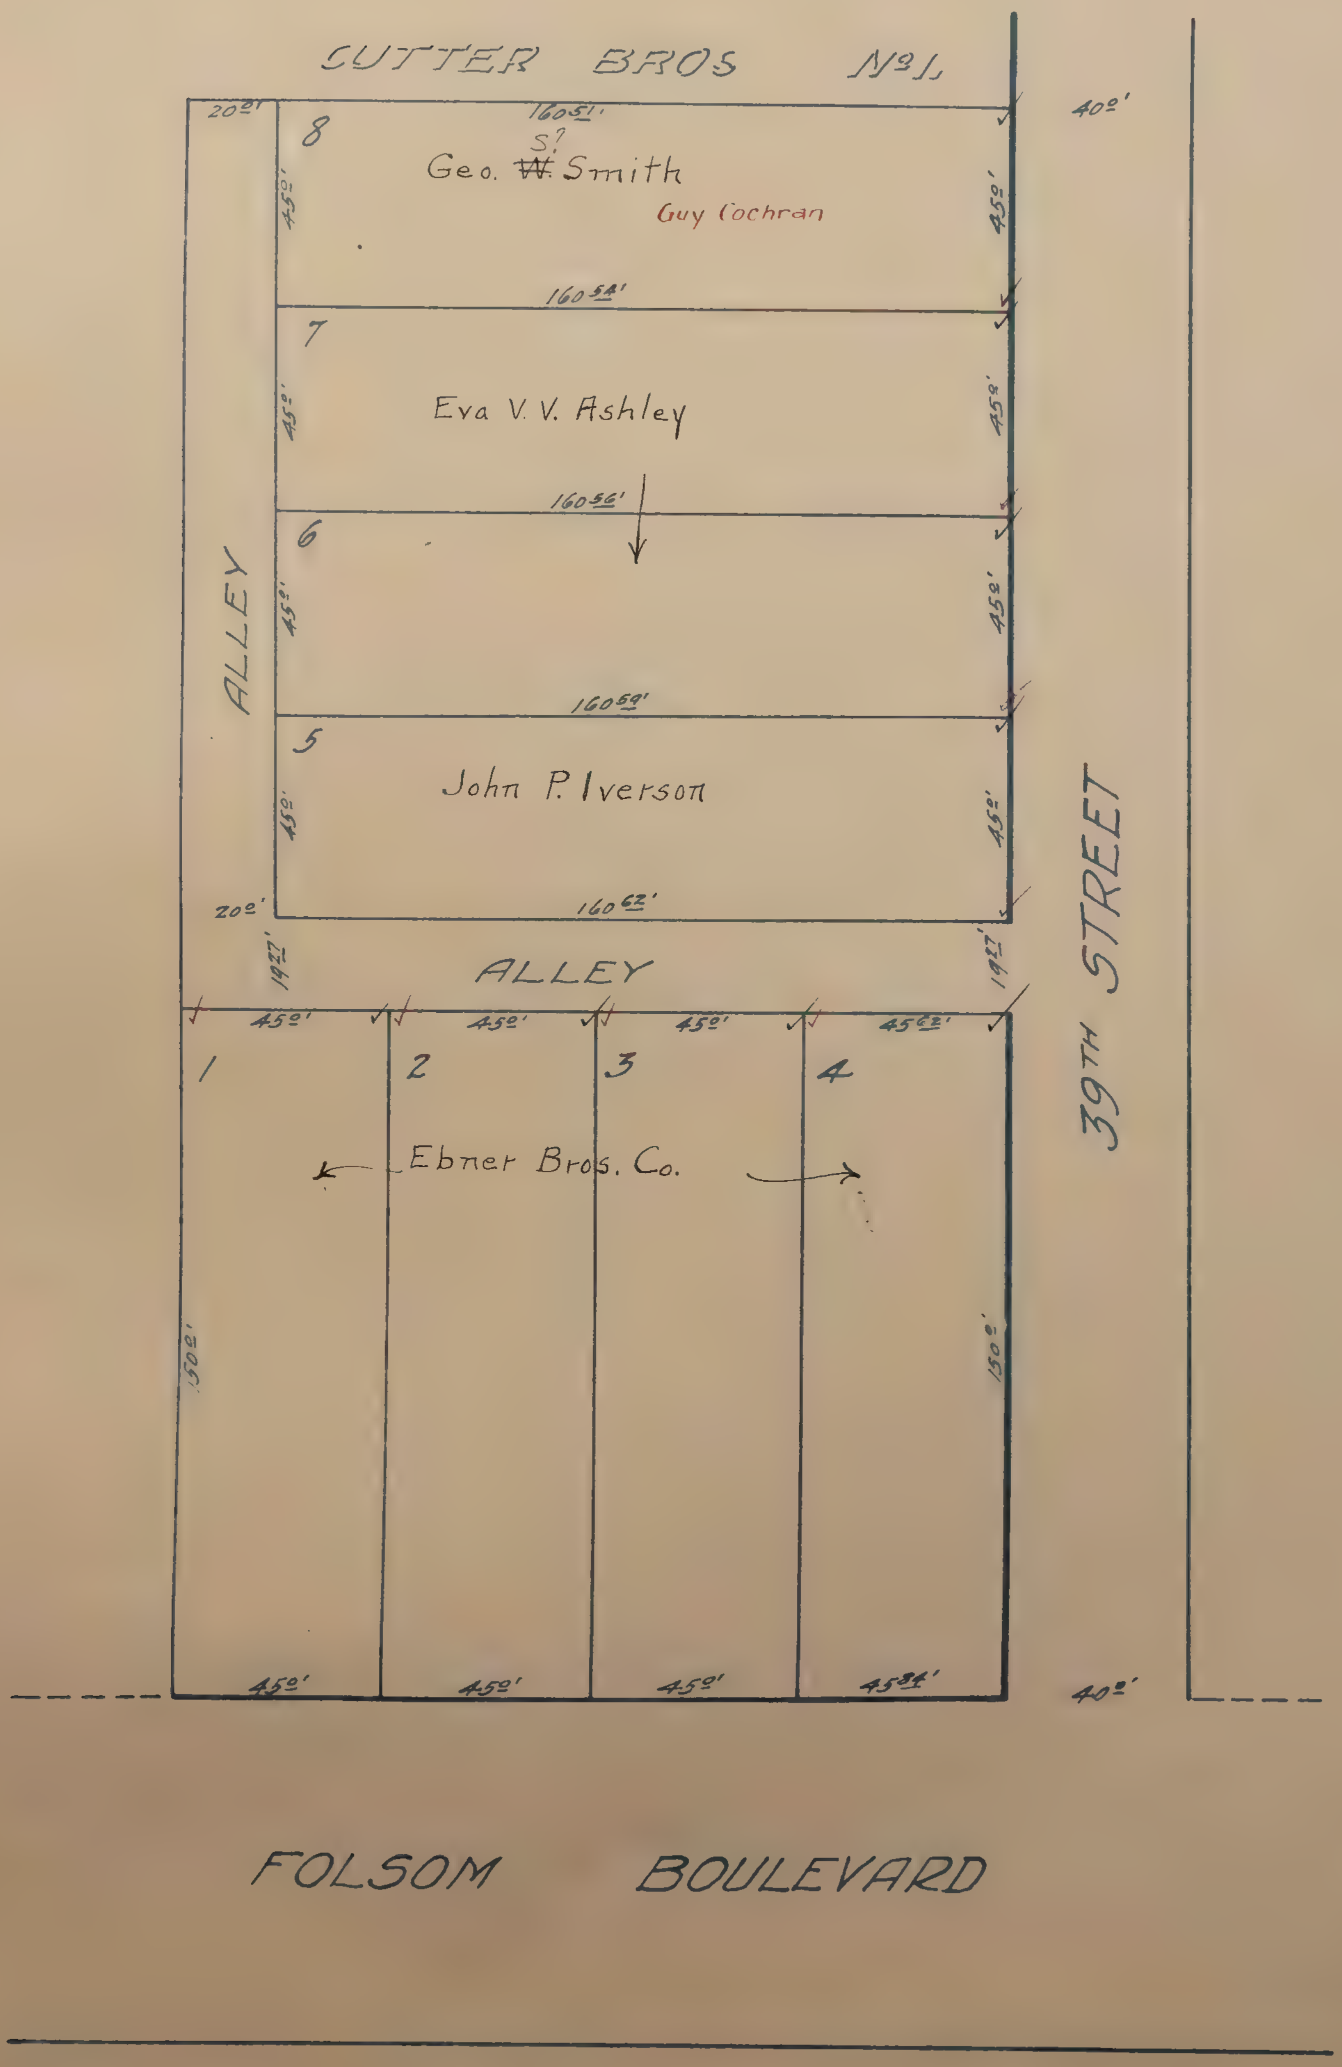
CUTTER BROS No. 1
20^{0}'
160^{51}'
8
S?
Geo. ~~W.~~ Smith
Guy Cochran
45^{0}'
45^{0}'
40^{0}'
160^{54}'
7
Eva V. V. Ashley
45^{0}'
45^{0}'
160^{56}'
6
45^{0}'
45^{0}'
ALLEY
160^{59}'
5
John P. Iverson
45^{0}'
45^{0}'
20^{0}'
160^{62}'
19^{27}'
ALLEY
19^{27}'
45^{0}'
45^{0}'
45^{0}'
45^{62}'
1
2
3
4
Ebner Bros. Co.
150^{0}'
150^{0}'
45^{0}'
45^{0}'
45^{0}'
45^{84}'
40^{0}'
39TH STREET
FOLSOM BOULEVARD

E. J. BODEN SUBDIVISION ✓✓

Scale: 1 Inch = 80 feet.

NOTE: South fractional part of Lot C of J. B. McIntyre Tract.

Blanks to E. J. Boden

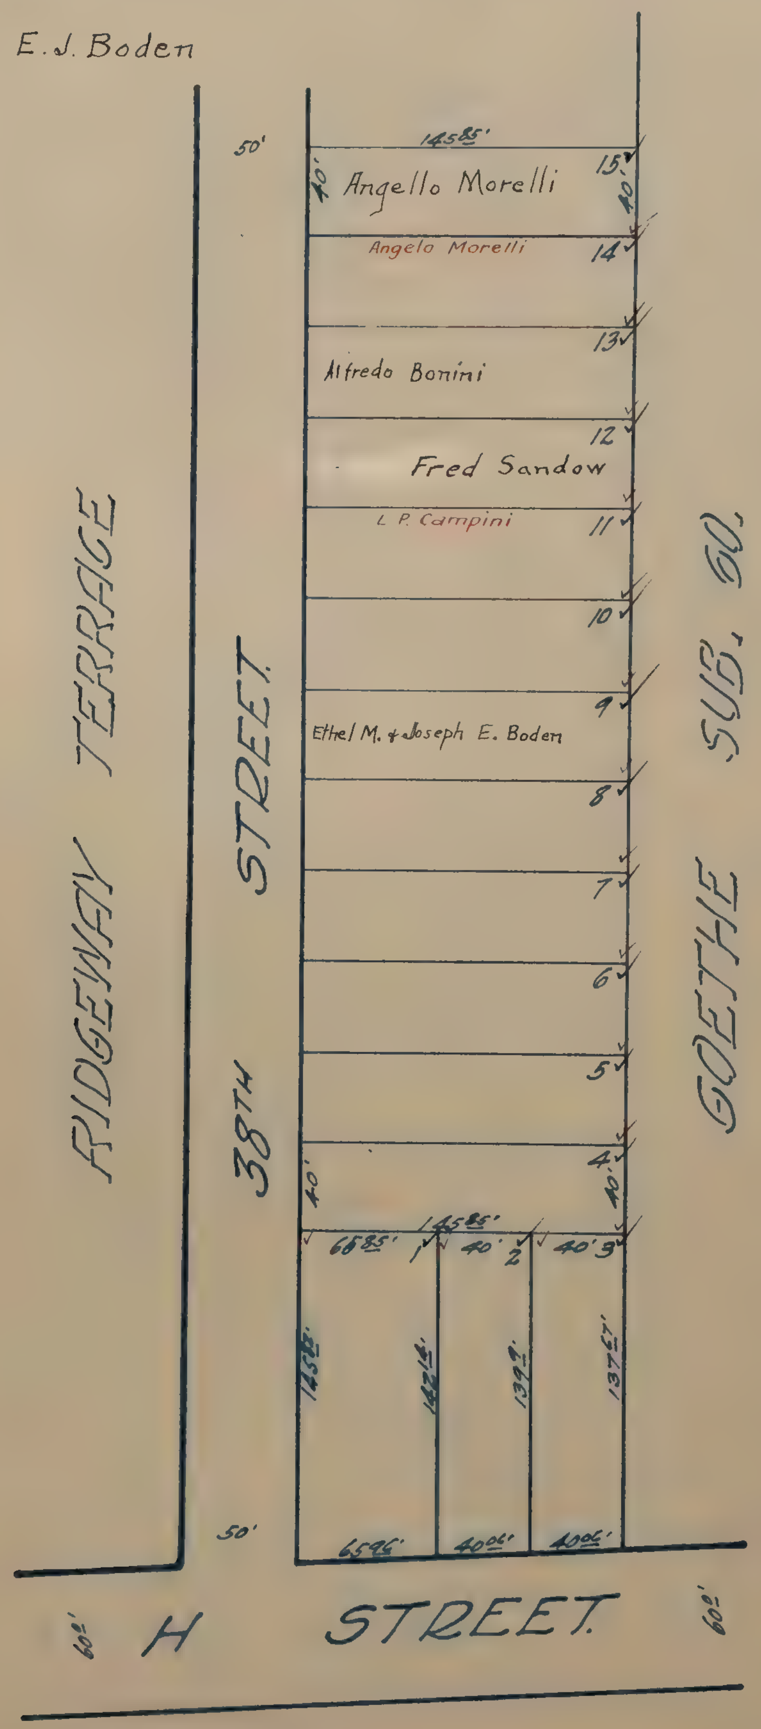
RIDGEWAY TERRACE
38TH STREET
GOETHE SUB. 60.
H STREET.
50'
50'
60'
60'
145.85'
40'
40'
Angello Morelli
15
Angelo Morelli
14
13
Alfredo Bonini
12
Fred Sandow
L. P. Campini
11
10
9
Ethel M. & Joseph E. Boden
8
7
6
5
4
40'
40'
145.85'
66.85'
1
40'
2
40'
3
139.9'
137.7'
65.95'
40.06'
40.06'

SUBDIVISION OF LOT 22 OF ✓✓
BONITA TERRACE

Scale : 1 Inch = 40 feet.

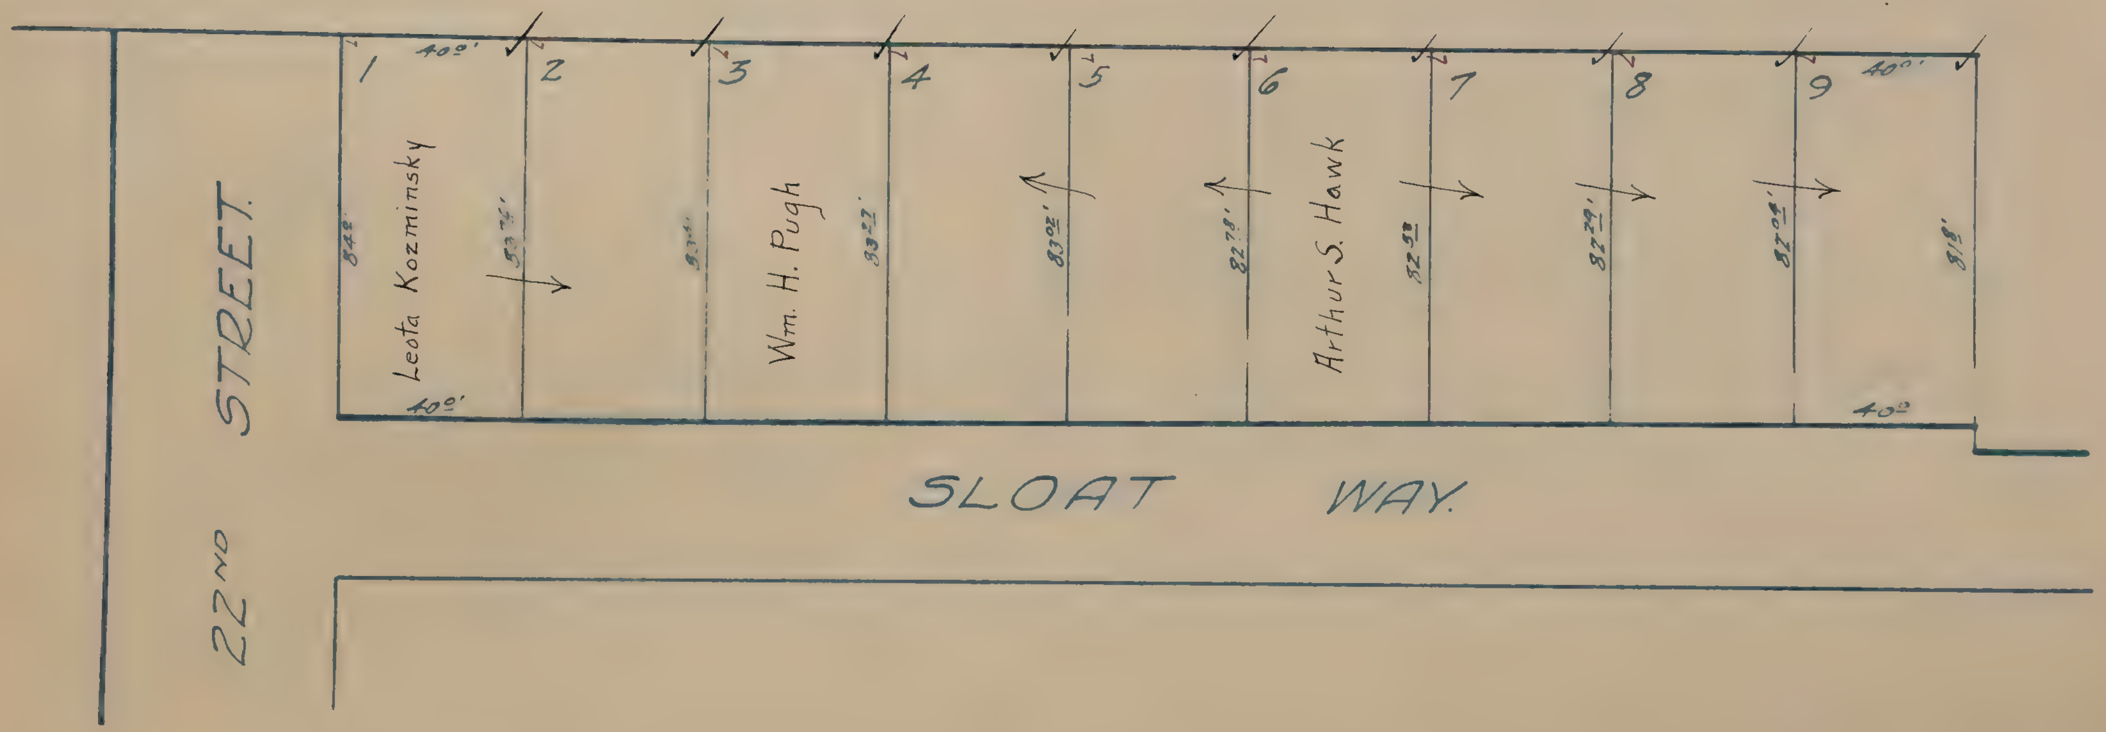
1
2
3
4
5
6
7
8
9
40.0'
40.0'
40.0'
40.0
84.0
83.76'
83.51'
83.27
83.02'
82.78'
82.53
82.29'
82.04'
81.8'
Leota Kozminsky
Wm. H. Pugh
Arthur S. Hawk
SLOAT WAY.
22ND STREET.

BONITA TERRACE ✓

Scale: 1 Inch = 80 feet.

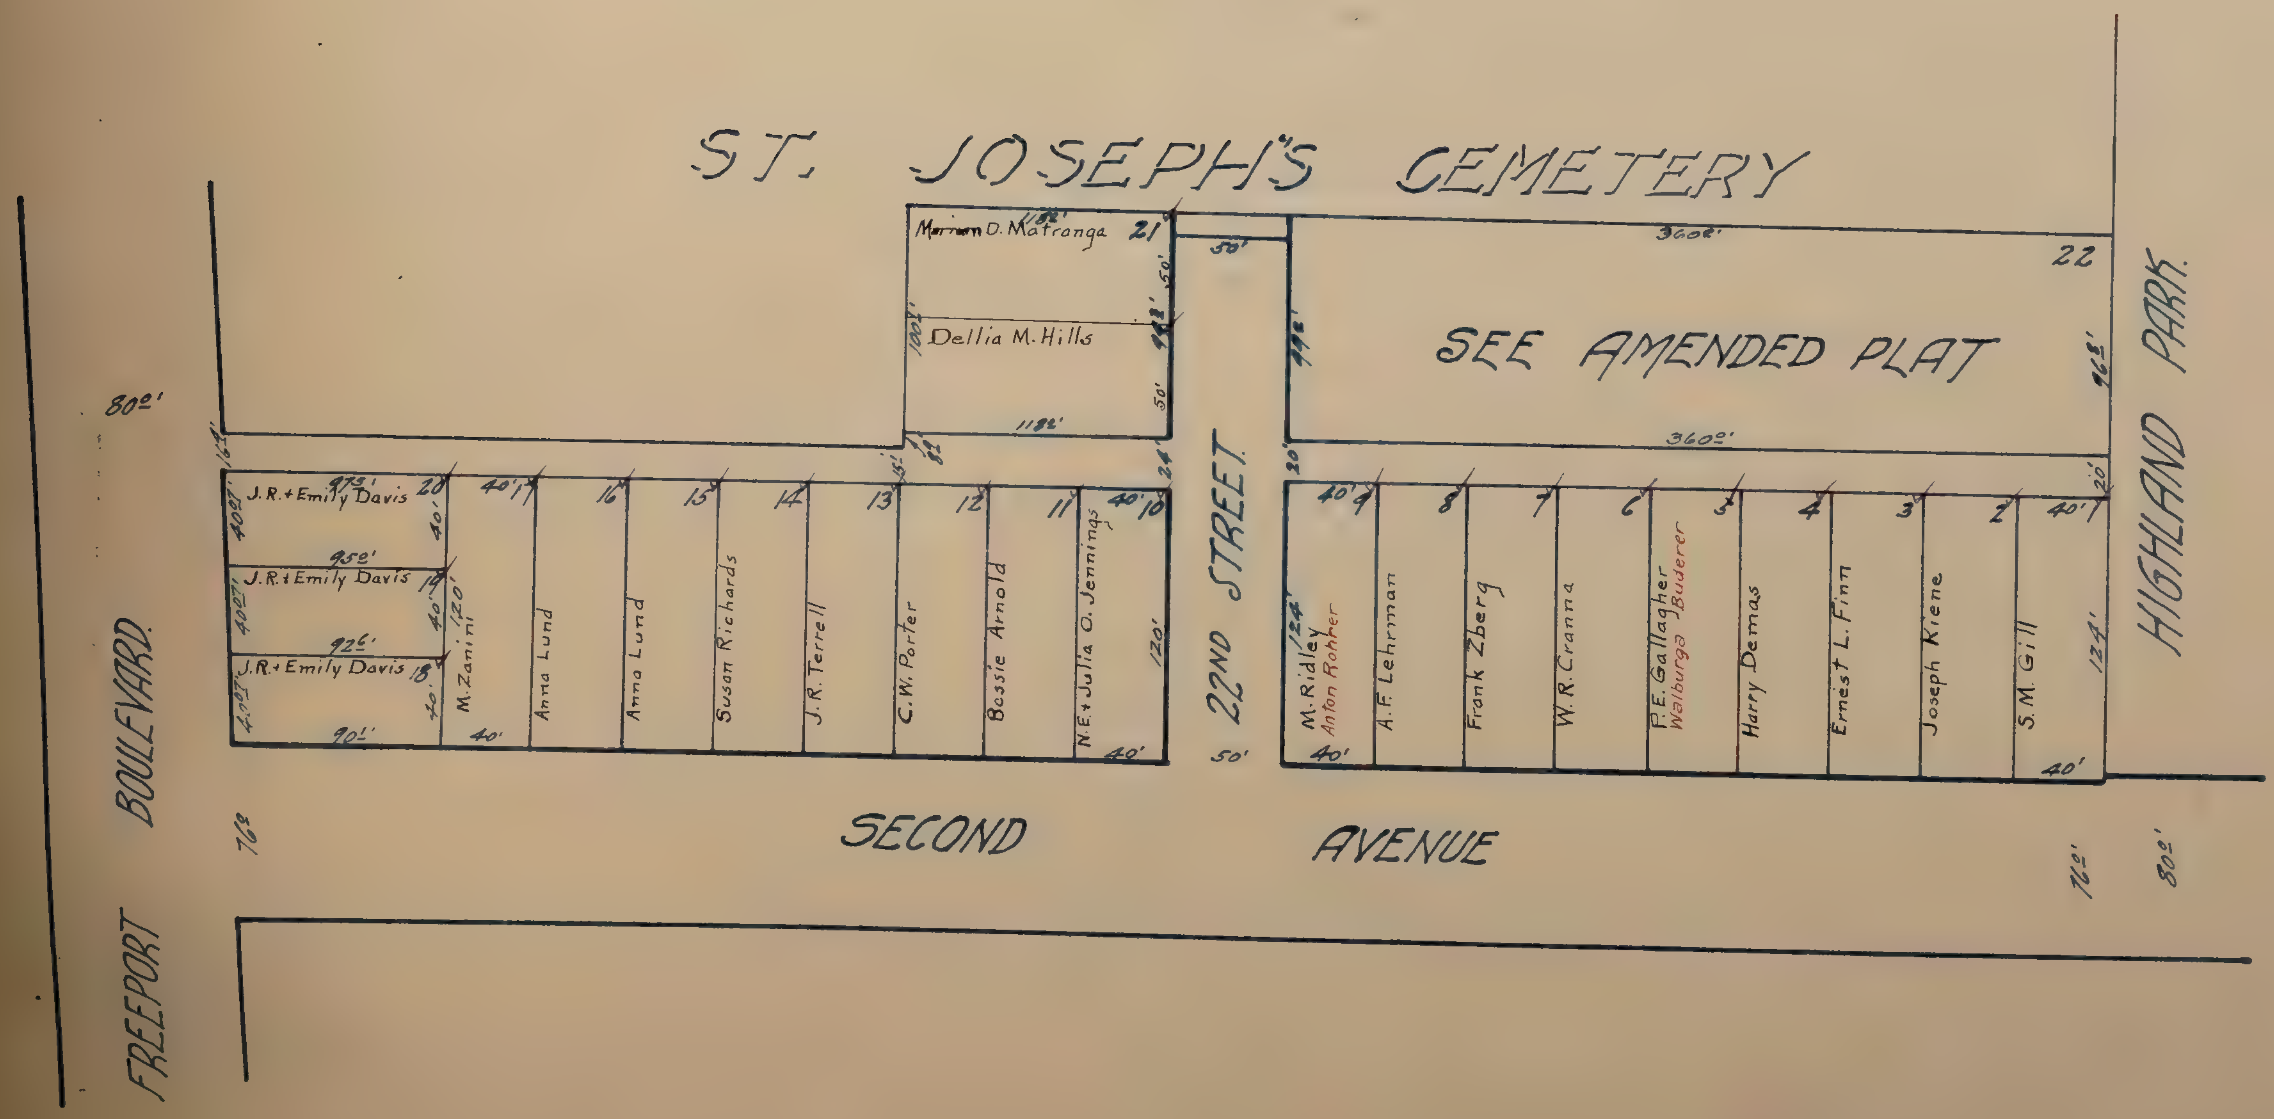
ST. JOSEPH'S CEMETERY
D. Matranga 21
Dellia M. Hills
118.2'
100.7'
50'
SEE AMENDED PLAT
22
360.0'
76.5'
J.R.+Emily Davis 20
97.5'
40.0'
J.R.+Emily Davis 19
95.0'
J.R.+Emily Davis 18
92.6'
90.1'
80.0'
16.1'
40'
17
M. Zanini
120'
16
Anna Lund
15
Anna Lund
14
Susan Richards
13
J.R. Terrell
12
C.W. Porter
11
Bossie Arnold
10
N.E.+Julia O. Jennings
120'
40'
24'
20'
22ND STREET
50'
9
M. Ridley
Anton Rohrer
124'
8
A.F. Lehrman
7
Frank Zberg
6
W.R. Cranna
5
P.E. Gallagher
Walburga J. Buderer
4
Harry Demas
3
Ernest L. Finn
2
Joseph Kiene
1
S.M. Gill
124'
40'
HIGHLAND PARK.
SECOND AVENUE
76.3
76.0'
80.0'
FREEPORT BOULEVARD.

BONITA VISTA TRACT.

Scale: 1 Inch = 80 feet.

Note: Comprises Lots 1816, 1817 & 1818 of Park Terrace.

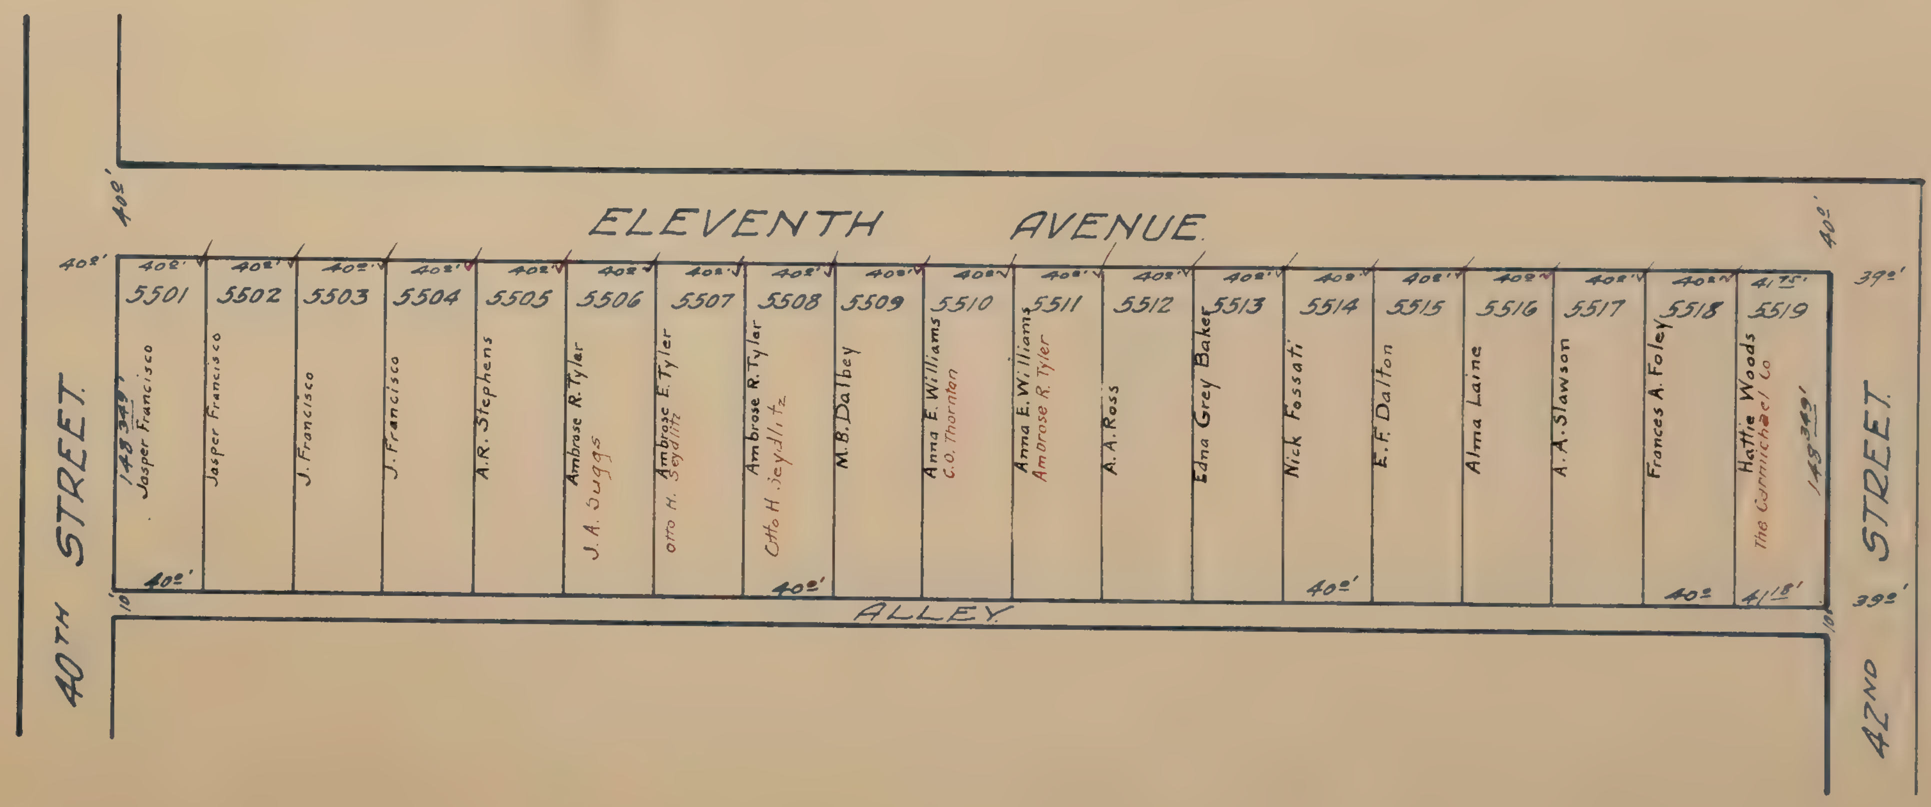
ELEVENTH AVENUE
ALLEY
40TH STREET
42ND STREET
40'
40'
40'
39'
39'
10'
10'
5501 Jasper Francisco 148.34'
5502 Jasper Francisco
5503 J. Francisco
5504 J. Francisco
5505 A.R. Stephens
5506 Ambrose R. Tylar J. A. Suggs
5507 Ambrose E. Tyler Otto H. Seydlitz
5508 Ambrose R. Tylar Otto H. Seydlitz
5509 M.B. Dalbey
5510 Anna E. Williams C.O. Thornton
5511 Anna E. Williams Ambrose R. Tyler
5512 A.A. Ross
5513 Edna Grey Baker
5514 Nick Fossati
5515 E.F. Dalton
5516 Alma Laine
5517 A.A. Slawson
5518 Frances A. Foley
5519 Hattie Woods The Carmichael Co 149.34'
41.75'
41.18'

BOXLER TRACT ✓

SUBDIVISION NO. 1.

Scale: 1 Inch = 80 feet

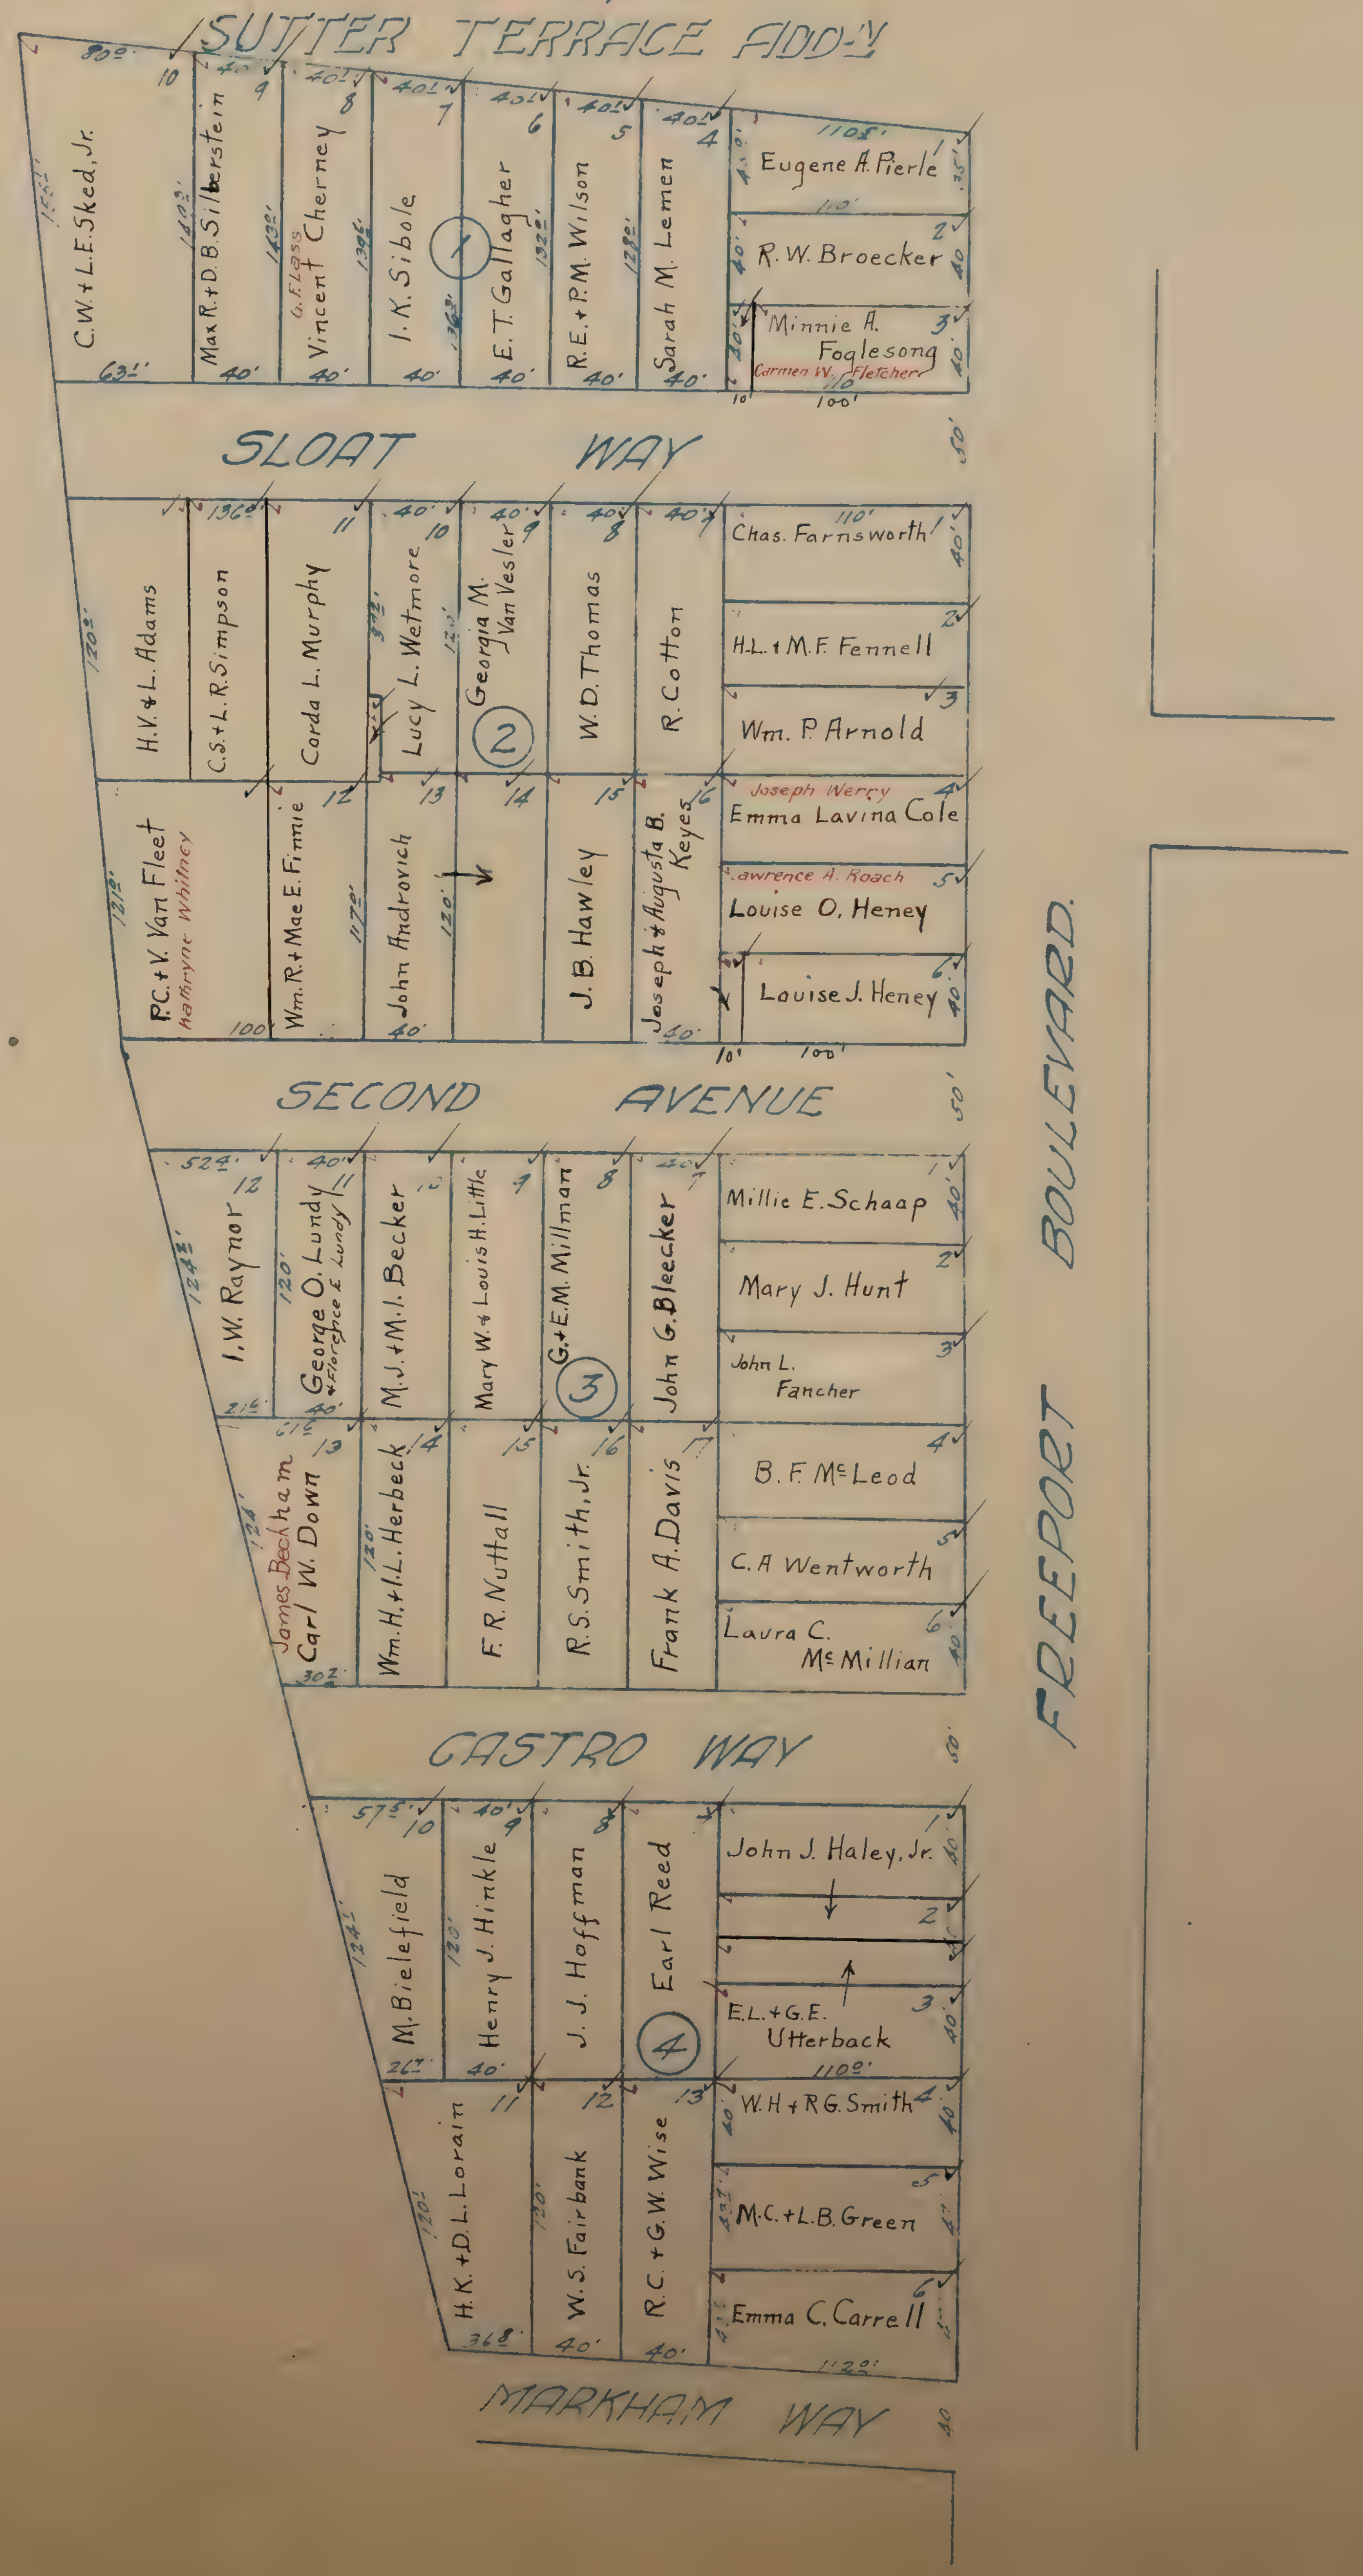
SUTTER TERRACE ADD-N
C.W. + L.E. Sked, Jr.
Max R. + D.B. Silberstein
G.F. Lass
Vincent Cherney
I.K. Sibole
1
E.T. Gallagher
R.E. + P.M. Wilson
Sarah M. Lemen
Eugene A. Pierle
R.W. Broecker
Minnie A. Foglesong
Carmen W. Fletcher
SLOAT WAY
H.V. + L. Adams
C.S. + L.R. Simpson
Corda L. Murphy
Lucy L. Wetmore
Georgia M. J. Van Vesler
2
W.D. Thomas
R. Cotton
Chas. Farnsworth
H.L. + M.F. Fennell
Wm. P. Arnold
Joseph Werry
Emma Lavina Cole
Lawrence A. Roach
Louise O. Heney
Louise J. Heney
P.C. + V. Van Fleet
Kathryne Whitney
Wm. R. + Mae E. Finnie
John Androvich
J.B. Hawley
Joseph + Augusta B. Keyes
SECOND AVENUE
I.W. Raynor
George O. Lundy
+ Florence E. Lundy
M.J. + M.I. Becker
Mary W. + Louis H. Little
G. + E.M. Millman
3
John G. Bleecker
Millie E. Schaap
Mary J. Hunt
John L. Fancher
James Beckham
Carl W. Down
Wm. H. + I.L. Herbeck
F.R. Nuttall
R.S. Smith, Jr.
Frank A. Davis
B.F. McLeod
C.A Wentworth
Laura C. McMillian
FREEPORT BOULEVARD
CASTRO WAY
M. Bielefield
Henry J. Hinkle
J.J. Hoffman
Earl Reed
4
John J. Haley, Jr.
E.L. + G.E. Utterback
W.H + R.G. Smith
M.C. + L.B. Green
Emma C. Carrell
H.K. + D.L. Lorain
W.S. Fairbank
R.C. + G.W. Wise
MARKHAM WAY

BOXLER TRACT ✓✓

SUBDIVISION NO. 2

Scale: 1 Inch = 40 feet.

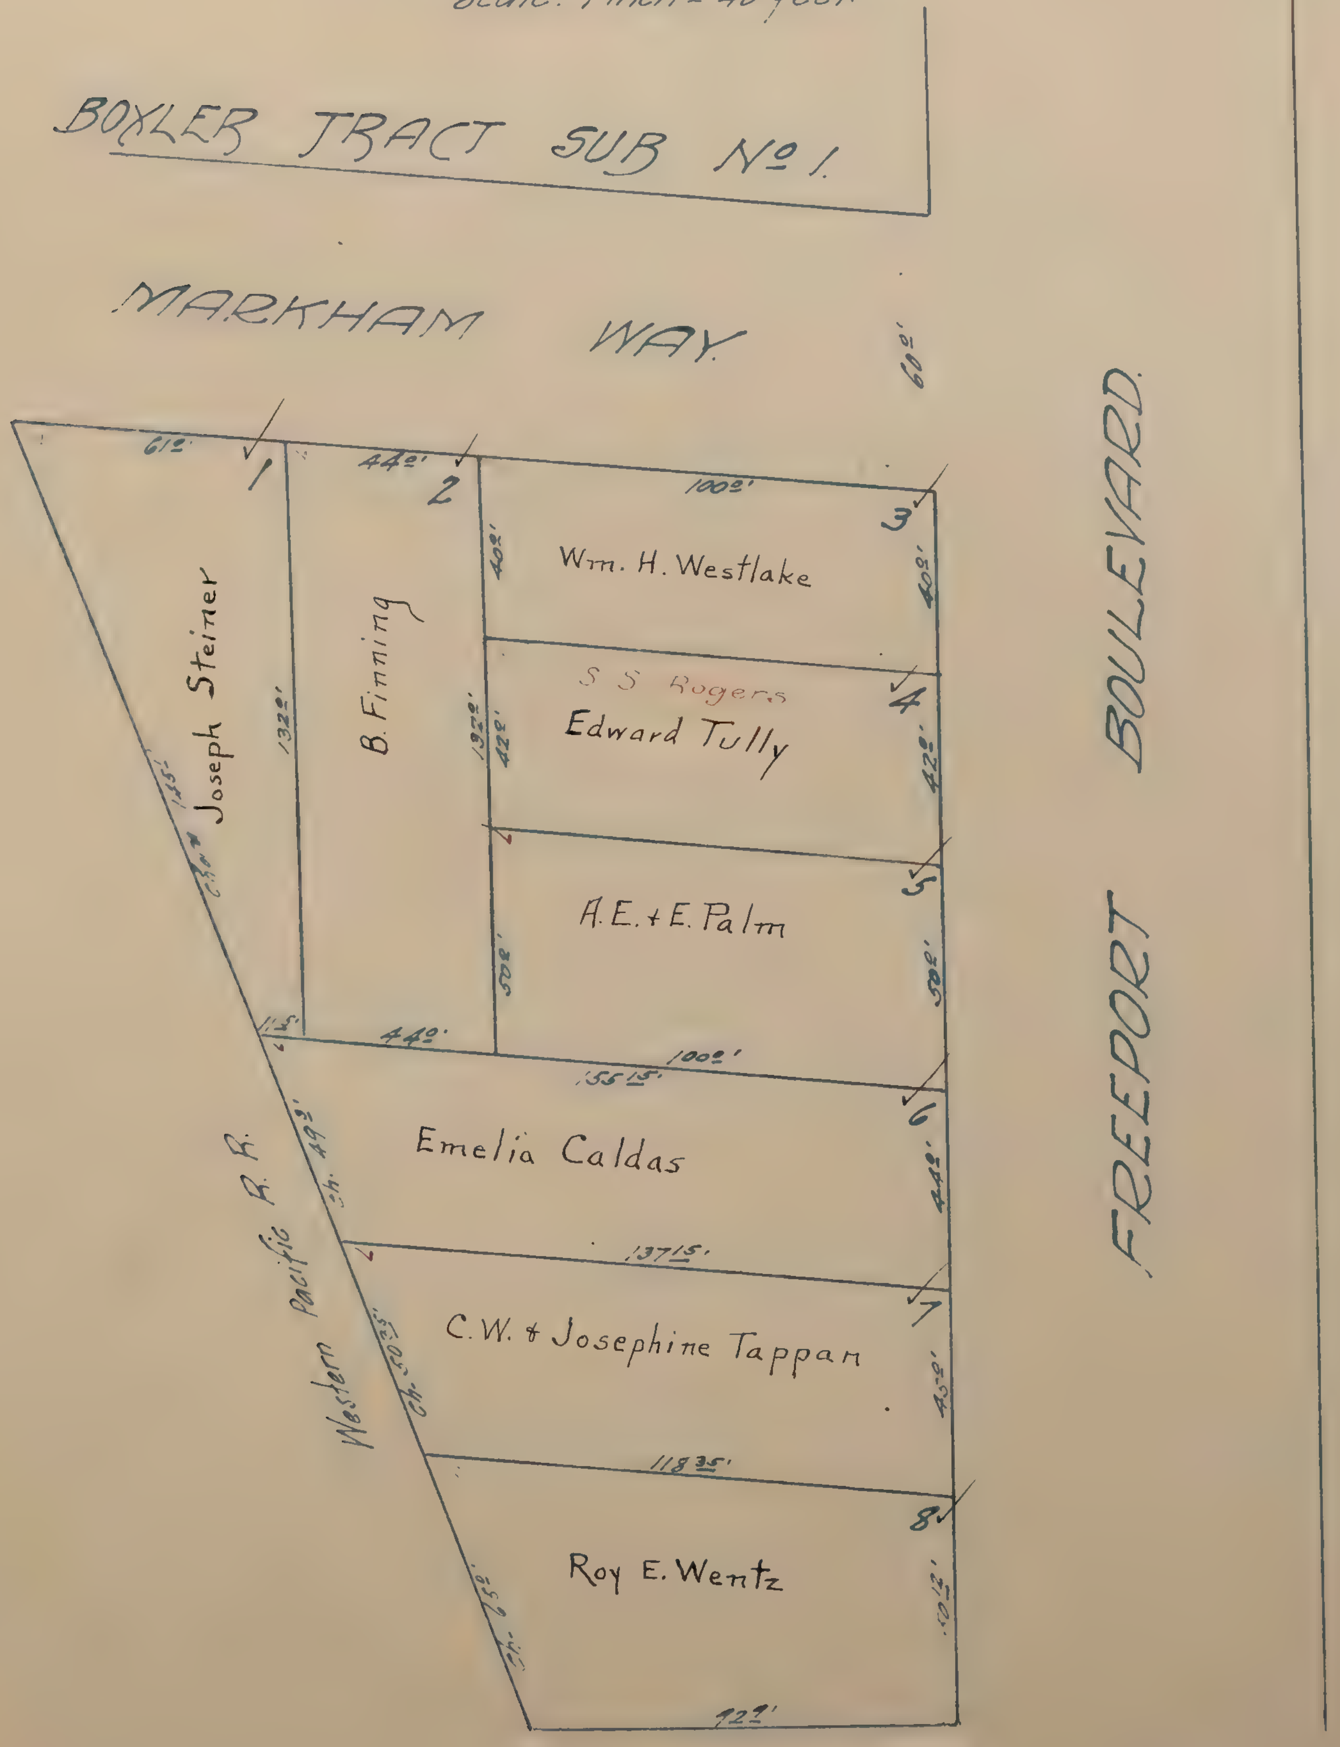
BOXLER TRACT SUB No 1.
MARKHAM WAY.
60.0'
FREEPORT BOULEVARD.
Western Pacific R.R.
1 ✓
2 ✓
3 ✓
4 ✓
5 ✓
6 ✓
7 ✓
8 ✓
61.0'
44.0'
100.0'
40.0'
40.0'
132.0'
132.0'
42.0'
42.0'
50.0'
50.0'
135'
Ch. 63.0
11.5'
44.0'
100.0'
155.15'
Ch. 49.3'
44.0'
137.15'
Ch. 50.35'
45.0'
118.35'
Ch. 25.0'
50.12'
92.7'
Joseph Steiner
B. Finning
Wm. H. Westlake
S S Rogers
Edward Tully
A. E. + E. Palm
Emelia Caldas
C. W. + Josephine Tappan
Roy E. Wentz

BOYLE COURT

Scale 1" = 50'

All Blanks assessed to C.F. Boyle & E.L. Boyle, Jr.

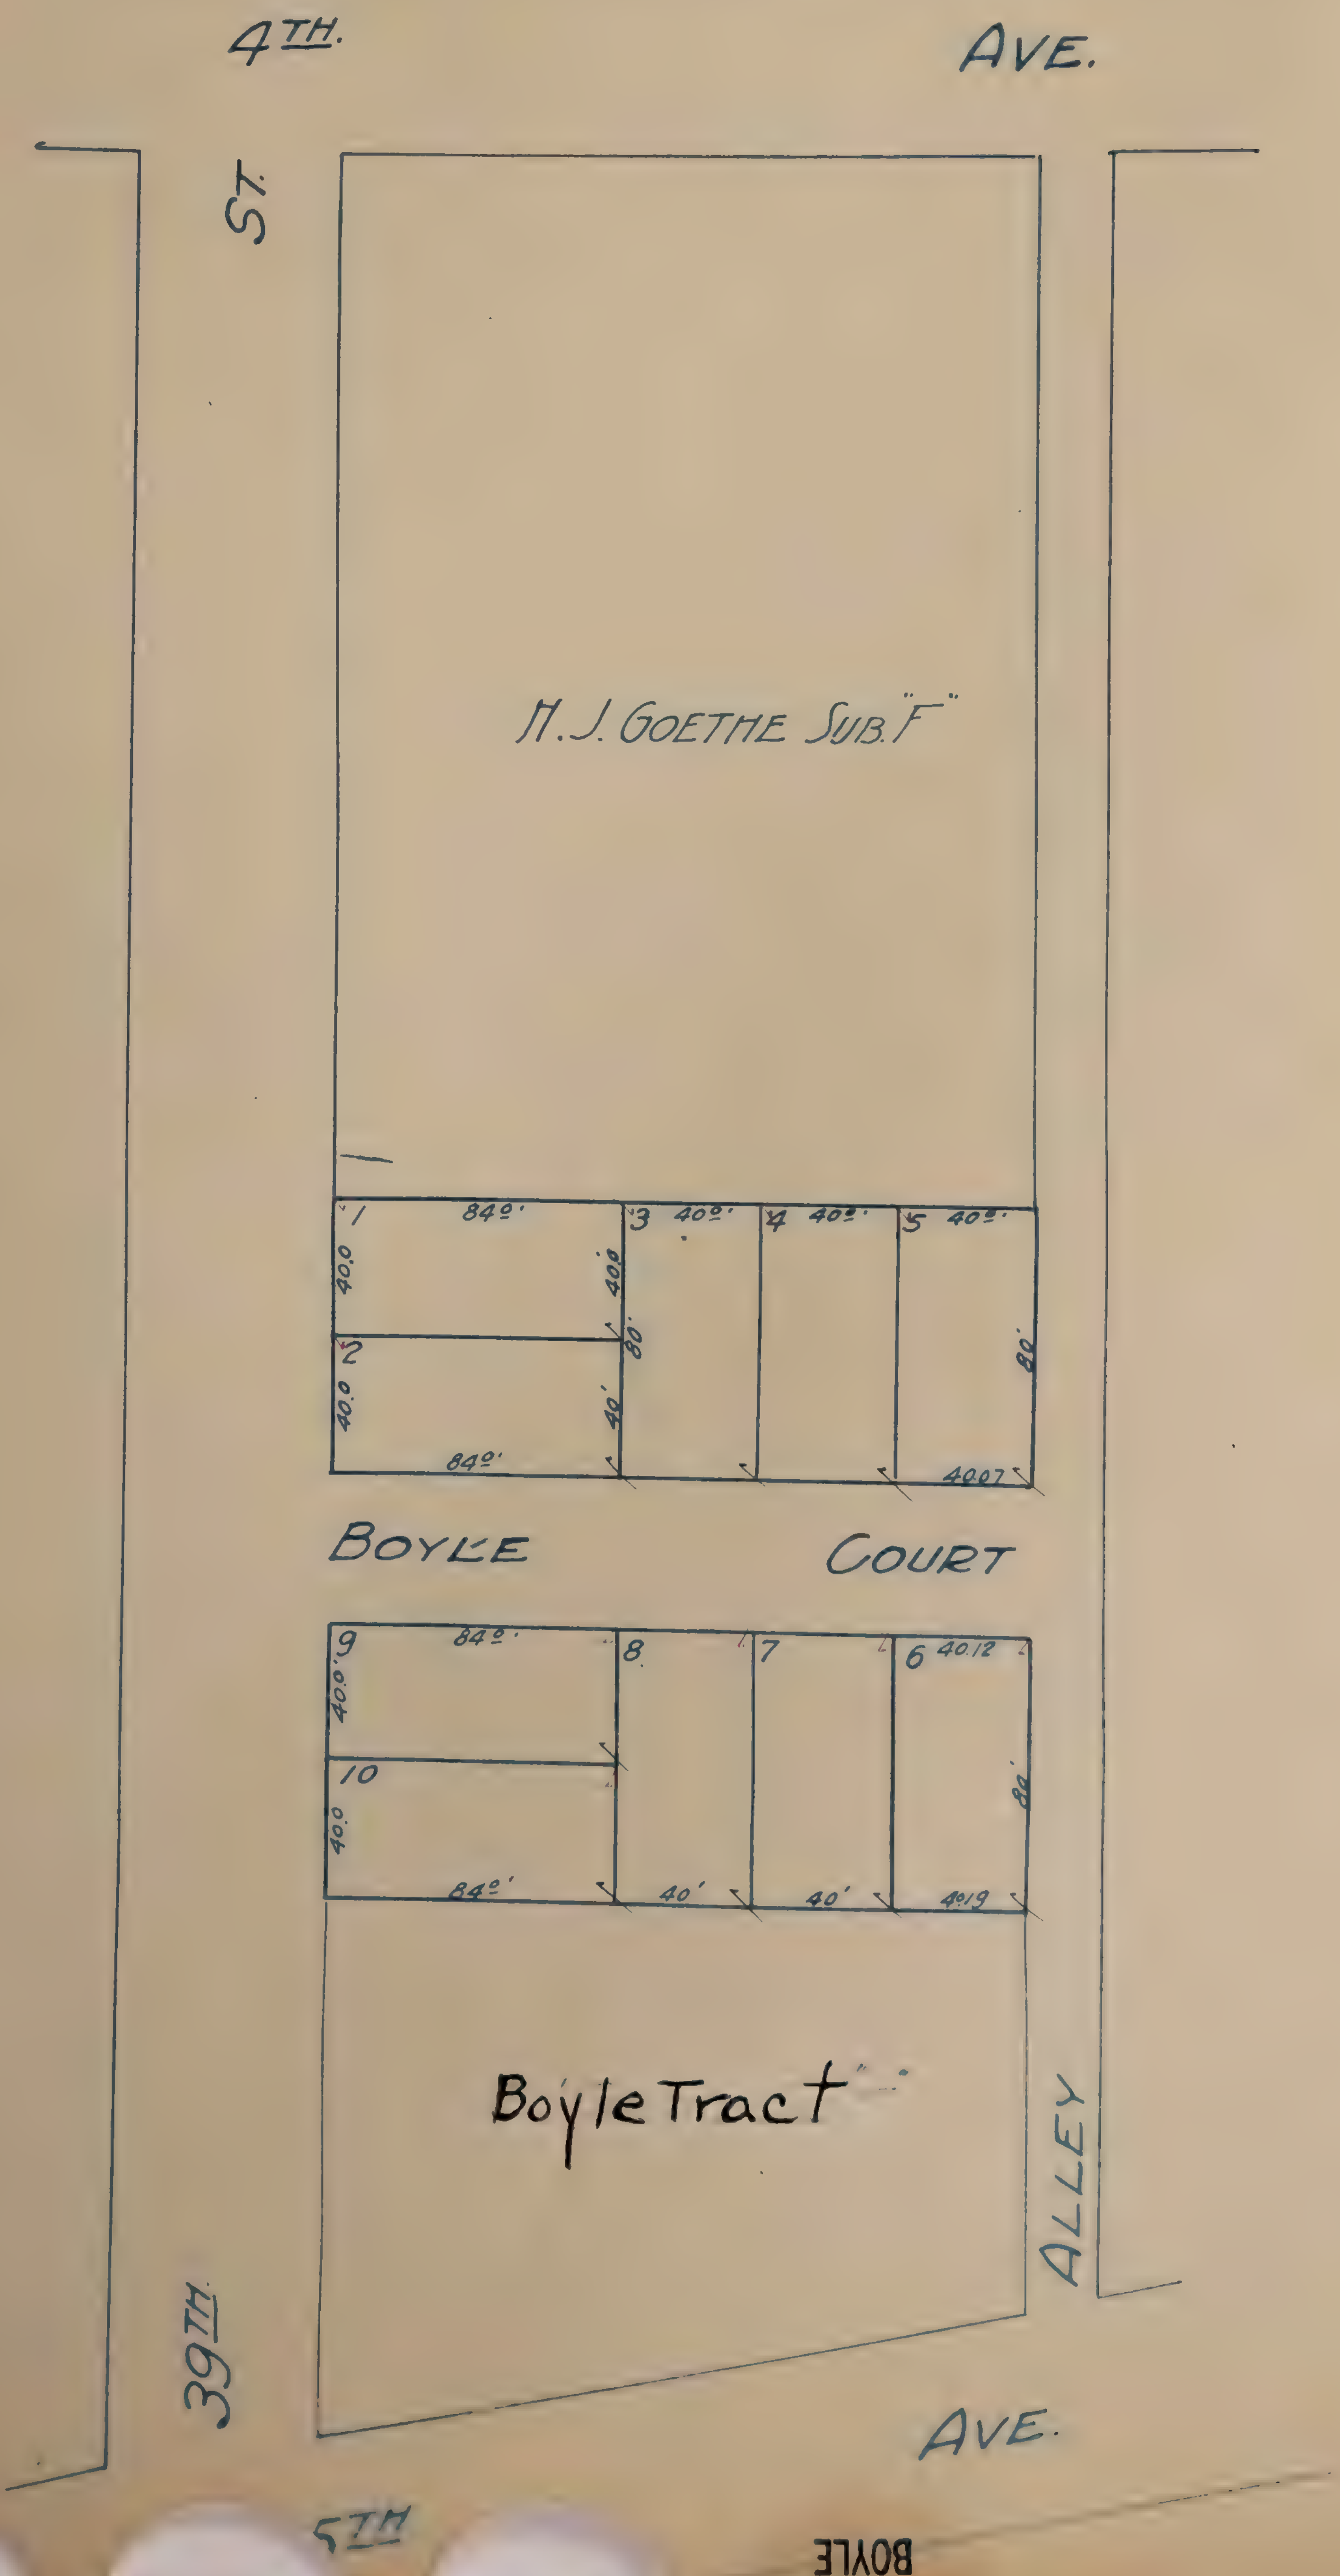
4TH
AVE.
ST.
M.J. GOETHE SUB. "F"
1
2
3
4
5
84.0'
40.0
40.0
80'
40'
40.0'
40.07
BOYLE
COURT
9
10
8
7
6
40.12
80'
84.0'
40'
40.19
Boyle Tract
ALLEY
39TH
AVE.
5TH

BOYLE TRACT ✓✓

Scale: 1 Inch = 40 feet.

NOTE: Comprises Lots 27 & 28 of H. J. Goethe Addn F

Blanks to E.L. Boyle

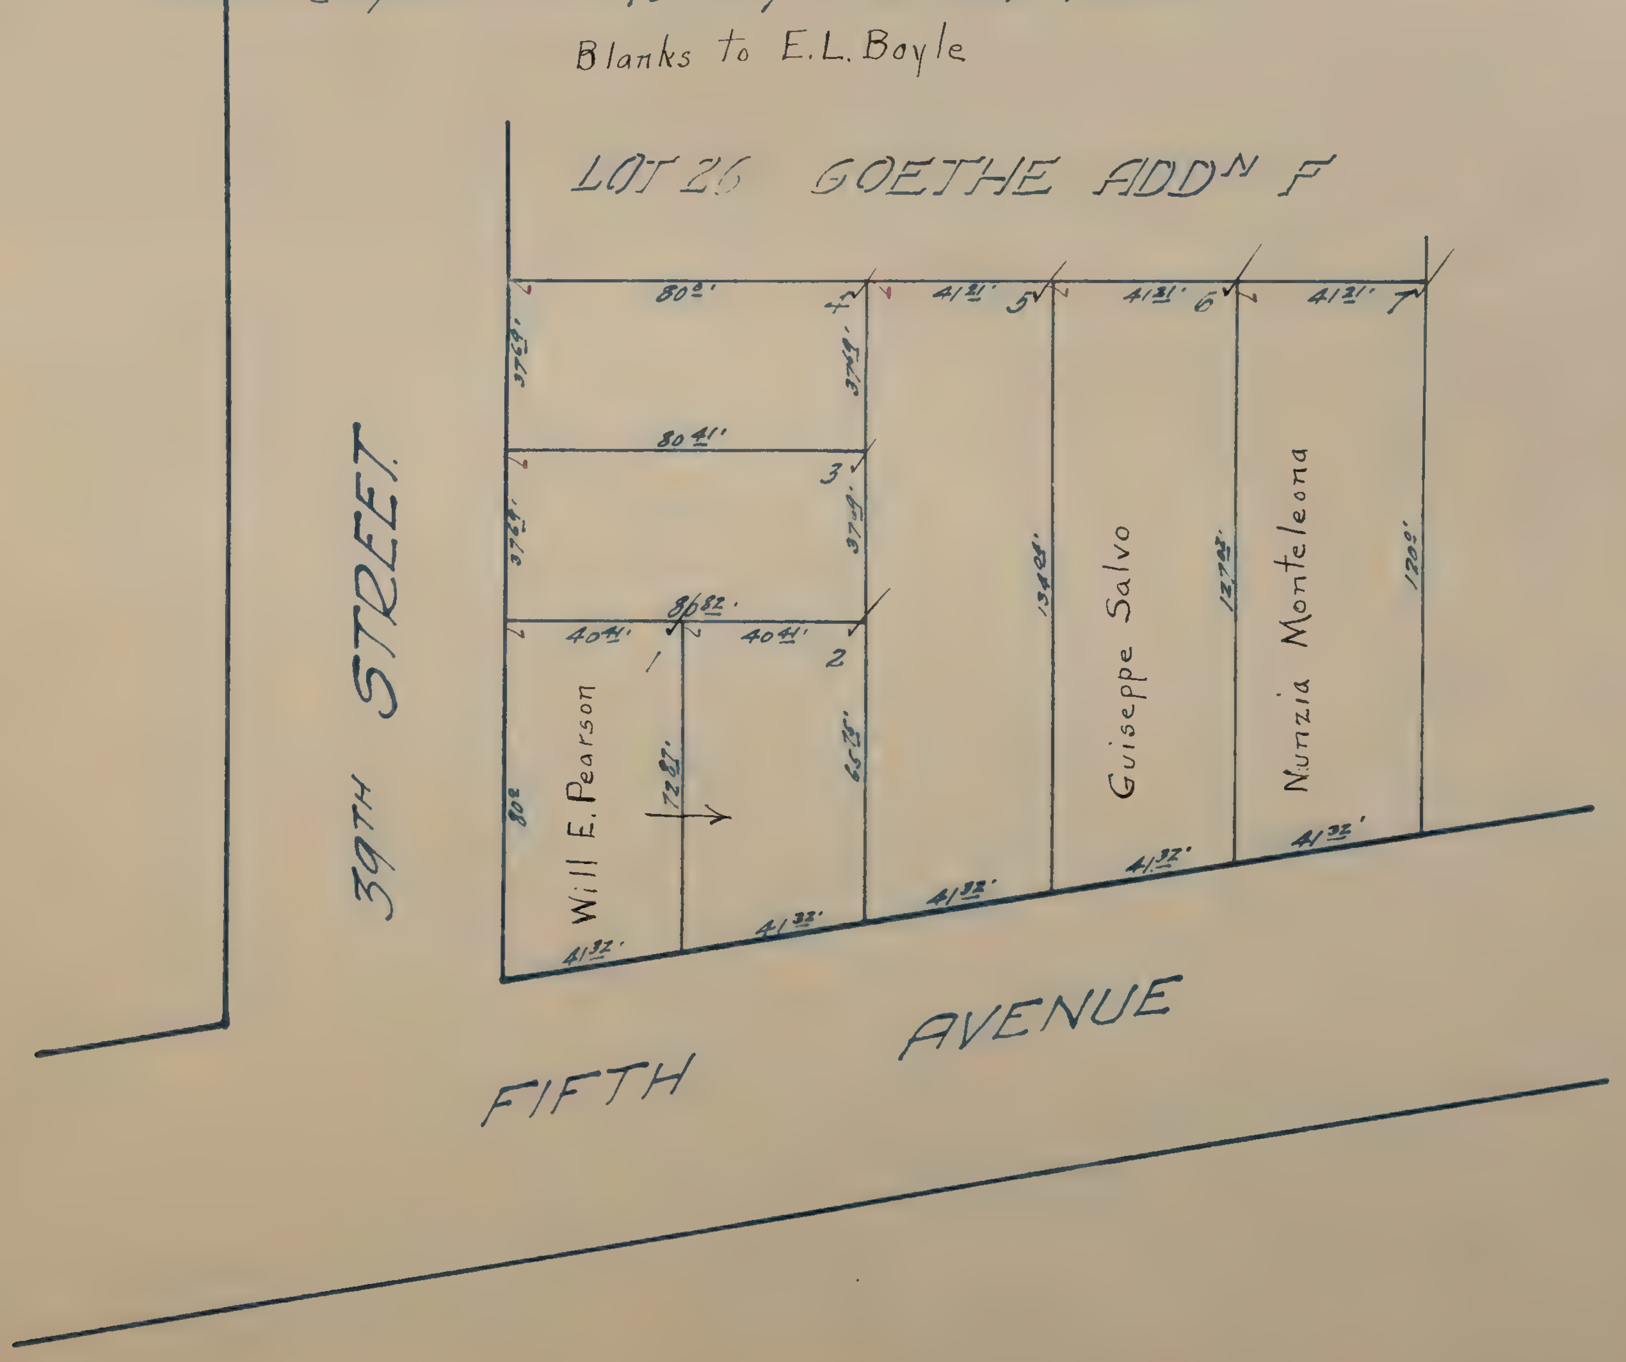
LOT 26 GOETHE ADDN F
80 2'
41 21' 5
41 31' 6
41 21' 7
37 29'
37 29'
4
80 41'
3
37 29'
37 29'
80 82'
40 41'
40 41'
1
2
Will E. Pearson
80 2
72 87'
65 75'
134 08'
Guiseppe Salvo
127 95'
Nunzia Monteleona
120 9'
41 32'
41 32'
41 32'
41 32'
41 32'
39TH STREET
FIFTH AVENUE

BRIER TERRACE

SACRAMENTO CITY, CALIFORNIA

Scale: 1 inch = 40 feet.

Dist - N - 6

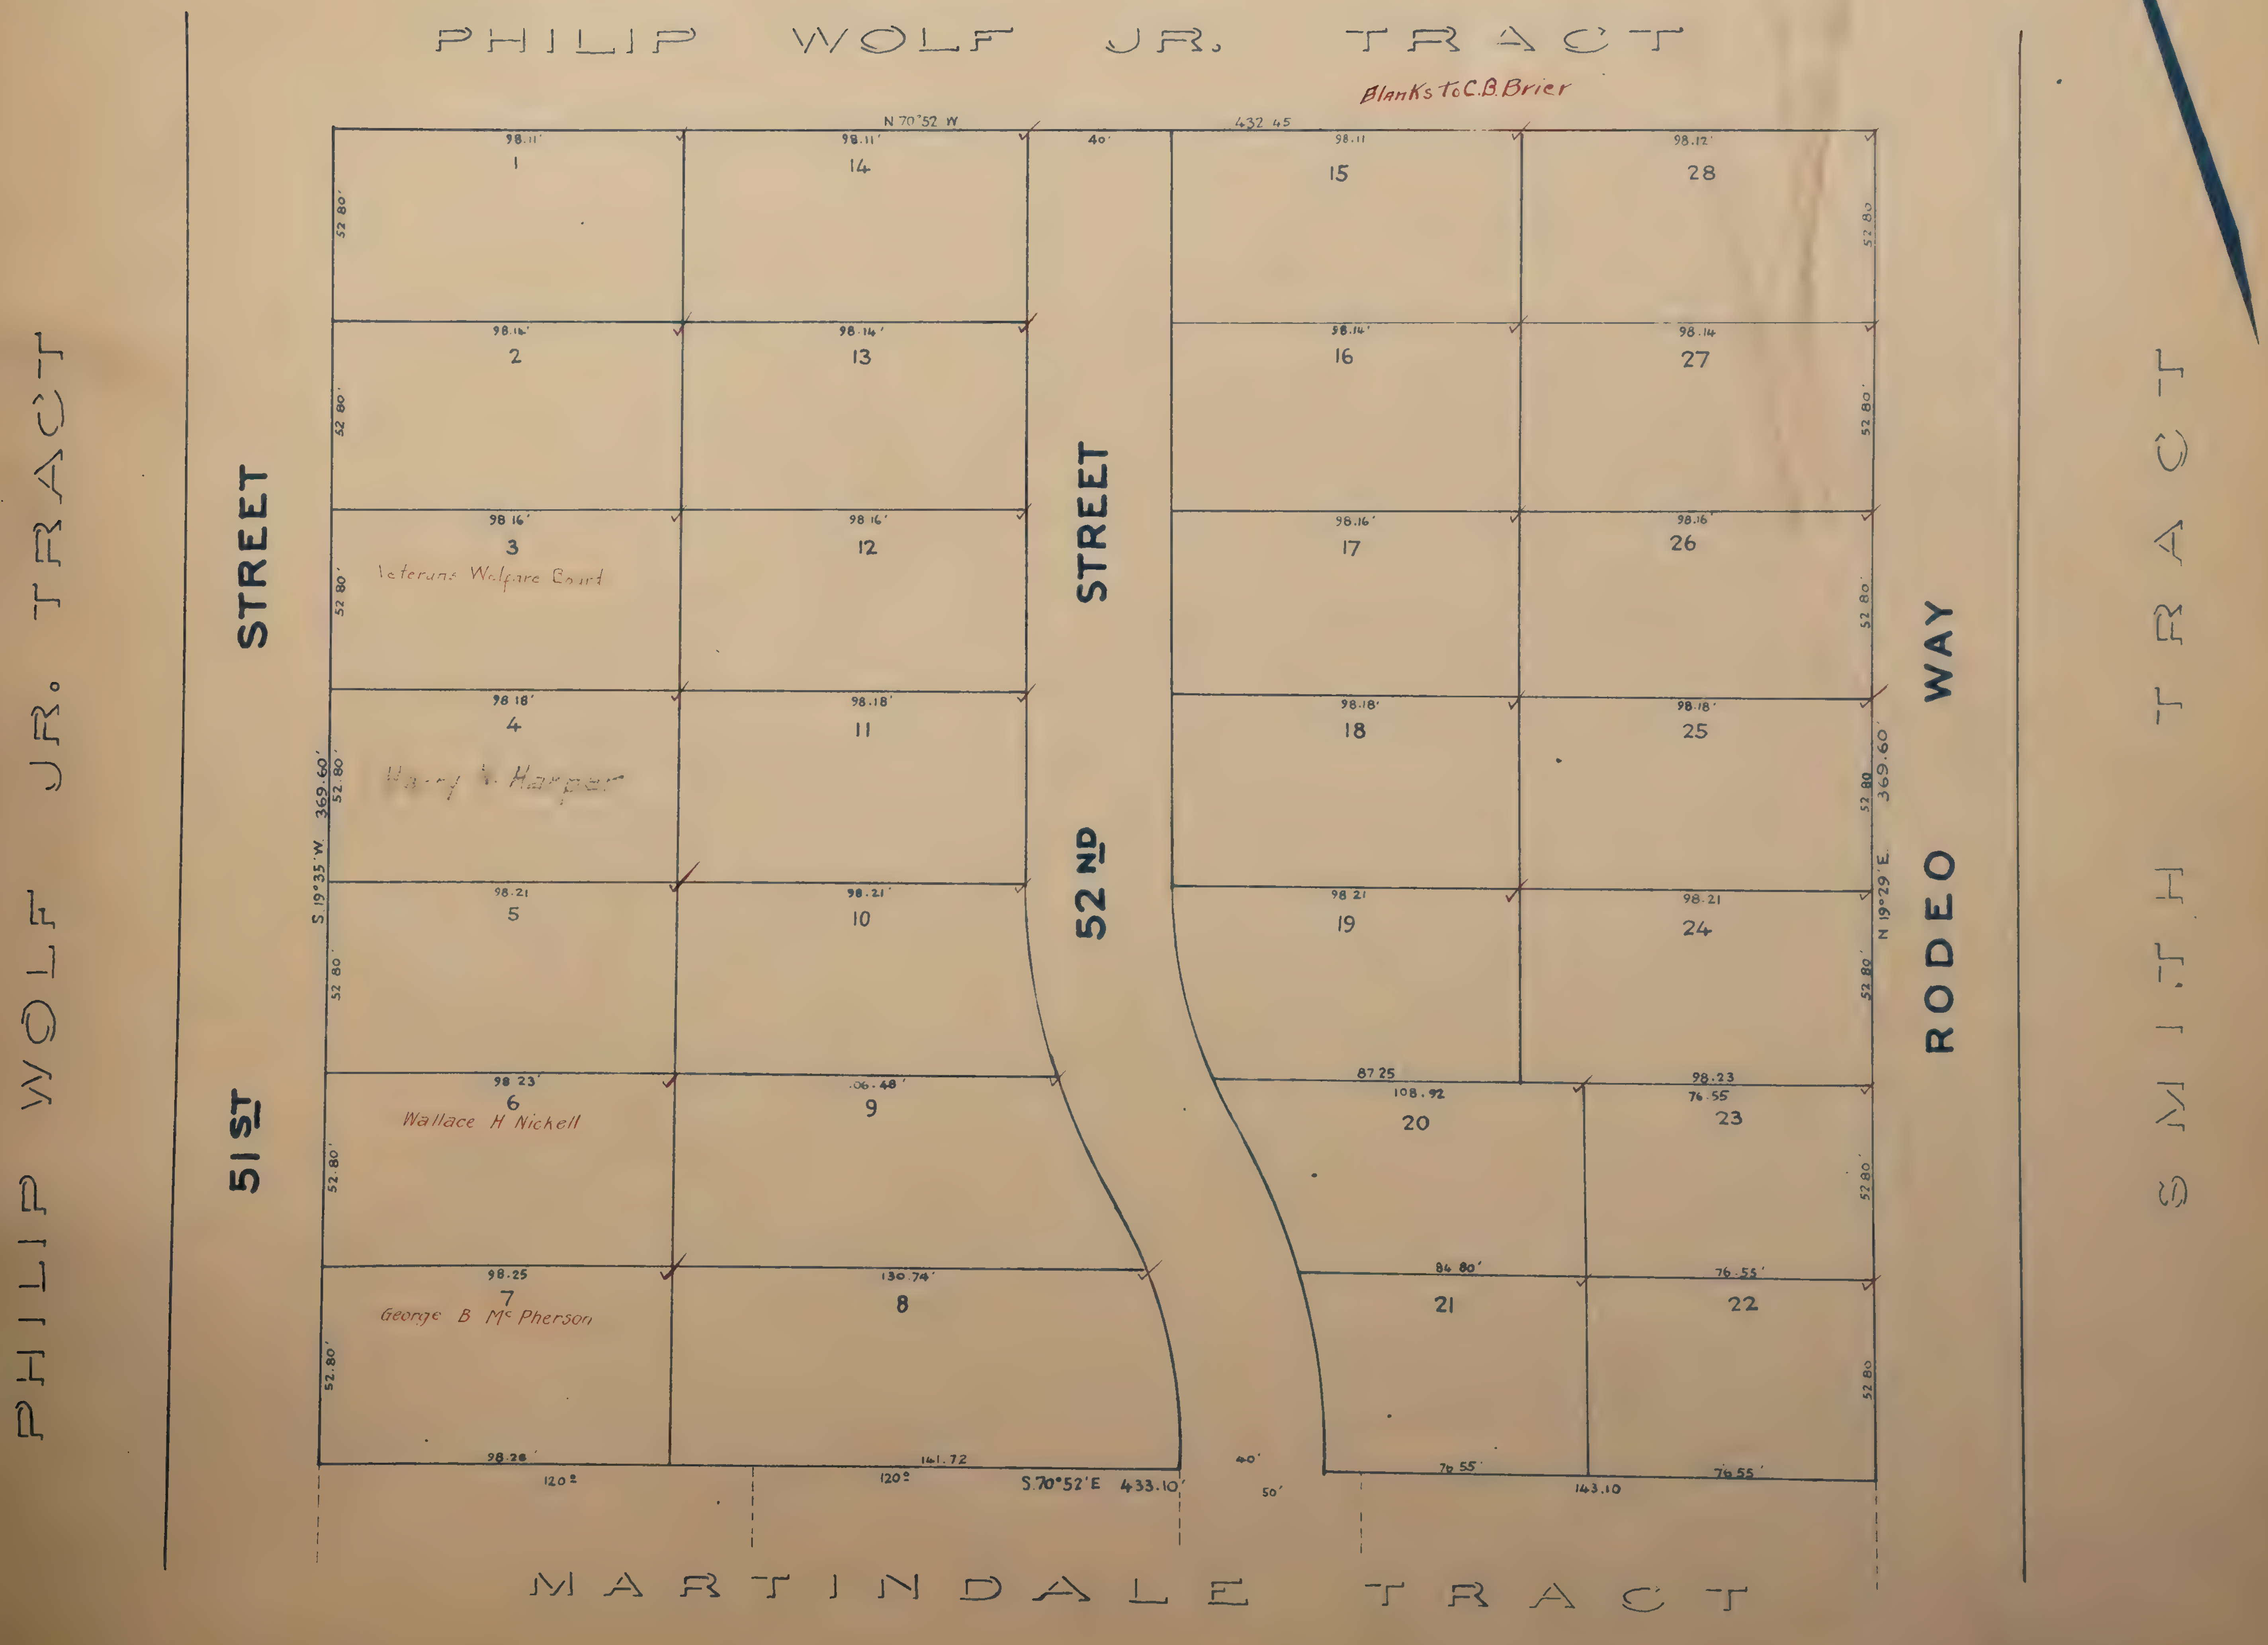
PHILIP WOLF JR. TRACT
Blanks to C.B.Brier
N 70°52' W
432.45
40'
PHILIP WOLF JR. TRACT
51ST STREET
52ND STREET
RODEO WAY
SMITH TRACT
MARTINDALE TRACT
S 19°35' W 369.60'
N 19°29' E 369.60'
S 70°52' E 433.10'
1
2
3
4
5
6
7
8
9
10
11
12
13
14
15
16
17
18
19
20
21
22
23
24
25
26
27
28
98.11'
98.12'
98.14'
98.16'
98.18'
98.21
98.23'
98.25
98.28'
130.74'
161.72
87.25
108.92
84.80'
76.55'
143.10
120'
40'
50'
52.80'
Veterans Welfare Board
Harry ... Harper
Wallace H Nickell
George B Mc Pherson

BRIGHTON AVENUE TRACT ✓✓

Scale: 1 Inch = 40 feet.

NOTE: Comprises Lot 6 of the Altamont Tract.

Blanks to Richard McIlroy

Blanks to Mabel Woerner

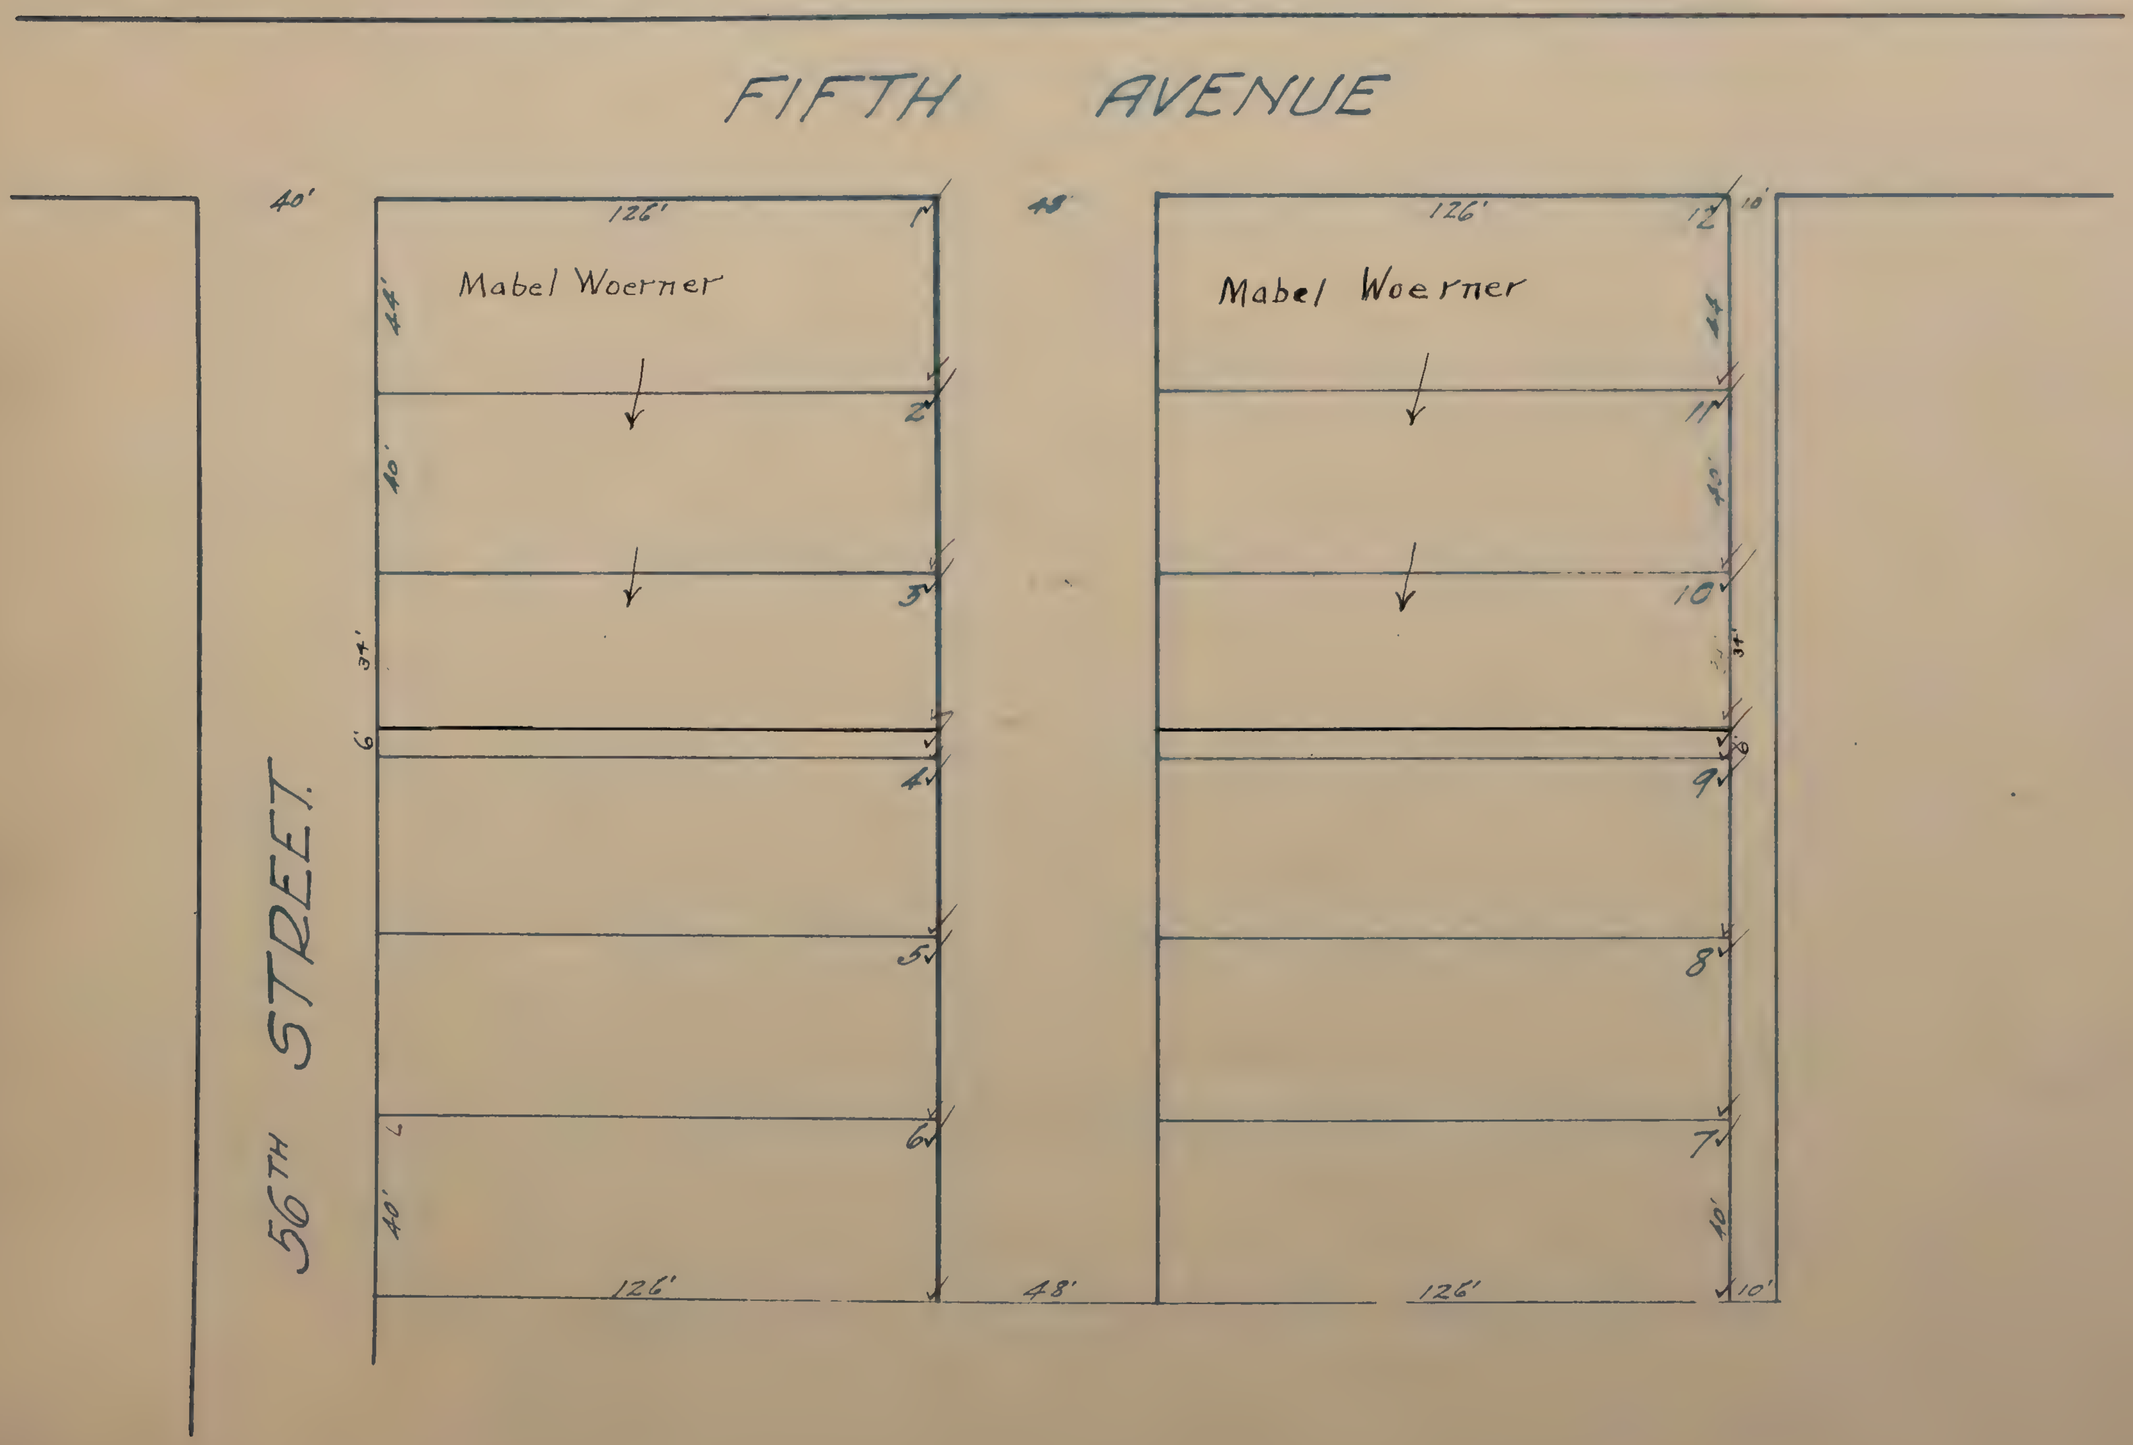
FIFTH AVENUE
56TH STREET.
40'
126'
48'
126'
10'
Mabel Woerner
Mabel Woerner
1
2
3
4
5
6
7
8
9
10
11
12
44'
40'
34'
6'
40'
44'
40'
34'
6'
40'
126'
48'
126'
10'

BUCKMAN TRACT ✓✓

Scale: 1 Inch = 40 feet

NOTE: Comprises Lots 2691 & 2692 of Oak Terrace.

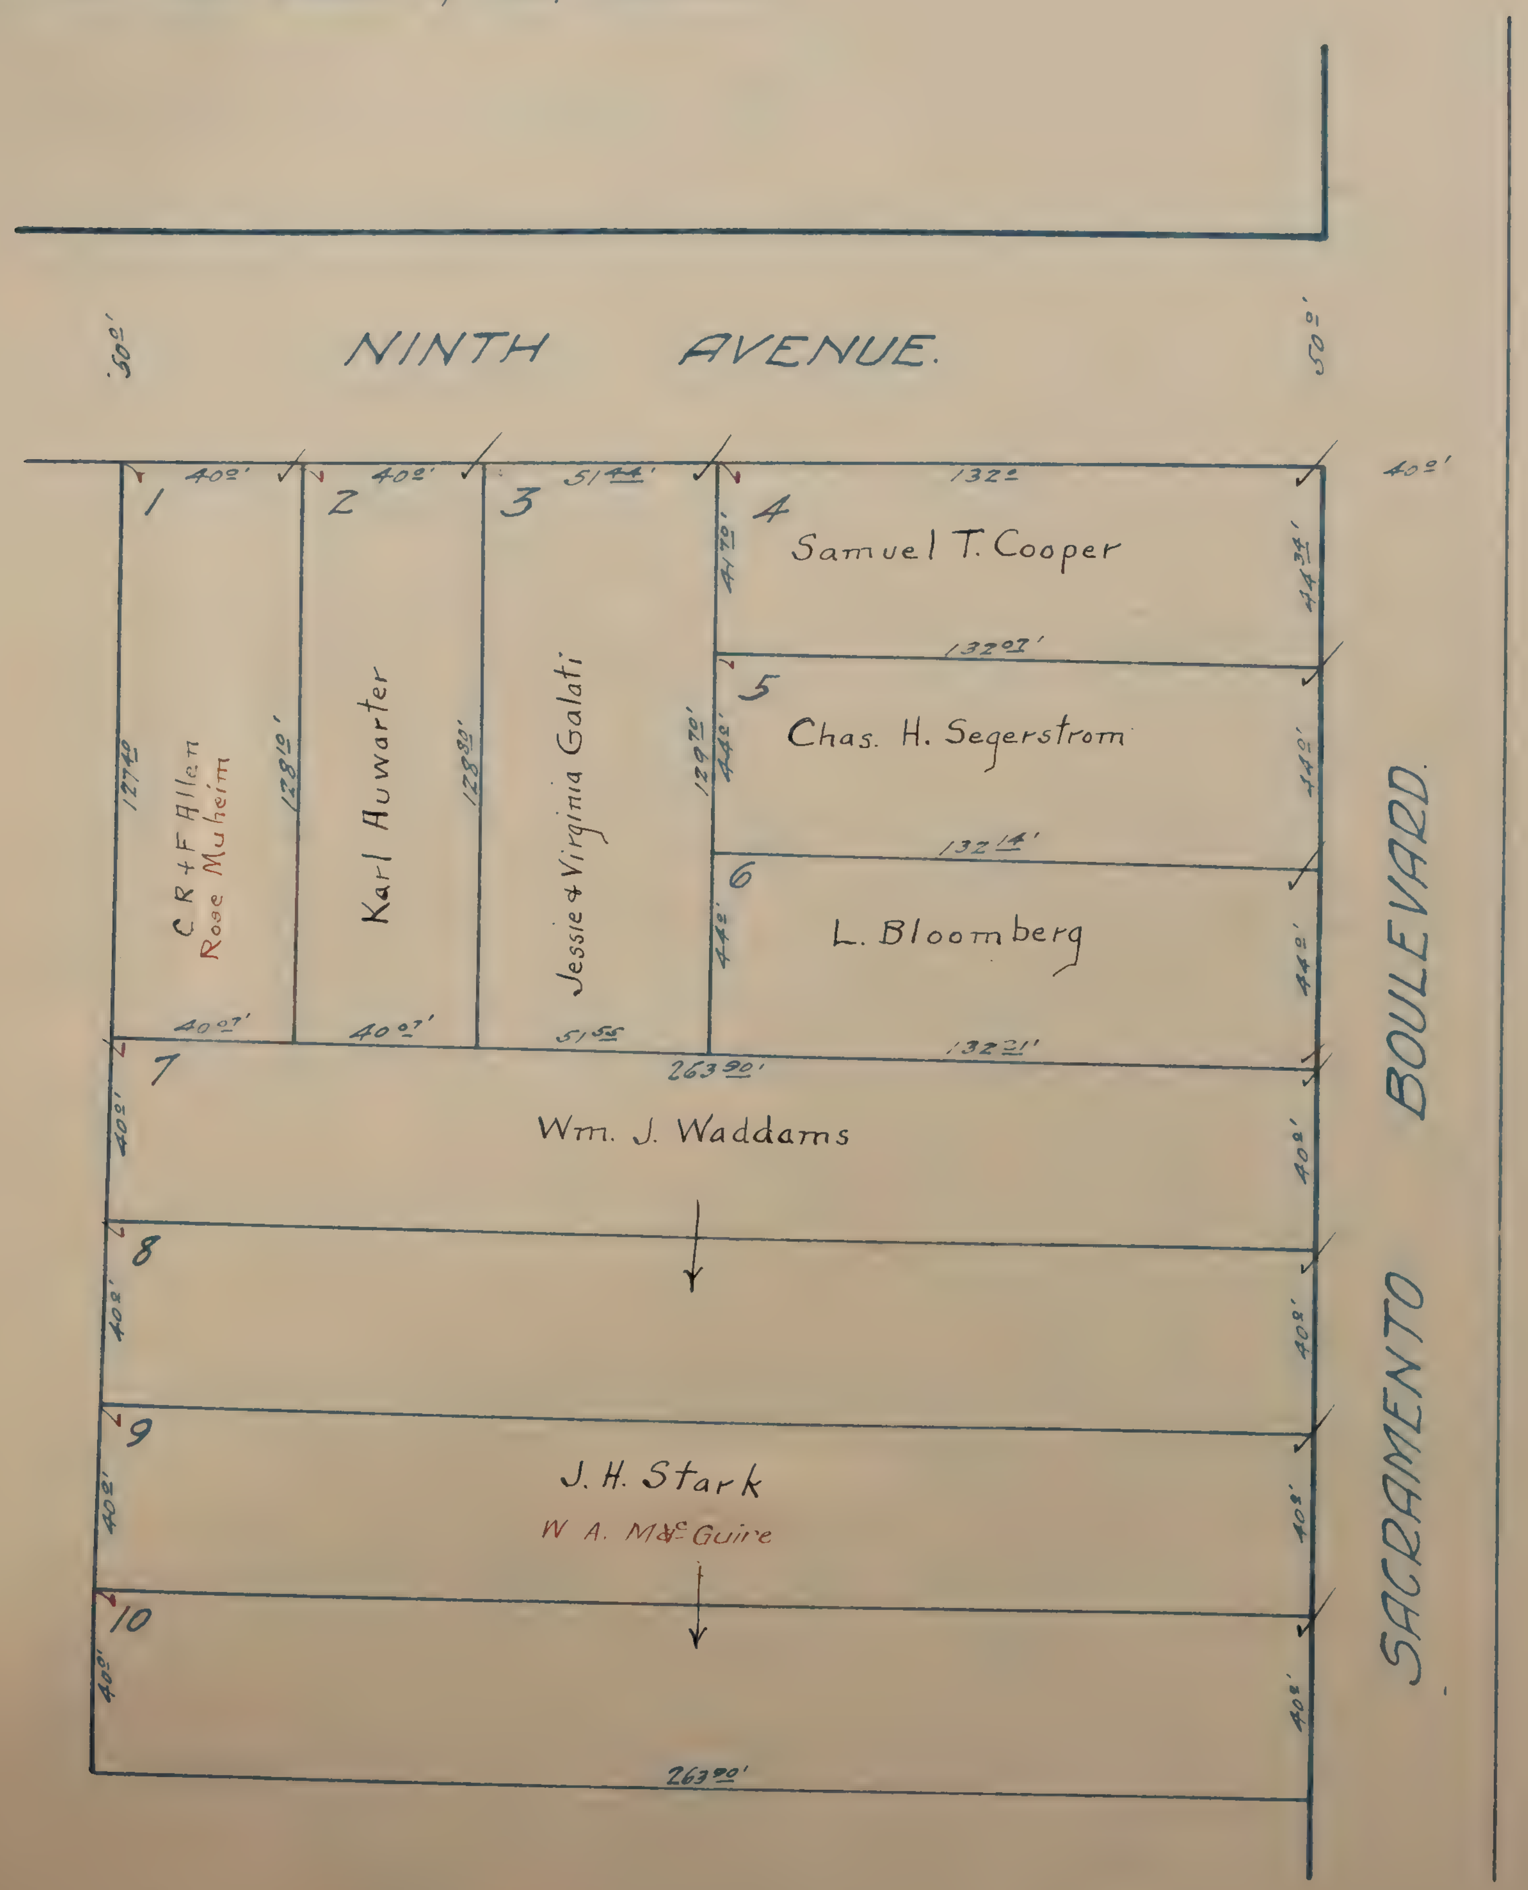
NINTH AVENUE.
50 0'
50 0'
SACRAMENTO BOULEVARD
1
2
3
4
5
6
7
8
9
10
40 0'
40 0'
51 44'
132 0
40 0'
41 70'
44 34'
132 07'
Samuel T. Cooper
Chas. H. Segerstrom
44 0'
44 0'
132 14'
L. Bloomberg
44 0'
44 0'
127 40
C R + F Allen
Rose Muheim
128 10'
Karl Auwarter
128 80'
Jessie + Virginia Galati
129 70'
40 07'
40 07'
51 55
132 21'
263 90'
Wm. J. Waddams
40 0'
40 0'
40 0'
40 0'
40 0'
40 0'
40 0'
40 0'
J. H. Stark
W. A. McGuire
263 90'

BUENA VISTA

Scale: 1 Inch = 80 feet.

NOTE: Comprises all of Lot 18 & N ½ of Lot 19 of the M J. Dillman Tract Sub. No.1.

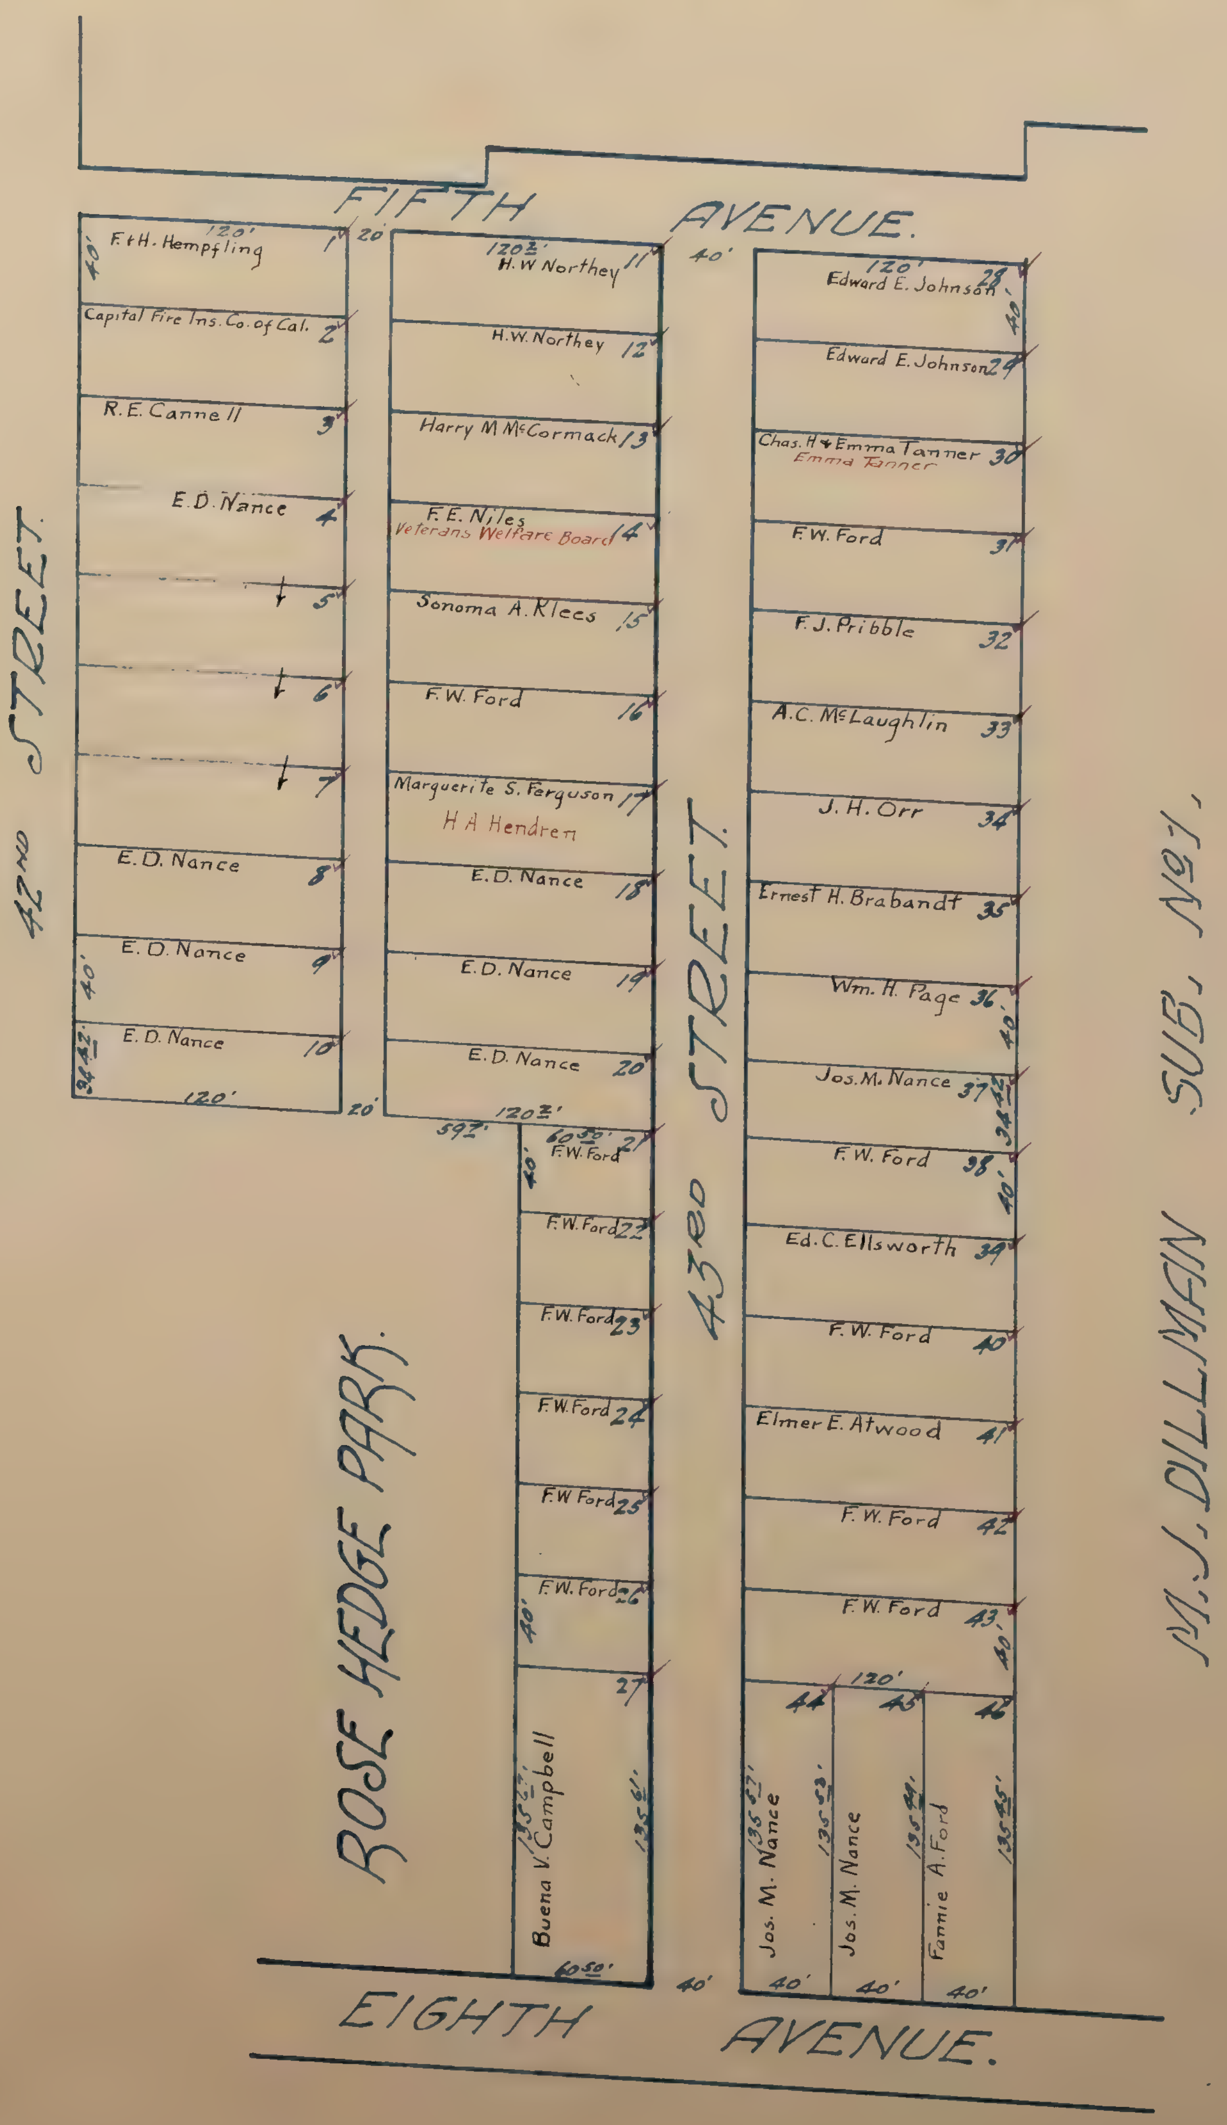
FIFTH AVENUE.
42ND STREET.
43RD STREET.
ROSE HEDGE PARK.
M.J. DILLMAN SUB. No1.
EIGHTH AVENUE.
120'
40'
20'
F & H. Hempfling 1
Capital Fire Ins. Co. of Cal. 2
R.E. Cannell 3
E.D. Nance 4
5
6
7
E.D. Nance 8
E.D. Nance 9
E.D. Nance 10
H.W Northey 11
H.W. Northey 12
Harry M McCormack 13
F.E. Niles 14
Veterans Welfare Board
Sonoma A. Klees 15
F.W. Ford 16
Marguerite S. Ferguson 17
H A Hendren
E.D. Nance 18
E.D. Nance 19
E.D. Nance 20
F.W. Ford 21
F.W. Ford 22
F.W. Ford 23
F.W. Ford 24
F.W Ford 25
F.W. Ford 26
27
Buena V. Campbell
Edward E. Johnson 28
Edward E. Johnson 29
Chas. H & Emma Tanner 30
Emma Tanner
F.W. Ford 31
F.J. Pribble 32
A.C. McLaughlin 33
J. H. Orr 34
Ernest H. Brabandt 35
Wm. H. Page 36
Jos. M. Nance 37
F.W. Ford 38
Ed. C. Ellsworth 39
F.W. Ford 40
Elmer E. Atwood 41
F.W. Ford 42
F.W. Ford 43
44
45
46
Jos. M. Nance
Jos. M. Nance
Fannie A. Ford
60.50'
40'

BUNGALOW TRACT. ✓✓

Scale: 1 Inch = 40 feet

NOTE: Comprises Lots 280 & 281 of South Oak Park.

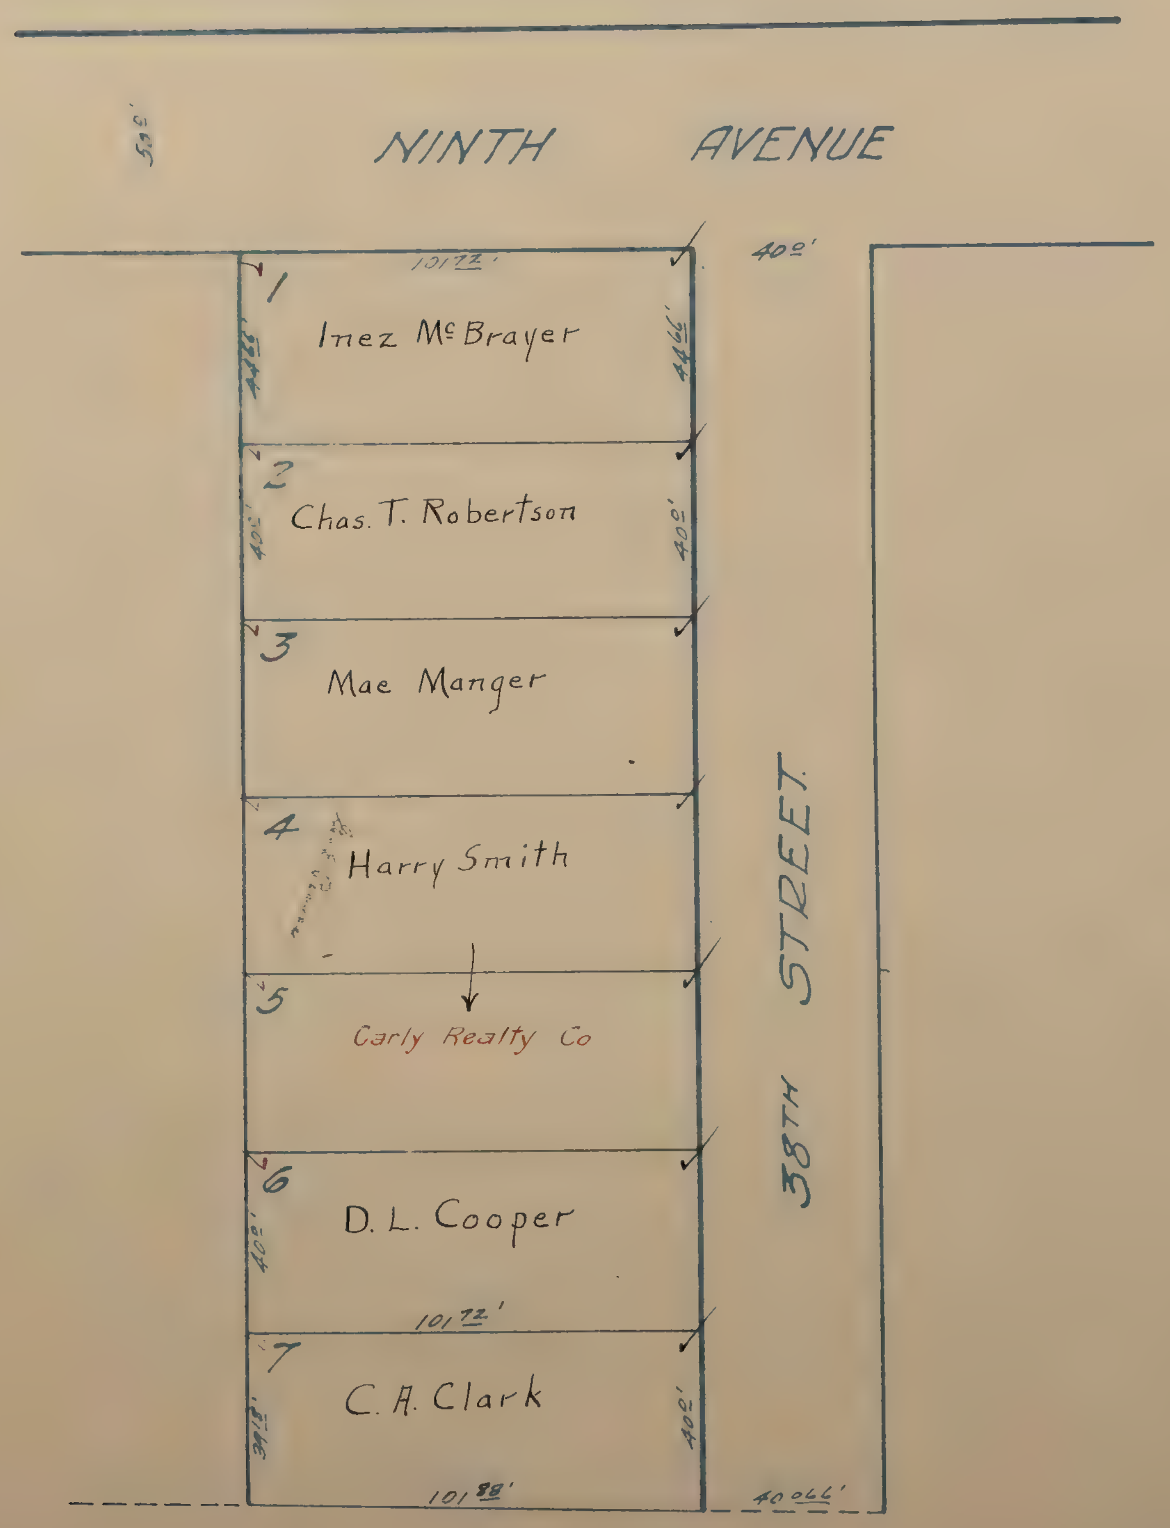
NINTH AVENUE
50^{0}'
101^{72}'
40^{0}'
1
Inez McBrayer
44^{66}'
44^{66}'
2
Chas. T. Robertson
40^{0}'
40^{0}'
3
Mae Manger
4
Harry Smith
5
Carly Realty Co
6
D. L. Cooper
40^{0}'
101^{72}'
7
C. A. Clark
39^{18}'
40^{0}'
101^{88}'
40^{066}'
38TH STREET

Bungalow

BURLINGAME TERRACE ✓

Scale: 1 Inch = 80 feet.

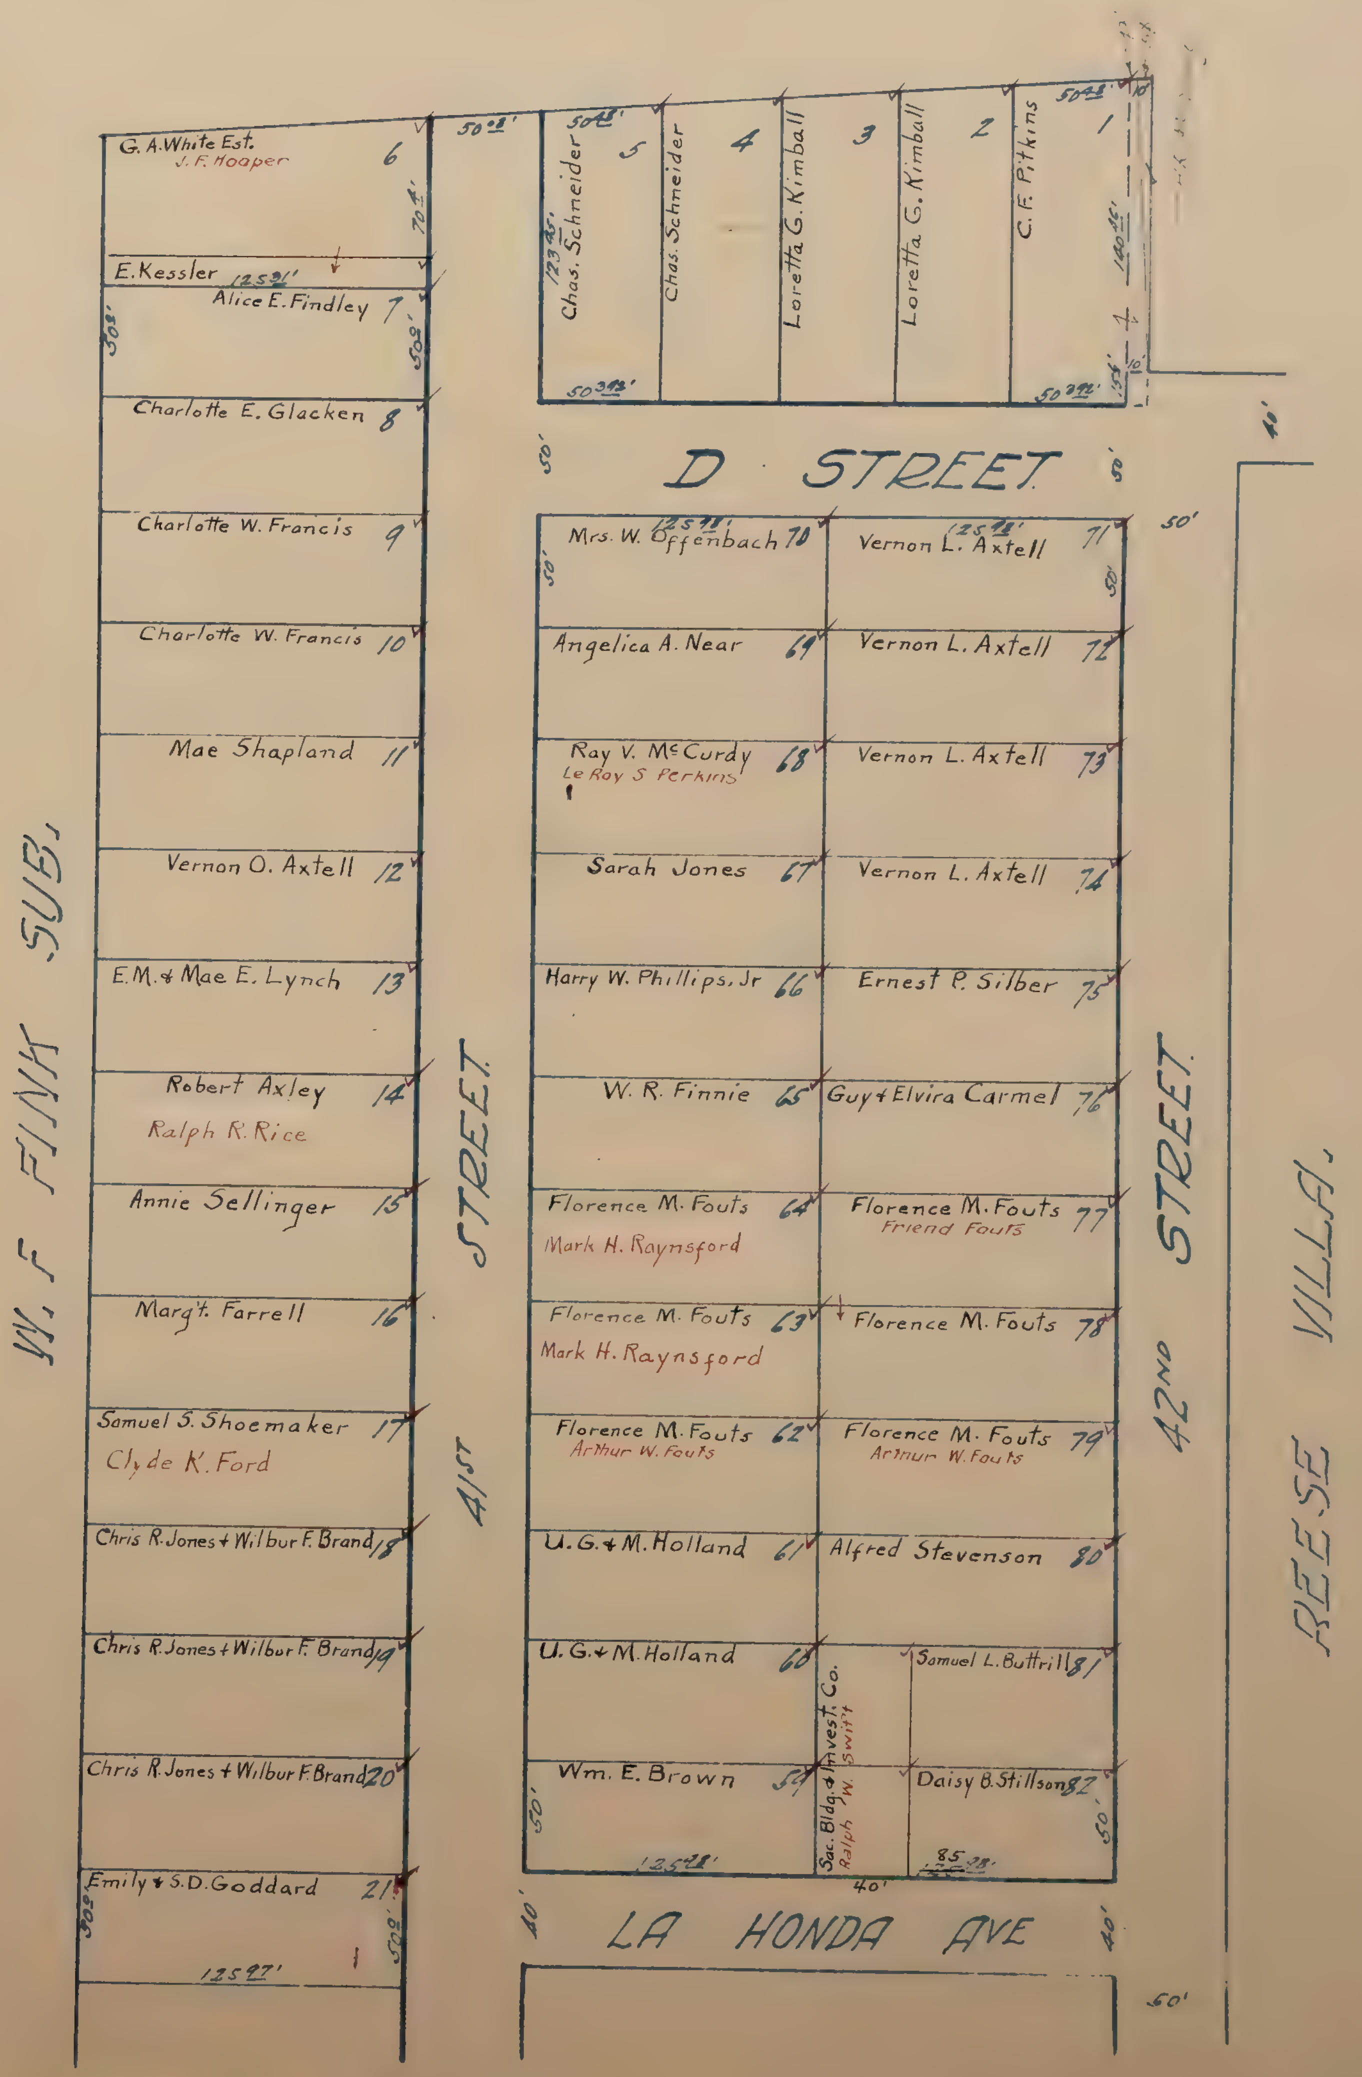

G. A. White Est.
J. F. Hooper
6
70'
E. Kessler
125.31'
Alice E. Findley
7
50'
50'
Charlotte E. Glacken
8
Charlotte W. Francis
9
Charlotte W. Francis
10
Mae Shapland
11
Vernon O. Axtell
12
E. M. & Mae E. Lynch
13
Robert Axley
14
Ralph R. Rice
Annie Sellinger
15
Marg't. Farrell
16
Samuel S. Shoemaker
17
Clyde K. Ford
Chris R. Jones + Wilbur F. Brand
18
Chris R. Jones + Wilbur F. Brand
19
Chris R. Jones + Wilbur F. Brand
20
Emily + S. D. Goddard
21
50'
50'
125.97'
W. F FINK SUB.
41ST STREET
Chas. Schneider
5
123'
Chas. Schneider
4
Loretta G. Kimball
3
Loretta G. Kimball
2
C. F. Pitkins
1
140'
10'
D STREET
50'
50'
50'
40'
Mrs. W. Offenbach
70
125'
Vernon L. Axtell
71
Angelica A. Near
69
Vernon L. Axtell
72
Ray V. McCurdy
Le Roy S Perkins
68
Vernon L. Axtell
73
Sarah Jones
67
Vernon L. Axtell
74
Harry W. Phillips, Jr
66
Ernest P. Silber
75
W. R. Finnie
65
Guy + Elvira Carmel
76
Florence M. Fouts
Mark H. Raynsford
64
Florence M. Fouts
Friend Fouts
77
Florence M. Fouts
Mark H. Raynsford
63
Florence M. Fouts
78
Florence M. Fouts
Arthur W. Fouts
62
Florence M. Fouts
Arthur W. Fouts
79
U. G. + M. Holland
61
Alfred Stevenson
80
U. G. + M. Holland
60
Sac. Bldg. + Invest. Co.
Ralph W. Switt
Samuel L. Buttrill
81
Wm. E. Brown
59
Daisy B. Stillson
82
50'
50'
125.48'
85.28'
40'
42ND STREET
REESE VILLA.
LA HONDA AVE
40'
40'
50'

BURLINGAME TERRACE ✓

Scale: 1 Inch = 80 feet.

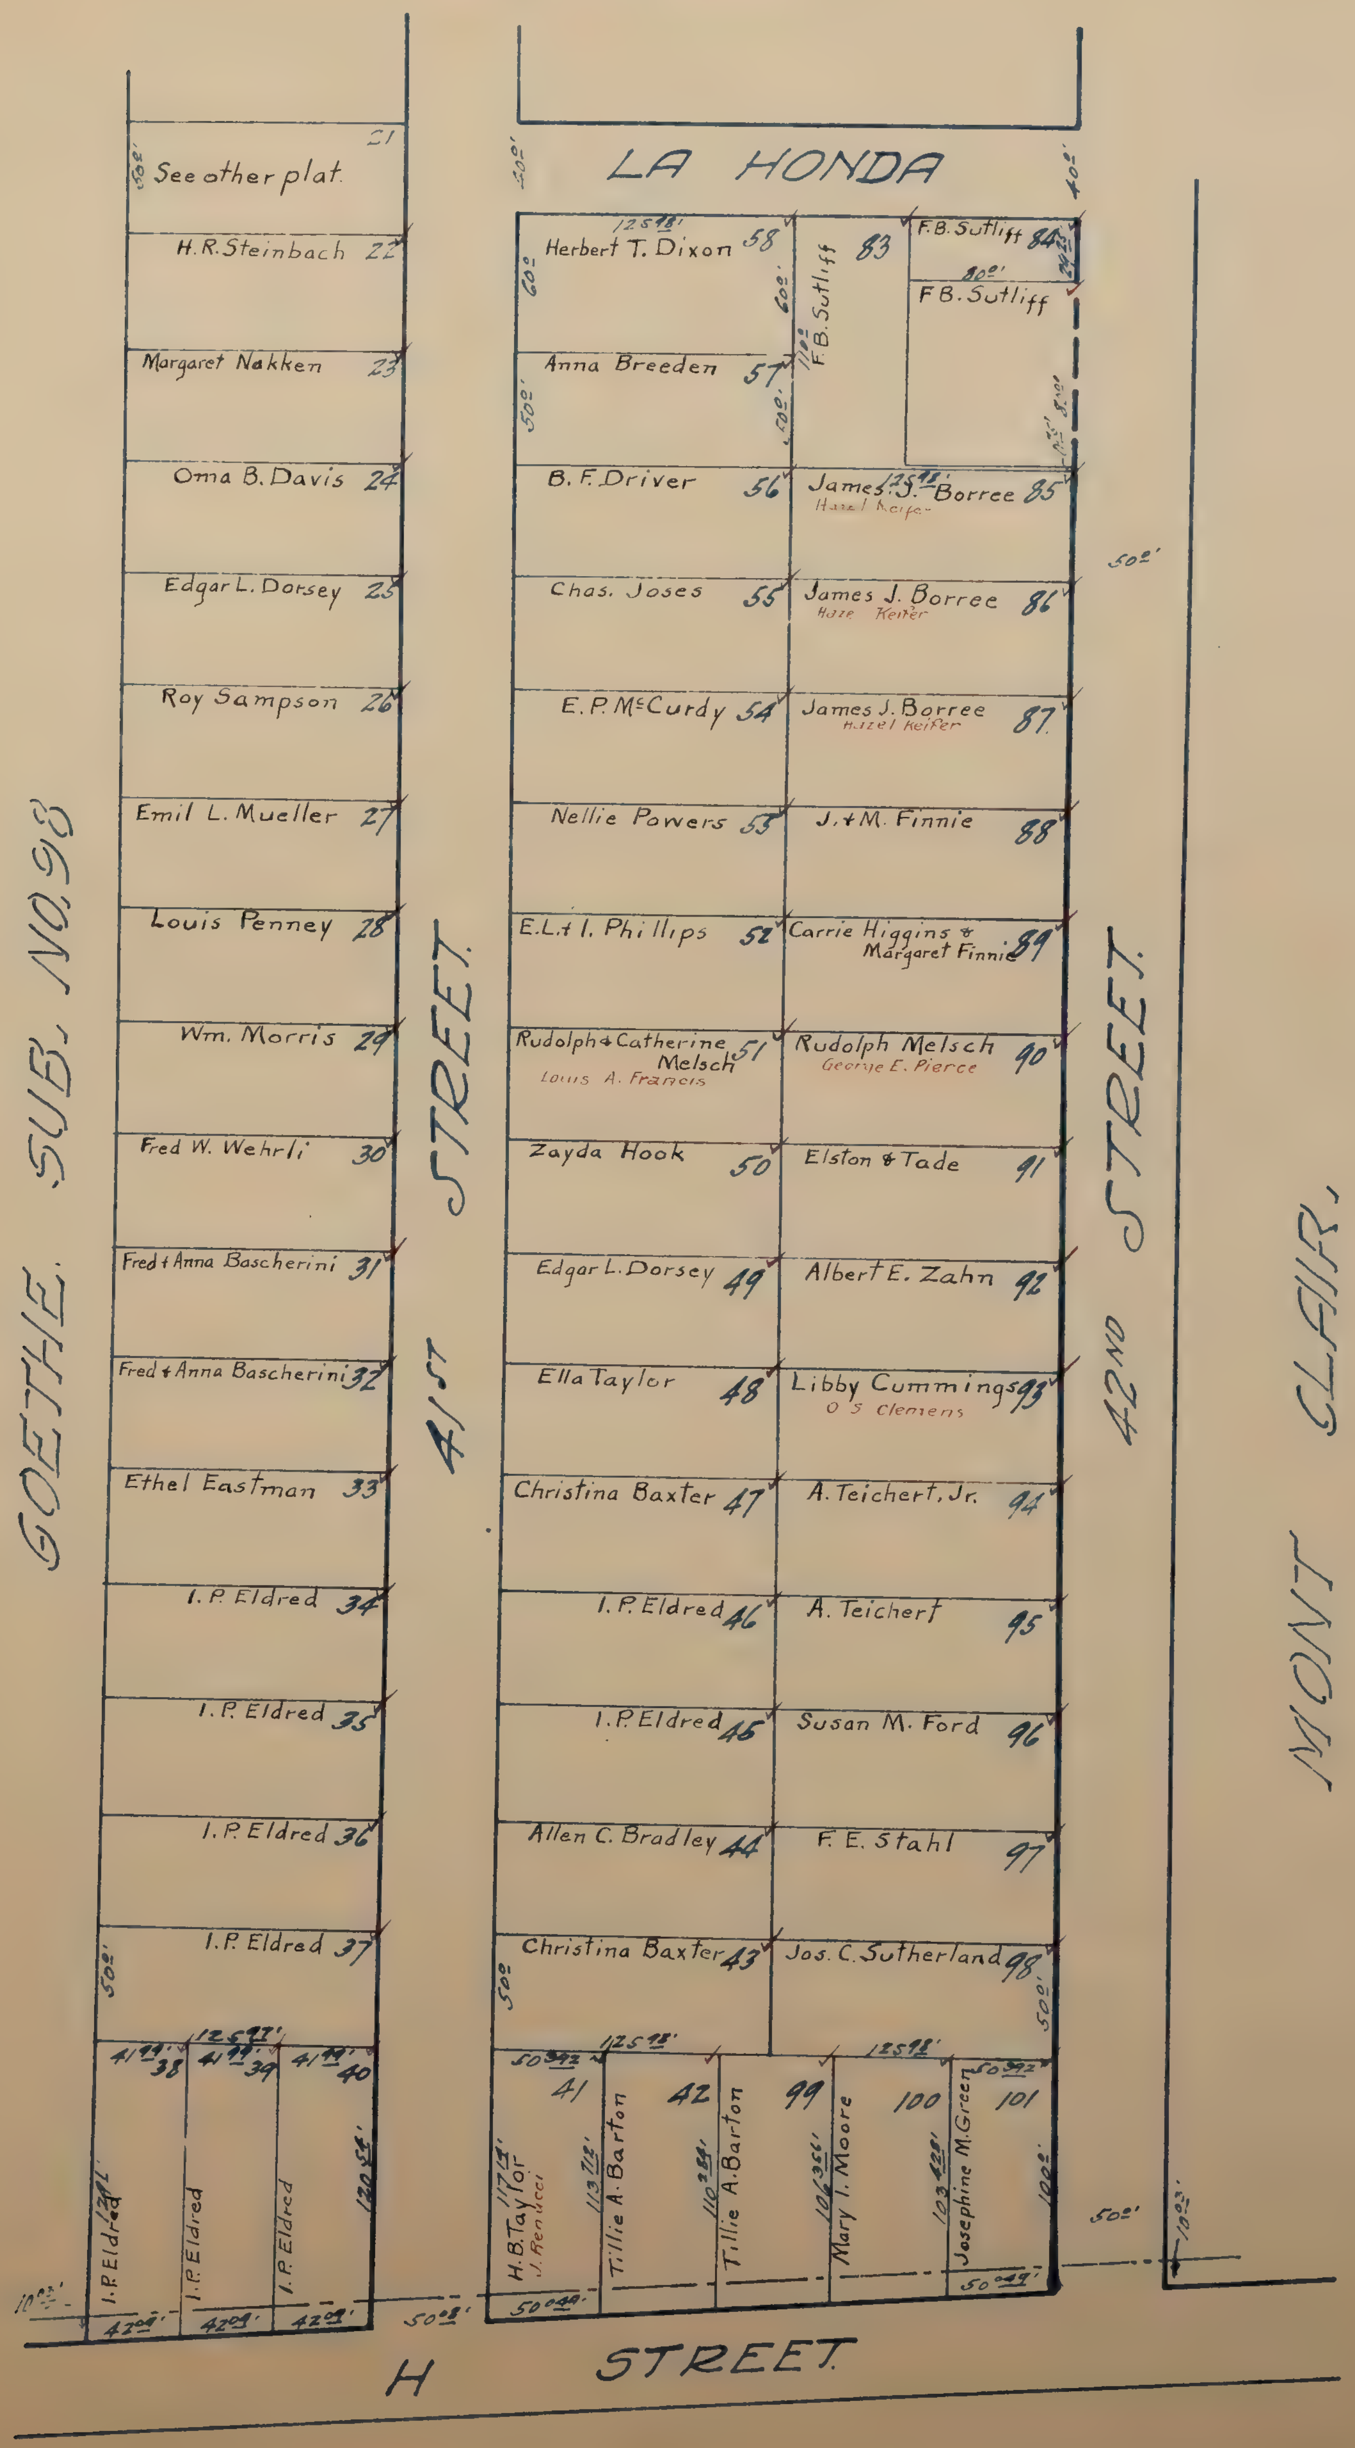
LA HONDA
21 See other plat.
H.R. Steinbach 22
Margaret Nakken 23
Oma B. Davis 24
Edgar L. Dorsey 25
Roy Sampson 26
Emil L. Mueller 27
Louis Penney 28
Wm. Morris 29
Fred W. Wehrli 30
Fred & Anna Boscherini 31
Fred & Anna Boscherini 32
Ethel Eastman 33
I.P. Eldred 34
I.P. Eldred 35
I.P. Eldred 36
I.P. Eldred 37
38 39 40
I.P. Eldred
I.P. Eldred
I.P. Eldred
Herbert T. Dixon 58
Anna Breeden 57
B.F. Driver 56
Chas. Joses 55
E.P. McCurdy 54
Nellie Powers 53
E.L. & I. Phillips 52
Rudolph & Catherine Melsch 51
Louis A. Francis
Zayda Hook 50
Edgar L. Dorsey 49
Ella Taylor 48
Christina Baxter 47
I.P. Eldred 46
I.P. Eldred 45
Allen C. Bradley 44
Christina Baxter 43
41 H.B. Taylor
J. Renucci
42 Tillie A. Barton
99 Tillie A. Barton
100 Mary I. Moore
101 Josephine M. Green
F.B. Sutliff 83
F.B. Sutliff 84
F.B. Sutliff
James J. Borree 85
Hazel Keifer
James J. Borree 86
Haze Keifer
James J. Borree 87
Hazel Keifer
J. & M. Finnie 88
Carrie Higgins & Margaret Finnie 89
Rudolph Melsch 90
George E. Pierce
Elston & Tade 91
Albert E. Zahn 92
Libby Cummings 93
O.S. Clemens
A. Teichert, Jr. 94
A. Teichert 95
Susan M. Ford 96
F.E. Stahl 97
Jos. C. Sutherland 98
GOETHE SUB. NO. 98
41ST STREET
42ND STREET
MONT CLAIR
H STREET
50'
40'
60'
125.98'
50'

CAPITOL HEIGHTS ✓ ✓

Scale 1 inch = 40 feet

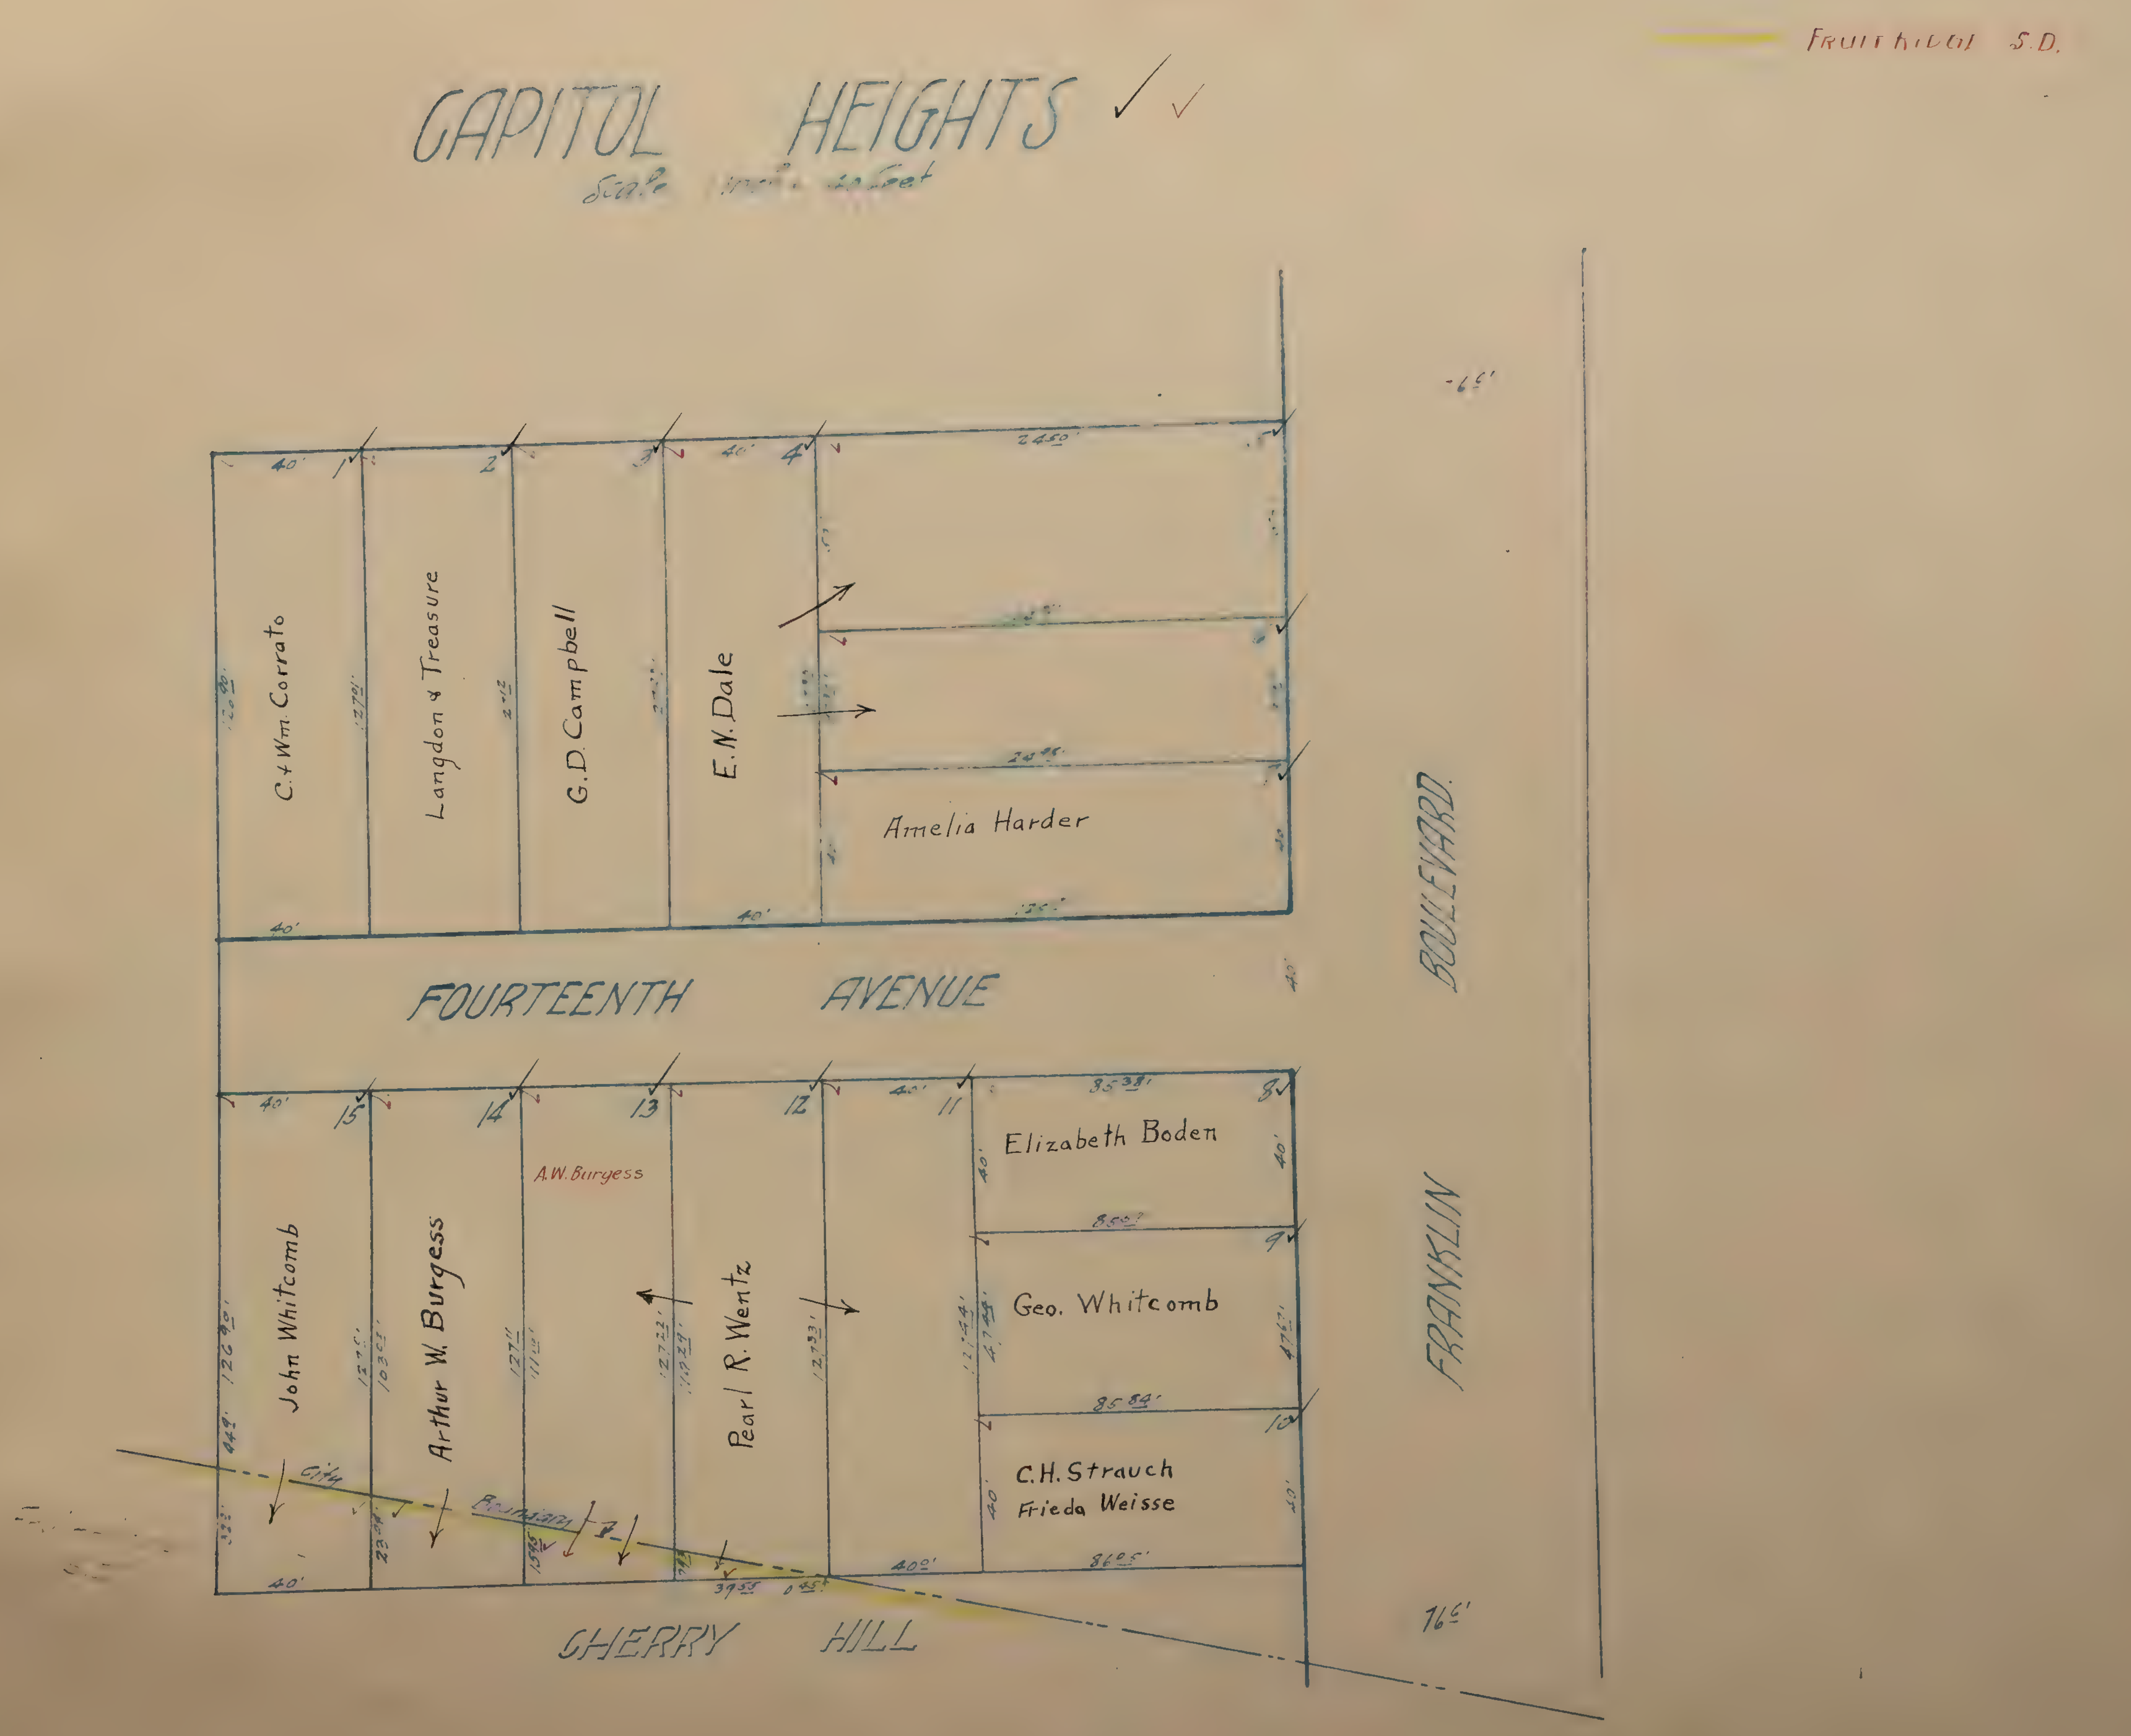
FRUITRIDGE S.D.
1
2
3
4
40'
2450'
C.+ Wm. Corrato
Langdon & Treasure
G.D. Campbell
E.N. Dale
Amelia Harder
127.01'
40'
FOURTEENTH AVENUE
BOULEVARD
FRANKLIN
15
14
13
12
11
8
9
10
A.W. Burgess
John Whitcomb
Arthur W. Burgess
Pearl R. Wentz
Elizabeth Boden
Geo. Whitcomb
C.H. Strauch
Frieda Weisse
35.38'
85.0'
85.84'
86.05'
40.0'
127.33'
127.22'
127.44'
47.44'
47.62'
126.90'
103.03'
23.04'
15.95'
39.55'
0.45'
City Boundary
CHERRY HILL
16.5'

CARSTEN'S ACRES. ✓✓

Scale: 1 inch = 80 feet.

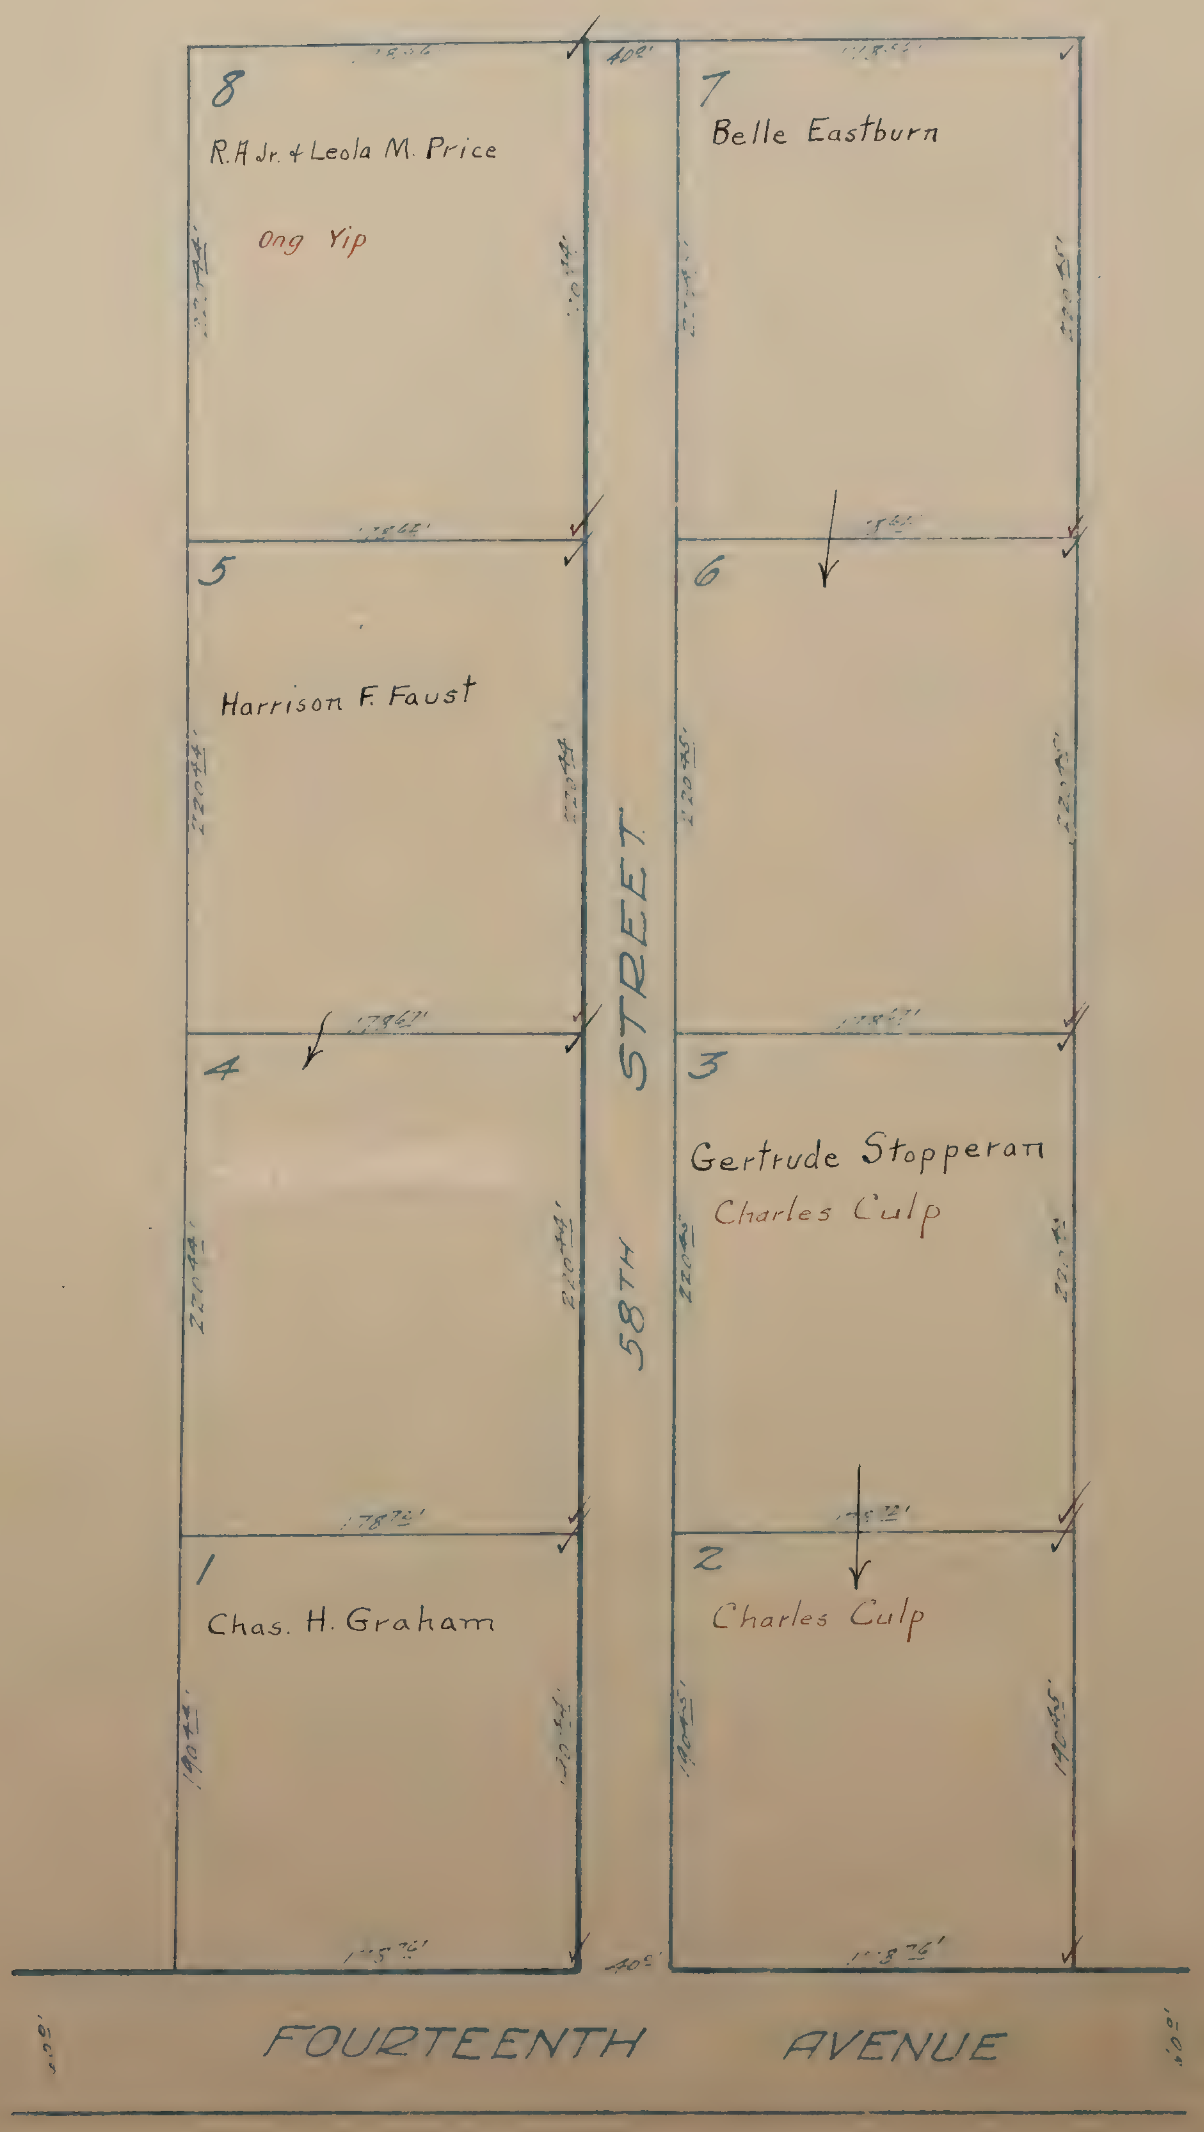
8
R. A. Jr. & Leola M. Price
Ong Yip
7
Belle Eastburn
5
Harrison F. Faust
6
4
3
Gertrude Stopperan
Charles Culp
1
Chas. H. Graham
2
Charles Culp
58TH STREET
FOURTEENTH AVENUE
40'
40'
178.67'
178.72'
178.76'
220.44'
220.45'
190.44'
190.45'

CASA LOMA TERRACE ✓

Scale: 1 Inch = 80 feet.

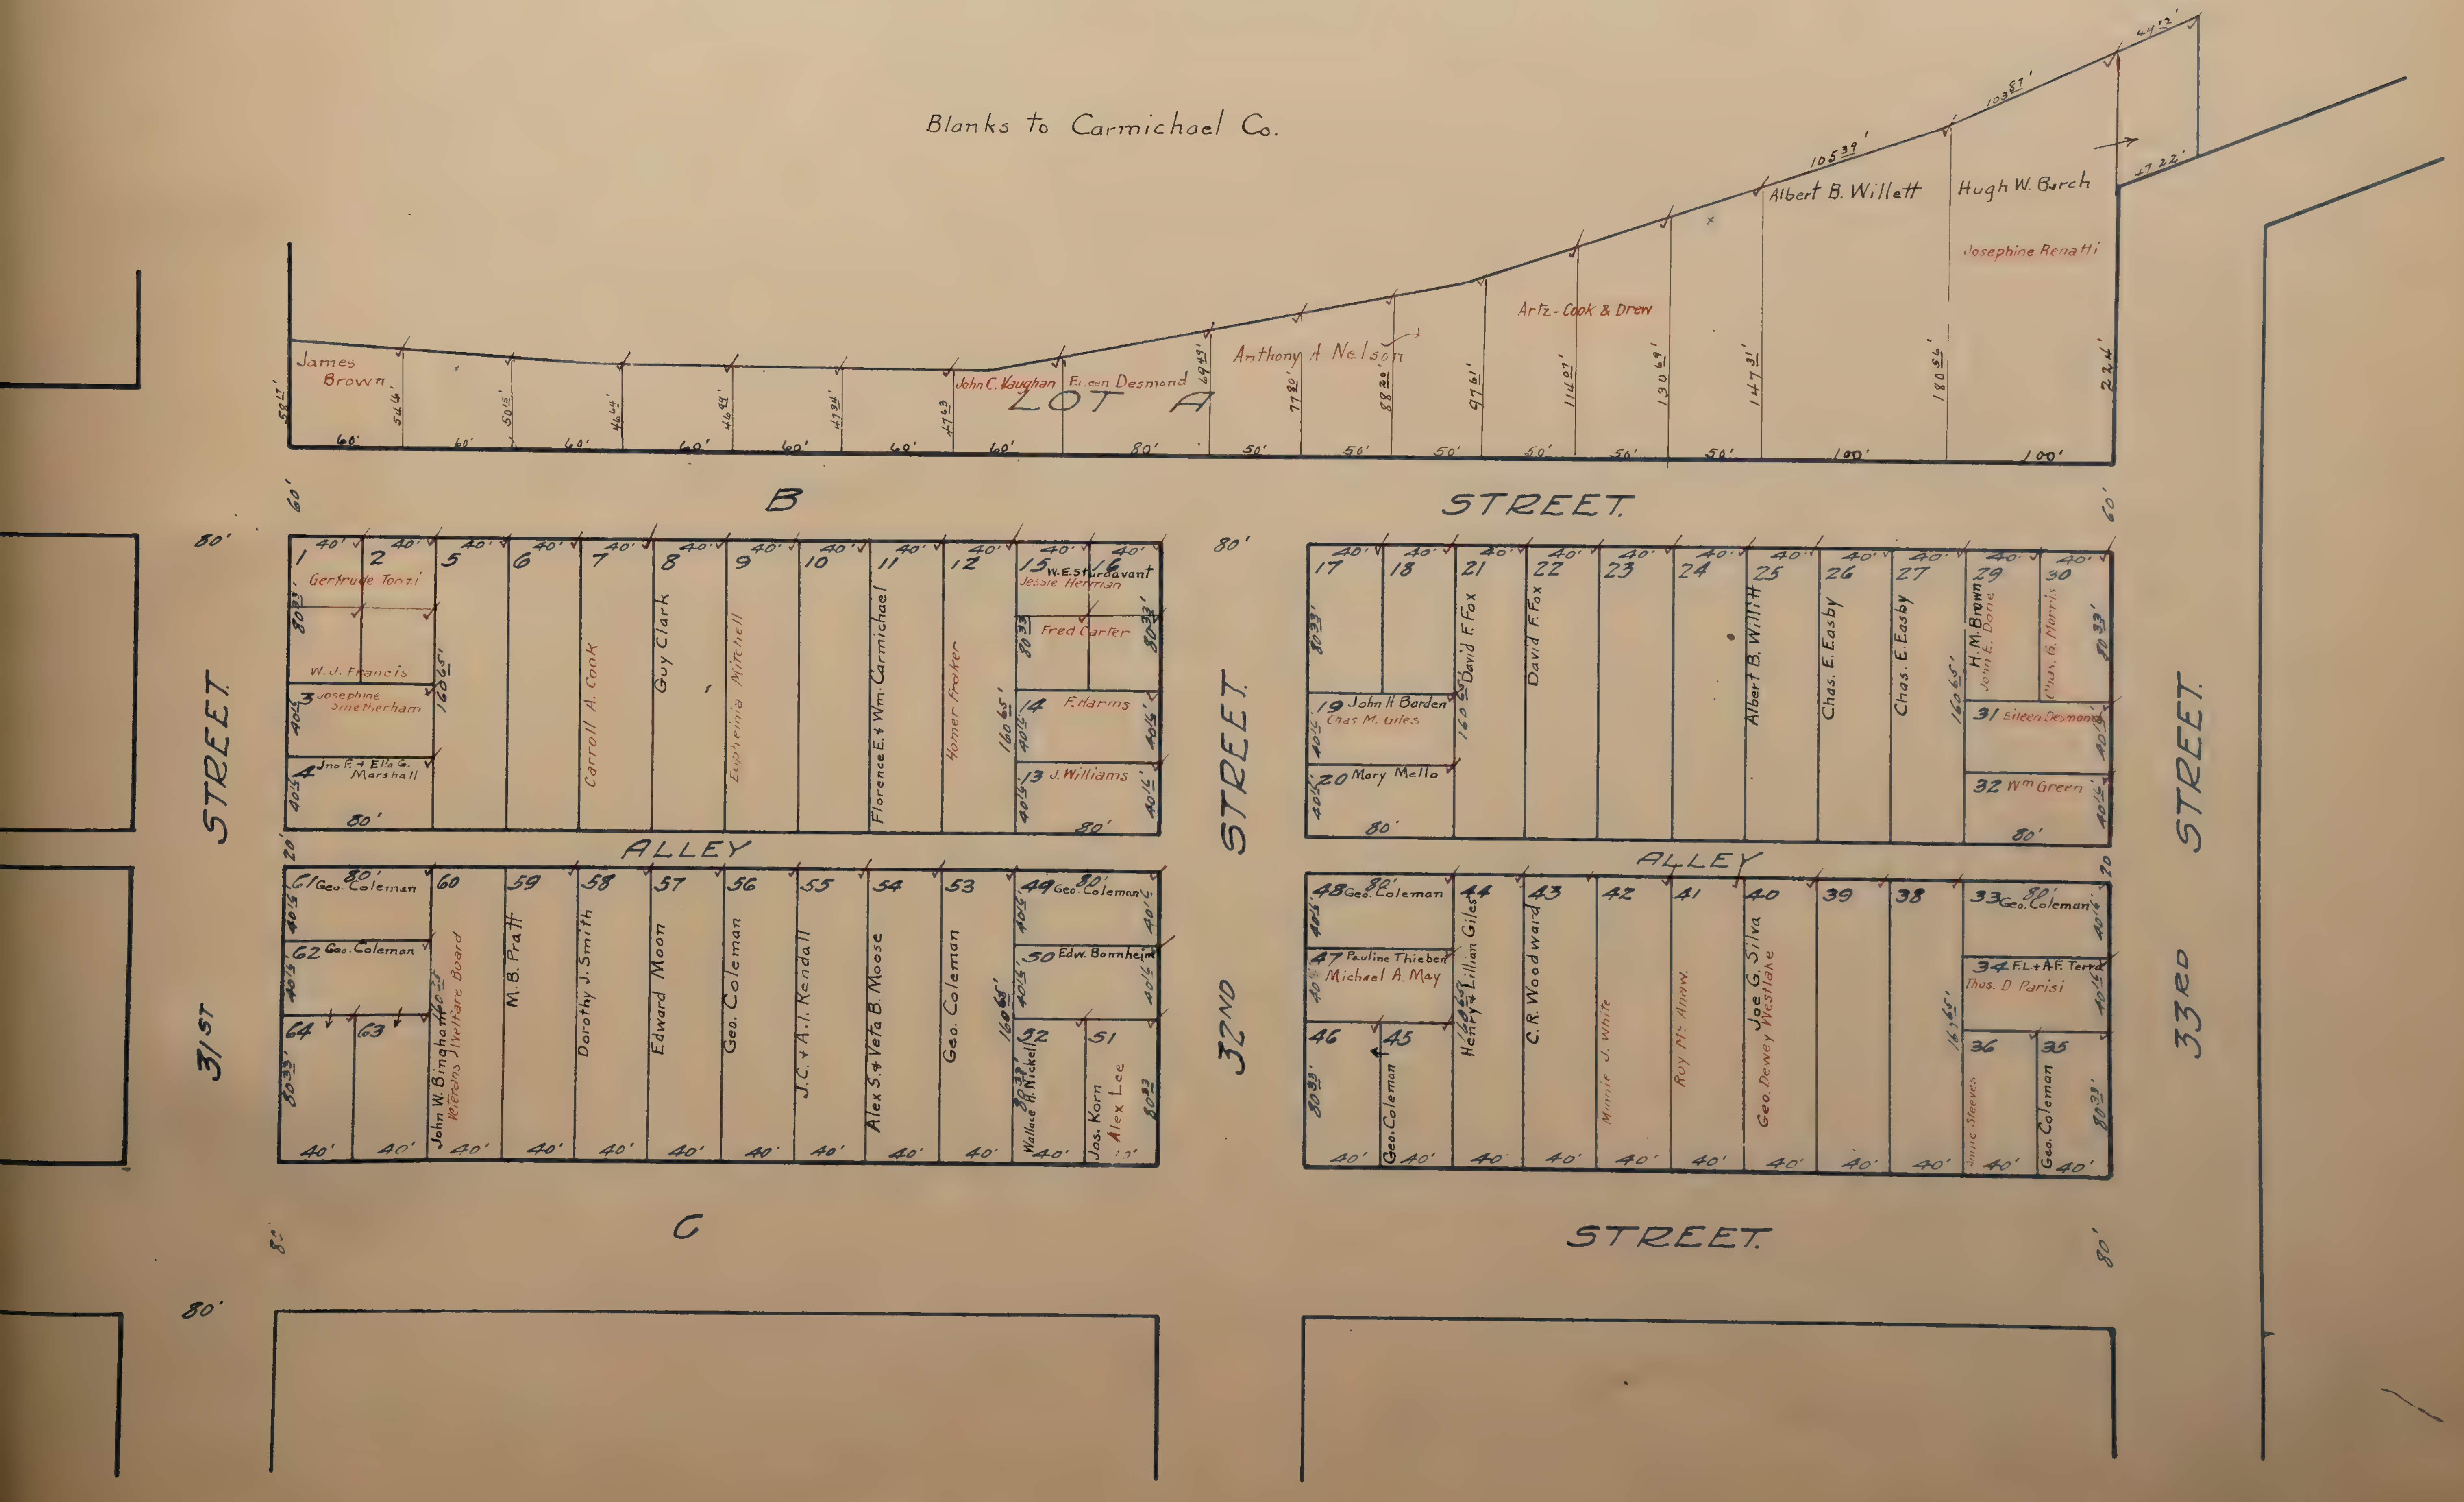

Blanks to Carmichael Co.

LOT A
James Brown
John C. Vaughan
Eileen Desmond
Anthony A. Nelson
Artz - Cook & Drew
Albert B. Willett
Hugh W. Burch
Josephine Renatti
58 17'
54 16'
50 15'
46 64'
46 49'
47 34'
47 63
69 49'
77 80'
88 20'
97 61'
114 07'
130 69'
147 31'
180 56'
224'
105 39'
103 87'
44 12'
47 22'
60'
80'
50'
100'
B
STREET.
C
STREET.
31ST
STREET
32ND
STREET
33RD
STREET
ALLEY
ALLEY
80'
20'
70
1
2
5
6
7
8
9
10
11
12
15
16
Gertrude Tonzi
W. J. Francis
3 Josephine Smetherham
4 Jno F. + Ella G. Marshall
Carroll A. Cook
Guy Clark
Euphemia Mitchell
Florence E. + Wm. Carmichael
Homer Froker
W. E. Sturdavant
Jessie Herman
Fred Carter
14 F. Harms
13 J. Williams
40'
80 33'
40 1/2'
160 65'
17
18
21
22
23
24
25
26
27
29
30
David F. Fox
David F. Fox
Albert B. Willitt
Chas. E. Easby
Chas. E. Easby
H. M. Brown
John E. Done
Chas. G. Morris
19 John H. Barden
Chas. M. Giles
20 Mary Mello
31 Eileen Desmond
32 Wm Green
61 Geo. Coleman
62 Geo. Coleman
64
63
60
59
58
57
56
55
54
53
John W. Bingham
Veterans Welfare Board
M. B. Pratt
Dorothy J. Smith
Edward Moon
Geo. Coleman
J. C. + A. I. Rendall
Alex S. + Veta B. Moose
Geo. Coleman
49 Geo. Coleman
50 Edw. Bonnheim
52 Wallace H. Nickell
51 Jos. Korn
Alex Lee
48 Geo. Coleman
47 Pauline Thieben
Michael A. May
46
45 Geo. Coleman
44 Henry + Lillian Giles
43 C. R. Woodward
42 Minnie J. White
41 Roy McAnaw
40 Joe G. Silva
Geo. Dewey Westlake
39
38
33 Geo. Coleman
34 F. L. + A. F. Terra
Thos. D. Parisi
36 Minnie Sleeves
35 Geo. Coleman

CASA LOMA TERRACE

Scale 1 Inch = 80 feet.

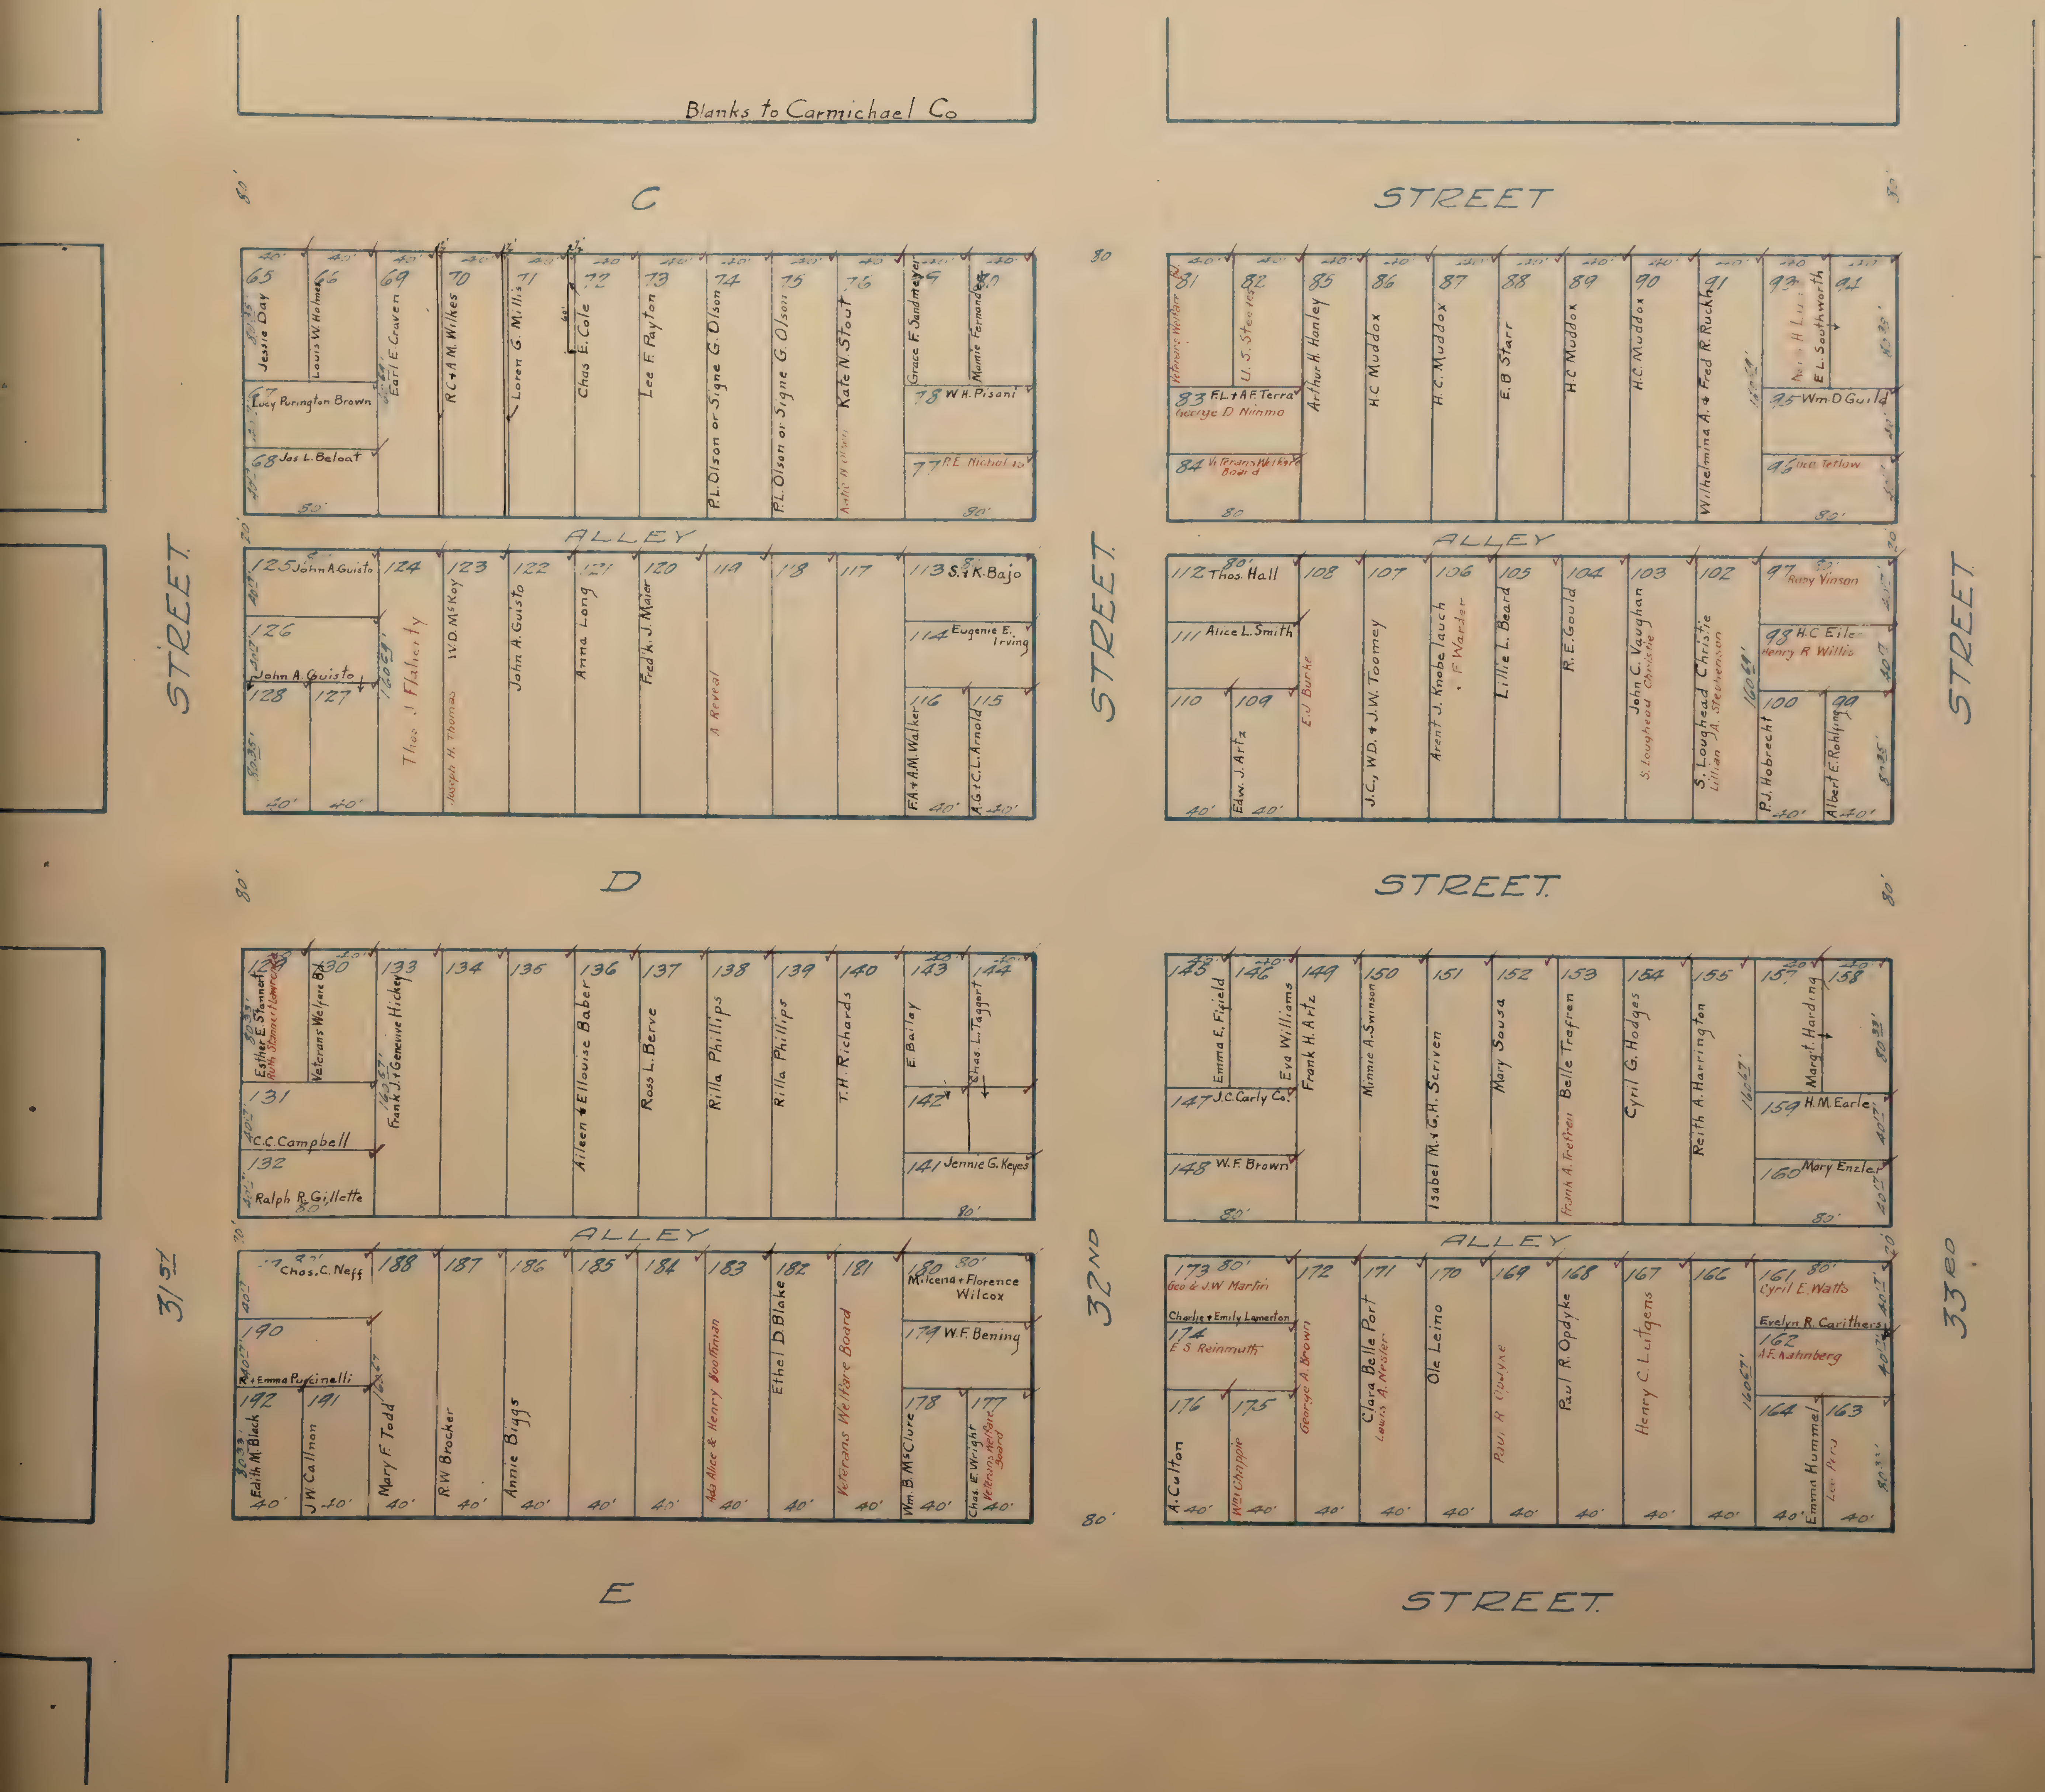
Blanks to Carmichael Co
C STREET
D STREET
E STREET
ALLEY
31st STREET
32ND STREET
33RD STREET
80'
20'
40'
65 Jessie Day
66 Louis W. Holmes
67 Lucy Purington Brown
68 Jos L. Beloat
69 Earl E. Craven
70 R.C. + A.M. Wilkes
71 Loren G. Millis
72 Chas E. Cole
73 Lee F. Payton
74 P.L. Olson or Signe G. Olson
75 P.L. Olson or Signe G. Olson
76 Kate N. Stout
Katie N Olsen
79 Grace F. Sandmeyer
80 Mamie Fernandes
78 W.H. Pisani
77 P.E. Nicholas
125 John A. Guisto
126
John A. Guisto
128
127
124 Thos. J. Flaherty
123 W.D. McKoy
Joseph H. Thomas
122 John A. Guisto
121 Anna Long
120 Fred'k. J. Maier
119 A Reveal
118
117
113 S. + K. Bajo
114 Eugenie E. Irving
116 F.A. + A.M. Walker
115 A.G. + C.L. Arnold
81 Veterans Welfare Bd.
82 U. S. Steeves
83 F.L. + A.F. Terra
George D Nimmo
84 Veterans Welfare Board
85 Arthur H. Hanley
86 H.C Muddox
87 H.C. Muddox
88 E.B Starr
89 H.C Muddox
90 H.C. Muddox
91 Wilhelmina A. + Fred R. Ruckh
93 E.L. Southworth
94
95 Wm. D Guild
96 Lucie Tetlow
112 Thos. Hall
111 Alice L. Smith
110
109 Edw. J. Artz
108 E.J Burke
107 J.C., W.D. + J.W. Toomey
106 Arent J. Knobelauch
F Warder
105 Lillie L. Beard
104 R.E. Gould
103 John C. Vaughan
S. Loughead Christie
102 S. Loughead Christie
Lillian A. Stephenson
97 Ruby Vinson
98 H.C Eiler
Henry R Willis
100 P.J. Hobrecht
99 Albert E. Rohlfing
129 Esther E. Stannert
Ruth Stannert Lawrence
130 Veterans Welfare Bd.
131 C.C. Campbell
132 Ralph R. Gillette
133 Frank J. + Genevive Hickey
134
135
136 Aileen + Ellouise Baber
137 Ross L. Berve
138 Rilla Phillips
139 Rilla Phillips
140 T.H. Richards
143 E. Bailey
144 Chas. L. Taggart
142
141 Jennie G. Keyes
189 Chas. C. Neff
190
R + Emma Puccinelli
192 Edith M. Black
191 J.W. Callnon
188 Mary F. Todd
187 R.W Brocker
186 Annie Biggs
185
184
183 Ada Alice & Henry Boothman
182 Ethel D. Blake
181 Veterans Welfare Board
180 Milcena + Florence Wilcox
179 W.F. Bening
178 Wm. B. McClure
177 Chas. E. Wright
Veterans Welfare Board
145 Emma E. Fifield
146 Eva Williams
147 J.C. Carly Co.
148 W.F. Brown
149 Frank H. Artz
150 Minnie A. Swinson
151 Isabel M. + G.H. Scriven
152 Mary Sousa
153 Belle Trefren
Frank A. Trefren
154 Cyril G. Hodges
155 Reith A. Harrington
157 Marg't. Harding
158
159 H.M. Earle
160 Mary Enzler
173 Geo & J.W Martini
Charlie + Emily Lamerton
174 E S Reinmuth
176 A. Colton
175 Wm Chappie
172 George A. Brown
171 Clara Belle Port
Lewis A. Nesler
170 Ole Leino
169 Paul R Opdyke
168 Paul R. Opdyke
167 Henry C. Lutgens
166
161 Cyril E. Watts
Evelyn R. Carithers
162 A.F. Kahnberg
164 Emma Hummel
163 Lee Pero
160.67'
80.33'
40.17'

DIST N6

CASELLAS' SUBDIVISION

SCALE 1" = 100'

All Blanks assessed to R. Casella

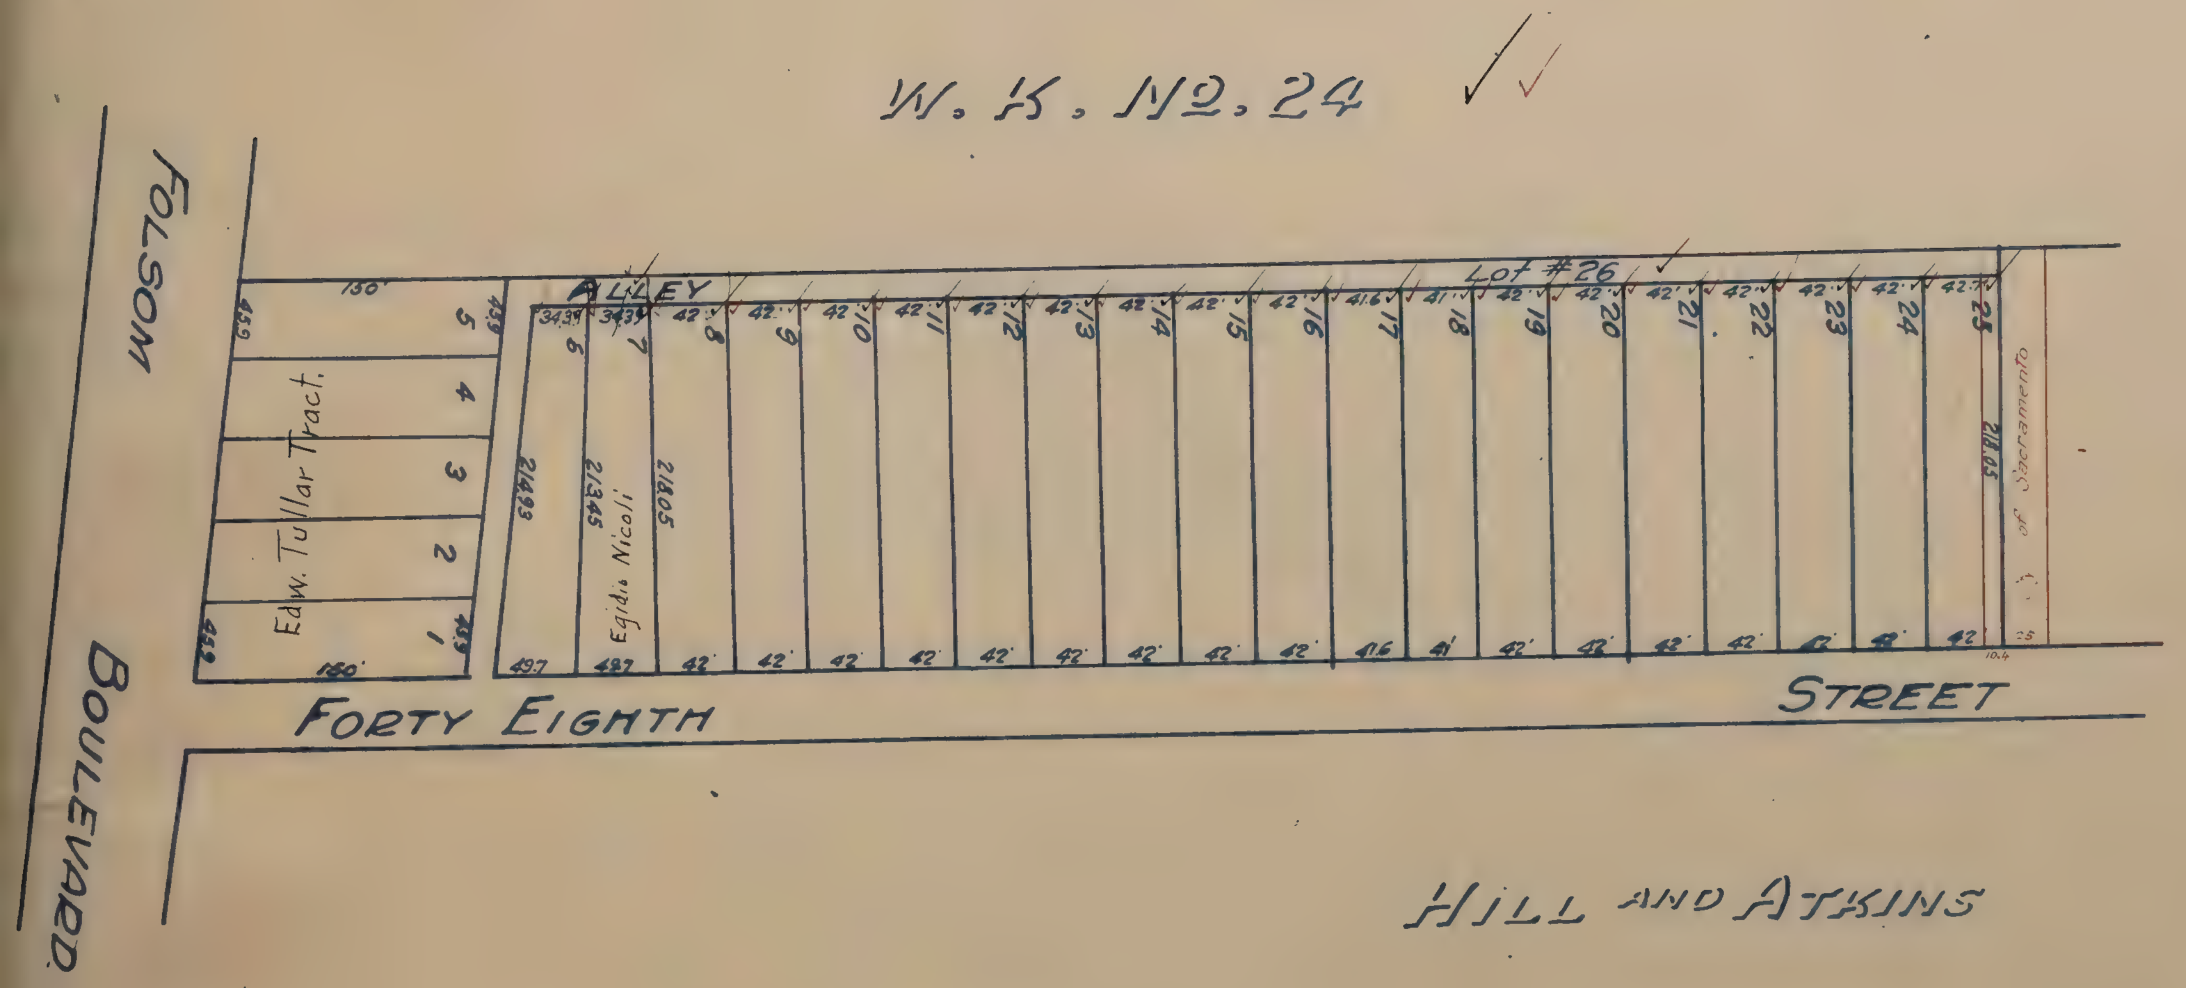
W. K. No. 24 ✓✓
FOLSOM BOULEVARD
ALLEY
Lot #26
Edw. Tullar Tract.
1
2
3
4
5
150'
150'
45.9
45.9
45.9
45.9
34.39
34.39
6
7
8
9
10
11
12
13
14
15
16
17
18
19
20
21
22
23
24
25
214.93
213.45
218.05
218.05
Egidio Nicoli
49.7
48.7
42'
41.6
41'
42.7
10.4
25
of Sacramento
FORTY EIGHTH STREET
HILL AND ATKINS

Casellas

TRACT OF LAND ✓

owned by

JOHN S. CASEY & GEO. H. CASEY.

located in

SACRAMENTO CITY.

Scale: 1" = 3 chains.

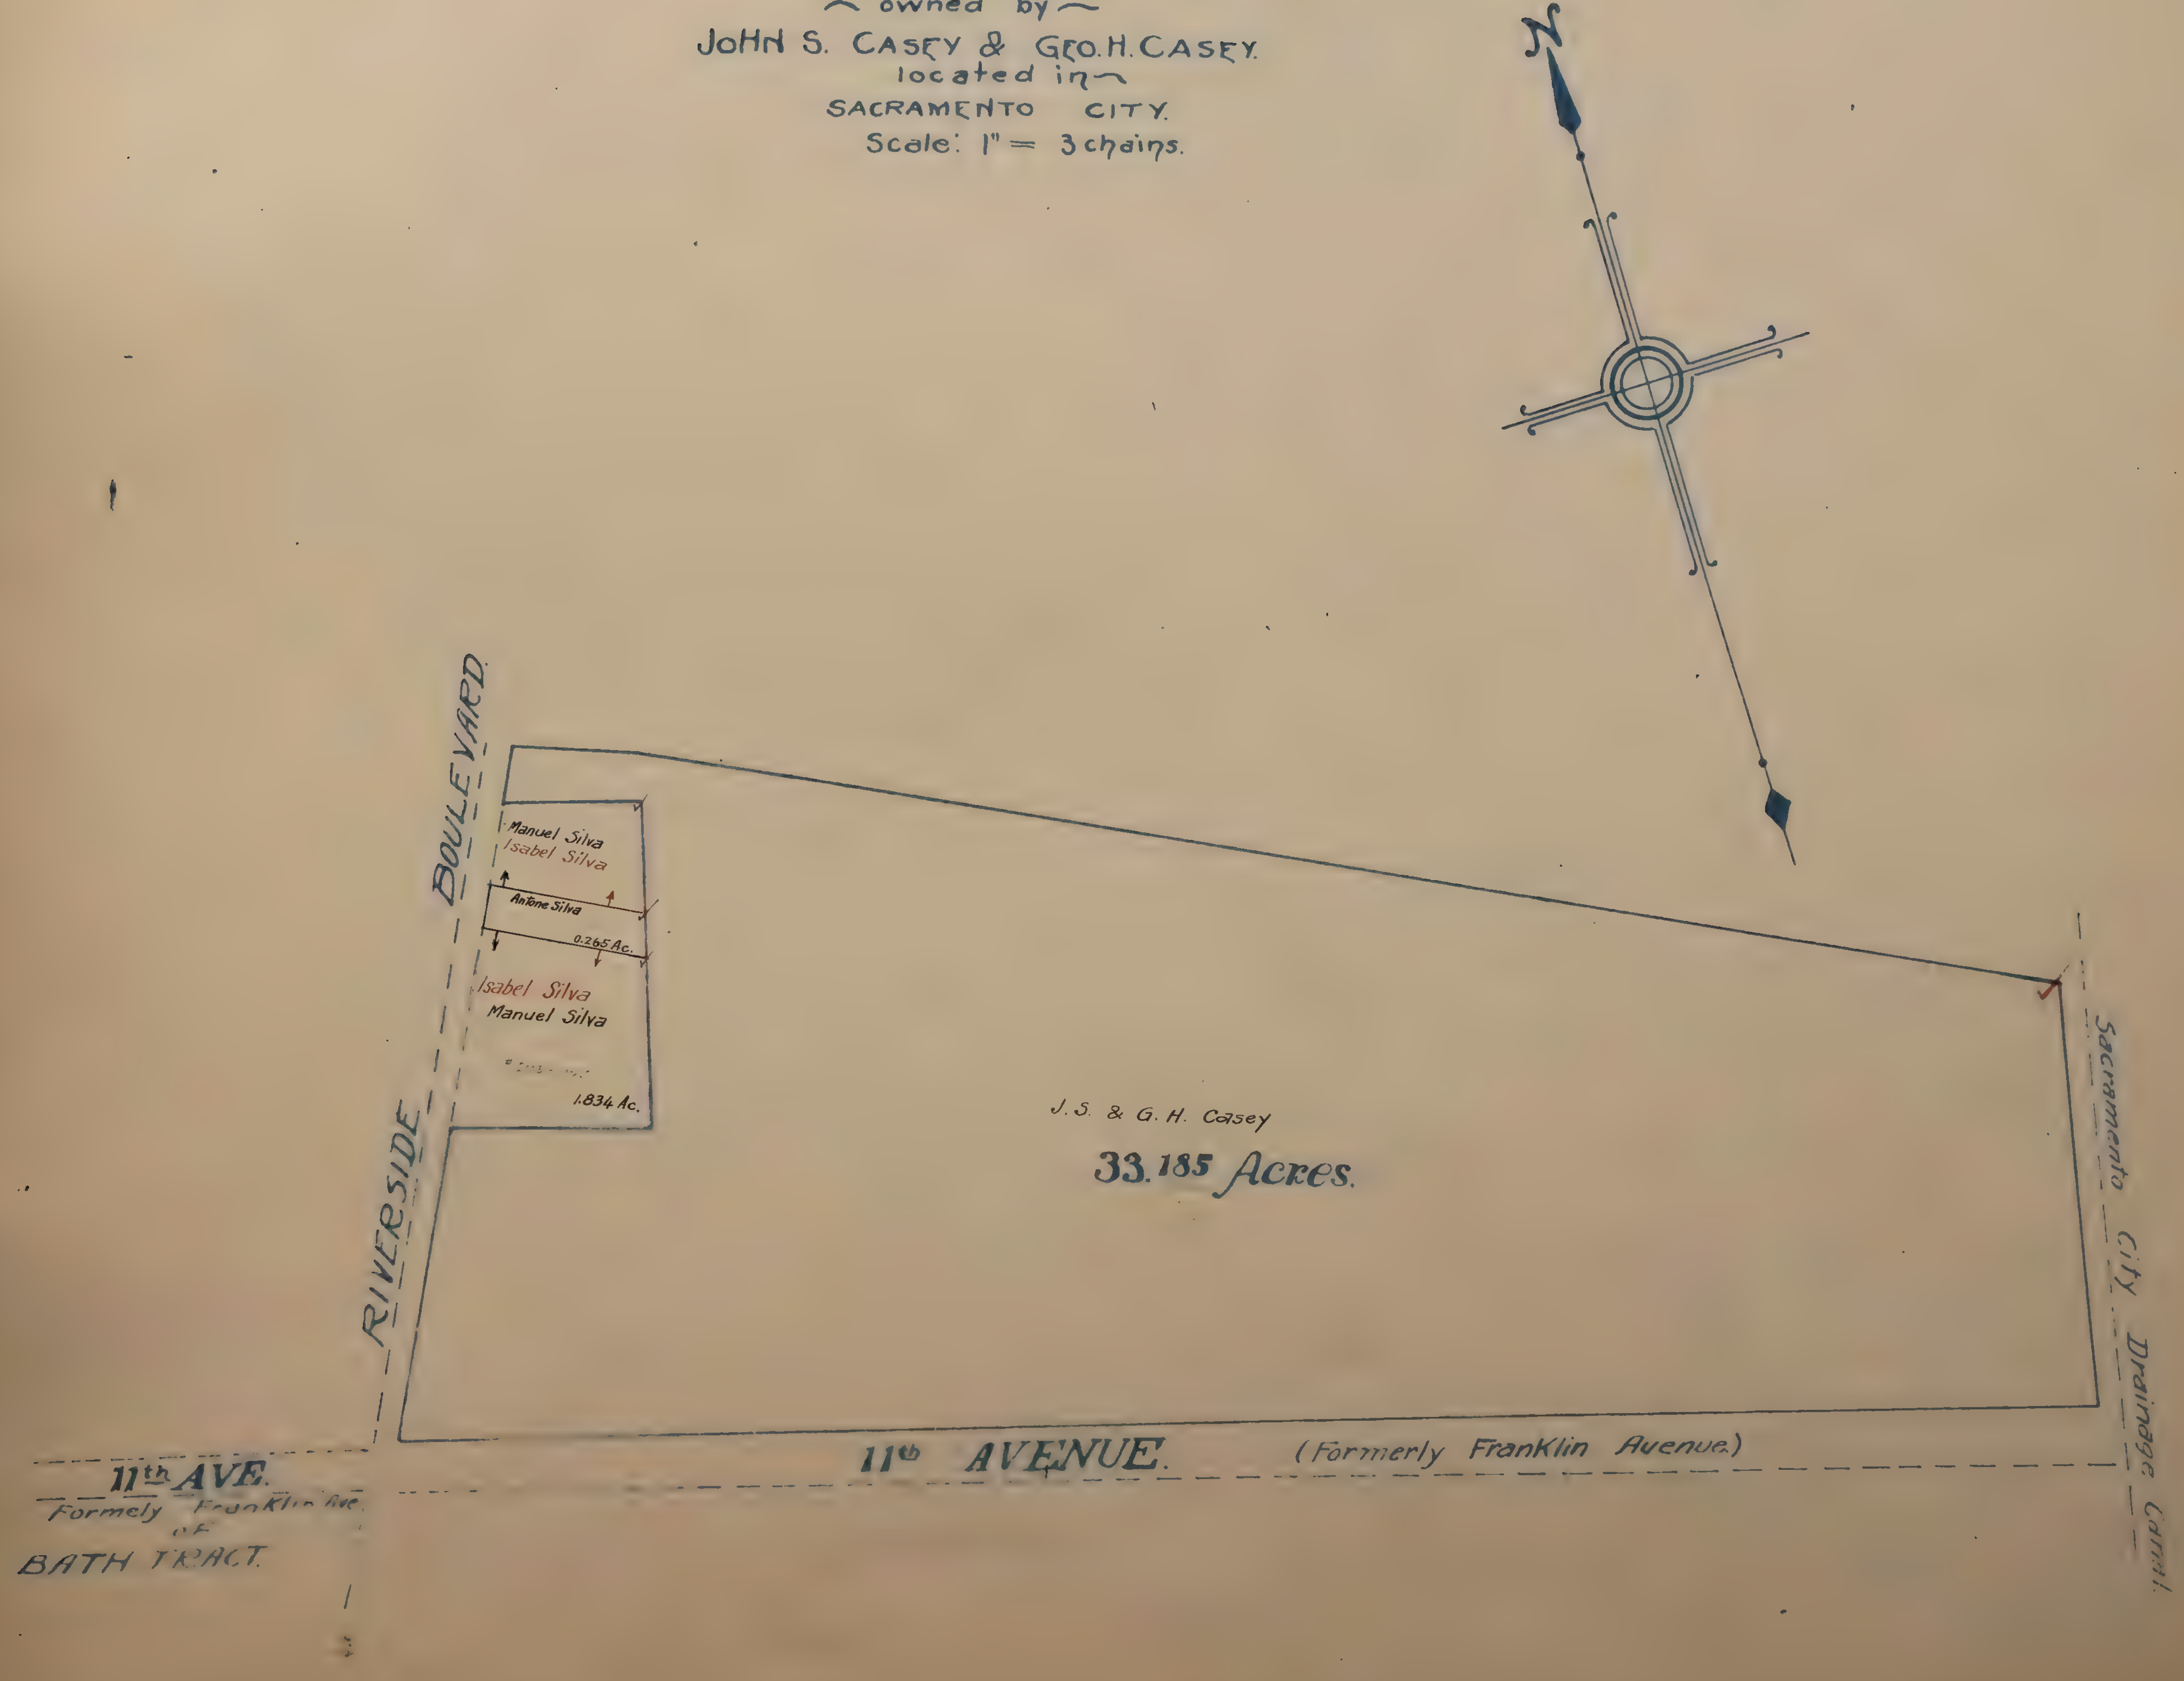
N
RIVERSIDE BOULEVARD
Manuel Silva
Isabel Silva
Antone Silva
0.265 Ac.
Isabel Silva
Manuel Silva
1.834 Ac.
J. S. & G. H. Casey
33.185 Acres.
Sacramento City Drainage Canal
11th AVENUE. (Formerly Franklin Avenue)
11th AVE.
Formely Franklin Ave.
of
BATH TRACT.

J.C. CARLY Co.

CASITA SUBDIVISION ✓✓

SCALE 60' to 1"

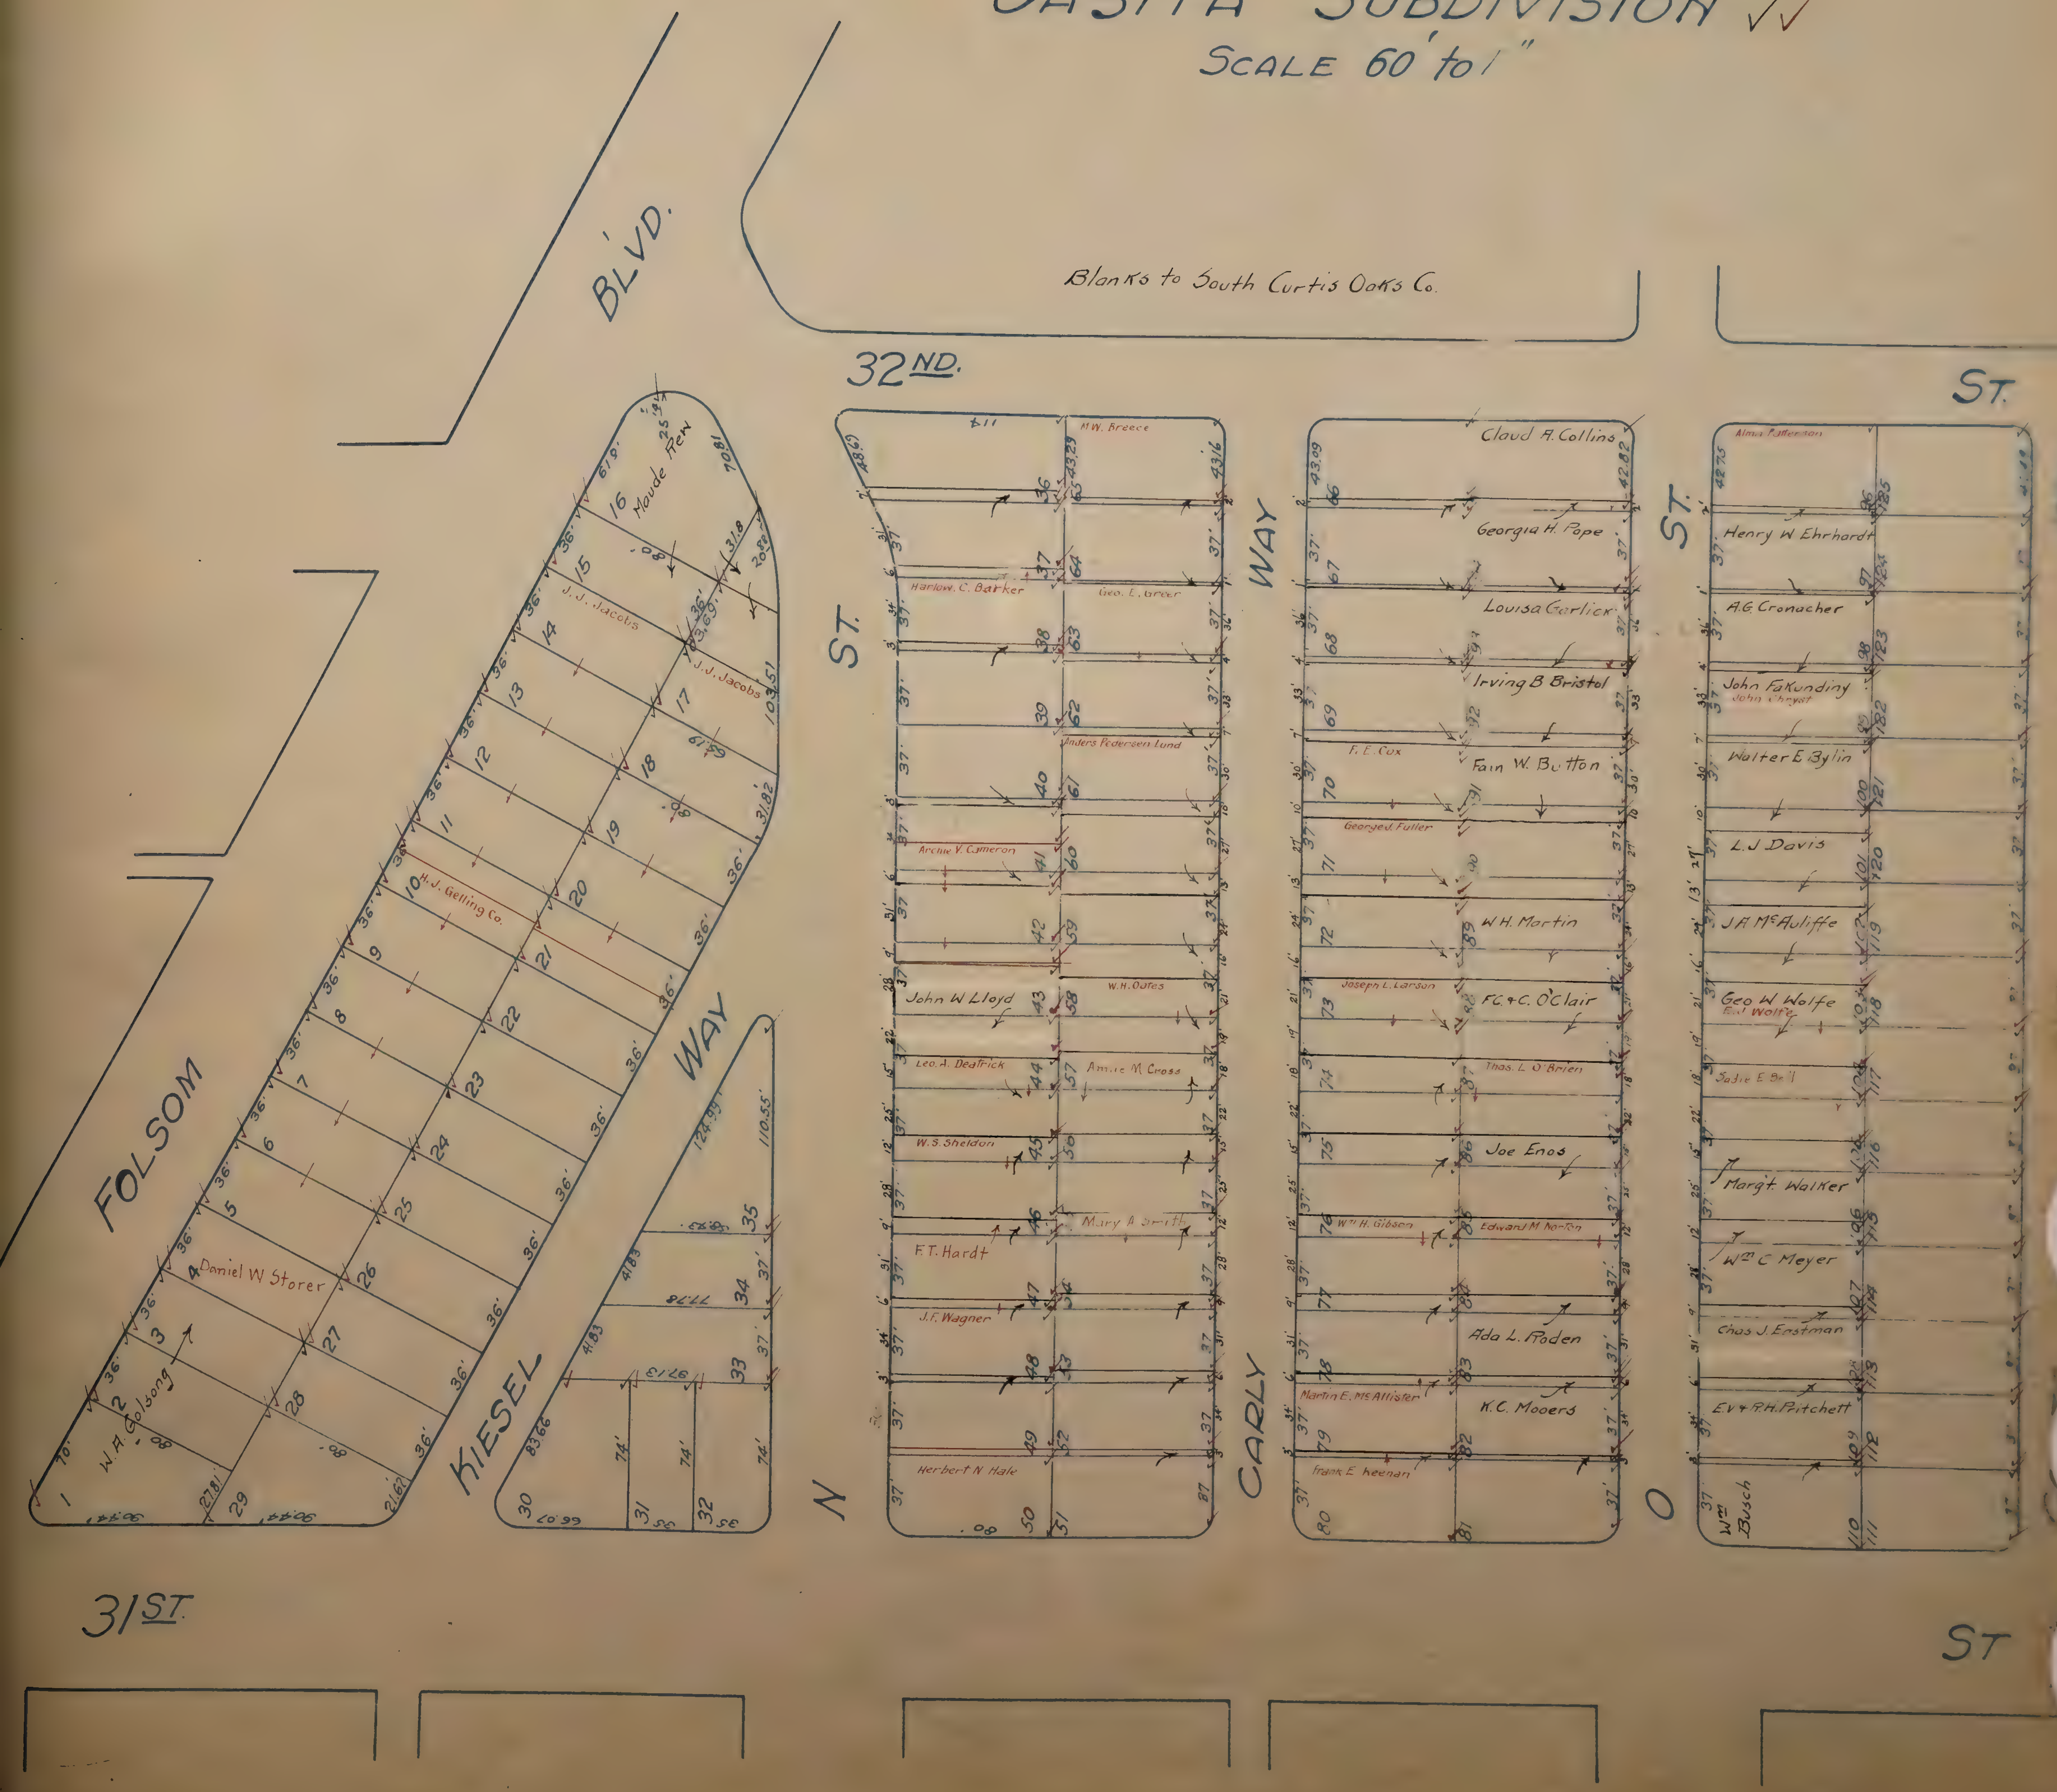
Blanks to South Curtis Oaks Co.
BLVD.
32ND. ST.
FOLSOM
KIESEL WAY
N ST.
CARLY WAY
O ST.
31ST.
ST
Maude Pew
J. J. Jacobs
J. J. Jacobs
H. J. Gelling Co.
Daniel W Storer
W. A. Golsong
M.W. Breece
Harlow. C. Barker
Geo. E. Greer
Anders Pedersen Lund
Archie V. Cameron
John W Lloyd
W.H. Oates
Leo. A. Deatrick
Annie M Cross
W. S. Sheldon
Mary A Smith
F.T. Hardt
J.F. Wagner
Herbert N Hale
Claud A. Collins
Georgia H. Pope
Louisa Garlick
Irving B Bristol
F. E. Cox
Fain W. Button
George J. Fuller
W.H. Martin
Joseph L. Larson
F.C. & C. O'Clair
Thos. L O'Brien
Joe Enos
Wm H. Gibson
Edward M Norton
Ada L. Roden
Martin E. McAllister
K.C. Mooers
Frank E Keenan
Alma Patterson
Henry W Ehrhardt
A.G. Cronacher
John Fakundiny
John Chryst
Walter E Bylin
L.J Davis
J.A McAuliffe
Geo W Wolfe
E.J Wolfe
Sadie E Bell
Marg't. Walker
Wm C Meyer
Chas J. Eastman
E.V & R.H. Pritchett
Wm Busch

CARLY

J. C. CARLY CO.

CASITA SUBDIVISION

SCALE 60' to 1"

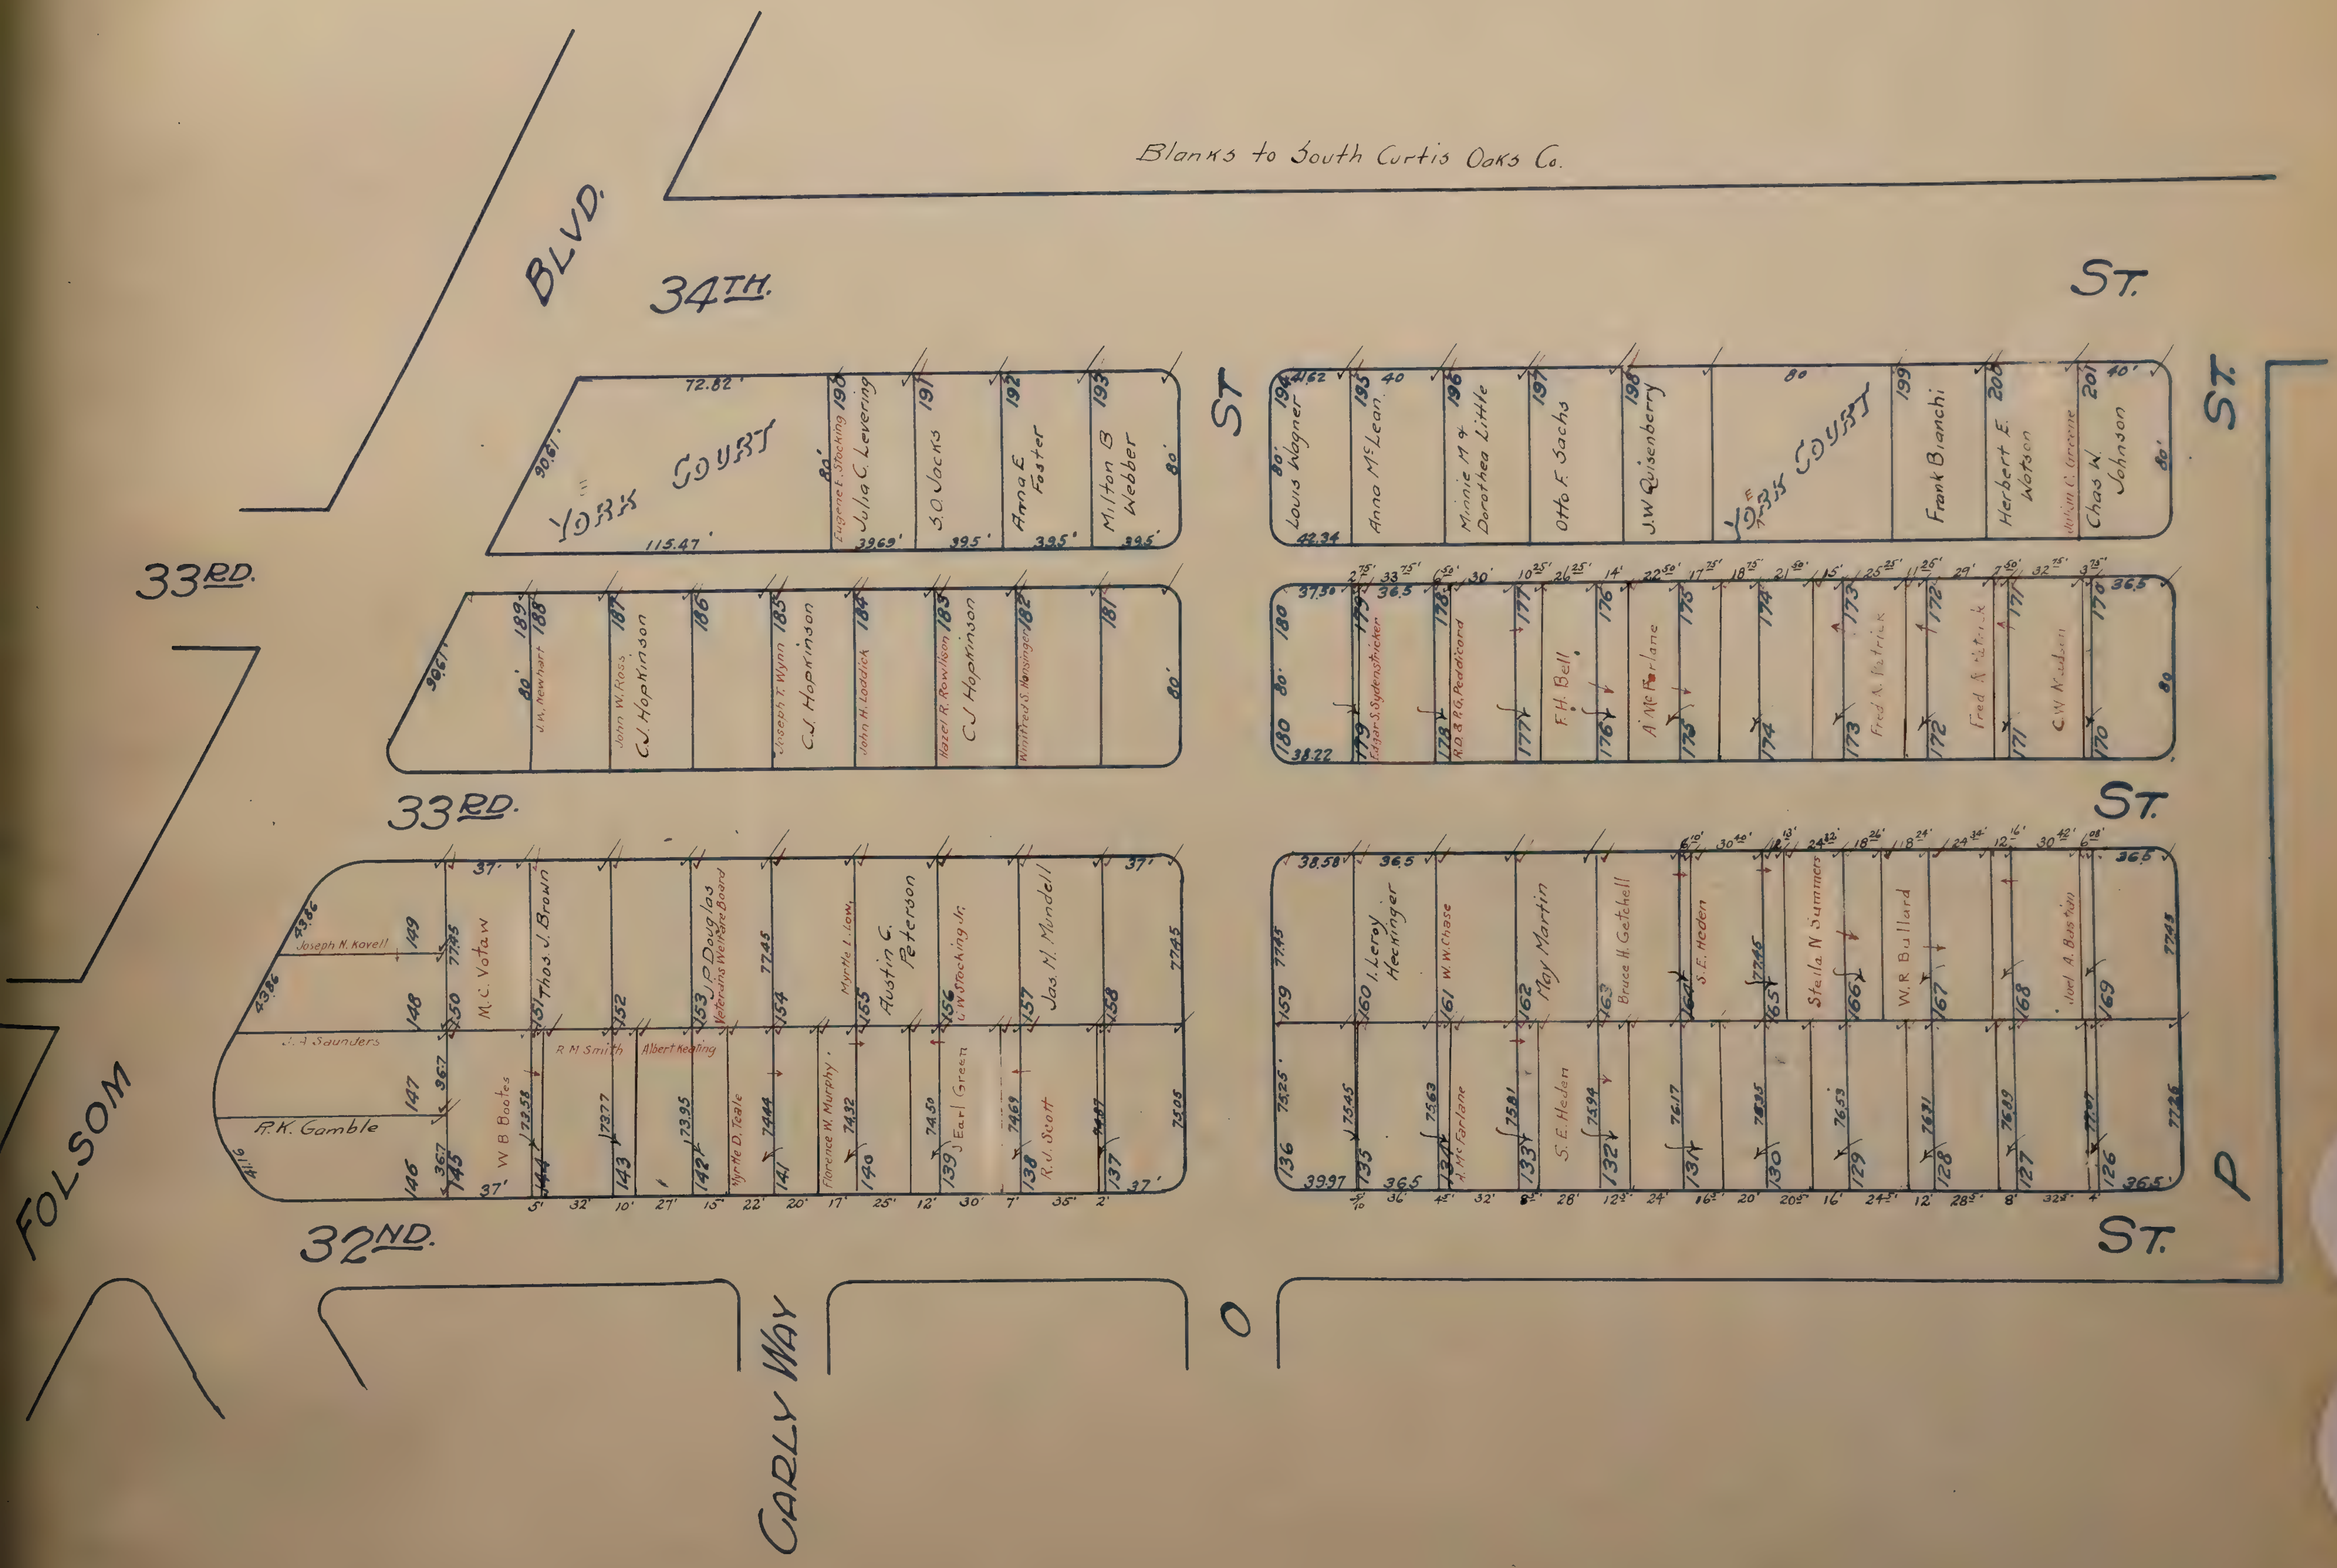
Blanks to South Curtis Oaks Co.
BLVD.
34TH. ST.
33RD. ST.
33RD.
32ND. ST.
FOLSOM
CARLY WAY
O ST
P ST
YORK COURT
72.82'
90.61'
115.47'
190 Eugene E. Stocking Julia C. Levering
191 S.O. Jacks
192 Anna E. Foster
193 Milton B. Webber
39.69'
39.5'
80'
194 Louis Wagner
195 Anna McLean
196 Minnie M & Dorothea Little
197 Otto F. Sachs
198 J.W. Quisenberry
199 Frank Bianchi
200 Herbert E. Watson
201 Julian C. Greene Chas W. Johnson
42.34
41.62
189
188 J.W. Newhart
187 John W. Ross C.J. Hopkinson
186
185 Joseph T. Wynn C.J. Hopkinson
184 John H. Loddick
183 Hazel R. Rowlison C.J. Hopkinson
182 Winifred S. Hansinger
181
180
179 Edgar S. Sydenstricker
178 R.D. & P.G. Peddicord
177
176 F.H. Bell
175 A. McFarlane
174
173 Fred A. Patrick
172 Fred A. Patrick
171
170 C.W. Madson
37.50'
38.22
36.5
149 Joseph N. Kovell
148
147 J.A. Saunders
146 R.K. Gamble
150 M.C. Votaw
151 Thos. J. Brown
152
153 J.P. Douglas Veterans Welfare Board
154
155 Myrtle L. Low
Austin C. Peterson
156 C.W. Stocking Jr.
157 Jas. M. Mundell
158
145 W.B. Bootes
144
143 R.M. Smith
Albert Keating
142
141 Myrtle D. Teale
140 Florence W. Murphy
139 J. Earl Green
138 R.J. Scott
137
43.86
41.16
36.7
37'
77.45
75.05
159
160 I. Leroy Heckinger
161 W.W. Chase
162 May Martin
163 Bruce H. Getchell
164 S.E. Heden
165
166 Stella N. Summers
167 W.R. Bullard
168
169 Joel A. Bastian
136
135
134 A. McFarlane
133
132 S.E. Heden
131
130
129
128
127
126
38.58
39.97
36.5
77.26

J.C. CARLY Co.

CASITA SUBDIVISION

SCALE 60' to 1"

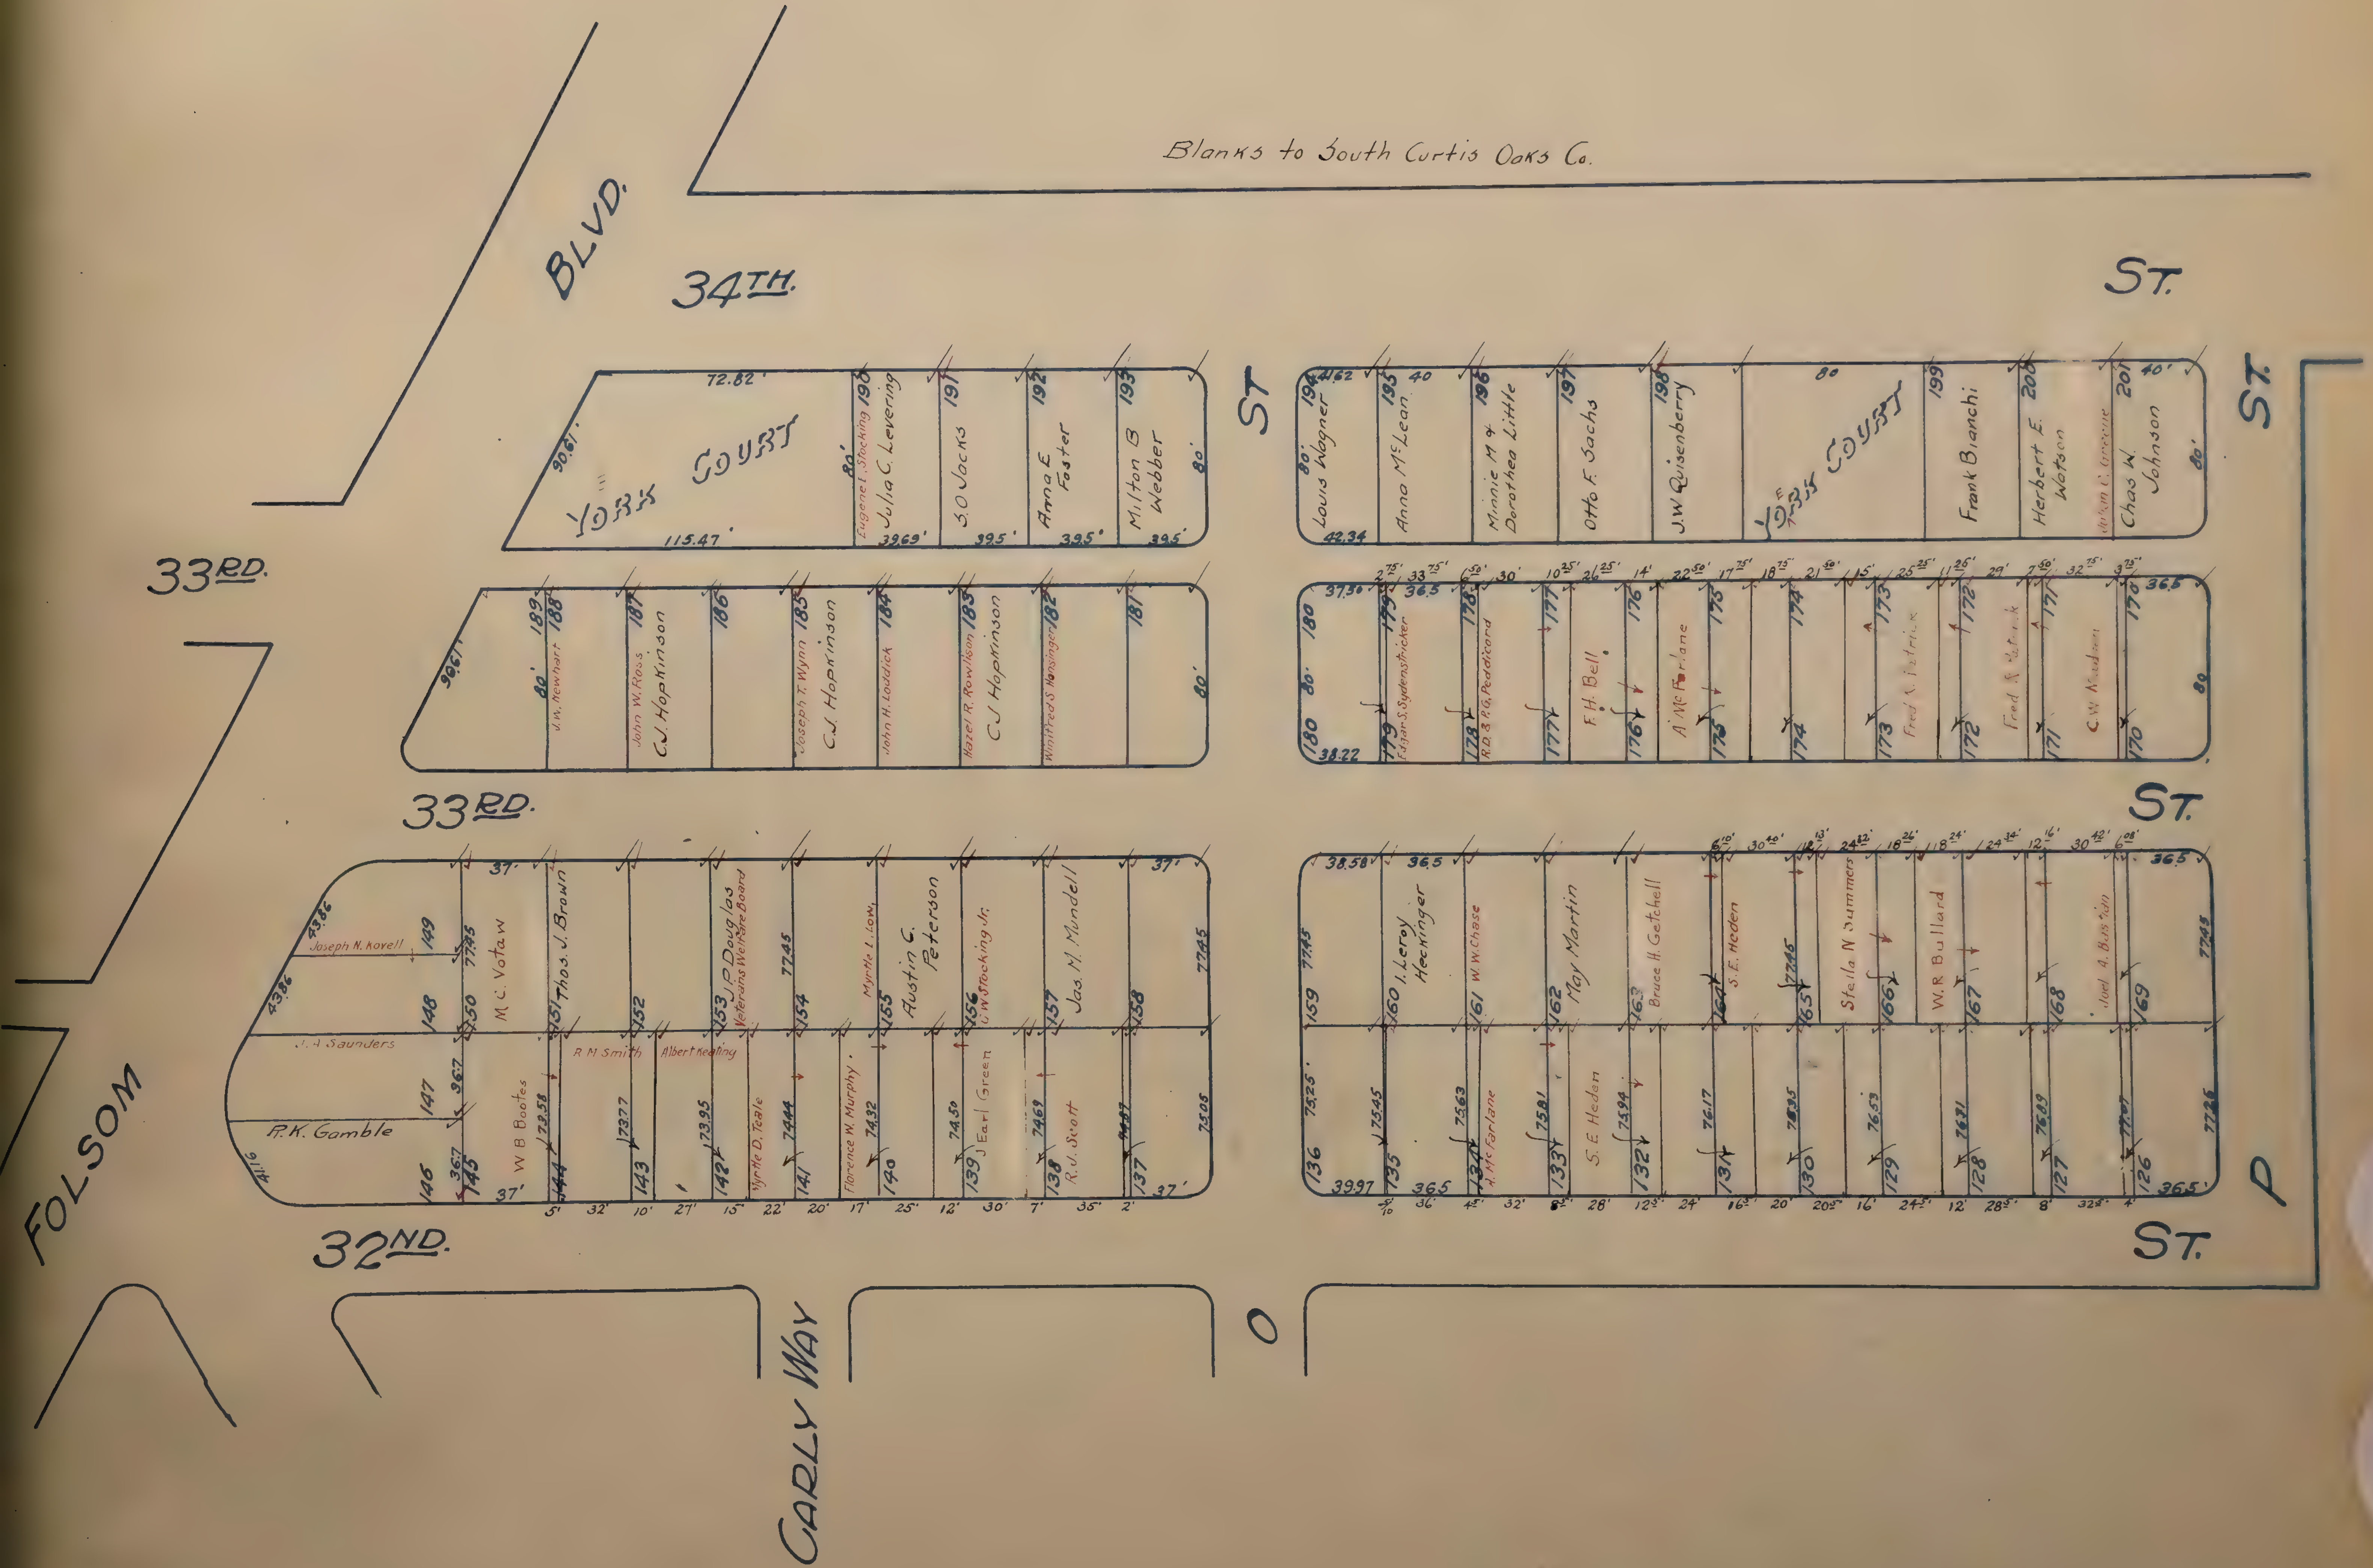
Blanks to South Curtis Oaks Co.
BLVD.
34TH.
ST.
33RD.
33RD.
ST.
ST
ST.
32ND.
ST.
FOLSOM
CARLY WAY
O
P
YORK COURT
72.82'
90.61'
115.47'
80'
190 Eugene I. Stocking
Julia C. Levering
39.69'
191 S.O. Jacks
39.5'
192 Anna E Foster
39.5'
193 Milton B Webber
39.5'
80'
189
188 J.W. Newhart
187 John W. Ross
C.J. Hopkinson
186
185 Joseph T. Wynn
C.J. Hopkinson
184 John H. Loddick
183 Hazel R. Rowlison
C J Hopkinson
182 Winifred S Hansinger
181
90.61'
80'
194 Louis Wagner
42.62
42.34
80'
195 Anna McLean
40
196 Minnie M & Dorothea Little
197 Otto F Sachs
198 J.W. Quisenberry
80
YORK COURT
199 Frank Bianchi
200 Herbert E. Watson
201 Chas W. Johnson
40'
80'
180
180
37.30
38.22
80'
179 Edgar S. Sydenstricker
36.5
178 R.D. & P.G. Peddicord
177
F.H. Bell
176
A. McFarlane
175
174
173 Fred R. Patrick
172 Fred R. Patrick
171 C.W. Madsen
170
36.5
80
149 Joseph N. Kovell
148
147 J.A. Saunders
146 R.K. Gamble
43.86
43.86
41.16
37'
150 M.C. Votaw
77.45
36.7
145 W B Bootes
151 Thos. J. Brown
144 R M Smith
73.58
152
143 Albert Keating
73.77
153 J.P. Douglas Veterans Welfare Board
142
73.95
Myrtle D. Teale
154
141
74.44
77.45
155 Myrtle L. Low
Austin C. Peterson
140 Florence W. Murphy
74.32
156 C.W. Stocking Jr.
139 J Earl Green
74.50
157 Jas. M. Mundell
138 R.J. Scott
74.69
158
137
37'
77.45
75.05
5' 32' 10' 27' 15' 22' 20' 17' 25' 12' 30' 7' 35' 2'
159
136
38.58
77.45
75.25
39.97
160 I. Leroy Heckinger
135
75.45
36.5
161 W.W. Chase
134 A. McFarlane
75.63
162 May Martin
133 S.E. Heden
75.81
163 Bruce H. Getchell
132
75.94
164 S.E. Heden
131
76.17
165
130
77.45
76.35
166 Stella N Summers
129
76.53
167 W.R. Bullard
128
76.71
168
127
76.89
169 Joel A. Bastian
126
77.26
36.5
36.5
5/10 36' 4.5' 32' 8.5' 28' 12.5' 24' 16.5' 20' 20.5' 16' 24.5' 12' 28.5' 8' 32.5' 4'

CENTRAL ADDITION
TO
EAST SACRAMENTO

Scale: 1 Inch = 80 feet.

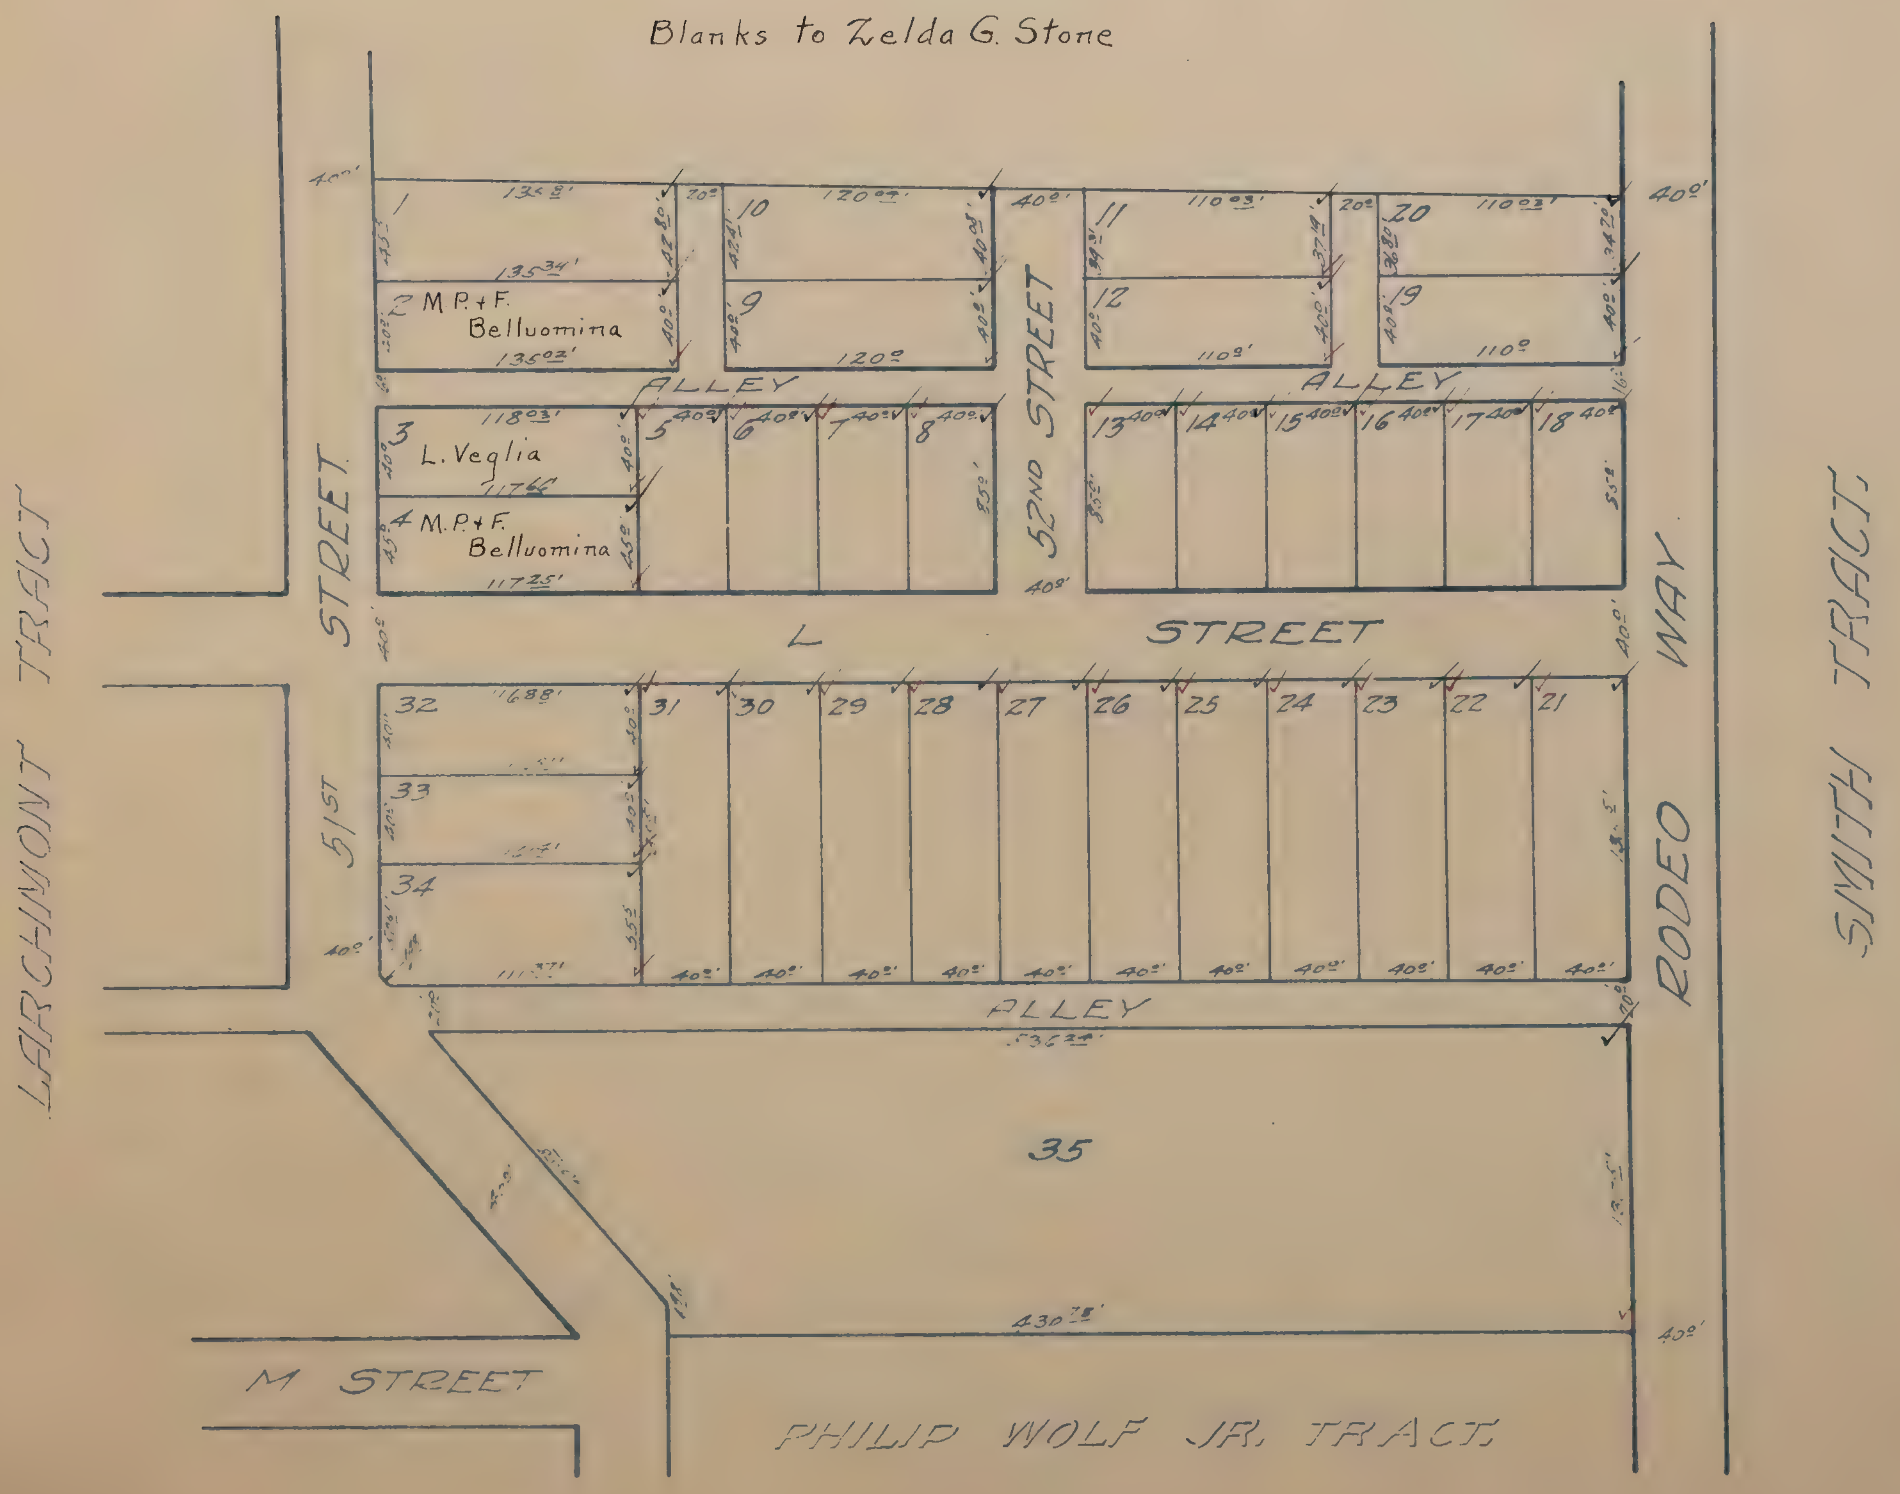

Blanks to Zelda G. Stone

LARCHMONT TRACT
51ST STREET
52ND STREET
RODEO WAY
SMITH TRACT
L STREET
M STREET
ALLEY
ALLEY
ALLEY
PHILIP WOLF JR. TRACT
1
2 M.P. + F. Belluomina
3 L. Veglia
4 M.P. + F. Belluomina
5
6
7
8
9
10
11
12
13
14
15
16
17
18
19
20
21
22
23
24
25
26
27
28
29
30
31
32
33
34
35
135 58'
135 34'
135 02'
118 03'
117 66
117 25'
120 04'
120 0
110 03'
110 0
168 88'
430 78'
40 0'

Central

CITY ACRES ✓

Blanks to W E. Trainor

Scale: 1 Inch = 100 feet.

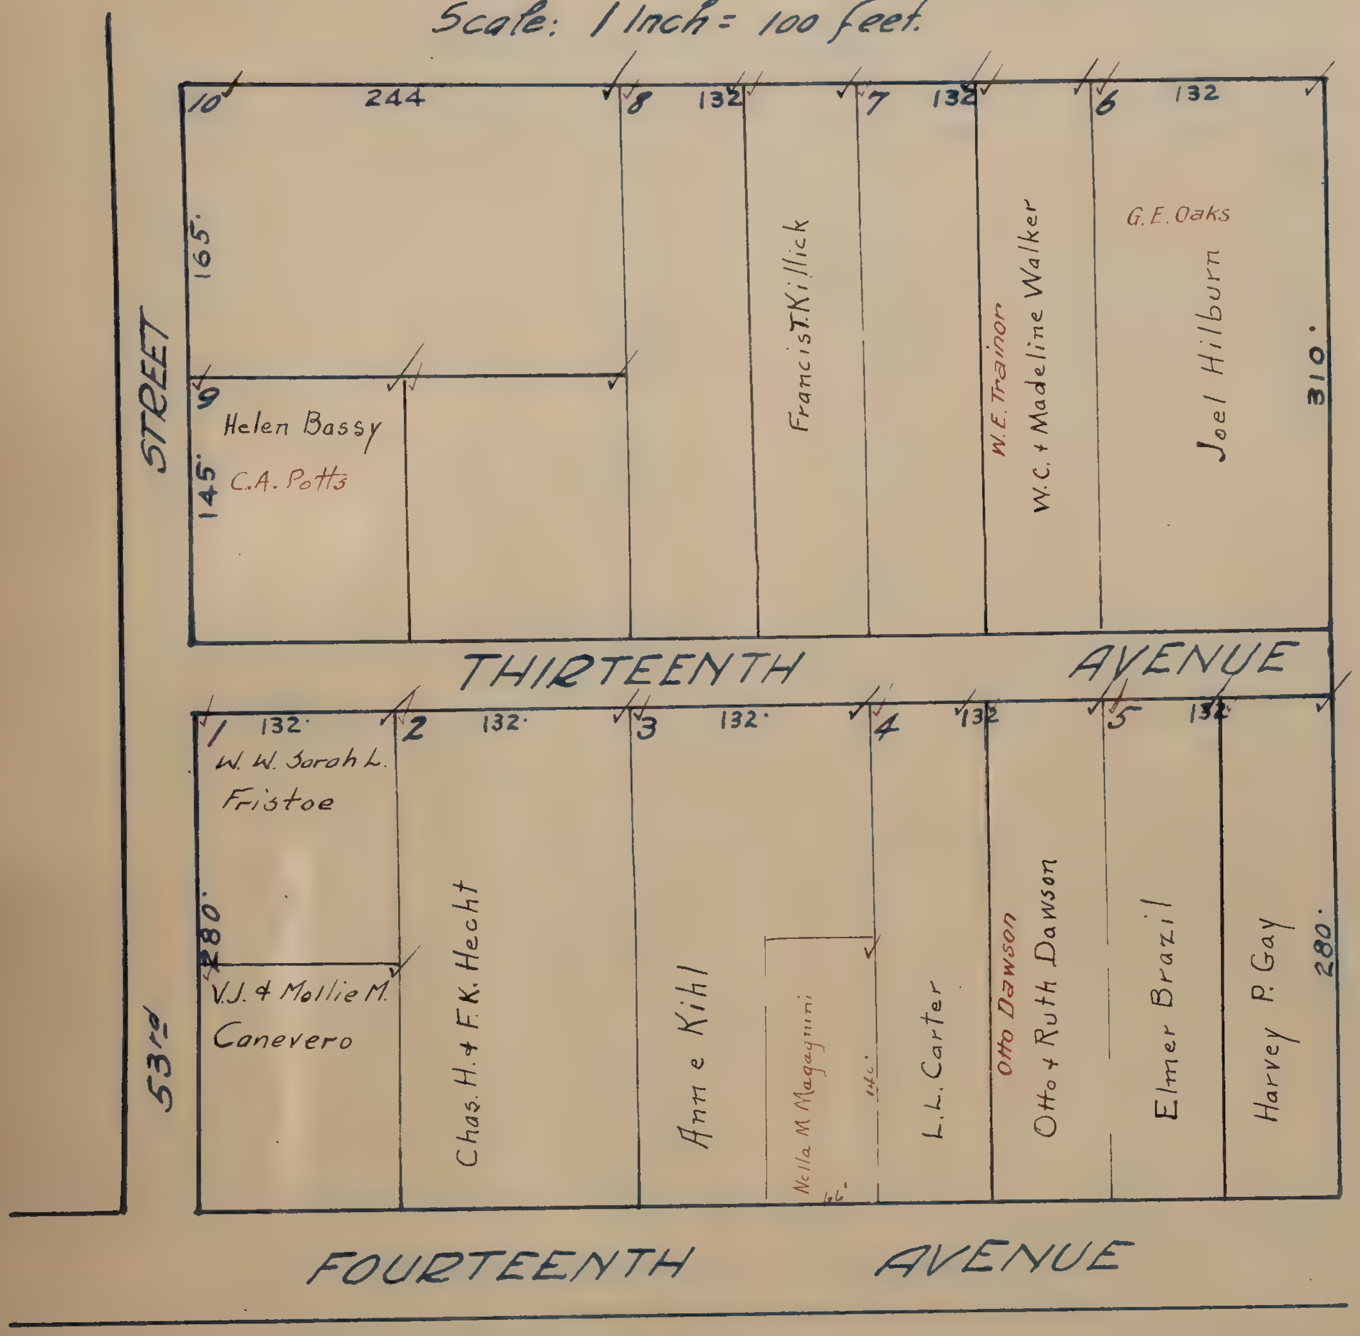
10
244
8
132
7
132
6
132
165'
9
Helen Bassy
C.A. Potts
145'
Francis T. Killick
W. E. Trainor
W. C. + Madeline Walker
G. E. Oaks
Joel Hilburn
310'
STREET
53rd
THIRTEENTH AVENUE
1
132'
2
132'
3
132'
4
132
5
132
W. W. Sarah L. Fristoe
280'
V. J. + Mollie M. Canevero
Chas. H. + F. K. Hecht
Anne Kihl
Nella M. Magagnini
66'
L. L. Carter
Otto Dawson
Otto + Ruth Dawson
Elmer Brazil
Harvey P. Gay
280'
FOURTEENTH AVENUE

CLAREMONT ✓

Scale: 1 inch = 80 feet

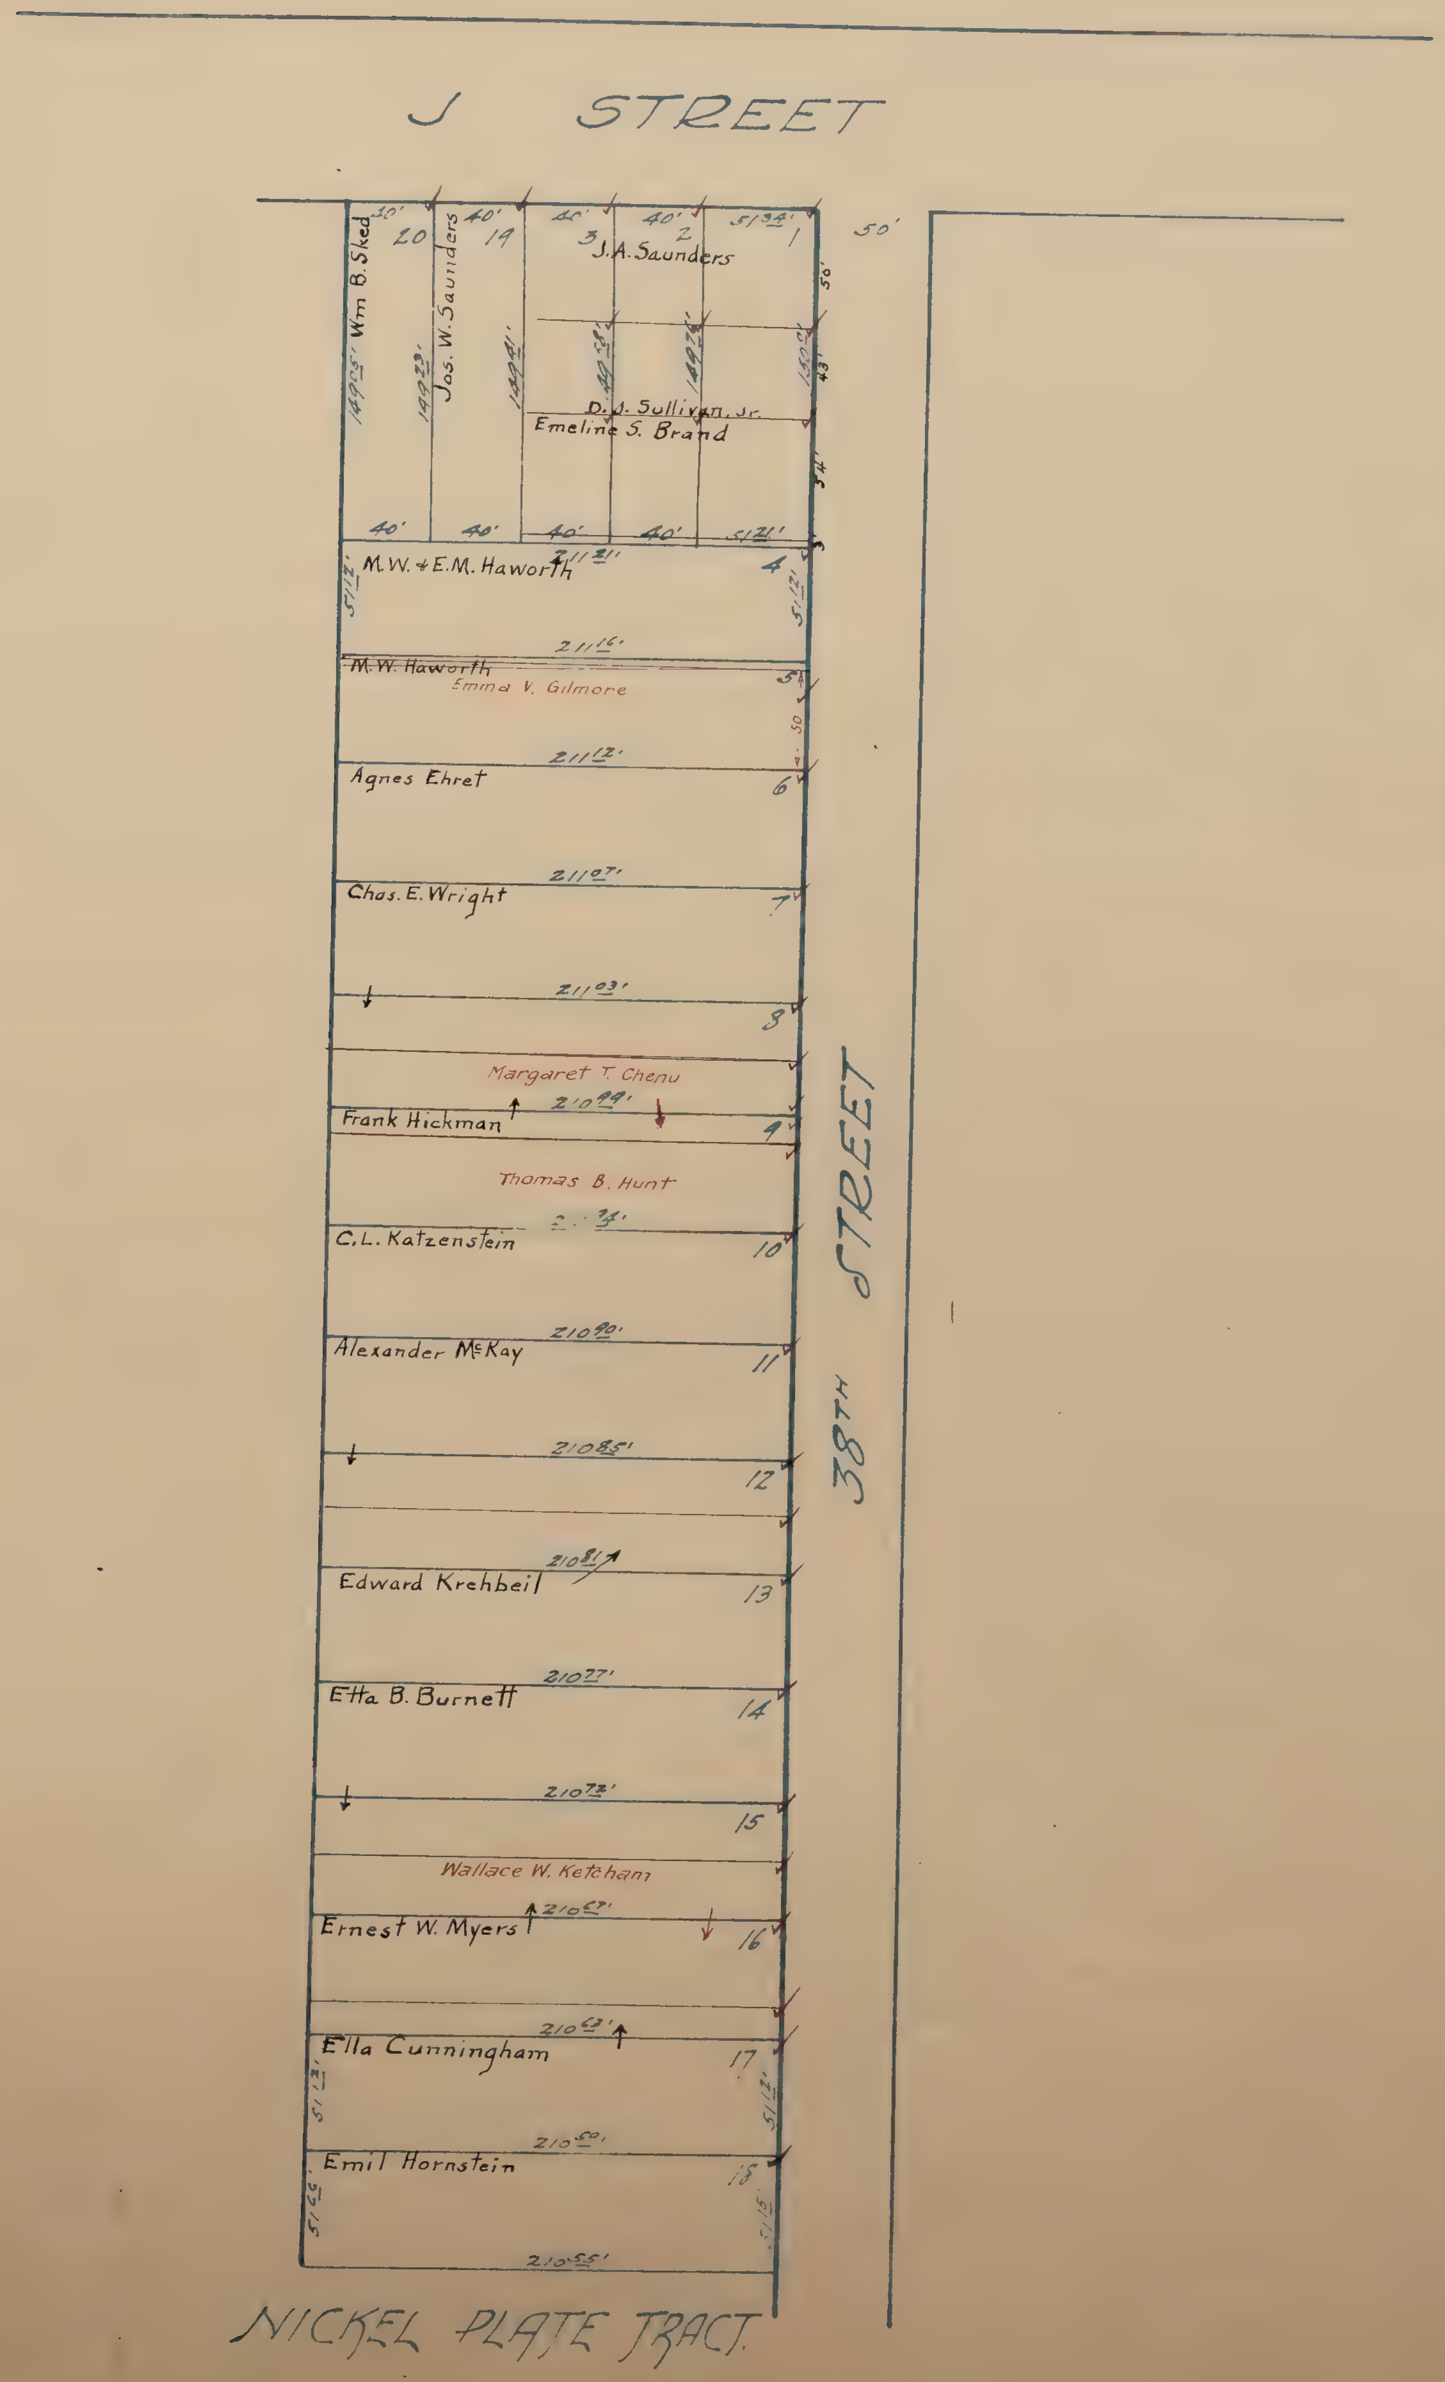
J STREET
38TH STREET
NICKEL PLATE TRACT.
50'
40'
20
19
3
2
1
51^{34}'
Wm B. Sked
149^{05}'
Jos. W. Saunders
149^{23}'
149^{41}'
J.A. Saunders
149^{58}'
149^{76}'
150^{0}'
50'
43'
34'
D. J. Sullivan, Jr.
Emeline S. Brand
40'
40'
40'
40'
51^{21}'
M.W. & E.M. Haworth
211^{31}'
51^{12}'
51^{12}'
4
211^{16}'
~~M.W. Haworth~~
Emma V. Gilmore
5
50
211^{12}'
Agnes Ehret
6
211^{07}'
Chas. E. Wright
7
211^{03}'
8
Margaret T. Chenu
210^{99}'
Frank Hickman
9
Thomas B. Hunt
$2..^{94}$'
C.L. Katzenstein
10
210^{90}'
Alexander McKay
11
210^{85}'
12
210^{81}'
Edward Krehbeil
13
210^{77}'
Etta B. Burnett
14
210^{73}'
15
Wallace W. Ketcham
210^{67}'
Ernest W. Myers
16
210^{63}'
Ella Cunningham
17
51^{13}'
51^{12}'
210^{50}'
Emil Hornstein
18
51^{66}'
51^{15}'
210^{55}'

N. CLARK TRACT ✓

Scale: 1 Inch = 80 feet.

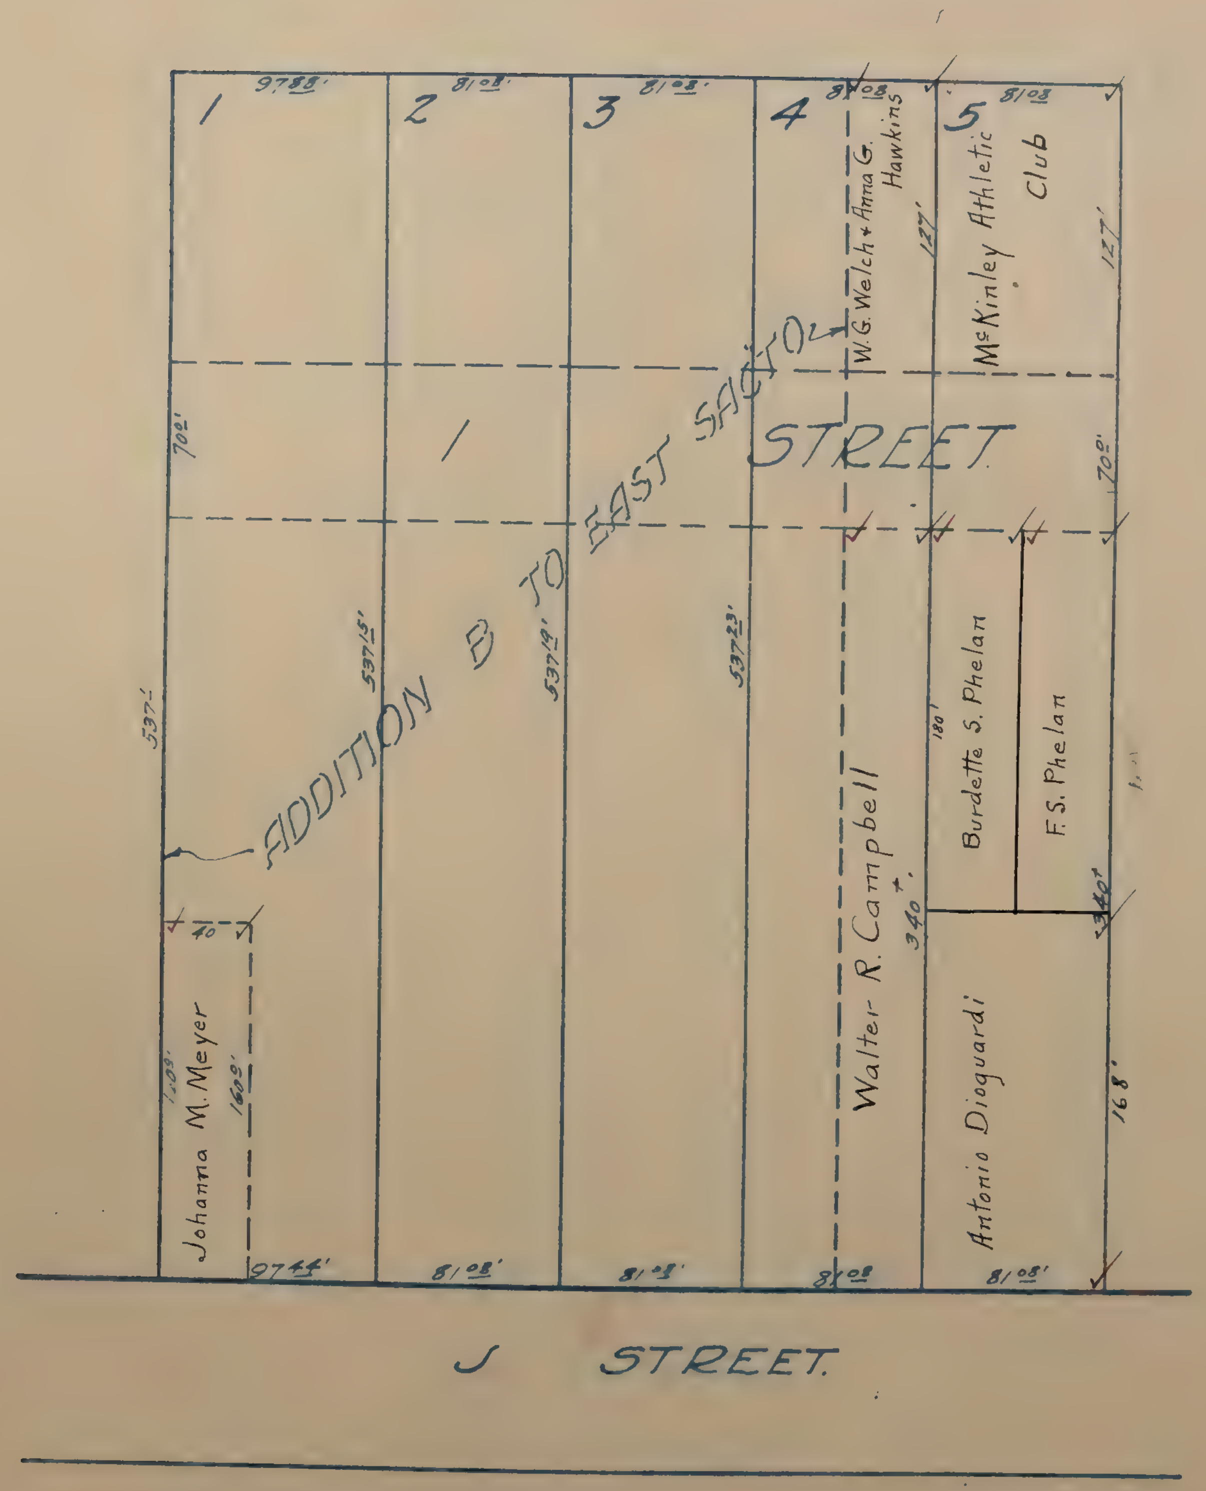
1
2
3
4
5
9788'
8108'
8108'
8108'
8108'
W. G. Welch + Anna G. Hawkins
McKinley Athletic Club
127'
127'
70'
70'
STREET
ADDITION B TO EAST SACTO.
537'
53715'
53719'
53723'
Walter R. Campbell
340'
180'
Burdette S. Phelan
F. S. Phelan
340'
40
Johanna M. Meyer
109'
169'
Antonio Dioguardi
168'
9744'
8108'
8108'
8108'
8108'
J STREET.

CLOVERKNOLL ✓✓

Scale: 1 Inch = 40 feet.

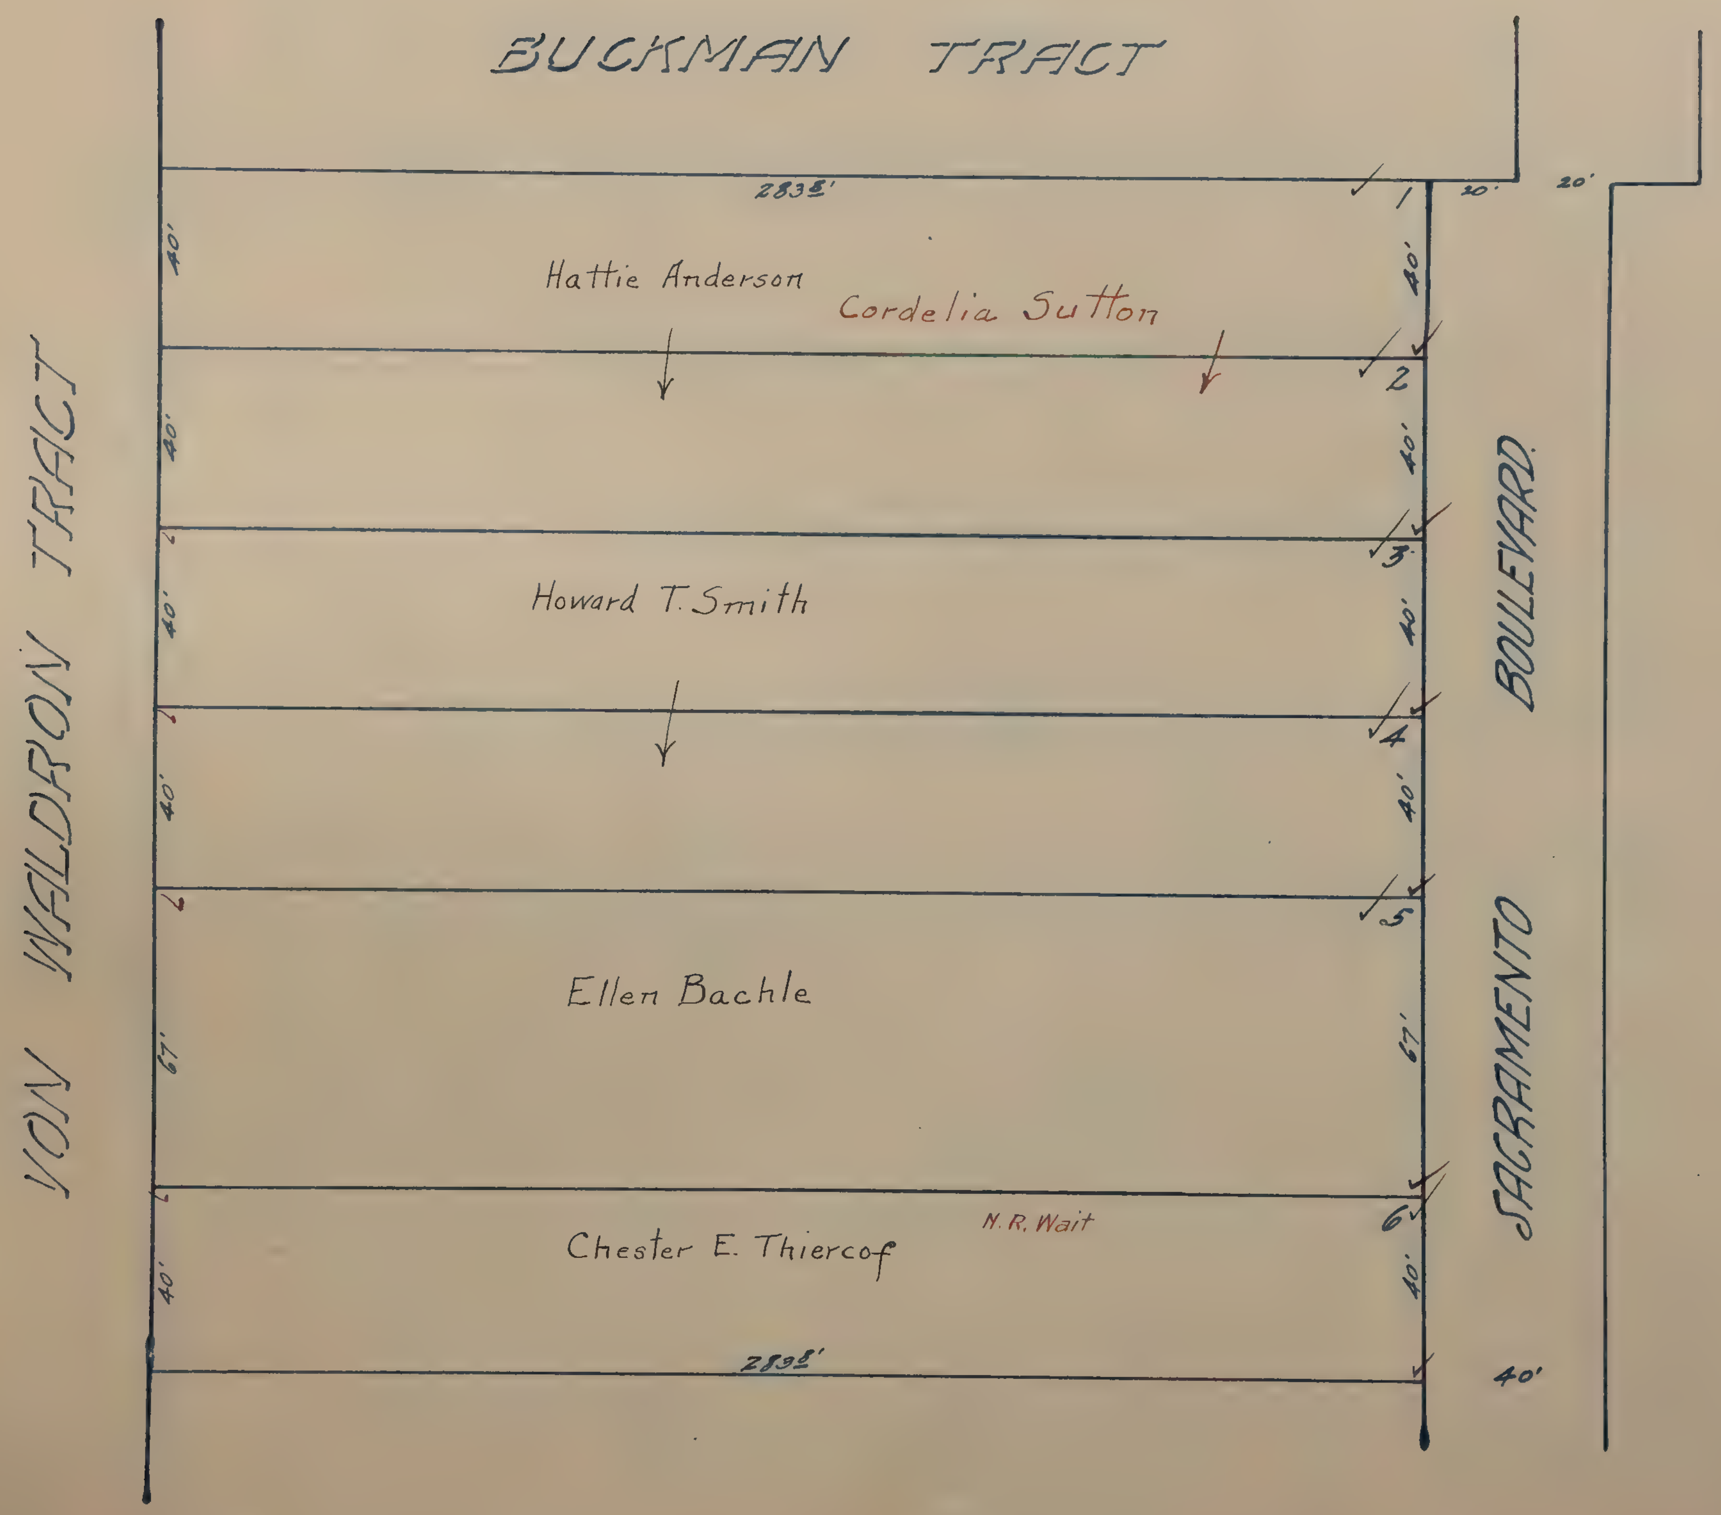
BUCKMAN TRACT
283⅚'
20'
20'
1
40'
40'
Hattie Anderson
Cordelia Sutton
2
40'
40'
3
Howard T. Smith
40'
40'
4
40'
40'
5
Ellen Bachle
67'
67'
6
Chester E. Thiercof
N. R. Wait
40'
40'
289⅚'
40'
VON WALDRON TRACT
SACRAMENTO BOULEVARD

COLLEGE TERRACE

Sacramento City, California

Scale 1″ = 80′

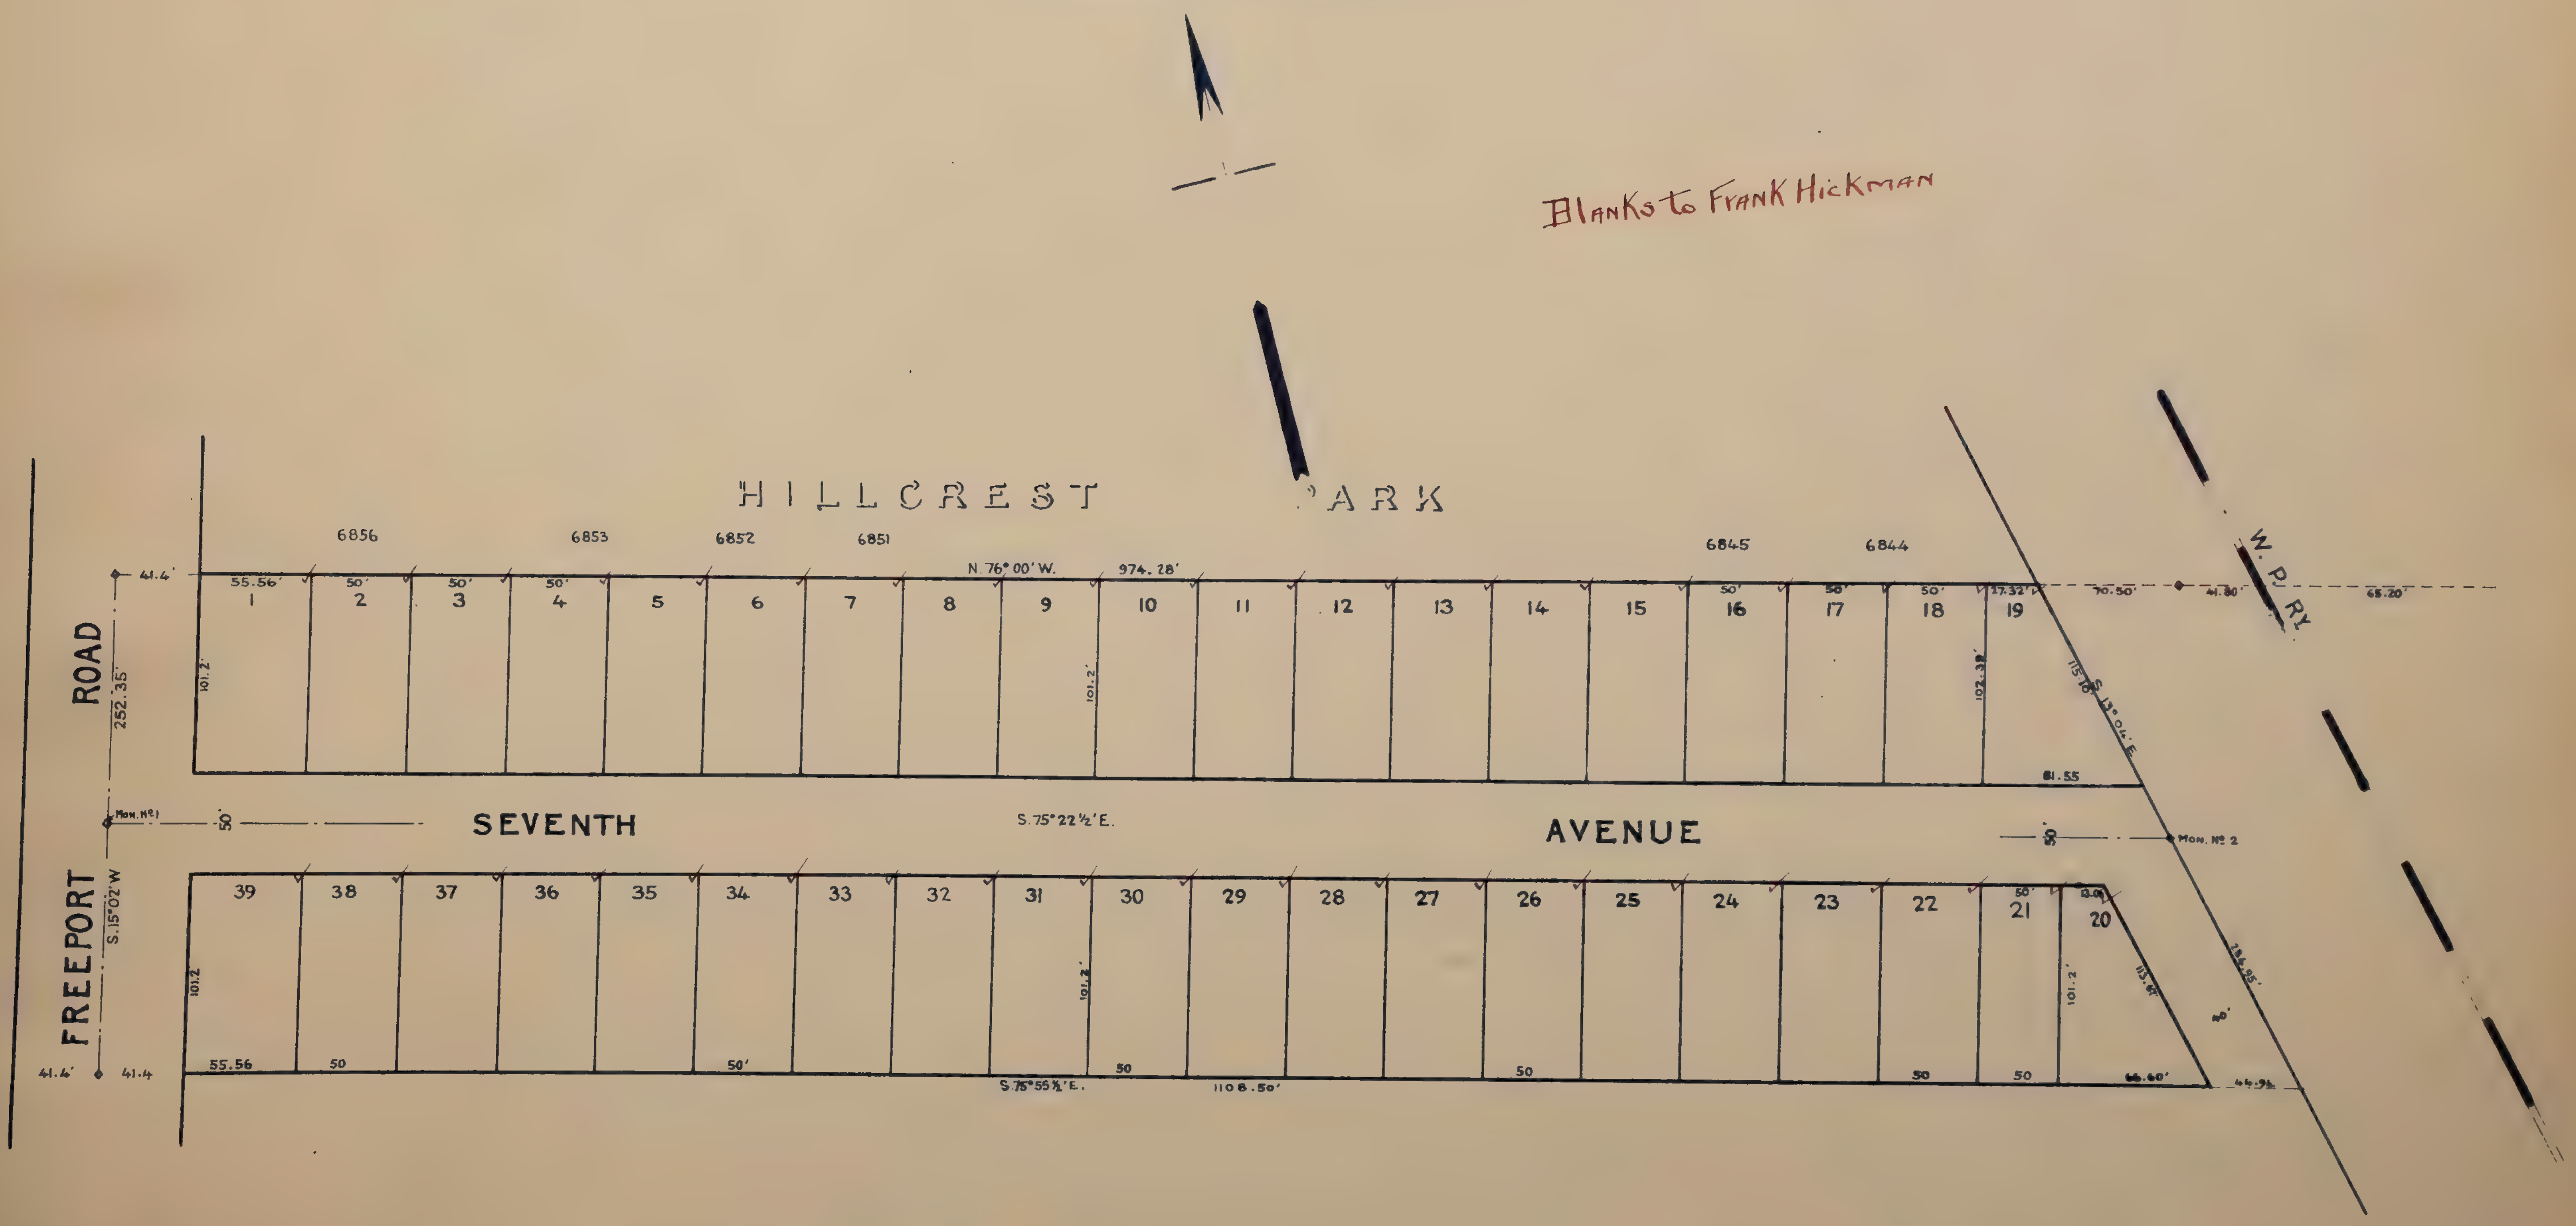
HILLCREST PARK
6856
6853
6852
6851
6845
6844
N. 76° 00′ W.
974.28′
55.56′
50′
1
2
3
4
5
6
7
8
9
10
11
12
13
14
15
16
17
18
19
27.32′
70.50′
41.80′
65.20′
W. P. RY.
102.38′
115.18′
S. 13° 04′ E.
81.55
101.2
101.2′
ROAD
252.35′
41.4′
Mon. Nº 1
50
SEVENTH
S. 75° 22½′ E.
AVENUE
Mon. Nº 2
FREEPORT
S. 15° 02′ W
39
38
37
36
35
34
33
32
31
30
29
28
27
26
25
24
23
22
21
20
113.61
288.95′
40′
55.56
50
50′
S. 75° 55½′ E.
1108.50′
66.60′
44.94
41.4′
41.4

Blanks to Frank Hickman

COLOMA HEIGHTS

Scale: 1 Inch = 80 feet.

NOTE: Comprises Lots 13, 14, 18 & 19 of the Louisiana Tract

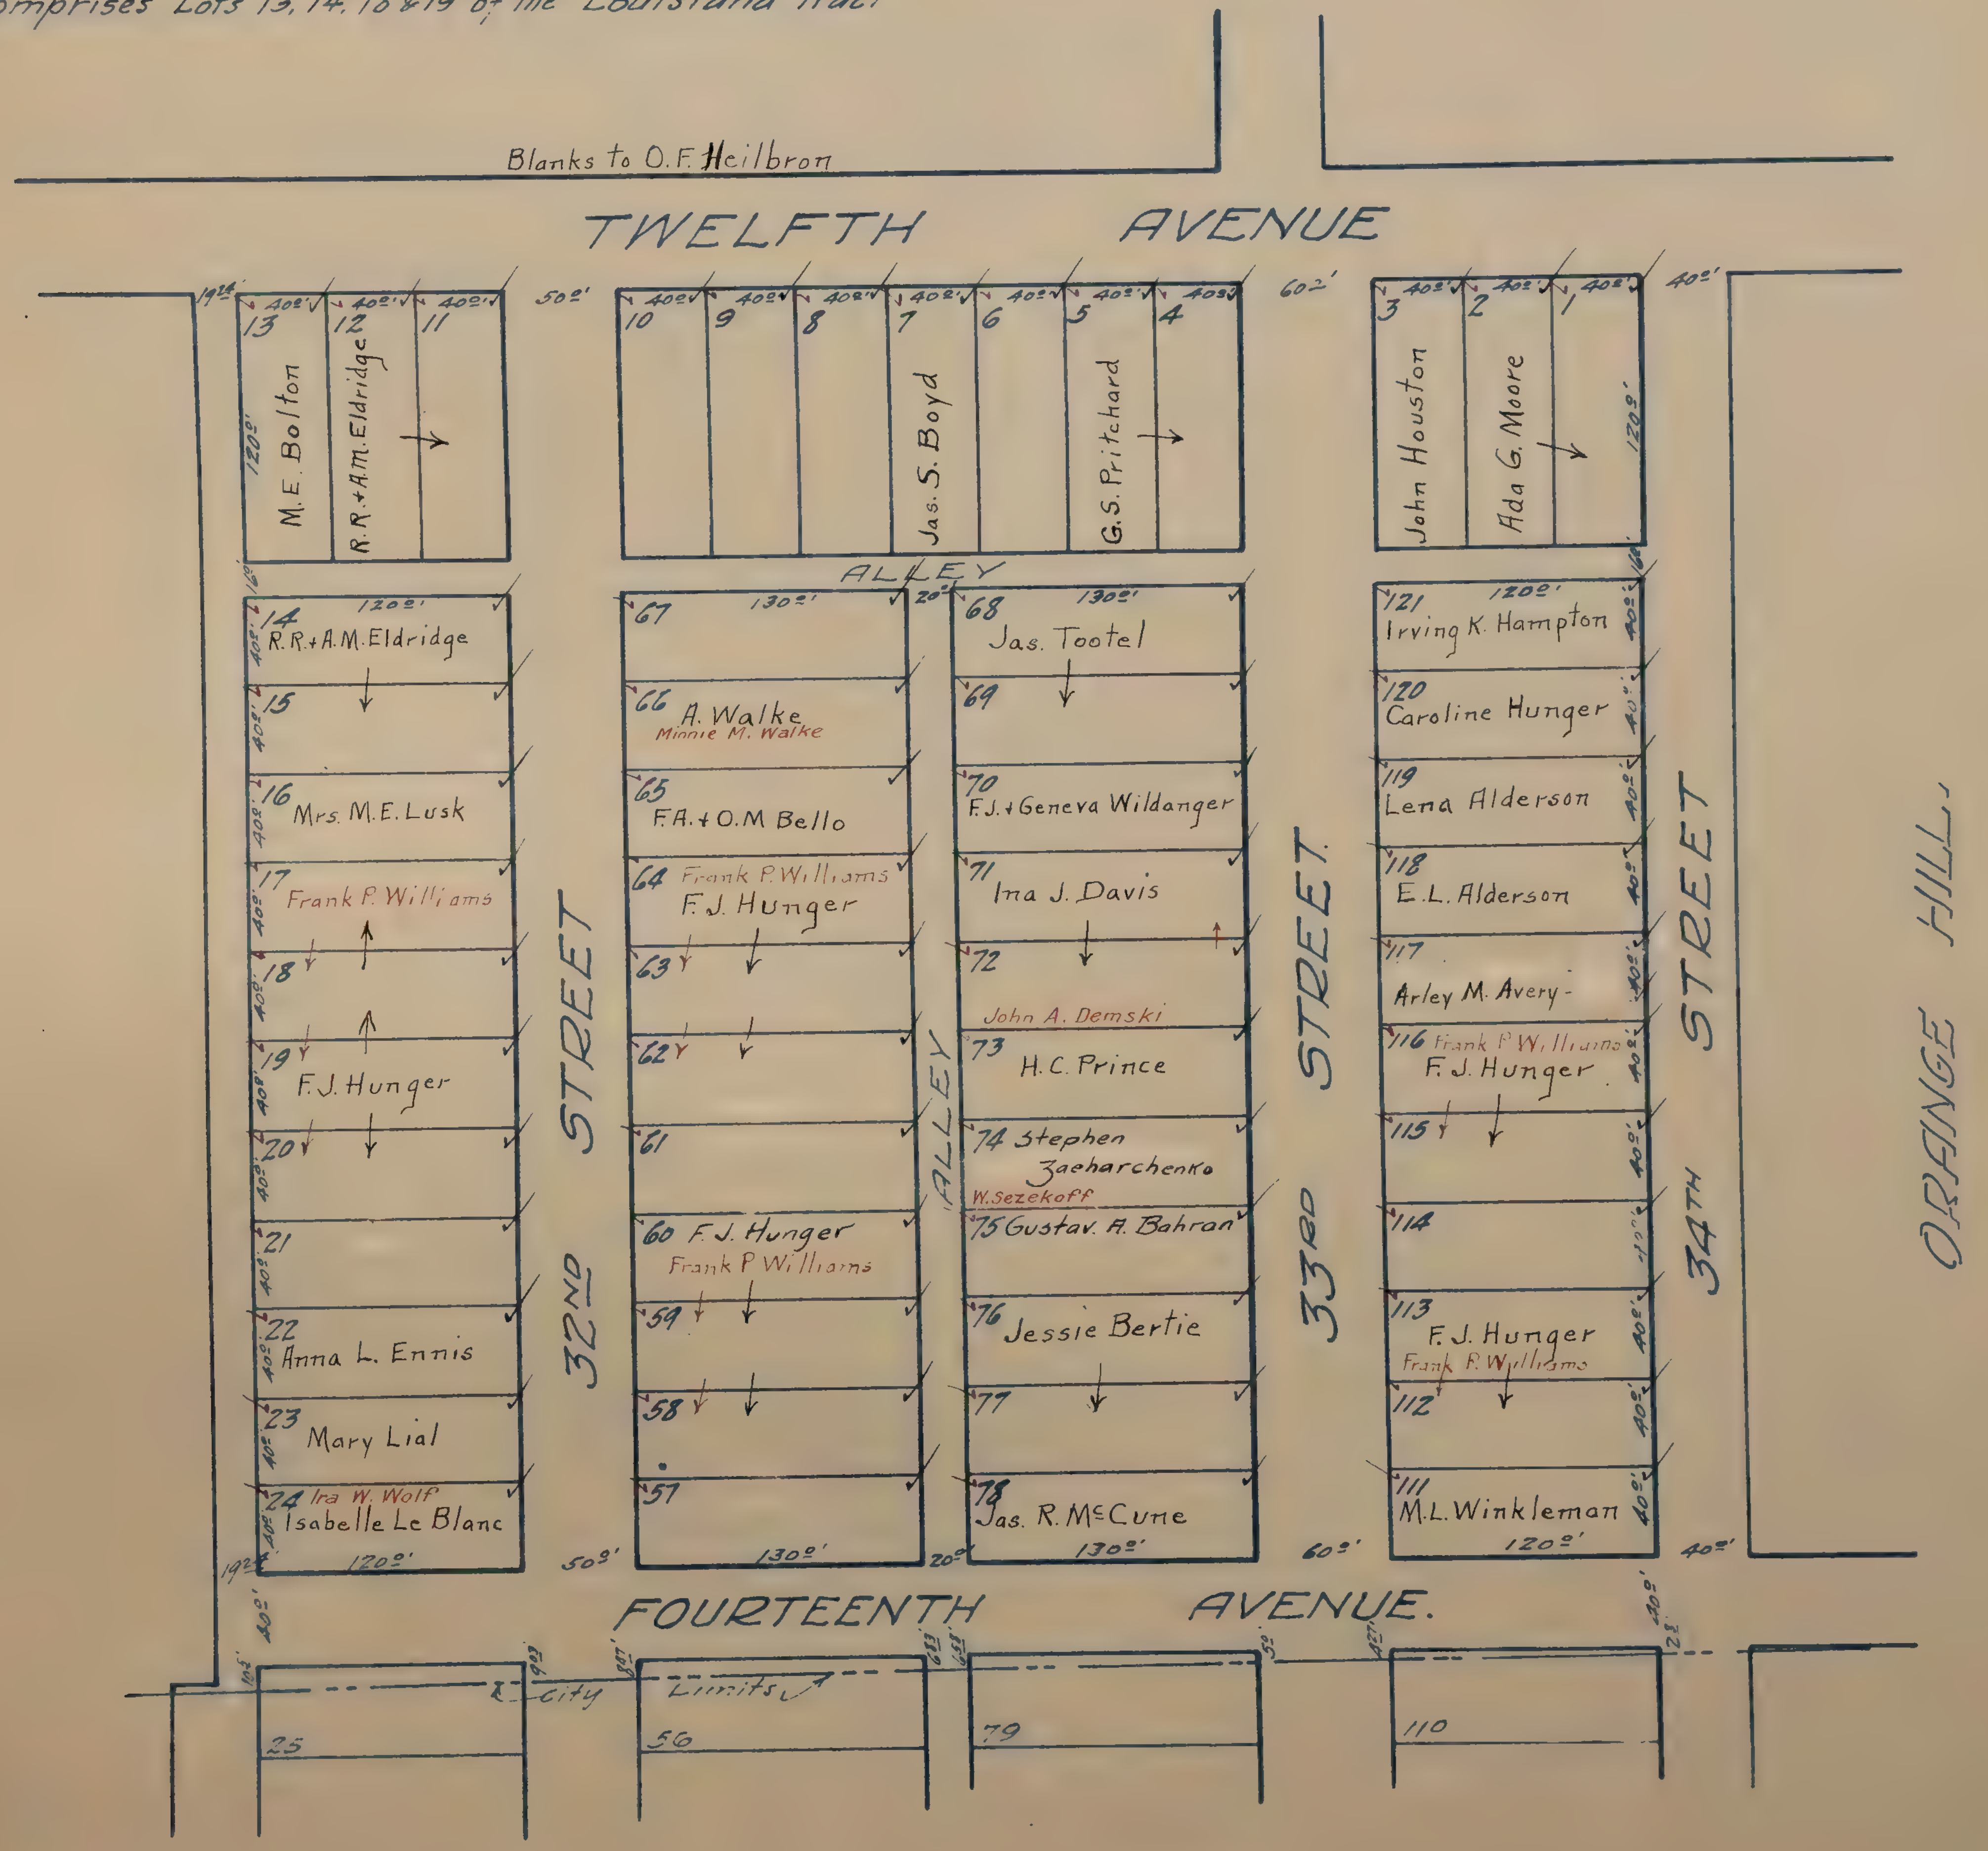
Blanks to O.F. Heilbron
TWELFTH AVENUE
FOURTEENTH AVENUE.
32ND STREET
33RD STREET
34TH STREET
ORANGE HILL
ALLEY
ALLEY
City Limits
13 M.E. Bolton
12 R.R. + A.M. Eldridge
11
10
9
8
7 Jas. S. Boyd
6
5 G.S. Pritchard
4
3 John Houston
2 Ada G. Moore
1
14 R.R. + A.M. Eldridge
15
16 Mrs. M.E. Lusk
17 Frank P. Williams
18
19 F.J. Hunger
20
21
22 Anna L. Ennis
23 Mary Lial
24 Ira W. Wolf
Isabelle Le Blanc
67
66 A. Walke
Minnie M. Walke
65 F.A. + O.M Bello
64 Frank P. Williams
F.J. Hunger
63
62
61
60 F.J. Hunger
Frank P Williams
59
58
57
68 Jas. Tootel
69
70 F.J. + Geneva Wildanger
71 Ina J. Davis
72
John A. Demski
73 H.C. Prince
74 Stephen Zaeharchenko
W. Sezekoff
75 Gustav. A. Bahran
76 Jessie Bertie
77
78 Jas. R. McCune
121 Irving K. Hampton
120 Caroline Hunger
119 Lena Alderson
118 E.L. Alderson
117 Arley M. Avery
116 Frank P Williams
F.J. Hunger
115
114
113 F.J. Hunger
Frank P. Williams
112
111 M.L. Winkleman
25
56
79
110
40.0'
120.0'
130.0'
50.0'
60.0'
20.0'
16.0'
19.2'

COLUMBIA TERRACE.

Scale: 1 Inch = 80 feet.

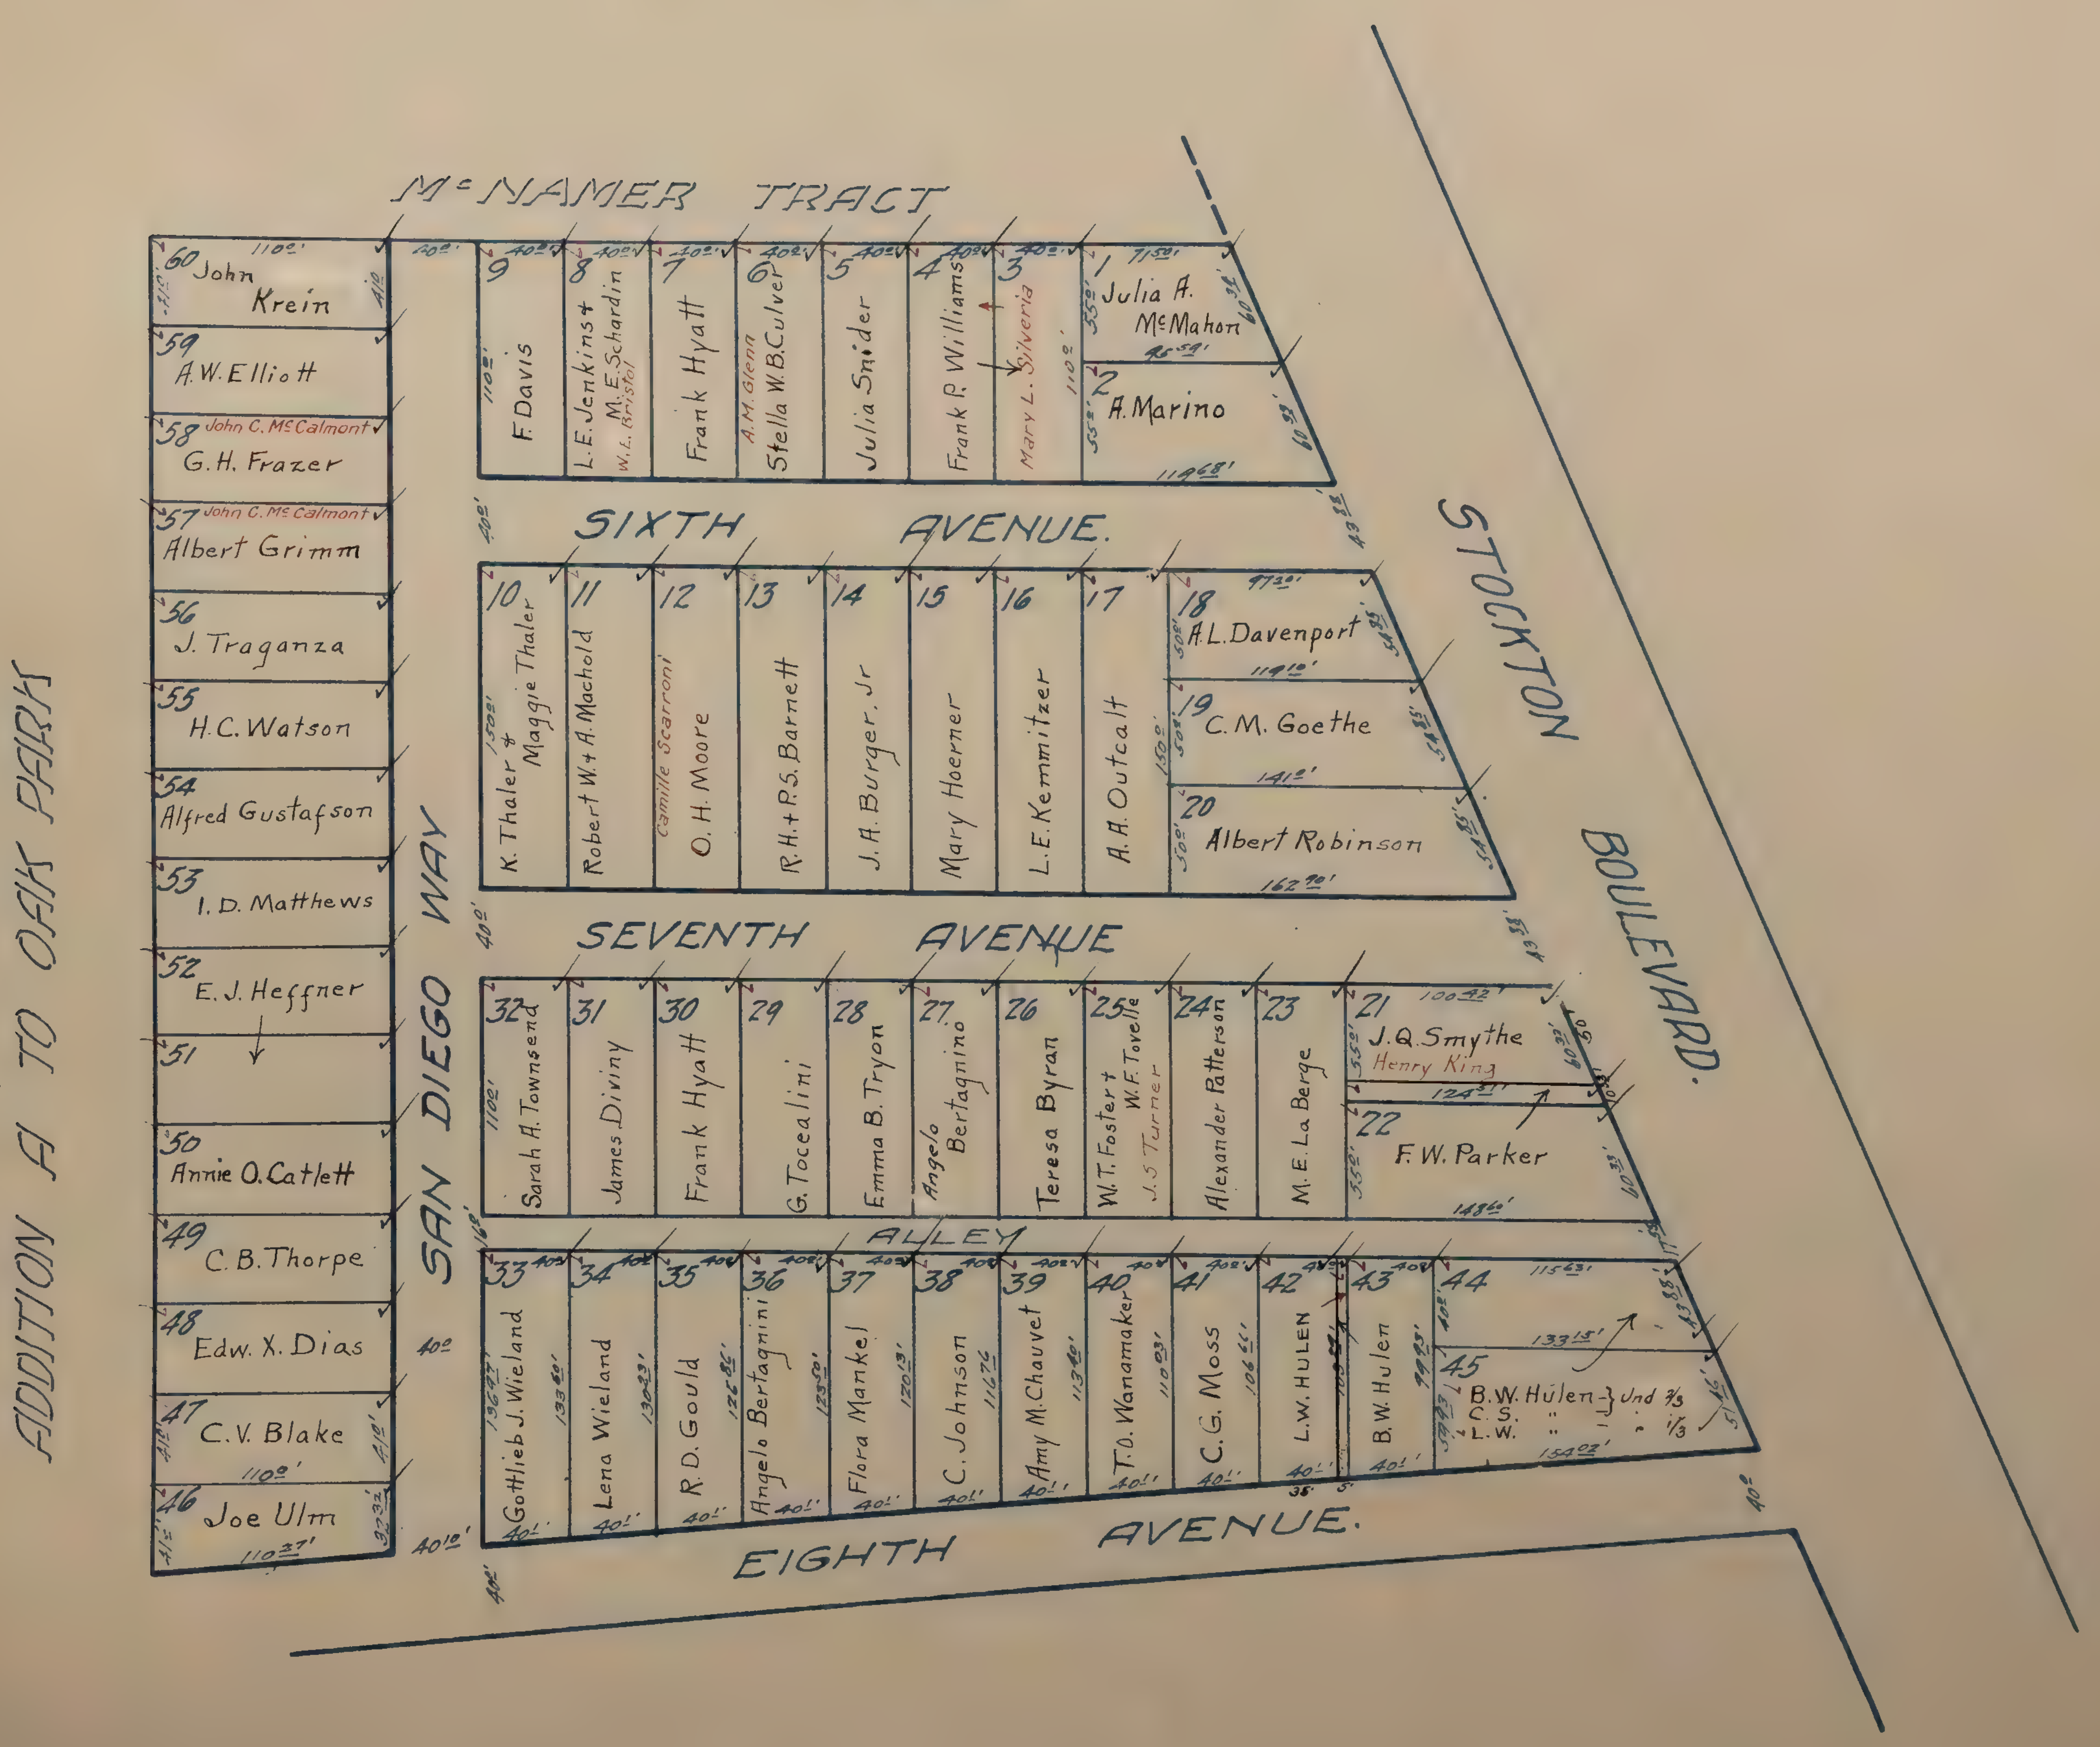
McNAMER TRACT
ADDITION A TO OAK PARK
SAN DIEGO WAY
SIXTH AVENUE.
SEVENTH AVENUE
EIGHTH AVENUE.
ALLEY
STOCKTON BOULEVARD.
60 John Krein
59 A.W. Elliott
58 John C. McCalmont G.H. Frazer
57 John C. McCalmont Albert Grimm
56 J. Traganza
55 H.C. Watson
54 Alfred Gustafson
53 I.D. Matthews
52 E.J. Heffner
51
50 Annie O. Catlett
49 C.B. Thorpe
48 Edw. X. Dias
47 C.V. Blake
46 Joe Ulm
9 F. Davis
8 L.E. Jenkins + M.E. Schardin W.L. Bristol
7 Frank Hyatt
6 A.M. Glenn Stella W.B. Culver
5 Julia Snider
4 Frank P. Williams
3 Mary L. Silveria
1 Julia A. McMahon
2 A. Marino
10 K. Thaler + Maggie Thaler
11 Robert W + A. Machold
12 Camille Scarroni O.H. Moore
13 R.H. + P.S. Barnett
14 J.A. Burger, Jr
15 Mary Hoerner
16 L.E. Kemmitzer
17 A.A. Outcalt
18 A.L. Davenport
19 C.M. Goethe
20 Albert Robinson
32 Sarah A. Townsend
31 James Diviny
30 Frank Hyatt
29 G. Tocealini
28 Emma B. Tryon
27 Angelo Bertagnino
26 Teresa Byran
25 W.T. Foster + W.F. Tovell J.S. Turner
24 Alexander Patterson
23 M.E. La Berge
21 J.Q. Smythe Henry King
22 F.W. Parker
33 Gottlieb J. Wieland
34 Lena Wieland
35 R.D. Gould
36 Angelo Bertagnini
37 Flora Mankel
38 C. Johnson
39 Amy M. Chauvet
40 T.O. Wanamaker
41 C.G. Moss
42 L.W. Hulen
43 B.W. Hulen
44
45 B.W. Hulen } Und 1/3 C.S. " 1/3 L.W. " 1/3

6

CONLEY TRACT ✓

Scale: 1 Inch = 80 ft.

NOTE: Comprises all of Lots 7 & 8 of the Altamont Tract.

Blanks to Chas + Annie Conley

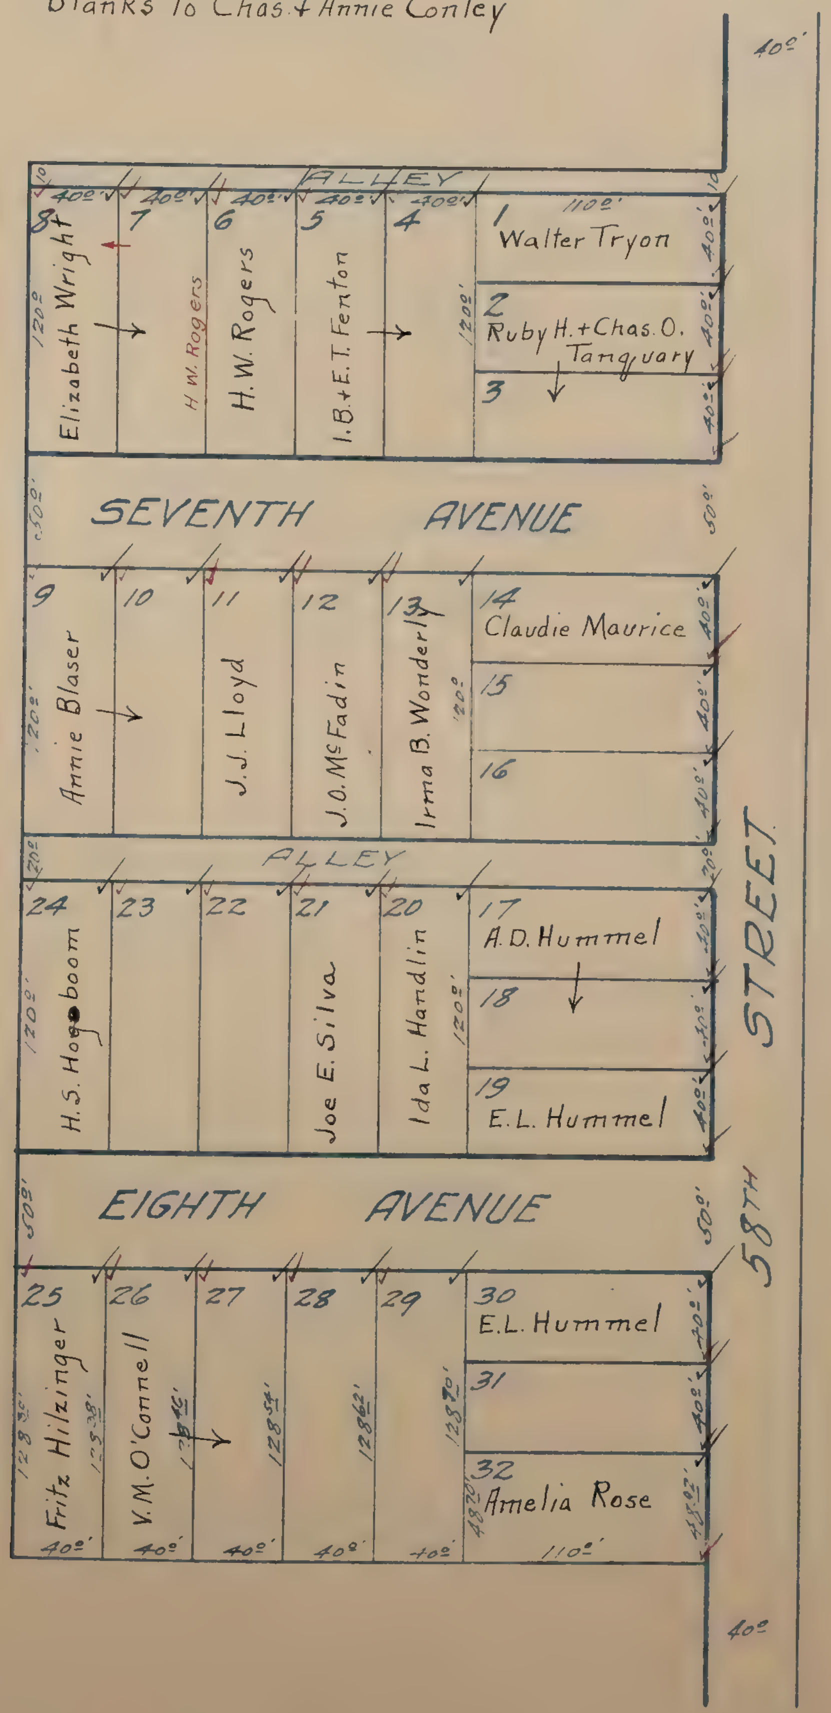

ALLEY
8 Elizabeth Wright
7
6 H.W. Rogers
H.W. Rogers
5 I.B. + E.T. Fenton
4
1 Walter Tryon
2 Ruby H. + Chas. O. Tanquary
3
SEVENTH AVENUE
9 Annie Blaser
10
11 J.J. Lloyd
12 J.O. McFadin
13 Irma B. Wonderly
14 Claudie Maurice
15
16
ALLEY
24 H.S. Hogeboom
23
22
21 Joe E. Silva
20 Ida L. Handlin
17 A.D. Hummel
18
19 E.L. Hummel
EIGHTH AVENUE
25 Fritz Hilzinger
26 V.M. O'Connell
27
28
29
30 E.L. Hummel
31
32 Amelia Rose
58TH STREET
40'
50'
120'
110'

Conley

4

COPE SUBDIVISION Nº 4. ✓

Scale: 1 Inch = 80 Feet.

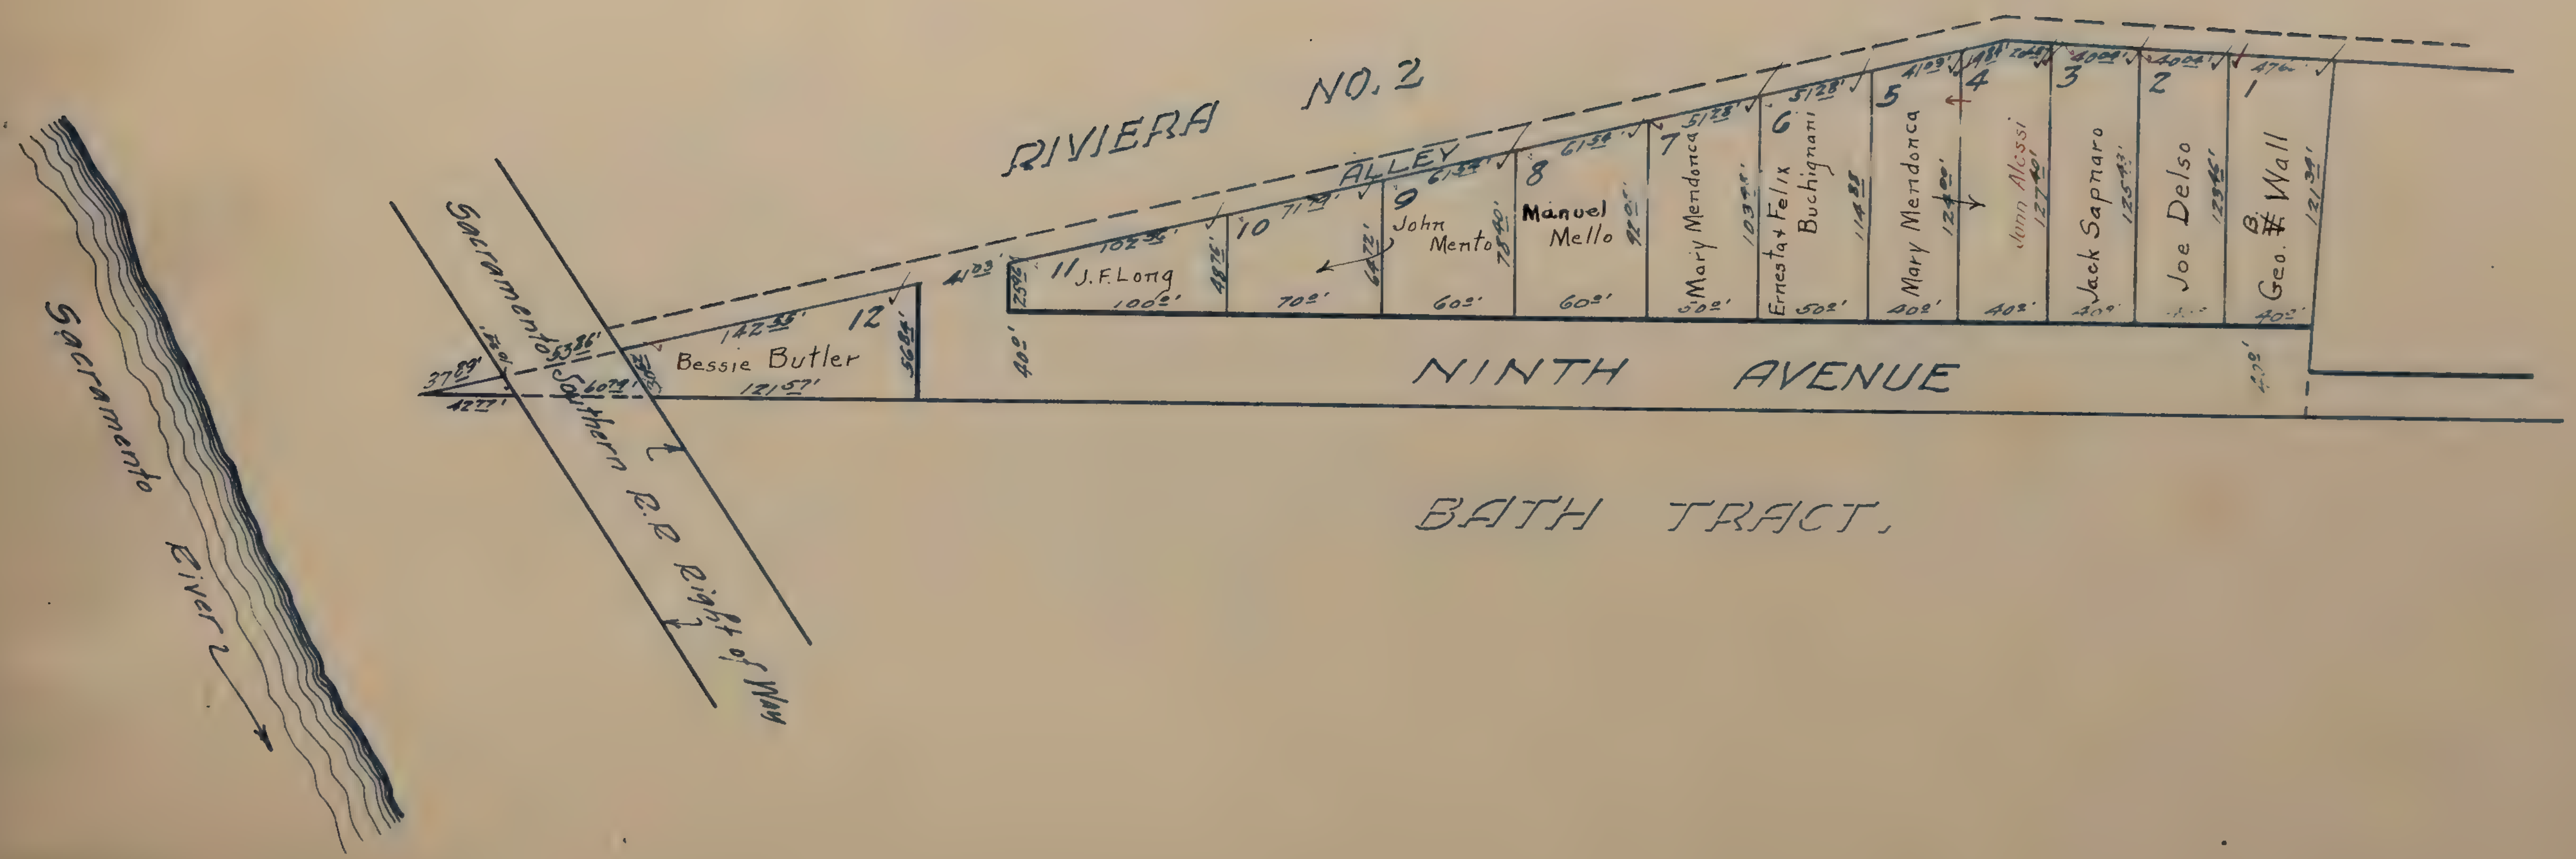
RIVIERA NO. 2
ALLEY
NINTH AVENUE
BATH TRACT.
Sacramento River
Sacramento Southern R.R. Right of Way
12
Bessie Butler
142 33'
121 57'
56 84'
53 86'
60 79'
37 89'
42 77'
41 03'
40'
11
J. F. Long
102 35'
100'
25 92'
48 76'
10
71 19'
70'
64 72'
9
John Mento
61 54'
60'
78 40'
8
Manuel Mello
61 54'
60'
90'
7
Mary Mendonca
51 28'
50'
103 78'
6
Ernest & Felix Buchignani
51 28'
50'
114 85'
5
Mary Mendonca
41 03'
40'
124 00'
4
John Alessi
127 01'
40'
3
Jack Sapnaro
40 00'
40'
125 43'
2
Joe Delso
40 00'
123 45'
1
B. Geo. # Wall
47'
40'
121 34'
40'

CRANDALL TRACT. ✓

Scale: 1 Inch = 40 feet.

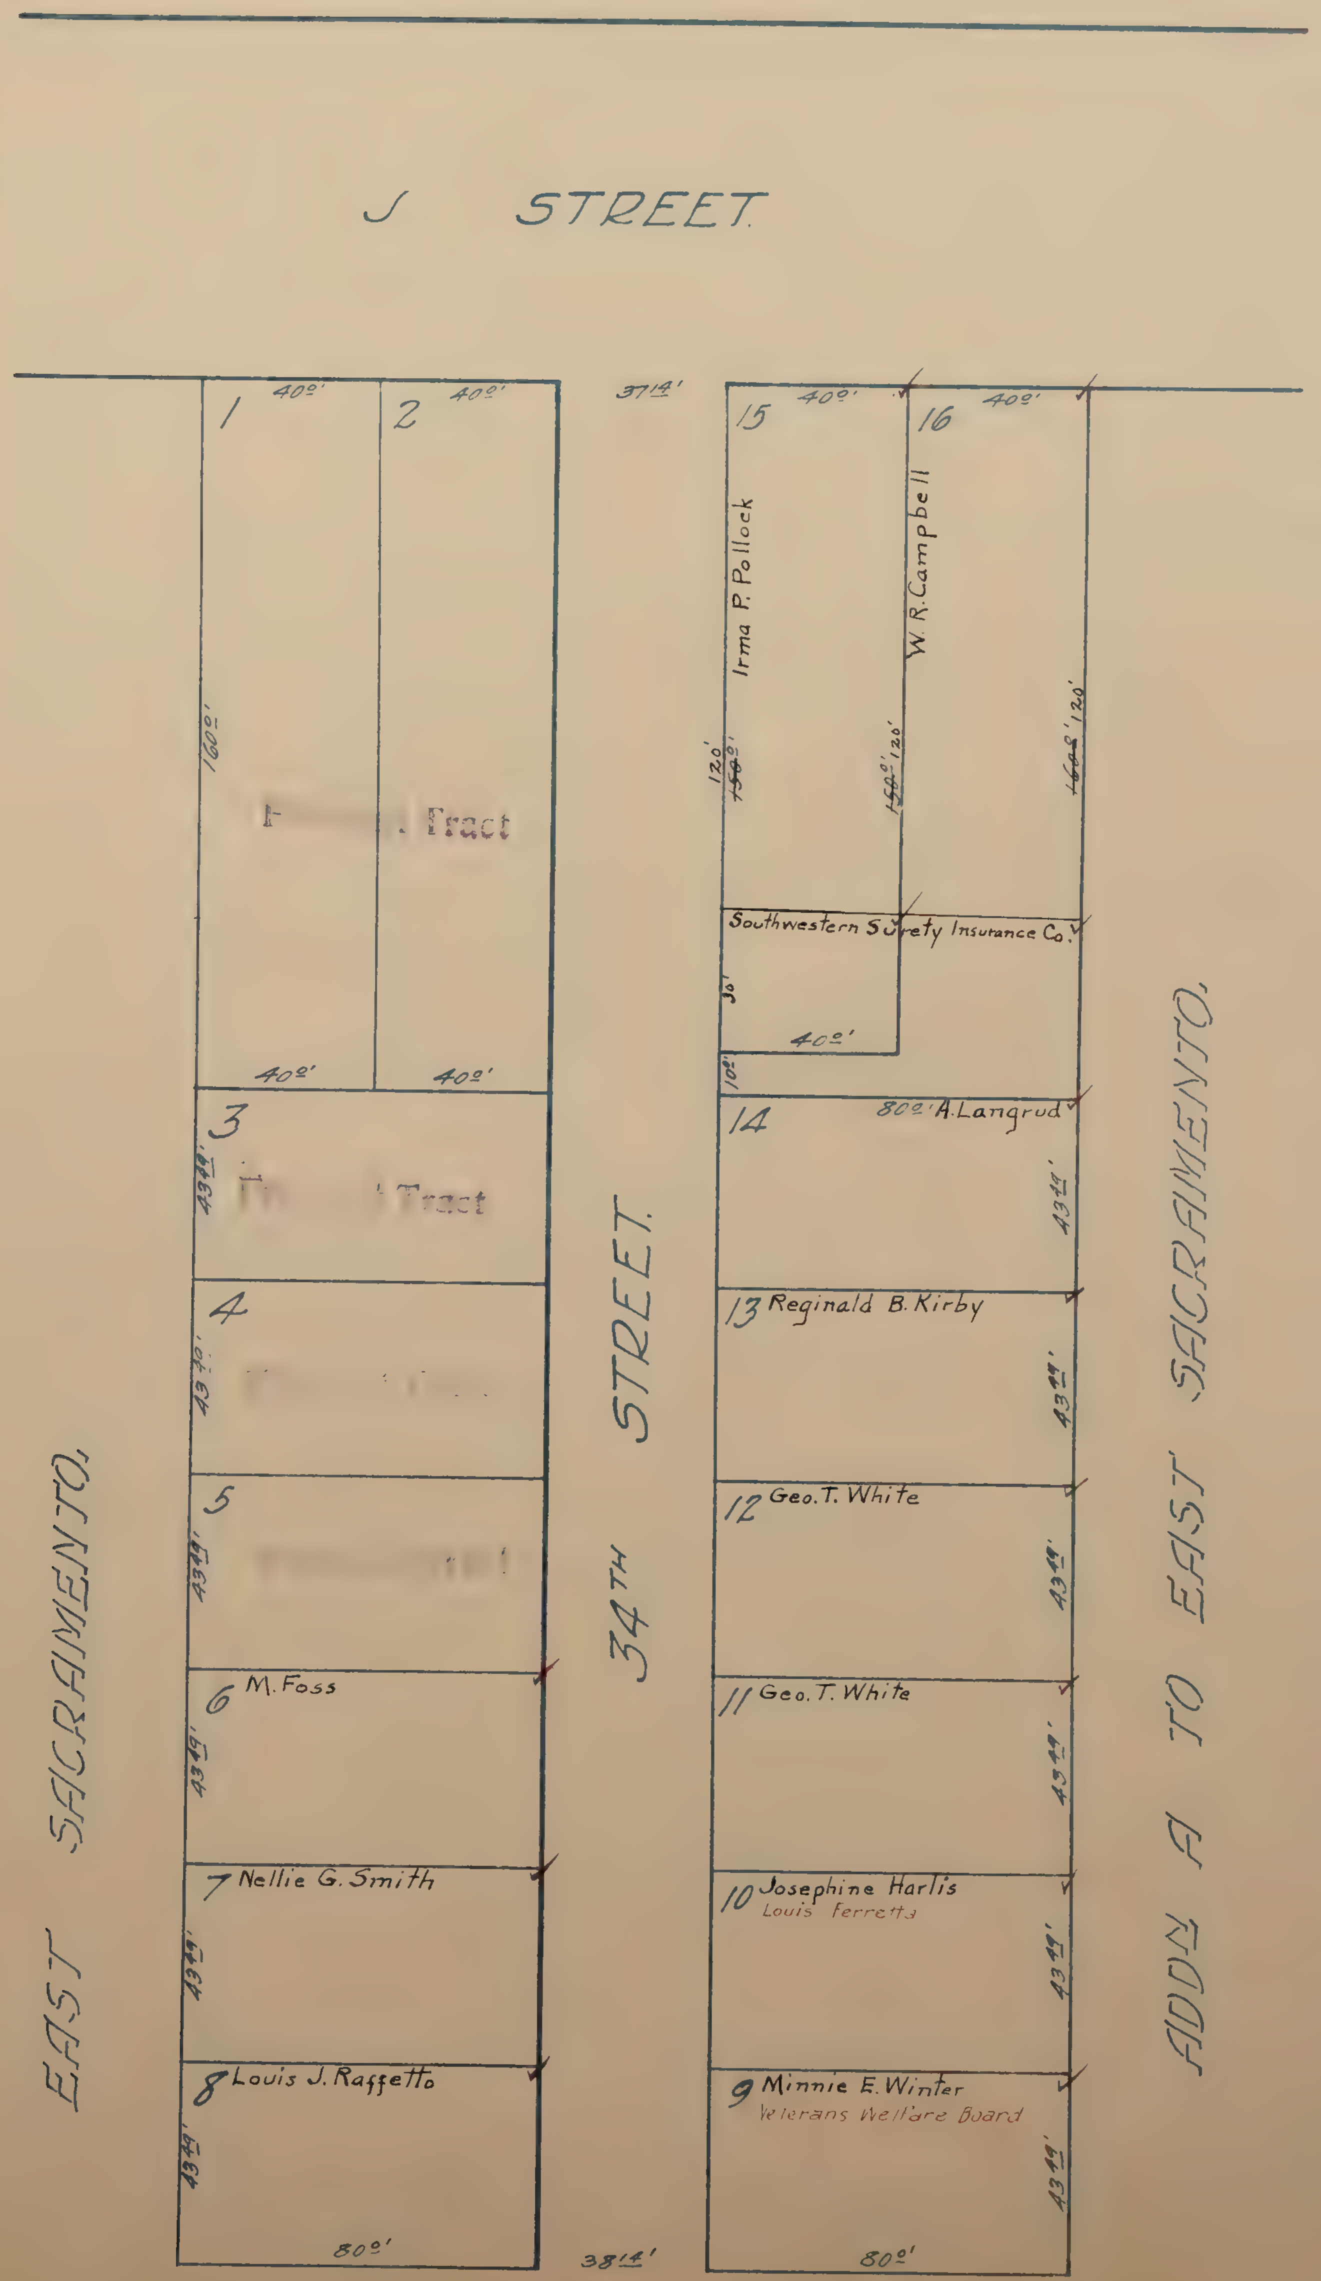
J STREET.
1
2
40º'
40º'
37¼'
15
40º'
16
40º'
Irma P. Pollock
W. R. Campbell
160º'
120' ~~150º'~~
~~150º'~~ 120'
~~160º'~~ 120'
[redacted]
Southwestern Surety Insurance Co.
30'
40º'
10'
40º'
40º'
3
43¼'
[redacted]
14
80º' A. Langrud
43¼'
4
43.30'
[redacted]
13 Reginald B. Kirby
43¼'
5
43¼'
[redacted]
12 Geo. T. White
43¼'
34TH STREET.
6 M. Foss
43¼'
11 Geo. T. White
43¼'
7 Nellie G. Smith
43¼'
10 Josephine Harlis
Louis Ferretta
43¼'
8 Louis J. Raffetto
43¼'
9 Minnie E. Winter
Veterans Welfare Board
43¼'
80º'
38¼'
80º'
EAST SACRAMENTO.
ADDN A TO EAST SACRAMENTO.

CRESCENT PARK ✓

Scale: 1 Inch = 80 feet.

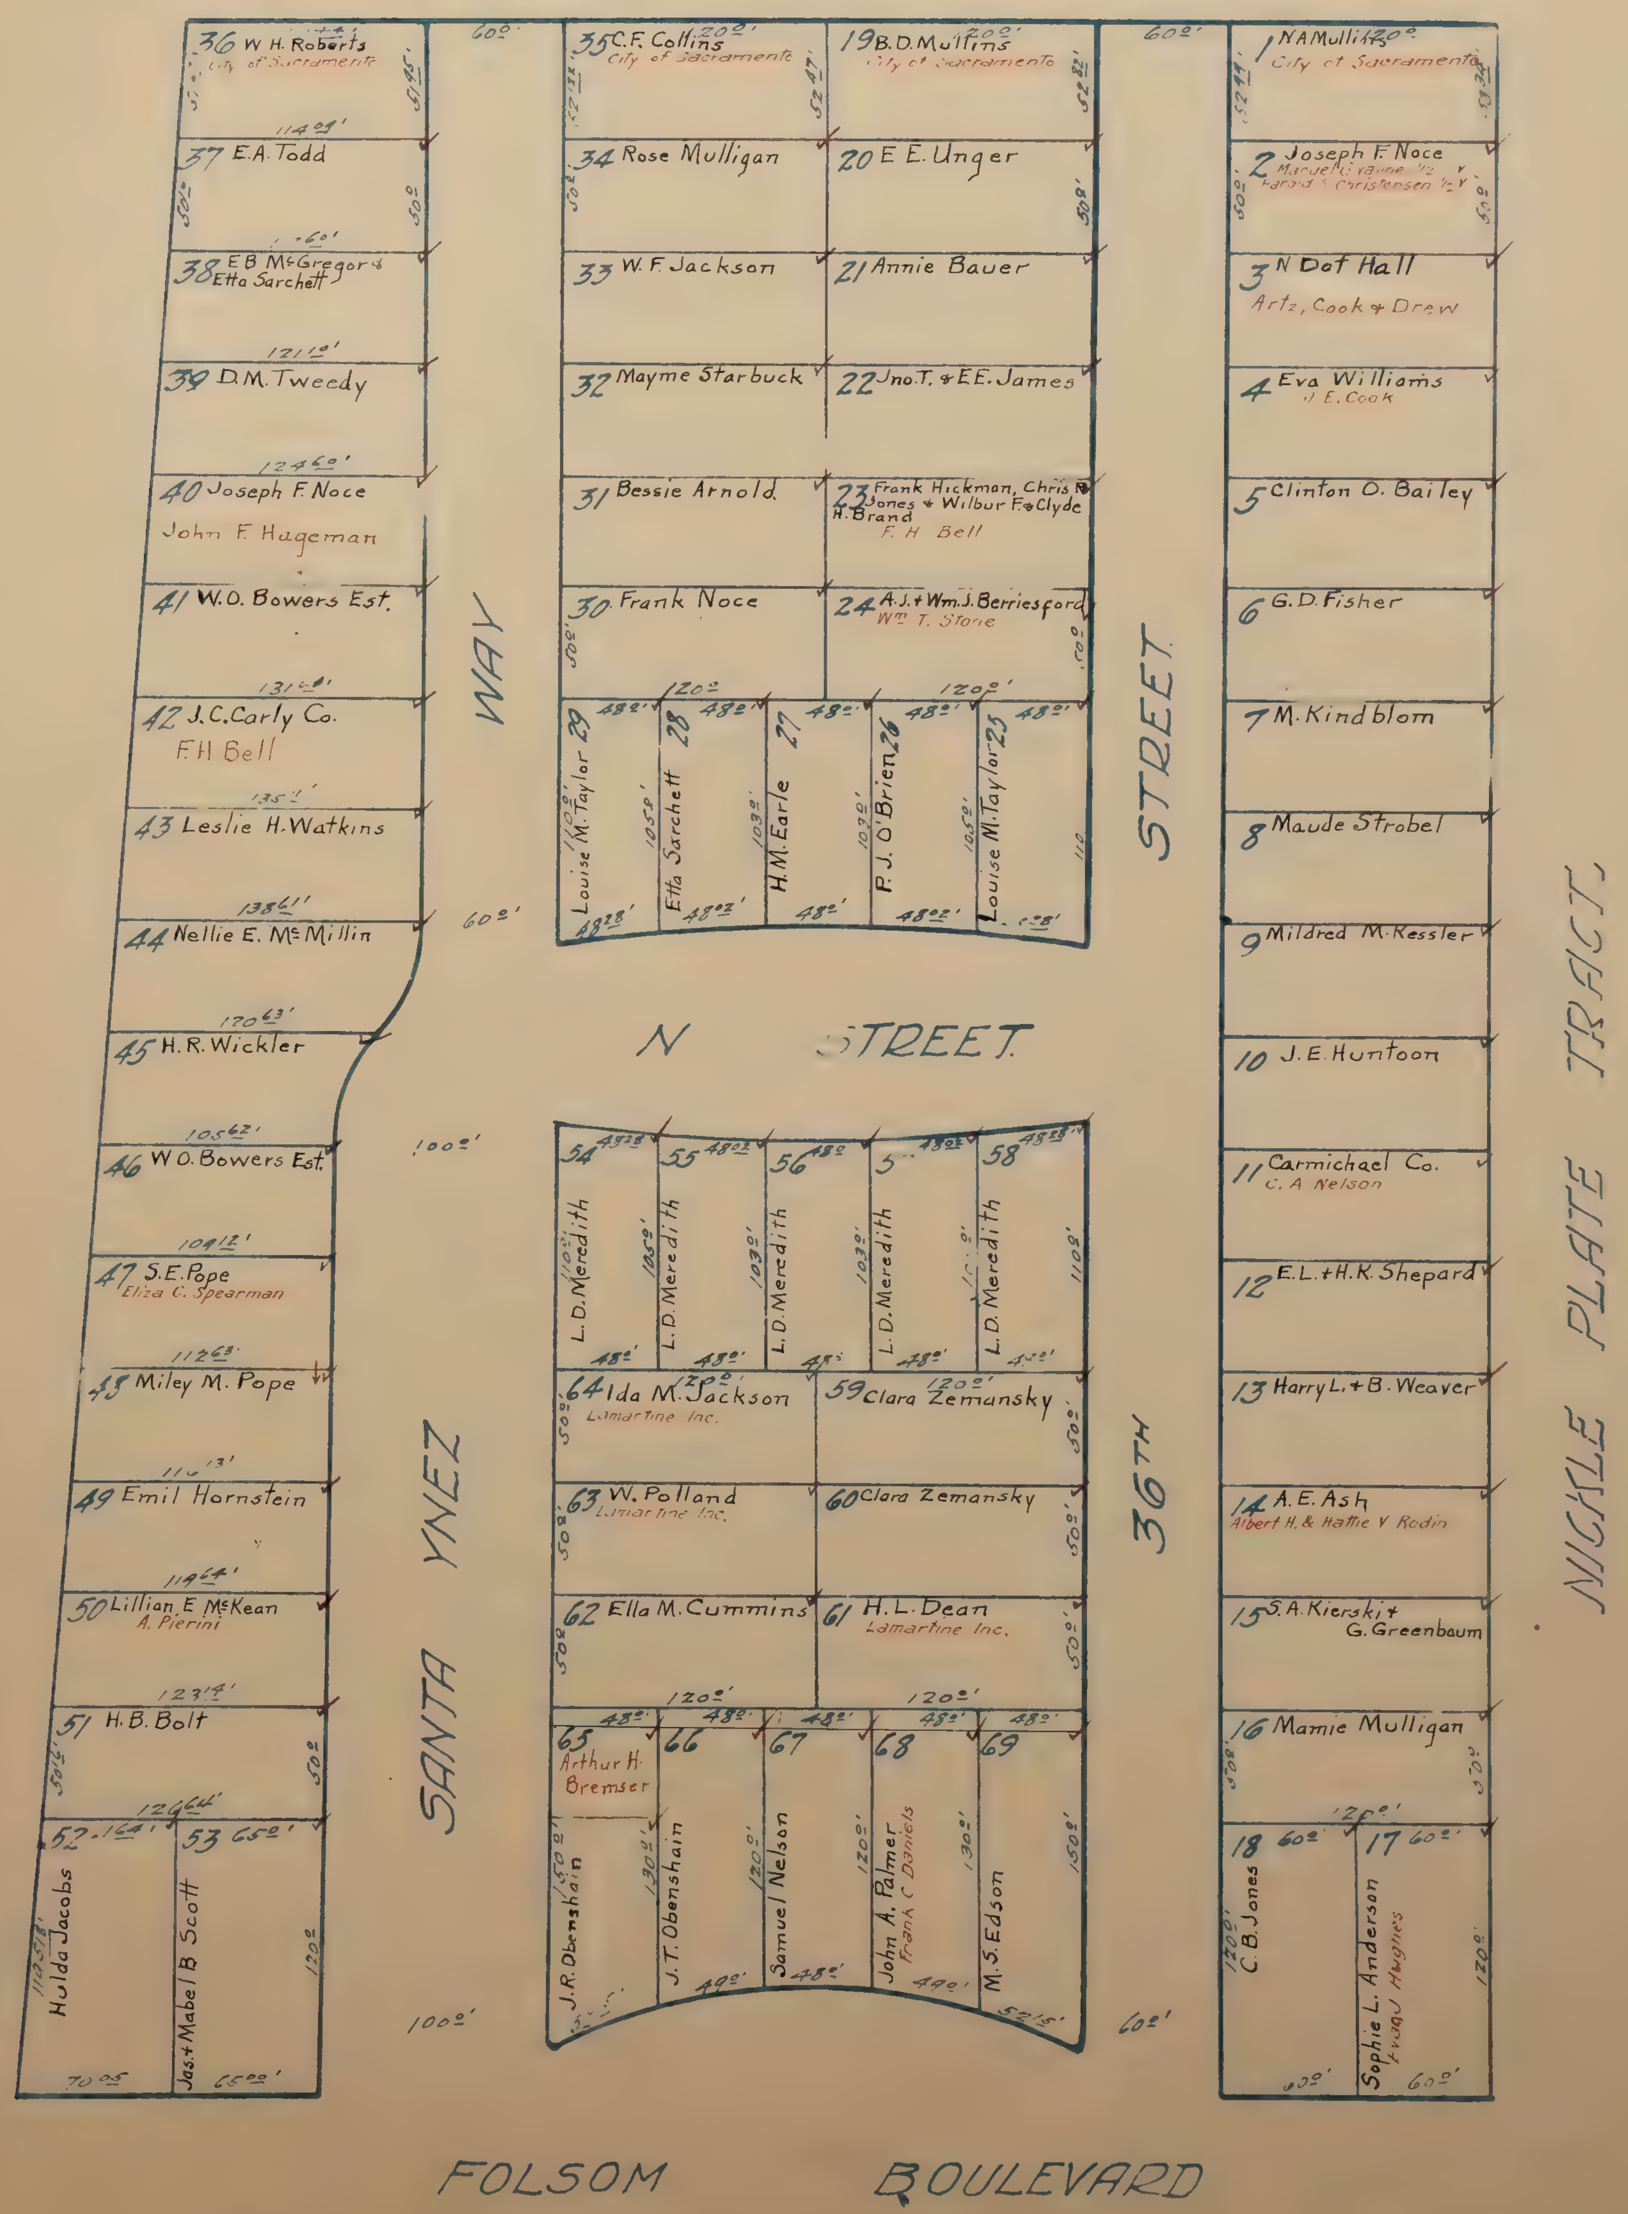
36 W. H. Roberts
City of Sacramento
37 E. A. Todd
38 E B McGregor & Etta Sarchett
39 D.M. Tweedy
40 Joseph F. Noce
John F. Hageman
41 W.O. Bowers Est.
42 J.C. Carly Co.
F.H Bell
43 Leslie H. Watkins
44 Nellie E. McMillin
45 H.R. Wickler
46 W.O. Bowers Est.
47 S.E. Pope
Eliza C. Spearman
48 Miley M. Pope
49 Emil Hornstein
50 Lillian E McKean
A. Pierini
51 H.B. Bolt
52 Hulda Jacobs
53 Jas. + Mabel B Scott
35 C.F. Collins
City of Sacramento
34 Rose Mulligan
33 W.F. Jackson
32 Mayme Starbuck
31 Bessie Arnold
30 Frank Noce
29 Louise M. Taylor
28 Etta Sarchett
27 H.M. Earle
26 P. J. O'Brien
25 Louise M. Taylor
19 B.D. Mullins
City of Sacramento
20 E E. Unger
21 Annie Bauer
22 Jno. T. & E.E. James
23 Frank Hickman, Chris & Jones & Wilbur F. & Clyde H. Brand
F. H Bell
24 A.J. + Wm. J. Berriesford
Wm. T. Stone
N STREET
54 L. D. Meredith
55 L. D. Meredith
56 L. D. Meredith
57 L. D. Meredith
58 L. D. Meredith
64 Ida M. Jackson
Lamartine Inc.
63 W. Polland
Lamartine Inc.
62 Ella M. Cummins
59 Clara Zemansky
60 Clara Zemansky
61 H.L. Dean
Lamartine Inc.
65 Arthur H. Bremser
J.R. Obenshain
66 J.T. Obenshain
67 Samuel Nelson
68 John A. Palmer
Frank C Daniels
69 M.S. Edson
SANTA YNEZ WAY
36TH STREET
1 N A Mullins
City of Sacramento
2 Joseph F. Noce
Manuel Gravine ½
Harold S Christensen ½
3 N Dot Hall
Artz, Cook & Drew
4 Eva Williams
J. E. Cook
5 Clinton O. Bailey
6 G.D. Fisher
7 M. Kindblom
8 Maude Strobel
9 Mildred M. Kessler
10 J.E. Huntoon
11 Carmichael Co.
C. A Nelson
12 E.L. + H.K. Shepard
13 Harry L. + B. Weaver
14 A.E. Ash
Albert H. & Hattie V Rodin
15 S.A. Kierski + G. Greenbaum
16 Mamie Mulligan
18 C.B. Jones
17 Sophie L. Anderson
Evan J Hughes
NICKLE PLATE TRACT
FOLSOM BOULEVARD

CRESCENT PARK EXTENSION

Scale: 1 Inch = 80 feet.

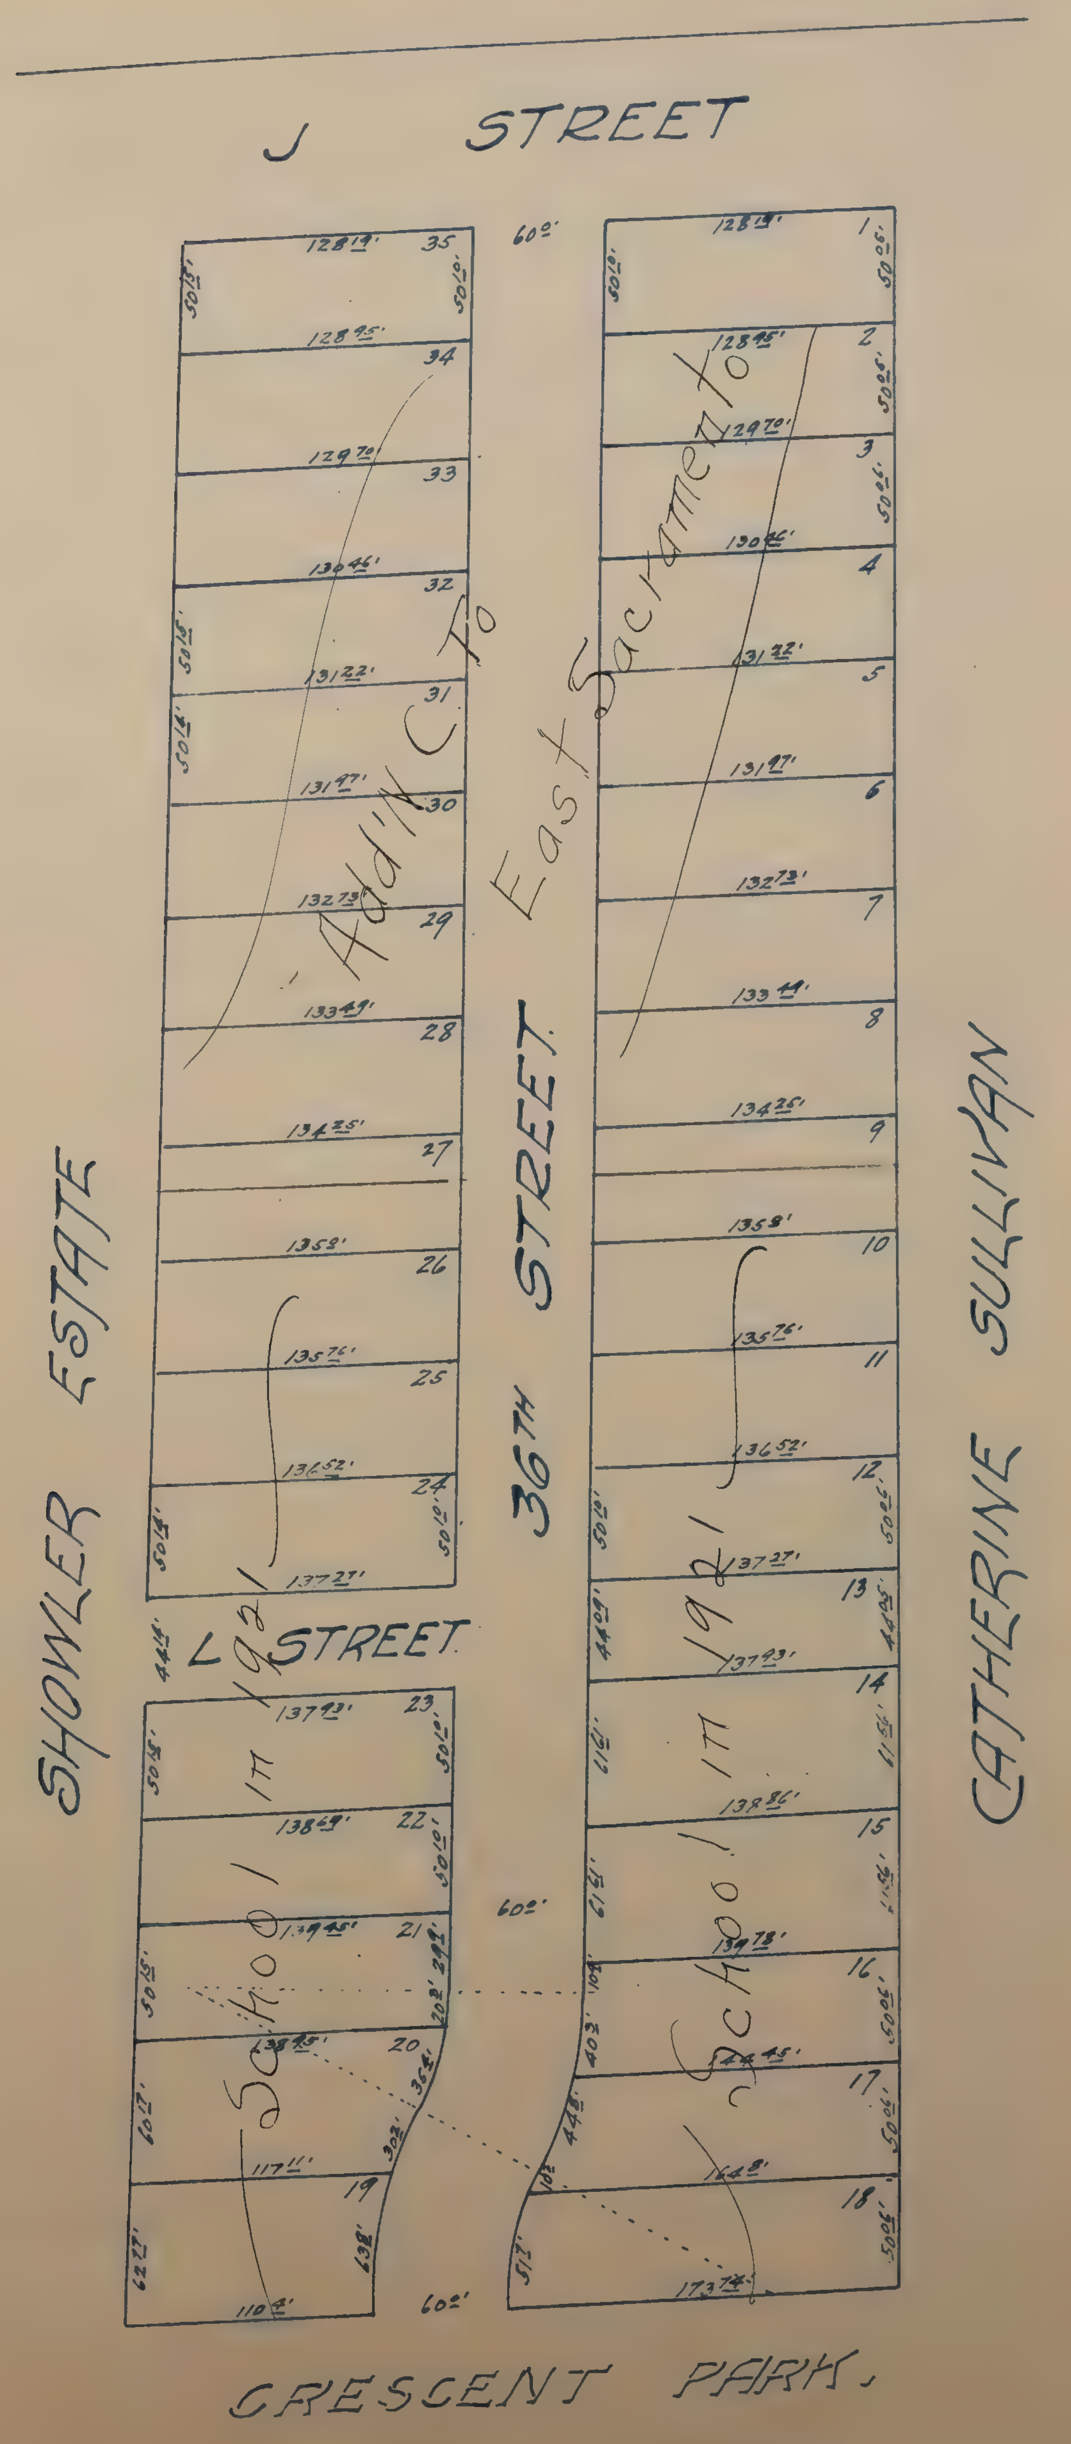
J STREET
L STREET
36TH STREET
SHOWLER ESTATE
CATHERINE SULLIVAN
CRESCENT PARK.
60.0'
Add'n C. to East Sacramento
School in 1921
School in 1921
1
2
3
4
5
6
7
8
9
10
11
12
13
14
15
16
17
18
19
20
21
22
23
24
25
26
27
28
29
30
31
32
33
34
35
128.19'
128.95'
129.70'
130.46'
131.22'
131.97'
132.73'
133.49'
134.25'
135.8'
135.76'
136.52'
137.27'
137.93'
138.69'
138.86'
139.45'
139.78'
138.45'
144.45'
117.11'
164.8'
110.4'
173.74'
50.15'
50.10'
50.05'
44.15'
44.09'
44.05'
11.61'
11.56'
60.17'
62.27'
29.1'
20.2'
36.4'
30.2'
13.8'
10.4'
40.3'
44.8'
10.3'
51.7'

CRESS TRACT ✓

Scale: 1 Inch = 40 feet.

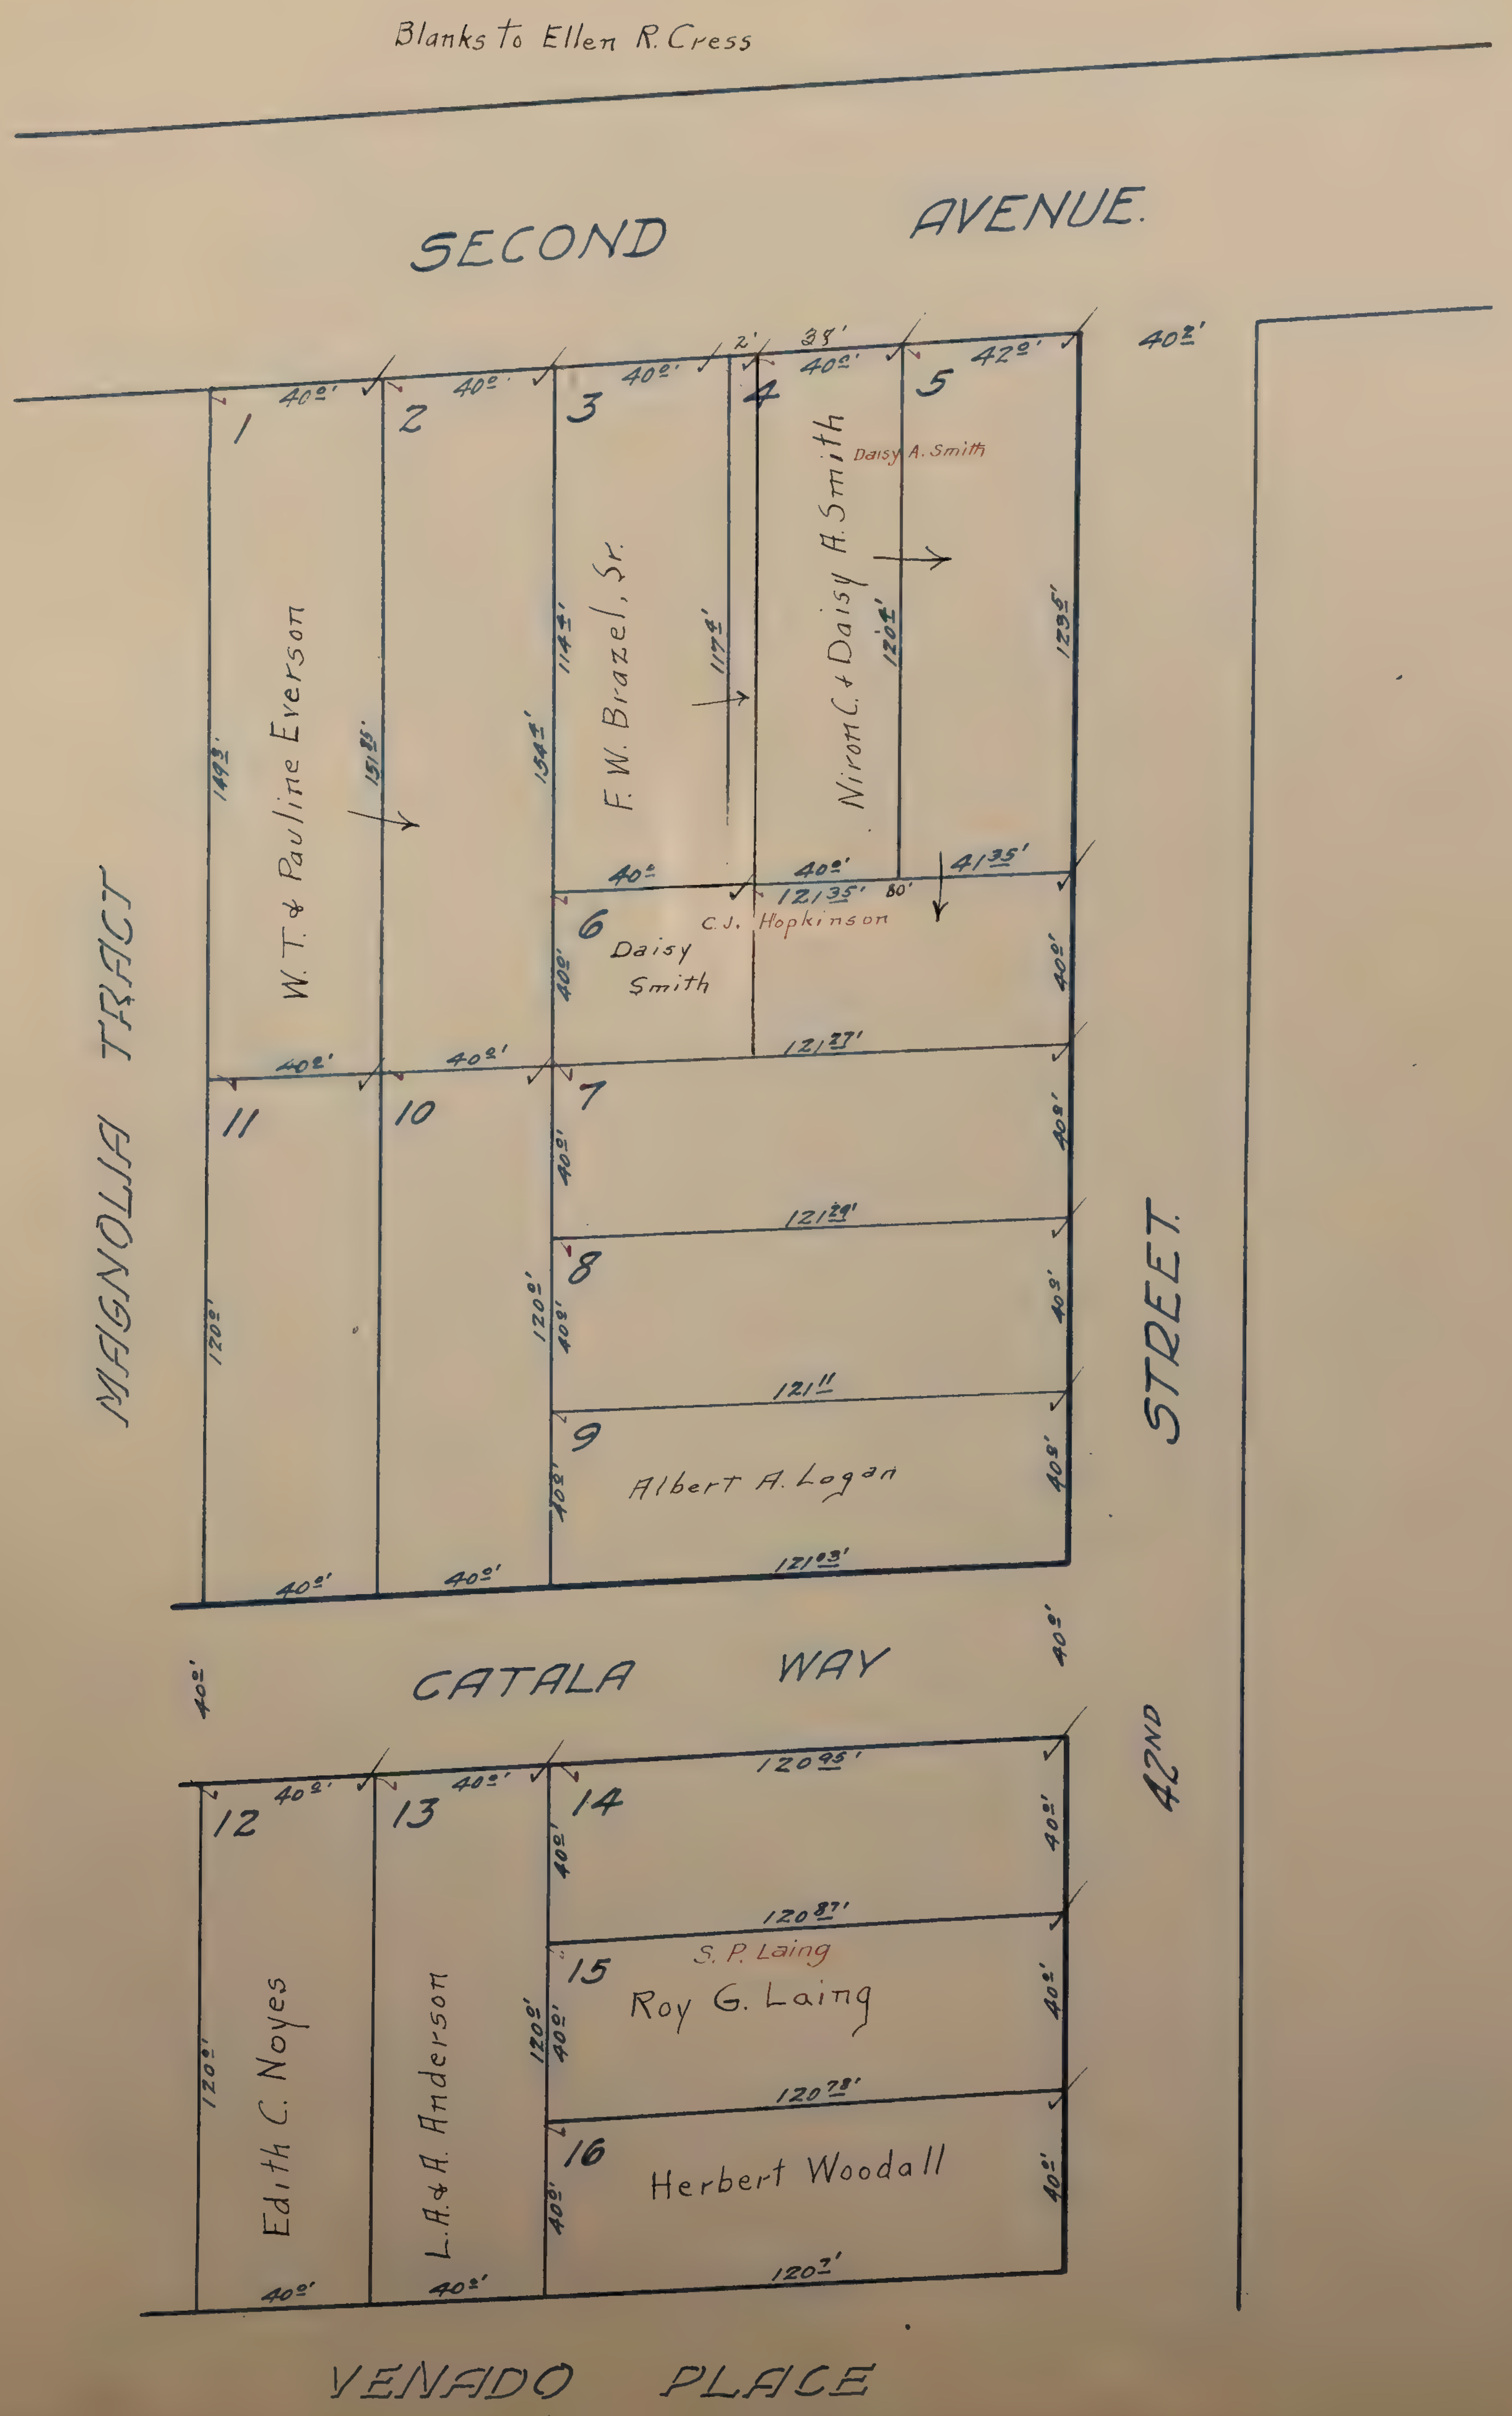
Blanks to Ellen R. Cress
SECOND AVENUE.
MAGNOLIA TRACT
42ND STREET.
CATALA WAY
VENADO PLACE
1
2
3
4
5
6
7
8
9
10
11
12
13
14
15
16
W. T. & Pauline Everson
F. W. Brazel, Sr.
Niron C. & Daisy A. Smith
Daisy A. Smith
Daisy Smith
C. J. Hopkinson
Albert A. Logan
Edith C. Noyes
L. A. & A. Anderson
S. P. Laing
Roy G. Laing
Herbert Woodall
40.0'
42.0'
2'
38'
149.9'
151.85'
134.4'
114.4'
117.4'
120.4'
139.5'
41.35'
121.35'
80'
121.27'
121.29'
121.11'
121.03'
120.0'
120.95'
120.87'
120.78'
120.7'

CRESS

CURTIS & BOWLEY'S ADDN

Scale 1 Inch = 80 feet.

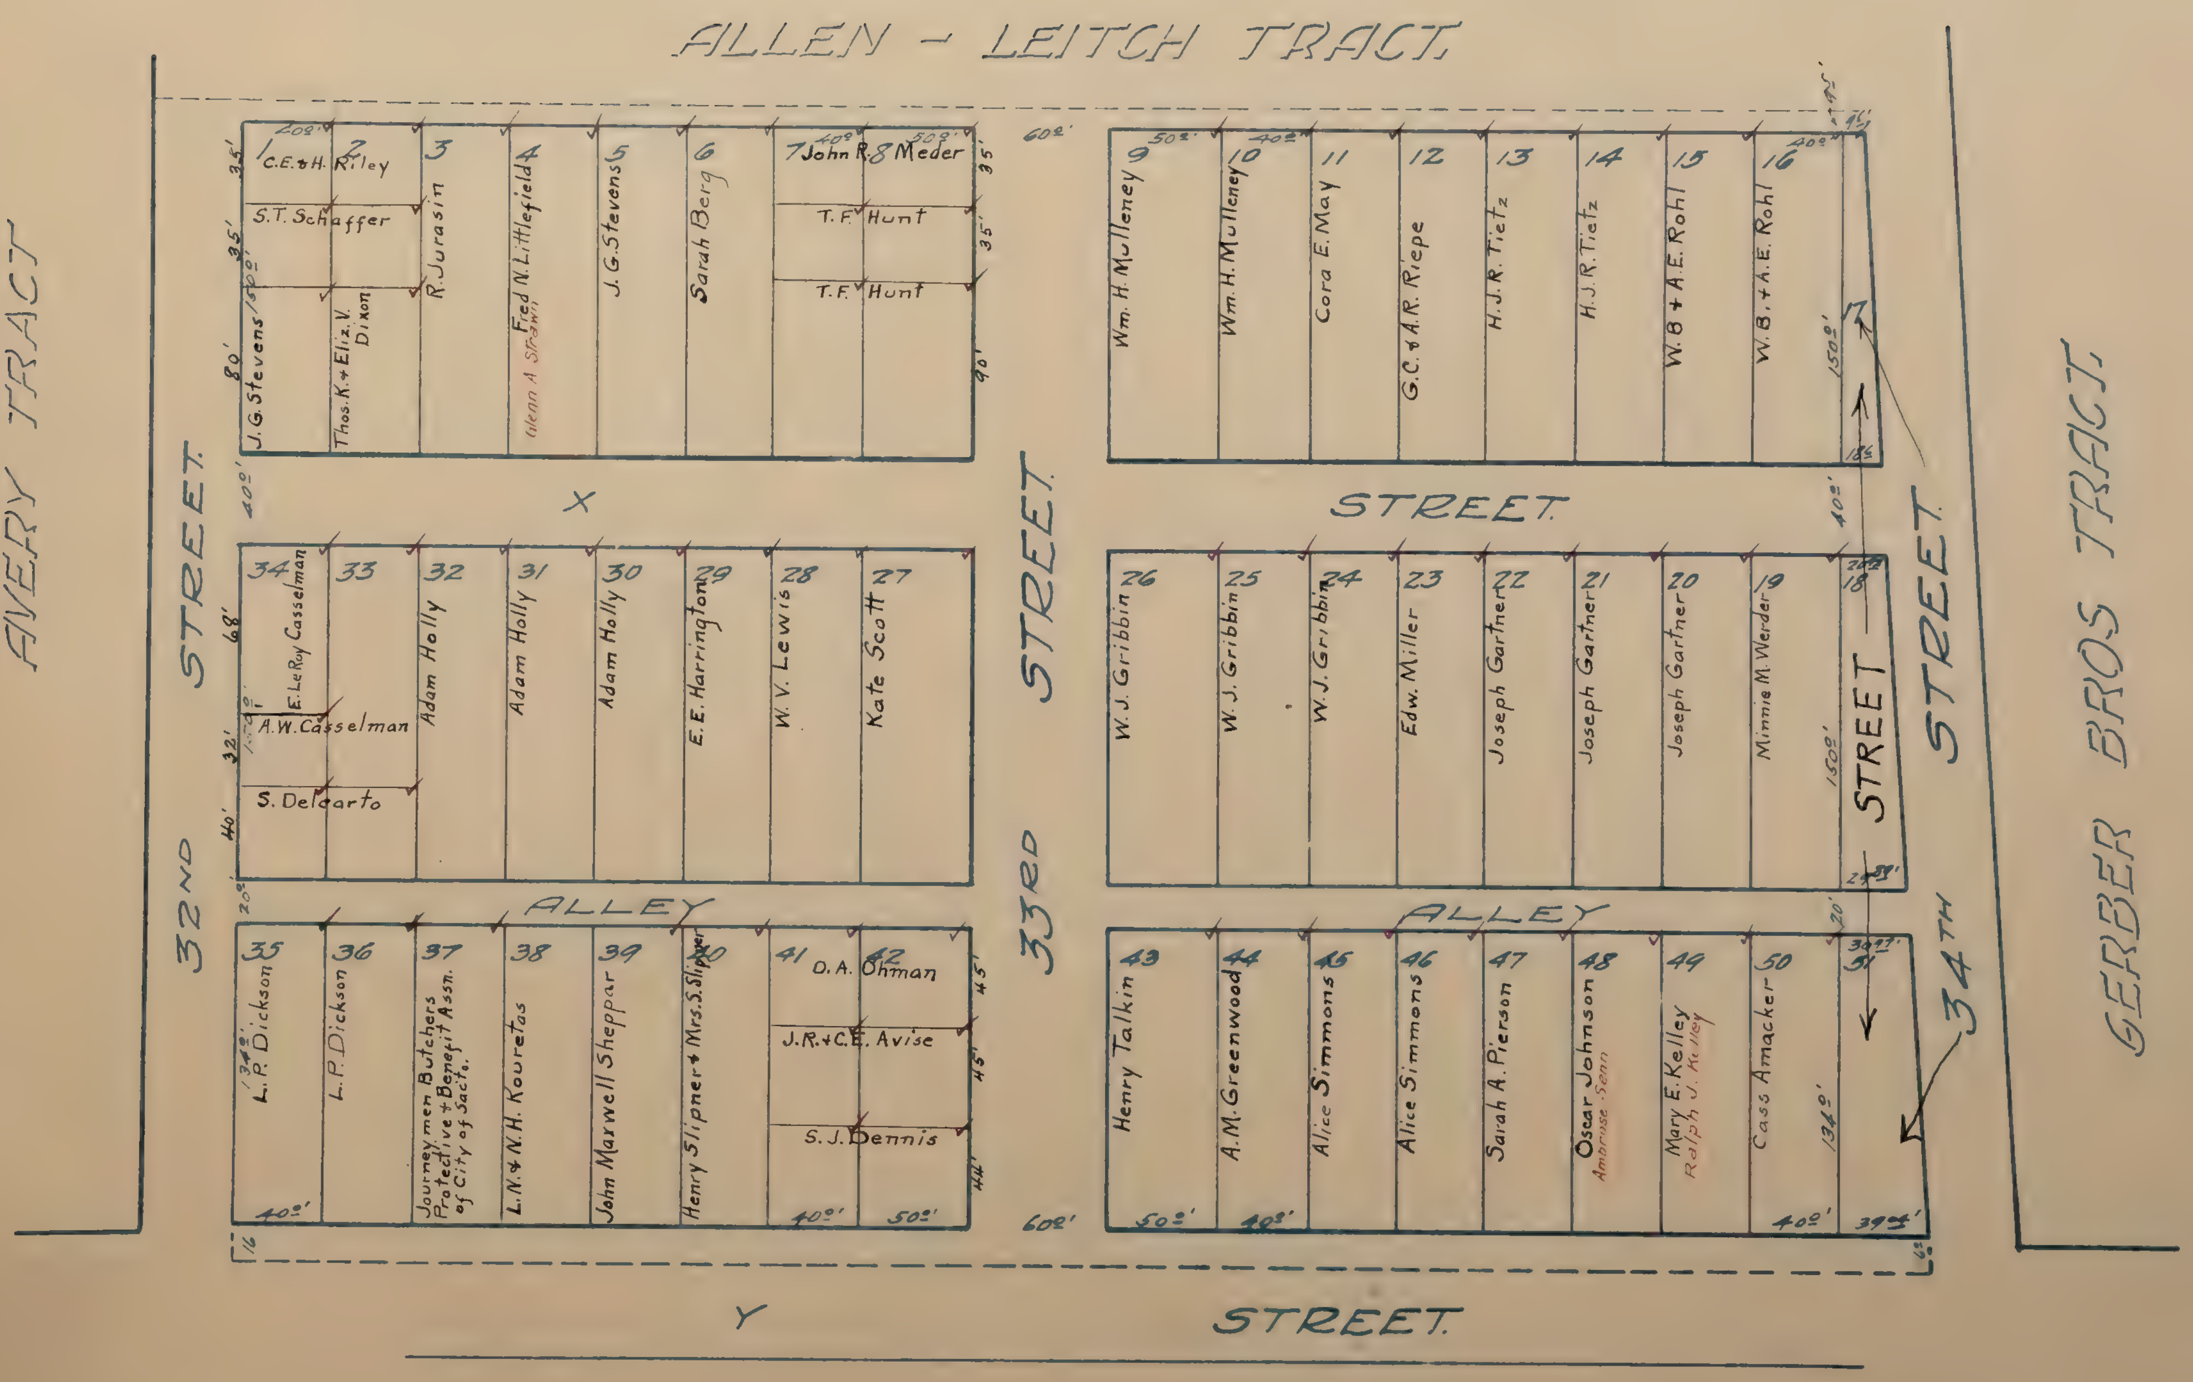
ALLEN - LEITCH TRACT.
AVERY TRACT
GERBER BROS TRACT.
32ND STREET.
33RD STREET.
34TH STREET.
X STREET.
Y STREET.
ALLEY
ALLEY
STREET
1 C.E. & H. Riley
2
S.T. Schaffer
J.G. Stevens
Thos. K. & Eliz. V. Dixon
3 R. Jurasin
4 Fred N. Littlefield
Glenn A. Strawn
5 J.G. Stevens
6 Sarah Berg
7 John R. 8 Meder
T.F. Hunt
T.F. Hunt
9 Wm. H. Mulleney
10 Wm. H. Mulleney
11 Cora E. May
12 G.C. & A.R. Riepe
13 H.J.R. Tietz
14 H.J.R. Tietz
15 W.B. & A.E. Rohl
16 W.B. & A.E. Rohl
17
18
19 Minnie M. Werder
20 Joseph Gartner
21 Joseph Gartner
22 Joseph Gartner
23 Edw. Miller
24 W.J. Gribbin
25 W.J. Gribbin
26 W.J. Gribbin
27 Kate Scott
28 W.V. Lewis
29 E.E. Harrington
30 Adam Holly
31 Adam Holly
32 Adam Holly
33
34 E. LeRoy Casselman
A.W. Casselman
S. Delcarto
35 L.P. Dickson
36 L.P. Dickson
37 Journeymen Butchers Protective & Benefit Assn. of City of Sacto.
38 L.N. & N.H. Kouretas
39 John Marwell Sheppar
40 Henry Slipner & Mrs. S. Slipner
41 O.A. 42 Ohman
J.R. & C.E. Avise
S.J. Dennis
43 Henry Talkin
44 A.M. Greenwood
45 Alice Simmons
46 Alice Simmons
47 Sarah A. Pierson
48 Oscar Johnson
Ambrose Senn
49 Mary E. Kelley
Ralph J. Kelley
50 Cass Amacker
51
20'
35'
35'
50'
80'
40'
50'
40'
50'
35'
35'
90'
60'
50'
40'
40'
150'
40'
20'
150'
68'
32'
40'
20'
34'
40'
40'
50'
45'
45'
44'
60'
50'
40'
40'
134'
39'
16
6

CURTIS OAKS.

Scale: 1 Inch= 80 feet.

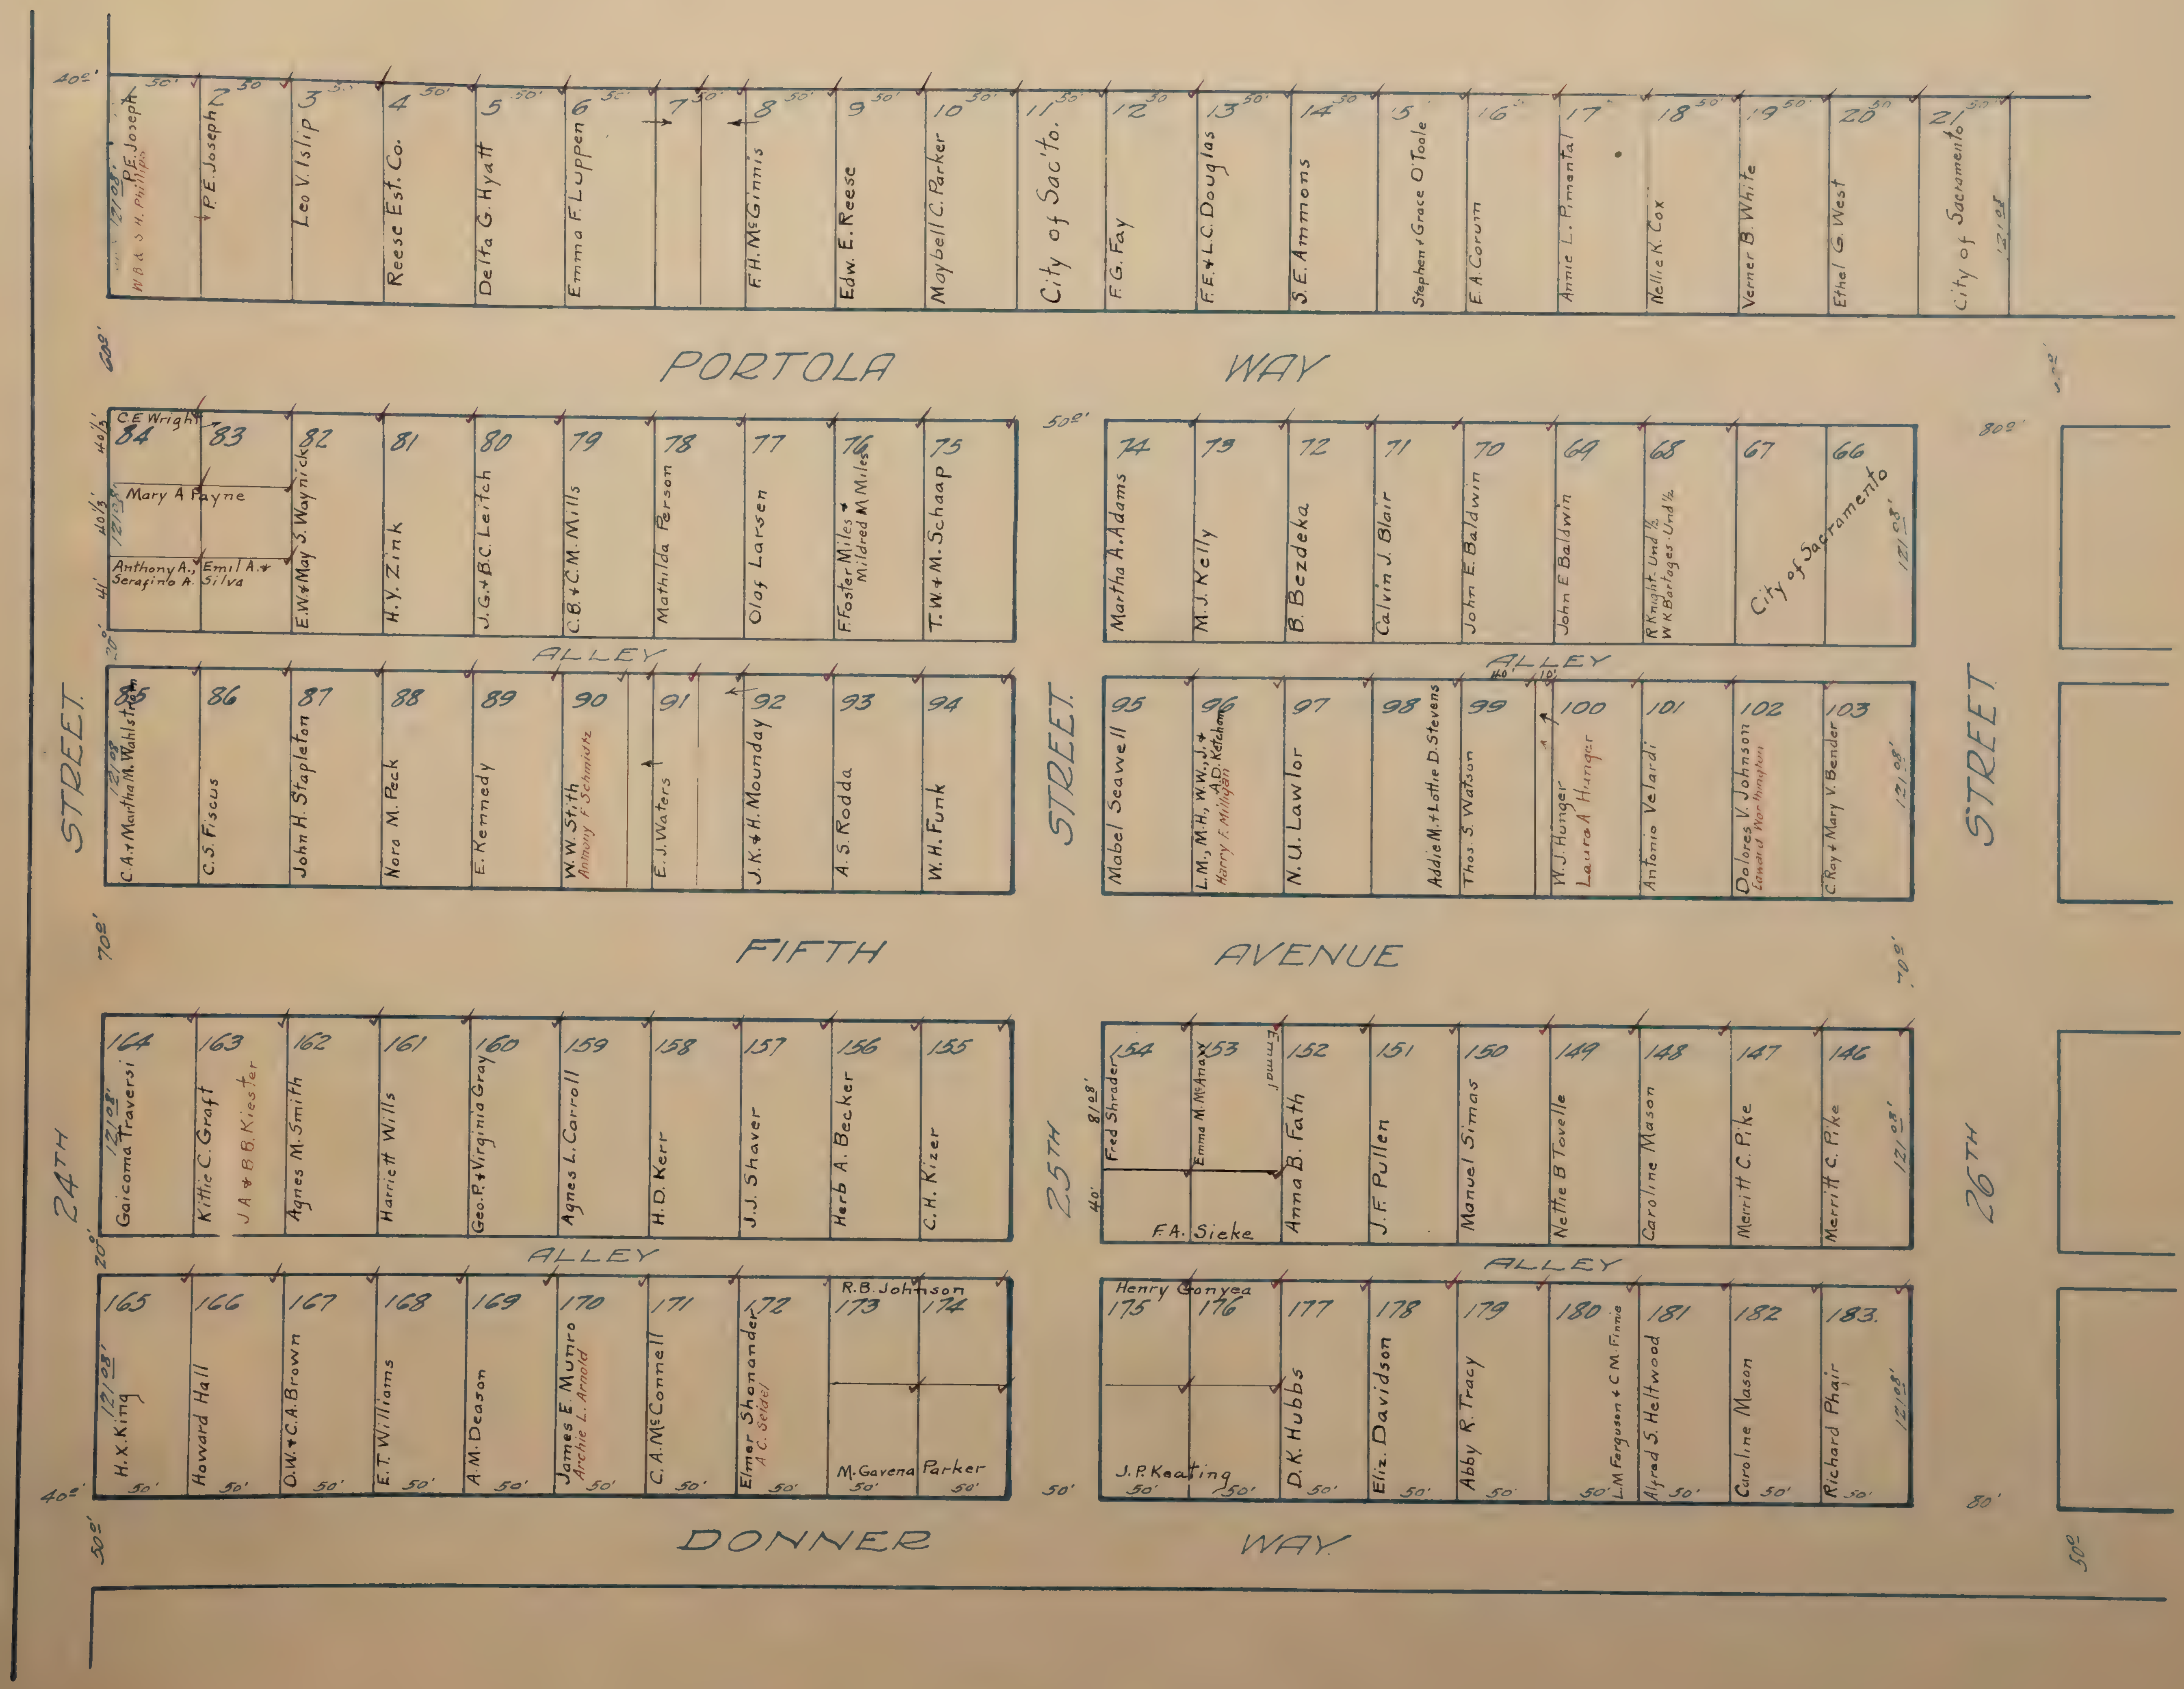
PORTOLA WAY
FIFTH AVENUE
DONNER WAY
24TH STREET
25TH STREET
26TH STREET
ALLEY
ALLEY
ALLEY
ALLEY
40°'
60°'
50°'
80°'
70°'
20°'
50°'
1 P.E. Joseph
W.B. & S.H. Phillips
121.08'
2 P.E. Joseph
3 Leo V. Islip
4 Reese Est. Co.
5 Delta G. Hyatt
6 Emma F. Luppen
7
8 F.H. McGinnis
9 Edw. E. Reese
10 Maybell C. Parker
11 City of Sac'to.
12 F.G. Fay
13 F.E. + L.C. Douglas
14 S.E. Ammons
15 Stephen + Grace O'Toole
16 E.A. Corum
17 Annie L. Pimental
18 Nellie K. Cox
19 Verner B. White
20 Ethel G. West
21 City of Sacramento
121.08'
50'
84 C.E. Wright
83
Mary A Payne
Anthony A., Serafino A.
Emil A. + Silva
40 1/3'
40 1/3'
41'
121.08'
82 E.W. + May S. Waynick
81 H.Y. Zink
80 J.G. + B.C. Leitch
79 C.B. + C.M. Mills
78 Mathilda Person
77 Olof Larsen
76 F. Foster Miles + Mildred M. Miles
75 T.W. + M. Schaap
74 Martha A. Adams
73 M.J. Kelly
72 B. Bezdeka
71 Calvin J. Blair
70 John E. Baldwin
69 John E Baldwin
68 R Knight Und ½ W K Bartages Und ½
67 City of Sacramento
66
121.08'
85 C.A. + Martha M. Wahlstrom
121.08'
86 C.S. Fiscus
87 John H. Stapleton
88 Nora M. Peck
89 E. Kennedy
90 W.W. Stith
Anthony F. Schmidtz
91 E.J. Waters
92 J.K. + H. Mounday
93 A.S. Rodda
94 W.H. Funk
95 Mabel Seawell
96 L.M., M.H., W.W., J. + A.D. Ketcham
Harry F. Milligan
97 N.U. Lawlor
98 Addie M. + Lottie D. Stevens
99 Thos. S. Watson
40'
10'
100 W.J. Hunger
Laura A Hunger
101 Antonio Velardi
102 Dolores V. Johnson
Edward Worthington
103 C. Roy + Mary V. Bender
121.08'
164 Gaicoma Traversi
121.08'
163 Kittie C. Graft
J A + B B. Kiester
162 Agnes M. Smith
161 Harriett Wills
160 Geo. P. + Virginia Gray
159 Agnes L. Carroll
158 H.D. Kerr
157 J.J. Shaver
156 Herb A. Becker
155 C.H. Kizer
154 Fred Shrader
81.08'
40'
153 Emma M. McAnaw
Emma
F.A. Sieke
152 Anna B. Fath
151 J.F. Pullen
150 Manuel Simas
149 Nettie B Tovelle
148 Caroline Mason
147 Merritt C. Pike
146 Merritt C. Pike
121.08'
165 H.X. King
121.08'
166 Howard Hall
167 O.W. + C.A. Brown
168 E.T. Williams
169 A.M. Deason
170 James E. Munro
Archie L. Arnold
171 C.A. McConnell
172 Elmer Shonander
A.C. Seidel
R.B. Johnson
173
174
M. Gavena
Parker
Henry Gonyea
175
176
J.P. Keating
177 D.K. Hubbs
178 Eliz. Davidson
179 Abby R. Tracy
180 L.M. Ferguson + C.M. Finnie
181 Alfred S. Heltwood
182 Caroline Mason
183. Richard Phair
121.08'
50'
50'
50'
50'
50'
50'
50'
50'
50'
50'
50'
50'
50'
50'
50'
50'
50'
50'
50'
50'
80'

5

CURTIS OAKS

Scale: 1 Inch = 80 feet.

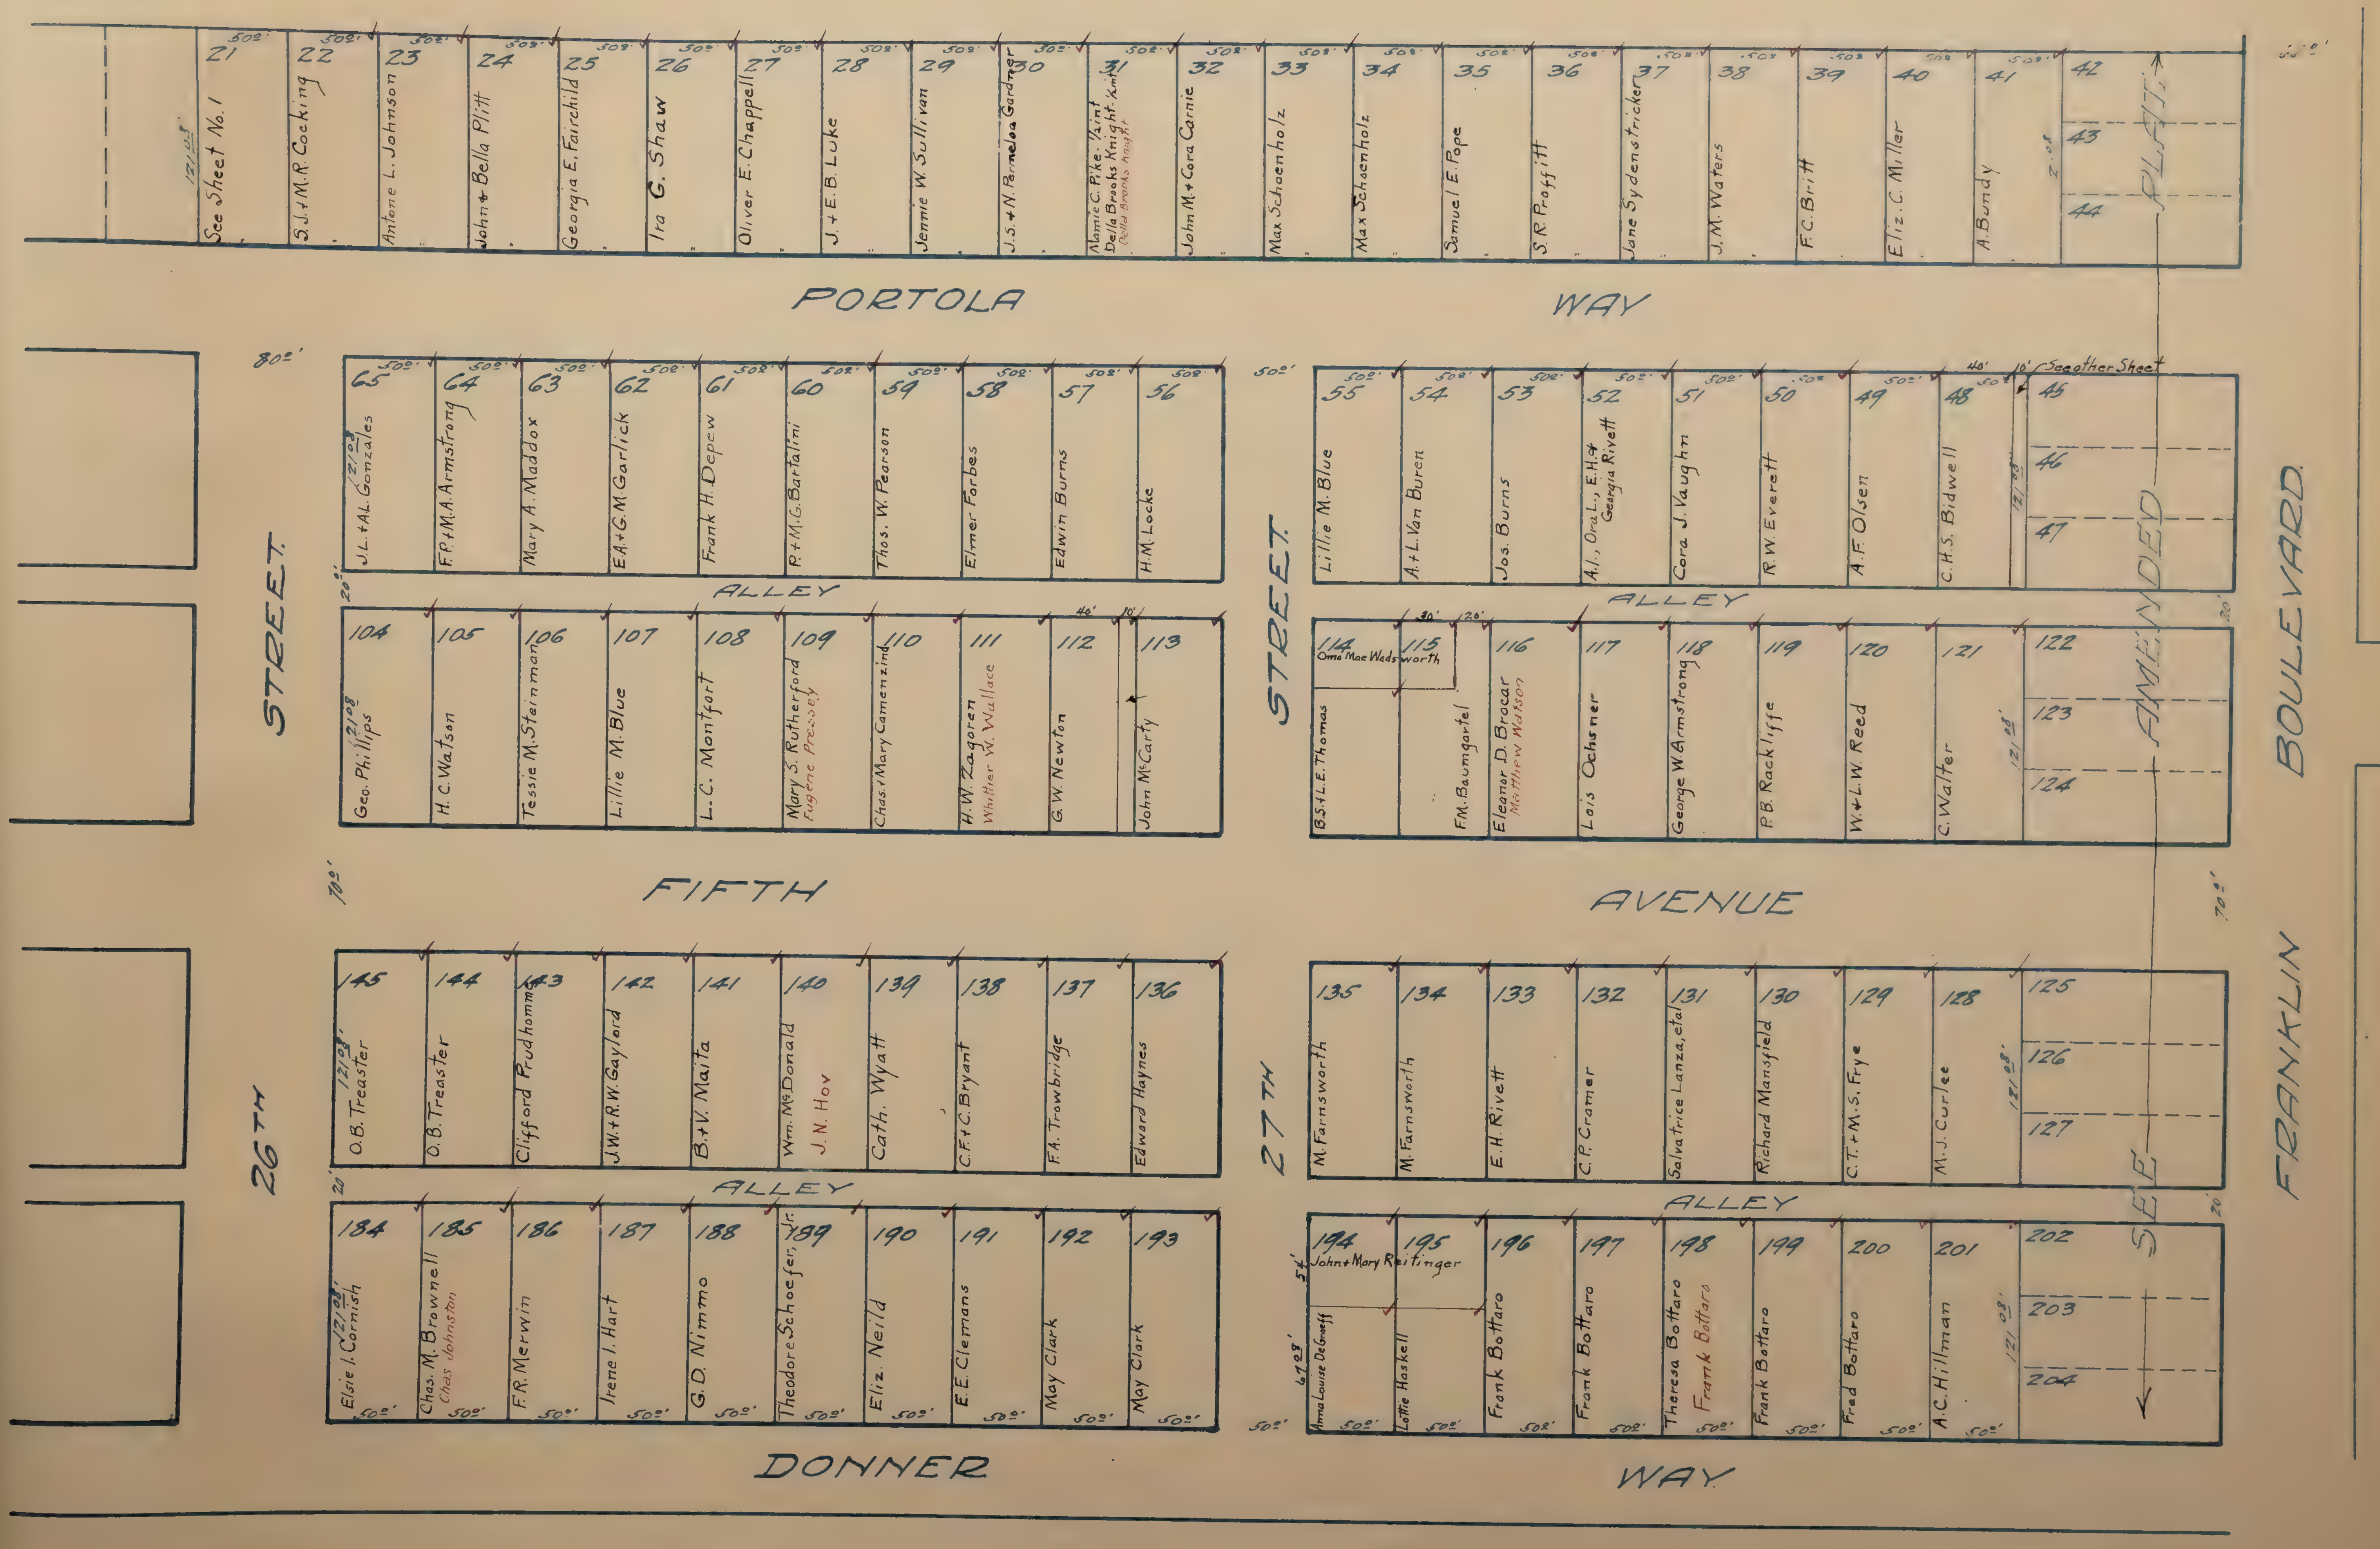

PORTOLA WAY
FIFTH AVENUE
DONNER WAY
26TH STREET
27TH STREET
FRANKLIN BOULEVARD
ALLEY
ALLEY
ALLEY
ALLEY
SEE AMENDED PLAT.
See other Sheet
80.0'
70.0'
20.0'
50.0'
21 See Sheet No. 1
12/08
22 S.J. + M.R. Cocking
23 Antone L. Johnson
24 John + Bella Plitt
25 Georgia E. Fairchild
26 Ira G. Shaw
27 Oliver E. Chappell
28 J. + E.B. Luke
29 Jennie W. Sullivan
30 J.S. + N. Permeloa Gardner
31 Mamie C. Pike: ½ int. Della Brooks Knight: ½ int. Della Brooks Knight
32 John M. + Cora Carnie
33 Max Schoenholz
34 Max Schoenholz
35 Samuel E. Pope
36 S.R. Proffitt
37 Jane Sydenstricker
38 J.M. Waters
39 F.C. Britt
40 Eliz. C. Miller
41 A. Bundy
42
43
44
65 J.L. + A.L. Gonzales
64 F.P. + M.A. Armstrong
63 Mary A. Maddox
62 E.A. + G.M. Garlick
61 Frank H. Depew
60 P. + M.G. Bartalini
59 Thos. W. Pearson
58 Elmer Forbes
57 Edwin Burns
56 H.M. Locke
55 Lillie M. Blue
54 A. + L. Van Buren
53 Jos. Burns
52 A.J., Ora L., E.H. + Georgia Rivett
51 Cora J. Vaughn
50 R.W. Everett
49 A.F. Olsen
48 C.H.S. Bidwell
45
46
47
104 Geo. Phillips
105 H.C. Watson
106 Tessie M. Steinman
107 Lillie M. Blue
108 L.C. Montfort
109 Mary S. Rutherford Eugene Pressey
110 Chas. + Mary Camenzind
111 H.W. Zagoren Whittier W. Wallace
112 G.W. Newton
113 John McCarty
40'
10'
114 Oma Mae Wadsworth
115
B.S. + L.E. Thomas
F.M. Baumgartel
30'
20'
116 Eleanor D. Brocar Matthew Watson
117 Lois Ochsner
118 George W. Armstrong
119 P.B. Rackliffe
120 W. + L.W. Reed
121 C. Walter
122
123
124
145 O.B. Treaster
144 O.B. Treaster
143 Clifford Prudhomme
142 J.W. + R.W. Gaylord
141 B. + V. Maita
140 Wm. McDonald J.N. Hoy
139 Cath. Wyatt
138 C.F. + C. Bryant
137 F.A. Trowbridge
136 Edward Haynes
135 M. Farnsworth
134 M. Farnsworth
133 E.H. Rivett
132 C.P. Cramer
131 Salvatrice Lanza, et al
130 Richard Mansfield
129 C.T. + M.S. Frye
128 M.J. Curlee
125
126
127
184 Elsie I. Cornish
185 Chas. M. Brownell Chas Johnston
186 F.R. Merwin
187 Irene I. Hart
188 G.D. Nimmo
189 Theodore Schoefer, Jr.
190 Eliz. Neild
191 E.E. Clemans
192 May Clark
193 May Clark
194 195 John + Mary Reitinger
Anna Louise DeGraeff
Lottie Haskell
54'
67.08'
196 Frank Bottaro
197 Frank Bottaro
198 Theresa Bottaro Frank Bottaro
199 Frank Bottaro
200 Fred Bottaro
201 A.C. Hillman
202
203
204
121.08'

AMENDED PLAT OF

LOTS 42, 43, 44, 45, 46, 47, 122, 123, 124, 125, 126, 127, 202, 203, 204 OF

CURTIS OAKS

Scale 1 Inch = 80 feet

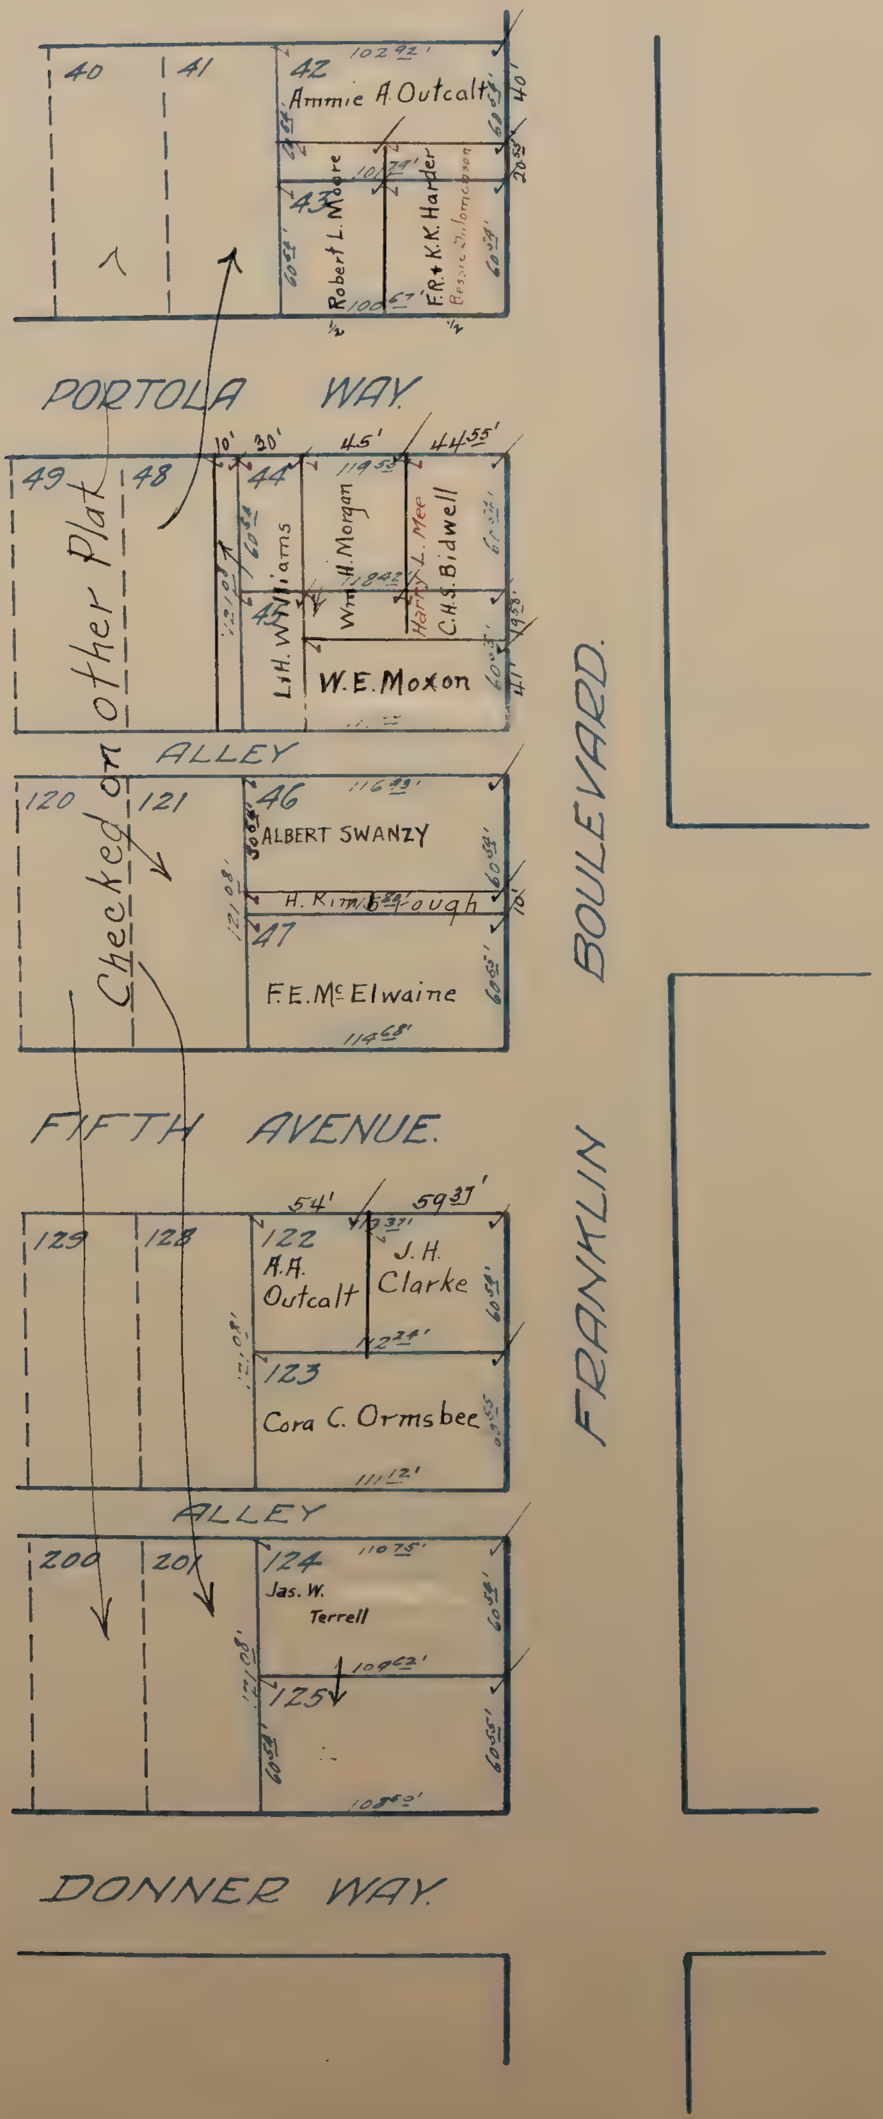
40
41
42
Ammie A. Outcalt
102.92'
43
Robert L. Moore
F.R. + K.K. Harder
Bessie Dalomasson
101.79'
100.67'
60.54'
20.55'
40'
PORTOLA WAY
49
48
other Plat
Checked on
10'
30'
45'
44.55'
44
45
L.H. Williams
Wm. H. Morgan
Harry L. Mee
C.H.S. Bidwell
W.E. Moxon
119.53'
118.42'
121.08'
19.58'
41'
ALLEY
120
121
46
ALBERT SWANZY
H. Kimbrough
47
F.E. McElwaine
116.93'
114.68'
30.54'
60.54'
60.55'
10'
FIFTH AVENUE
129
128
54'
59.37'
122
A.A. Outcalt
J.H. Clarke
112.34'
123
Cora C. Ormsbee
111.12'
121.08'
ALLEY
200
201
124
Jas. W. Terrell
110.75'
109.62'
125
108.50'
60.54'
60.55'
DONNER WAY
FRANKLIN BOULEVARD

6

CUTTER BROS TRACT No1 ✓✓

Scale: 1 Inch = 40 feet.

Note: Comprises Lots 7 & 8 of Mary Tullar Tract.

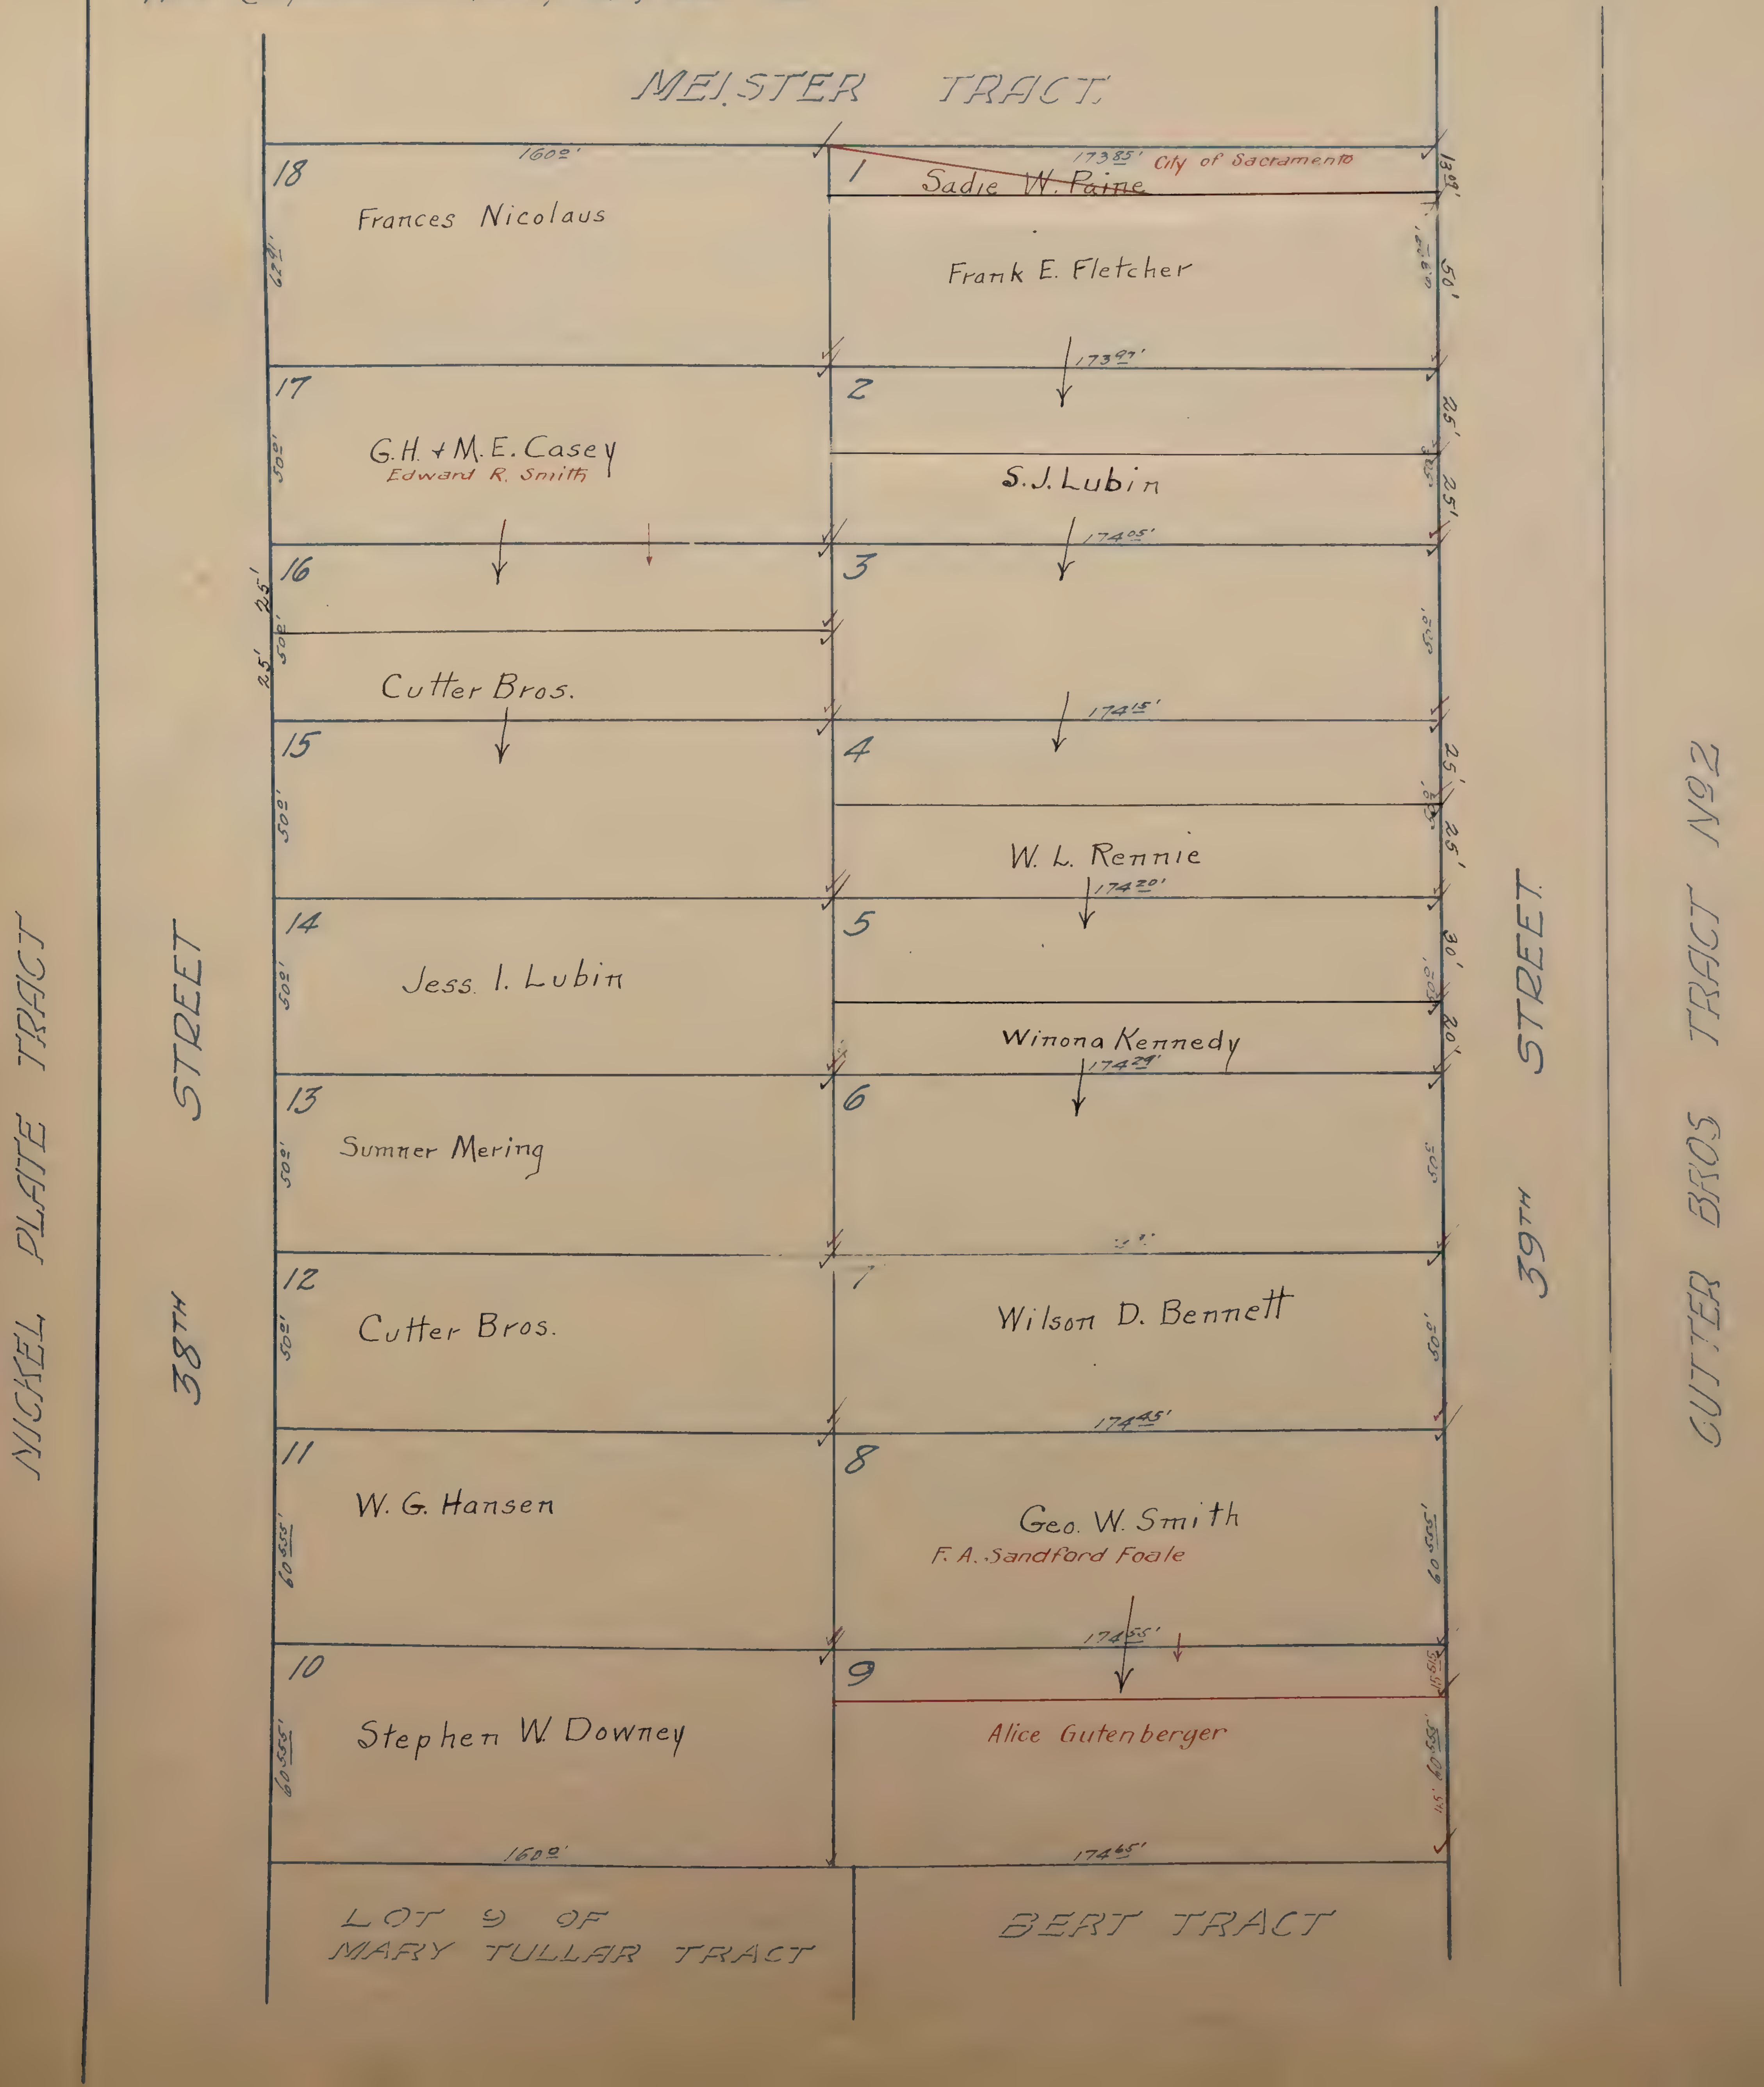
MEISTER TRACT
160.0'
18
Frances Nicolaus
62.1'
17
50.0'
G.H. & M.E. Casey
Edward R. Smith
16
25'
25'
50.0'
Cutter Bros.
15
50.0'
14
50.0'
Jess. I. Lubin
13
50.0'
Sumner Mering
12
50.0'
Cutter Bros.
11
W. G. Hansen
60.555'
10
60.555'
Stephen W. Downey
160.0'
173.85'
City of Sacramento
1
Sadie W. Paine
13.09'
63.03'
50'
Frank E. Fletcher
173.97'
2
25'
S.J. Lubin
50.0'
25'
174.05'
3
50.0'
174.15'
4
25'
50.0'
25'
W. L. Rennie
174.20'
5
30'
50.0'
20'
Winona Kennedy
174.29'
6
50.0'
7
Wilson D. Bennett
50.0'
174.45'
8
Geo. W. Smith
F. A. Sandford Foale
60.555'
174.55'
9
15.515
Alice Gutenberger
60.555'
14.5'
174.65'
LOT 9 OF MARY TULLAR TRACT
BERT TRACT
NICKEL PLATE TRACT
38TH STREET
39TH STREET
CUTTER BROS TRACT No2

CUTTER BROS. TRACT No 2. ✓

Scale: 1 Inch = 80 feet

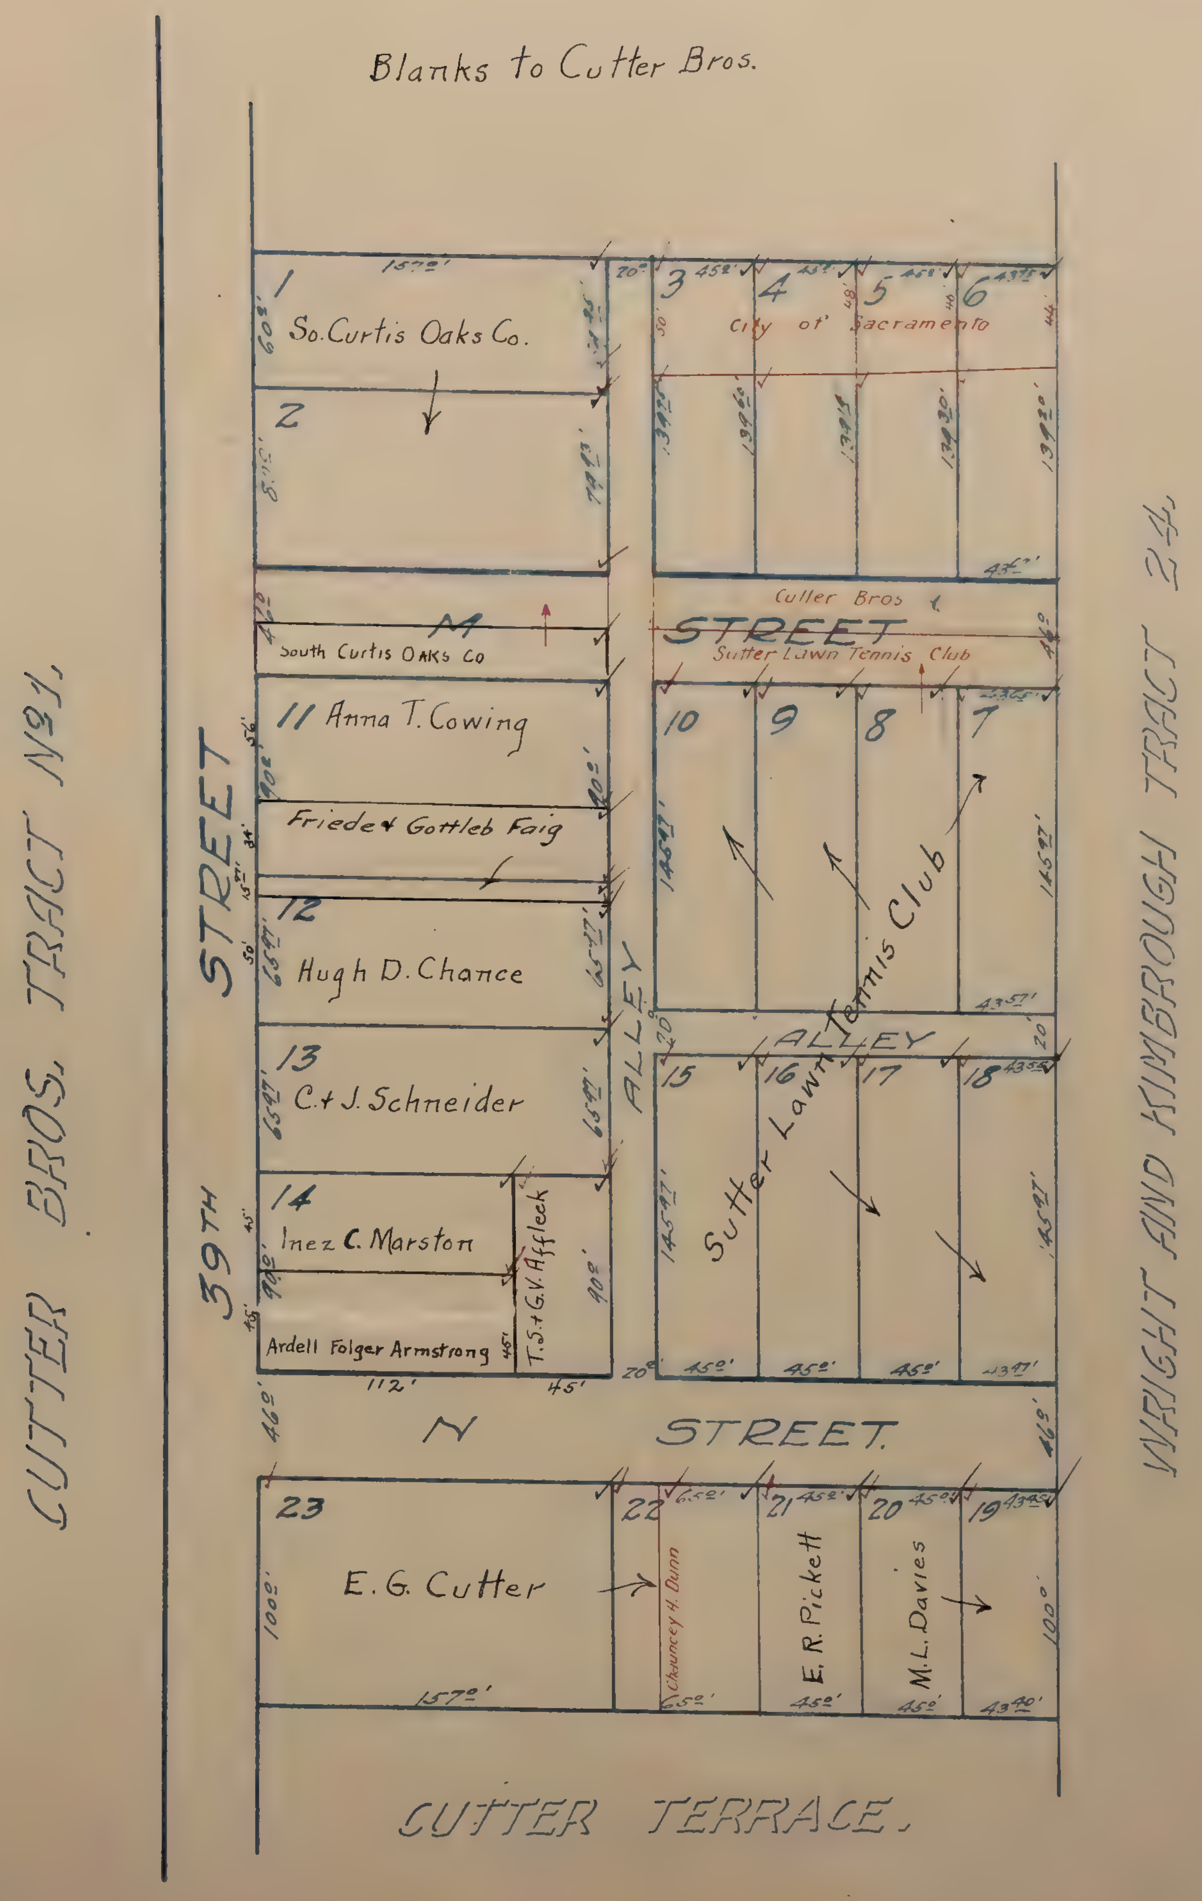
Blanks to Cutter Bros.
CUTTER BROS. TRACT No 1.
39TH STREET
WRIGHT AND KIMBROUGH TRACT 24.
1
So. Curtis Oaks Co.
2
157⁰'
60⁰'
3
4
5
6
City of Sacramento
M STREET
South Curtis OAKS Co
Culler Bros &
Sutter Lawn Tennis Club
11 Anna T. Cowing
Friede & Gottleb Faig
12
Hugh D. Chance
13
C. & J. Schneider
14
Inez C. Marston
Ardell Folger Armstrong
T.S. & G.V. Affleck
ALLEY
10
9
8
7
15
16
17
18
Sutter Lawn Tennis Club
112'
45'
45⁰'
20⁰
N STREET.
46⁰'
23
E. G. Cutter
22
Chauncey H. Dunn
21
E. R. Pickett
20
M. L. Davies
19
100⁰'
157⁰'
65⁰'
43⁴⁰'
CUTTER TERRACE.

CUTTER TERRACE ✓✓

Scale: 1 Inch = 40 feet.

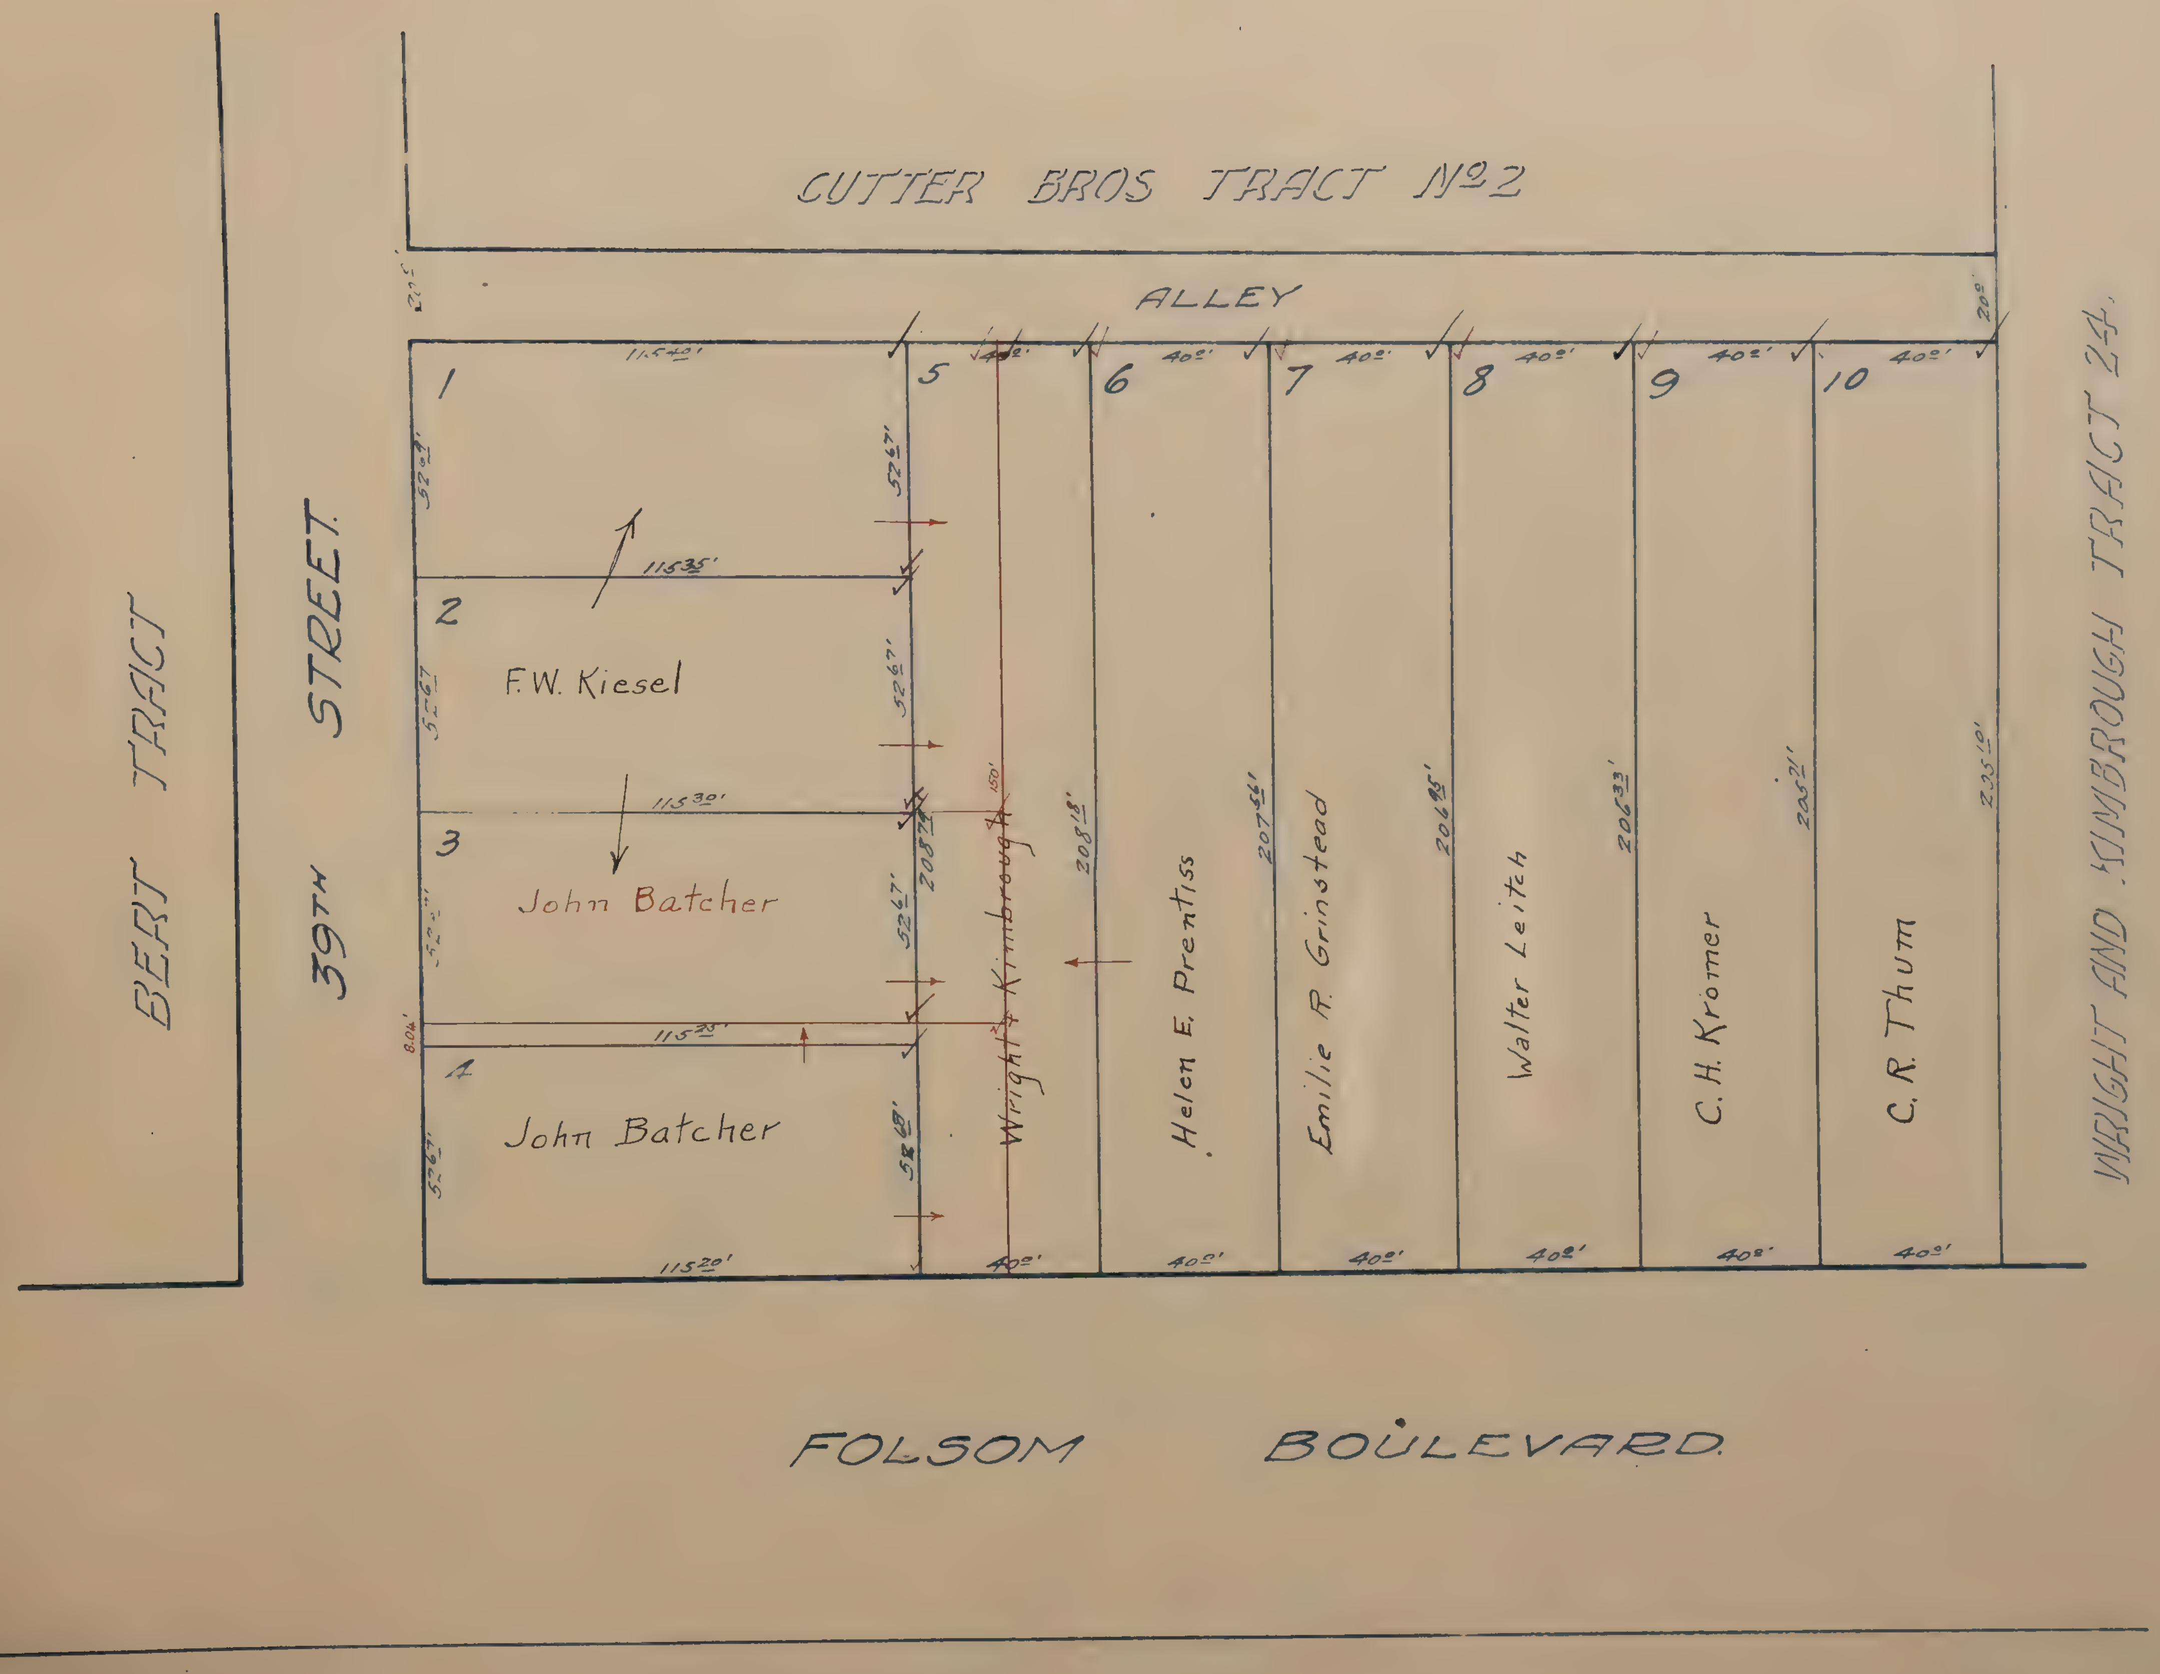
CUTTER BROS TRACT Nº2
ALLEY
20.5'
20'
BERT TRACT
39TH STREET
WRIGHT AND KIMBROUGH TRACT 24.
FOLSOM BOULEVARD
1
2
3
4
5
6
7
8
9
10
115.40'
115.35'
115.30'
115.25'
115.20'
52.67'
52.67'
52.67'
52.67'
52.68'
8.04'
150'
208.74'
208.18'
207.56'
206.95'
206.33'
205.71'
235.10'
40.0'
F.W. Kiesel
John Batcher
John Batcher
Wright & Kimbrough
Helen E. Prentiss
Emilie R. Grinstead
Walter Leitch
C.H. Kromer
C.R. Thum

PLAT OF
DARLING TRACT
LOCATED IN
Sacramento City, California

Surveyed May, 1923

DRURY BUTLER CIVIL ENGINEER

Scale: 1 in = 40 ft.

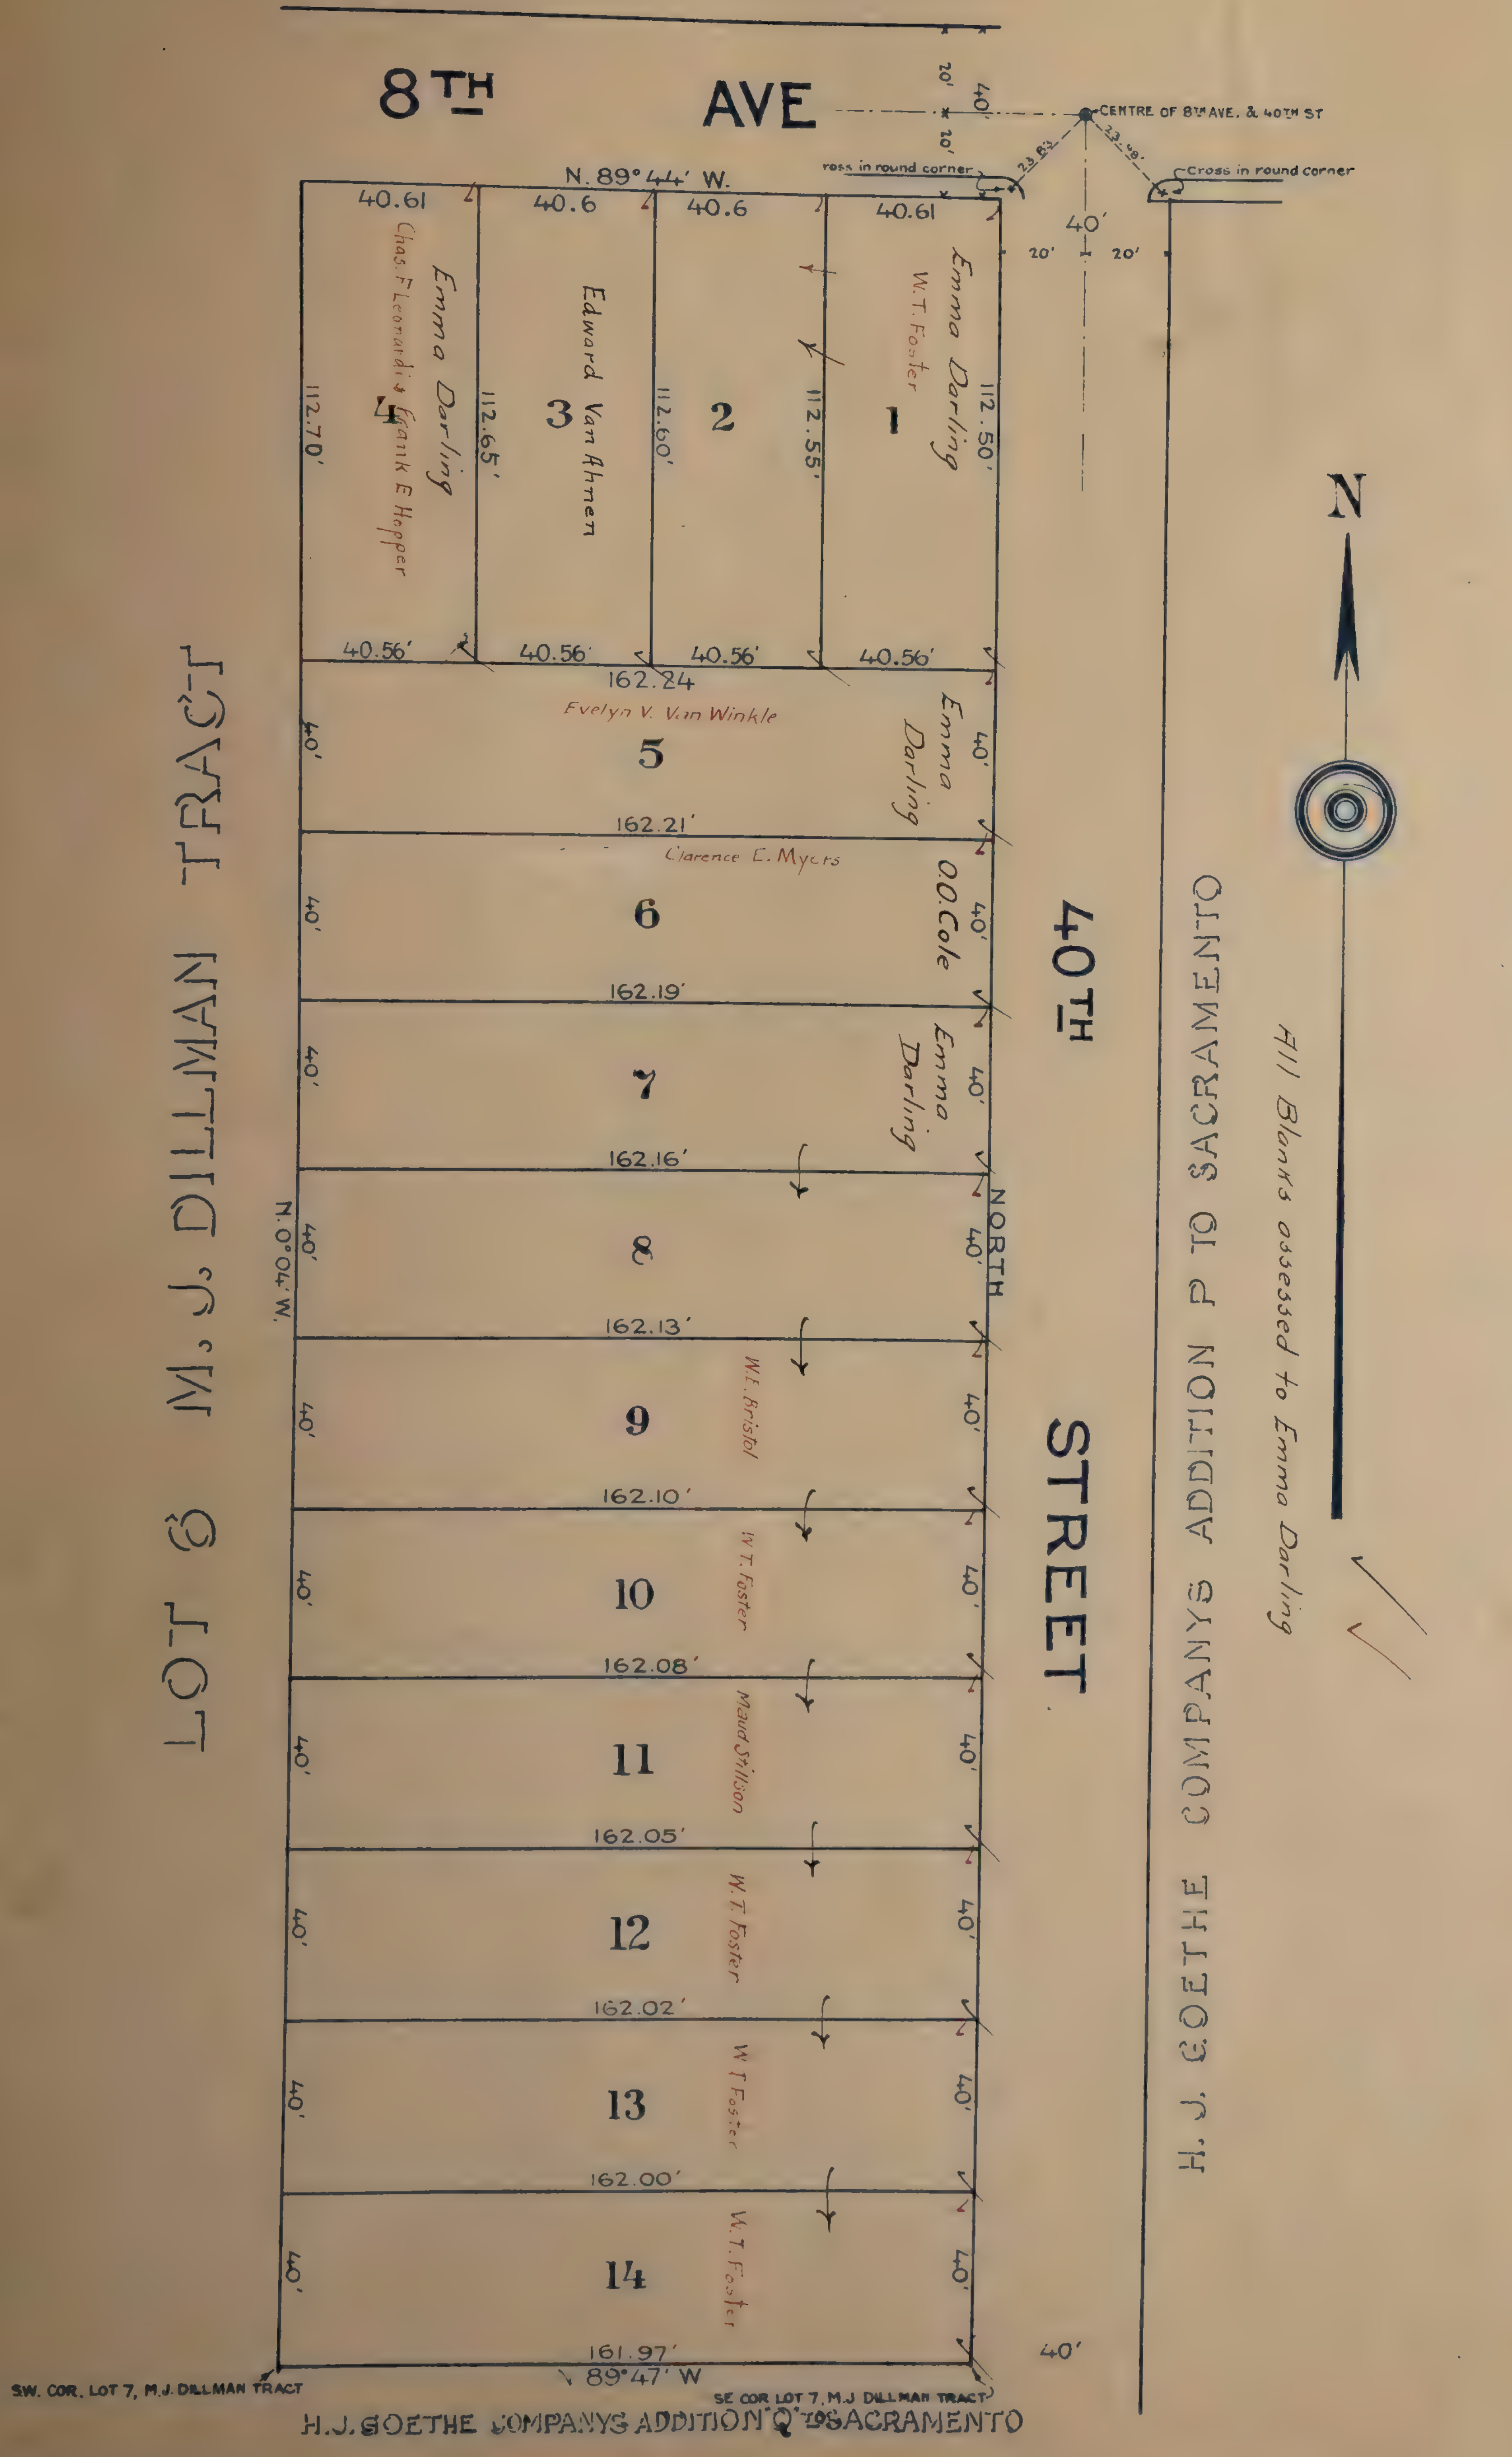
8TH AVE
40TH STREET
N
CENTRE OF 8TH AVE. & 40TH ST
Cross in round corner
Cross in round corner
23.82
23.48
20'
40'
N. 89° 44' W.
NORTH
N. 0° 04' W.
89° 47' W
1
Emma Darling
W.T. Foster
2
3
Edward Van Ahnen
4
Emma Darling
Chas. F. Leonardi & Frank E Hopper
5
Emma Darling
Evelyn V. Van Winkle
6
O.O. Cole
Clarence E. Myers
7
Emma Darling
8
9
W.E. Bristol
10
W.T. Foster
11
Maud Stillson
12
W.T. Foster
13
W.T. Foster
14
W.T. Foster
40.61
40.6
40.6
40.61
112.50'
112.55'
112.60'
112.65'
112.70'
40.56'
162.24
162.21'
162.19'
162.16'
162.13'
162.10'
162.08'
162.05'
162.02'
162.00'
161.97'
40'
LOT 6 M. J. DILLMAN TRACT
H. J. GOETHE COMPANYS ADDITION P TO SACRAMENTO
H.J. GOETHE COMPANYS ADDITION "Q" TO SACRAMENTO
SW. COR. LOT 7, M.J. DILLMAN TRACT
SE COR LOT 7, M.J. DILLMAN TRACT
All Blanks assessed to Emma Darling

LEGEND: THE LAND EMBRACED WITHIN THE BOUNDARIES OF DARLING TRACT, COMPRISES ALL OF LOT 7 AS SHOWN AND DELINEATED UPON A MAP OR PLAT, ENTITLED "AMENDED MAP OF M.J. DILLMAN TRACT, SUBDIVISION № 1, AS FILED IN THE OFFICE OF THE COUNTY RECORDER OF SACRAMENTO COUNTY AND RECORDED IN BOOK № 3 OF MAPS AT MAP 11, SACRAMENTO COUNTY RECORDS.

STATE OF CALIFORNIA }
CITY OF SACRAMENTO } S.S.

I, L.P. WILLIAMS, COUNTY AUDITOR OF SACRAMENTO COUNTY, STATE OF CALIFORNIA, DO HEREBY CERTIFY THAT THERE ARE NO LIENS FOR UNPAID STATE, COUNTY, OR OTHER TAXES EXCEPT TAXES NOT YET PAYABLE AGAINST THAT TRACT OF LAND KNOWN AS "DARLING TRACT".

IN WITNESS WHEREOF I HAVE HEREUNTO SET MY HAND AND AFFIXED MY OFFICIAL SEAL THIS 6 DAY OF JUNE IN THE YEAR 1923

L. P. Williams By A. S. Rodda Deputy
COUNTY AUDITOR OF THE COUNTY OF SACRAMENTO, STATE OF CALIFORNIA

STATE OF CALIFORNIA }
CITY OF SACRAMENTO } S.S.

I, CITY CONTROLLER OF SACRAMENTO CITY, STATE OF CALIFORNIA, DO HEREBY CERTIFY THAT THERE ARE NO LIENS FOR UNPAID MUNICIPAL TAXES, EXCEPT TAXES NOT YET PAYABLE AGAINST THAT OR SUBDIVISION OF LAND KNOWN AS DARLING TRACT.

IN WITNESS WHEREOF, I HAVE HEREUNTO SET ~~MY HAND~~ AND AFFIXED MY OFFICIAL SEAL THIS 6 DAY OF June IN THE YEAR 1923.

Craig de Saulés
CITY CONTROLLER

STATE OF CALIFORNIA }
COUNTY OF SACRAMENTO } S.S.

WE, THE UNDERSIGNED DO HEREBY CERTIFY THAT EACH AND EVERY LOT SHOWN ON THE WITHIN MAP OF "DARLING TRACT" HAS BEEN CAREFULLY EXAMINED AS TO ITS VALUE FOR RESIDENCE OR COMMERCIAL USES, AND WE RECOMMEND THAT THE SAID MAP BE APPROVED AND ACCEPTED AS PRESENTED.

Charles. W. Mier
ASSESSOR-COLLECTOR OF SACRAMENTO, CALIFORNIA

Albert Givan by J. L. Tempest
CITY ENGINEER OF SACRAMENTO, CALIFORNIA.

STATE OF CALIFORNIA }
COUNTY OF SACRAMENTO } S.S

THE UNDERSIGNED Emma L. Darling DOES HEREBY CONSENT TO THE MAKING OF THIS MAP AND FILING THE SAME IN THE OFFICE OF THE COUNTY RECORDER OF SACRAMENTO COUNTY, STATE OF CALIFORNIA, AND HEREBY CERTIFIES THAT IN ORDER TO PASS CLEAR TITLE, THE CONSENT OF NO OTHER PERSON OR CORPORATION IS NECESSARY, EXCEPT AS HEREON SHOWN.

IN WITNESS WHEREOF I HAVE CAUSED THESE PRESENTS TO BE EXECUTED THIS 31st DAY OF May IN THE YEAR 1923.

Emma L. Darling
OWNER

STATE OF CALIFORNIA }
COUNTY OF SACRAMENTO } S.S.

ON THIS 31st DAY OF May IN THE YEAR 1923, BEFORE ME Rita Dorian, A NOTARY PUBLIC RESIDING AT SACRAMENTO, IN THE COUNTY OF SACRAMENTO, DULY COMMISSIONED AND SWORN, PERSONALLY APPEARED Emma L. Darling KNOWN TO ME TO BE THE PERSON WHOSE NAME IS SUBSCRIBED TO THE WITHIN INSTRUMENT, AND ACKNOWLEDGED TO ME THAT she EXECUTED THE SAME.

IN WITNESS WHEREOF, I HAVE HEREUNTO SET MY HAND AND AFFIXED MY OFFICIAL SEAL, AT MY OFFICE IN SAID CITY AND COUNTY, THE DAY AND THE YEAR IN THIS CERTIFICATE FIRST ABOVE WRITTEN.

Rita Dorian
NOTARY PUBLIC

STATE OF CALIFORNIA }
COUNTY OF SACRAMENTO } S.S.

THE CITY COUNCIL OF THE CITY OF SACRAMENTO, STATE OF CALIFORNIA, HAS, BY RESOLUTION DULY AND REGULARLY PASSED BY SAID COUNCIL ON THIS 14 DAY OF June IN THE YEAR 1923, ACCEPTED AND APPROVED THIS PLAT.

M.J. DILLMAN SUB. No 1.

Scale: 1 Inch = 160 feet.

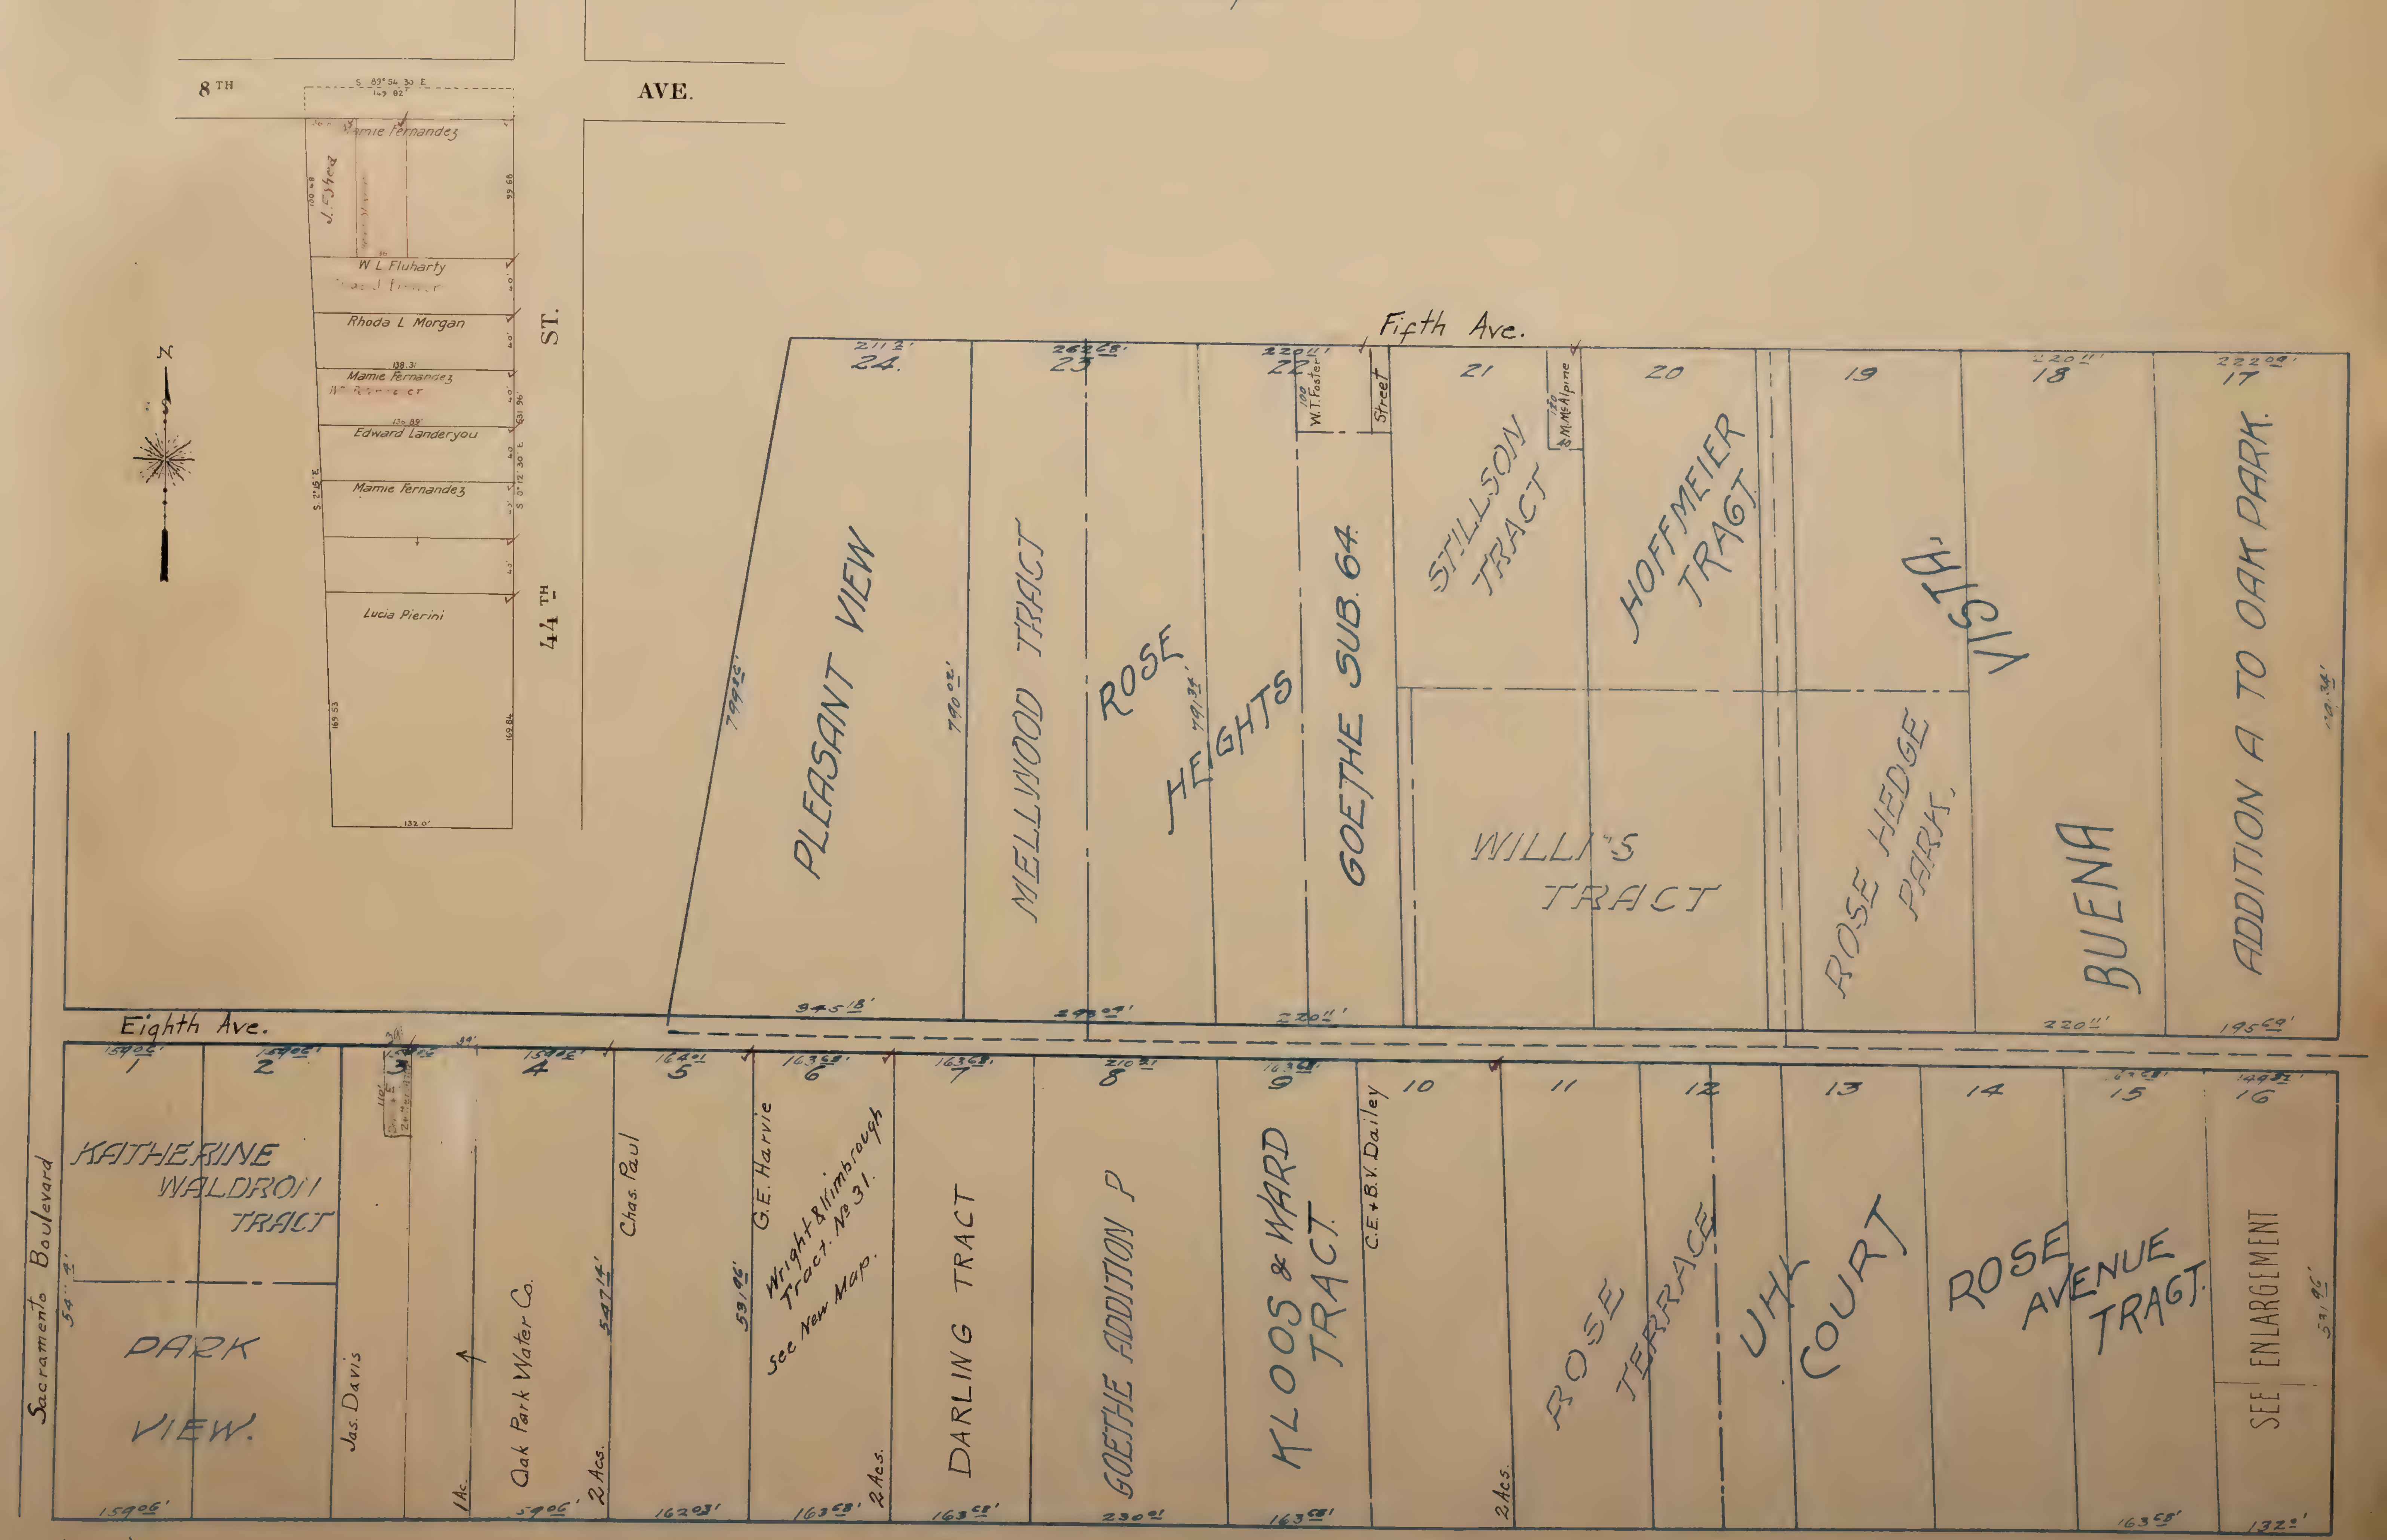
LOT 16
Scale: 1 100'
8TH AVE.
44TH ST.
S. 89° 54' 30" E
149.82'
Mamie Fernandez
J. Fisher
100.48
99.68
W. L. Fluharty
Rhoda L. Morgan
138.31
Mamie Fernandez
136.89'
Edward Landeryou
Mamie Fernandez
Lucia Pierini
S. 2° 15' E
S. 0° 12' 30" E
631.96'
40'
169.53
169.84
132.0'
N
Fifth Ave.
Eighth Ave.
Sacramento Boulevard
24.
23
22
21
20
19
18
17
211.2'
262.68'
220.11'
220.11'
222.09'
PLEASANT VIEW
799.85'
MELLWOOD TRACT
790.02'
ROSE HEIGHTS
791.34'
100 W. T. Foster
Street
GOETHE SUB. 64.
STILLSON TRACT
120 M. McAlpine
HOFFMEIER TRAGT.
WILLI'S TRACT
ROSE HEDGE PARK.
BUENA VISTA.
ADDITION A TO OAK PARK.
790.34'
945.18'
290.09'
220.11'
220.11'
195.69'
1
2
3
4
5
6
7
8
9
10
11
12
13
14
15
16
159.06'
159.06'
39'
159.06'
164.01
163.68'
163.68'
210.21
163.68'
149.82'
KATHERINE WALDRON TRACT
PARK VIEW.
54.4'
Jas. Davis
1 Ac.
Oak Park Water Co.
2 Acs.
547.14'
Chas. Paul
G. E. Harvie
531.96'
Wright & Kimbrough Tract. No 31.
See New Map.
2 Acs.
DARLING TRACT
GOETHE ADDITION P
KLOOS & WARD TRACT.
C.E. + B.V. Dailey
2 Acs.
ROSE TERRACE
UHL COURT
ROSE AVENUE TRAGT.
SEE ENLARGEMENT
531.96'
159.06'
159.06'
162.03'
163.68'
163.68'
230.01
163.68'
163.68'
132.0'

M.J. DILLMAN SUB. No 2. ✓

Scale: 1 Inch = 160 feet.

E ½ LOT 3

Scale 1" = 100'

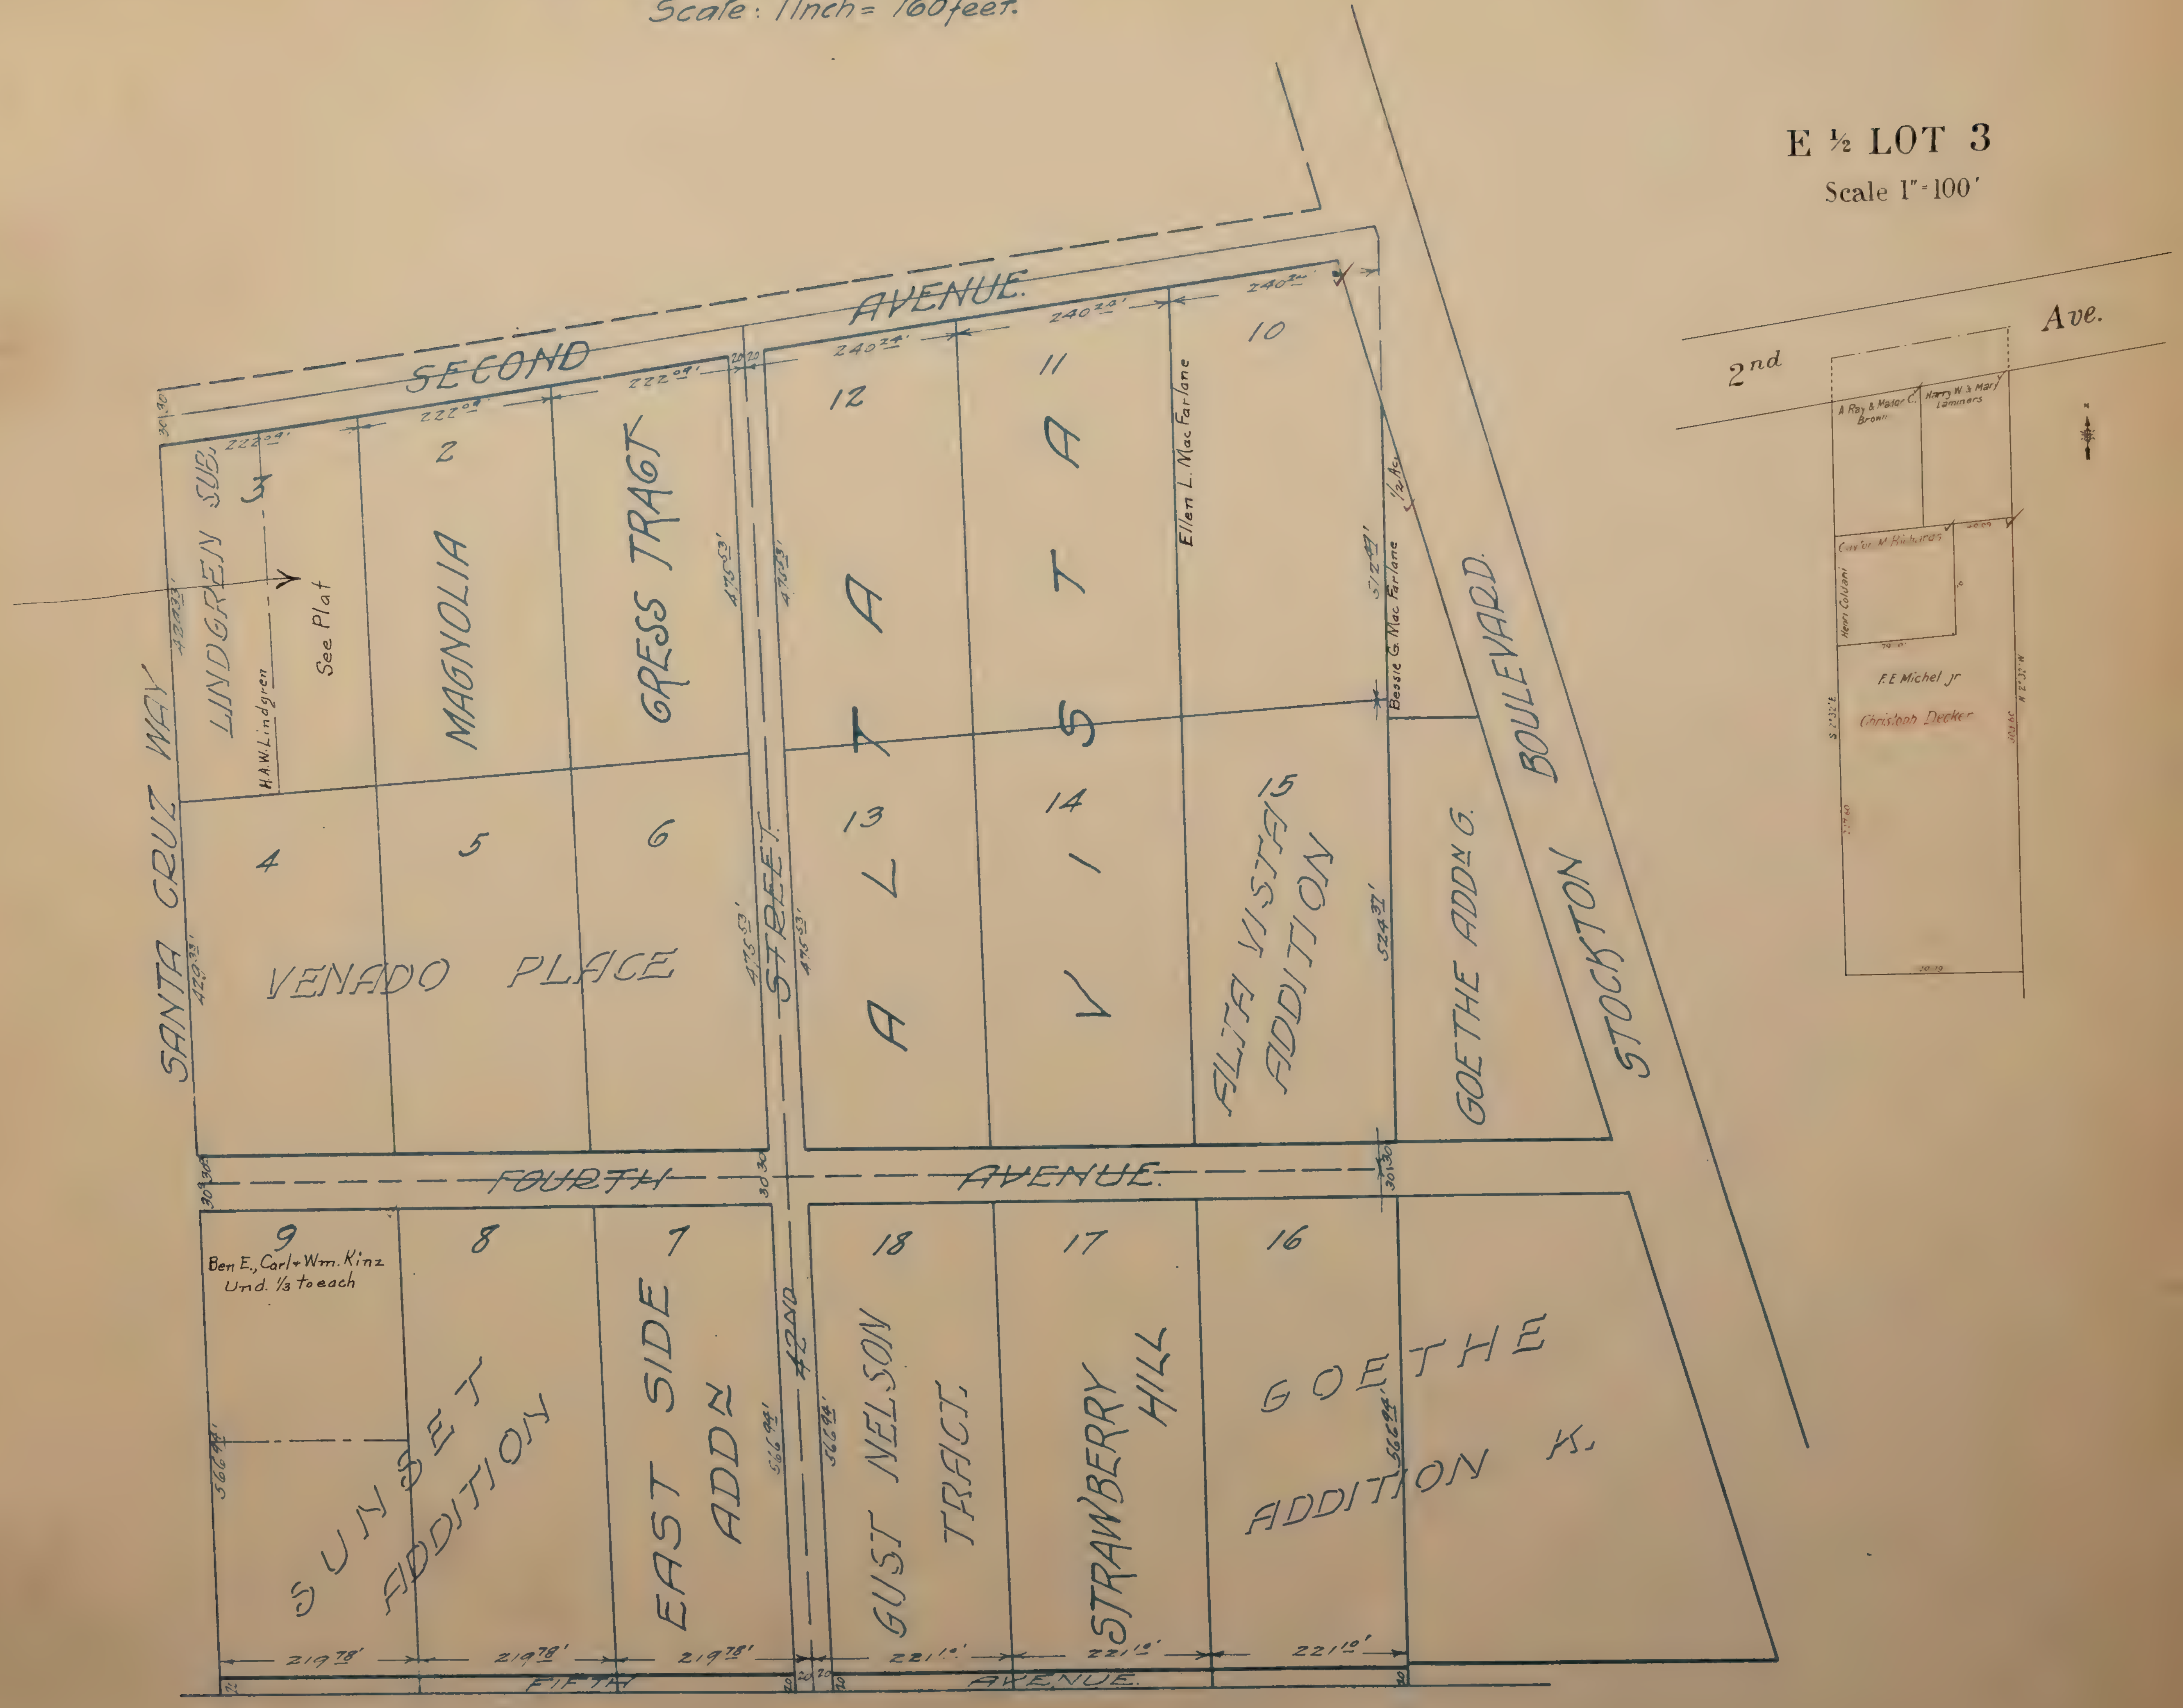
SECOND AVENUE
SANTA CRUZ WAY
1
2
3
222.09'
222.09'
222.09'
LINDGREN SUB.
See Plat
H.A.W. Lindgren
MAGNOLIA
GRESS TRACT
475.53'
4
5
6
VENADO PLACE
STREET
THIRD
12
11
10
240.34'
240.20'
240.xx
ALTA VISTA
Ellen L. Mac Farlane
Bessie G. Mac Farlane
512.41'
524.31'
13
14
15
ALTA VISTA ADDITION
GOETHE ADDN G.
STOCKTON BOULEVARD
FOURTH AVENUE
9
Ben E., Carl + Wm. Kinz
Und. 1/3 to each
8
7
SUNSET ADDITION
EAST SIDE ADDN
566.94'
18
17
16
GUST NELSON TRACT.
STRAWBERRY HILL
GOETHE ADDITION K.
219.78'
219.78'
219.78'
221.10'
221.10'
221.10'
FIFTH AVENUE
30
20
2nd Ave.
A Ray & Mador C. Brown
Harry W. & Mary Laminers
Caylor M Richards
Henri Coldani
79.0'
F.E Michel jr
Christoph Decker
S 2°32' E
N 2°32' W
309.60
227.60
N

EAST AVENUE TRACT ✓✓

Scale: 1 Inch = 40 feet.

NOTE: Comprises Lots 2678 & 2679 of Oak Terrace.

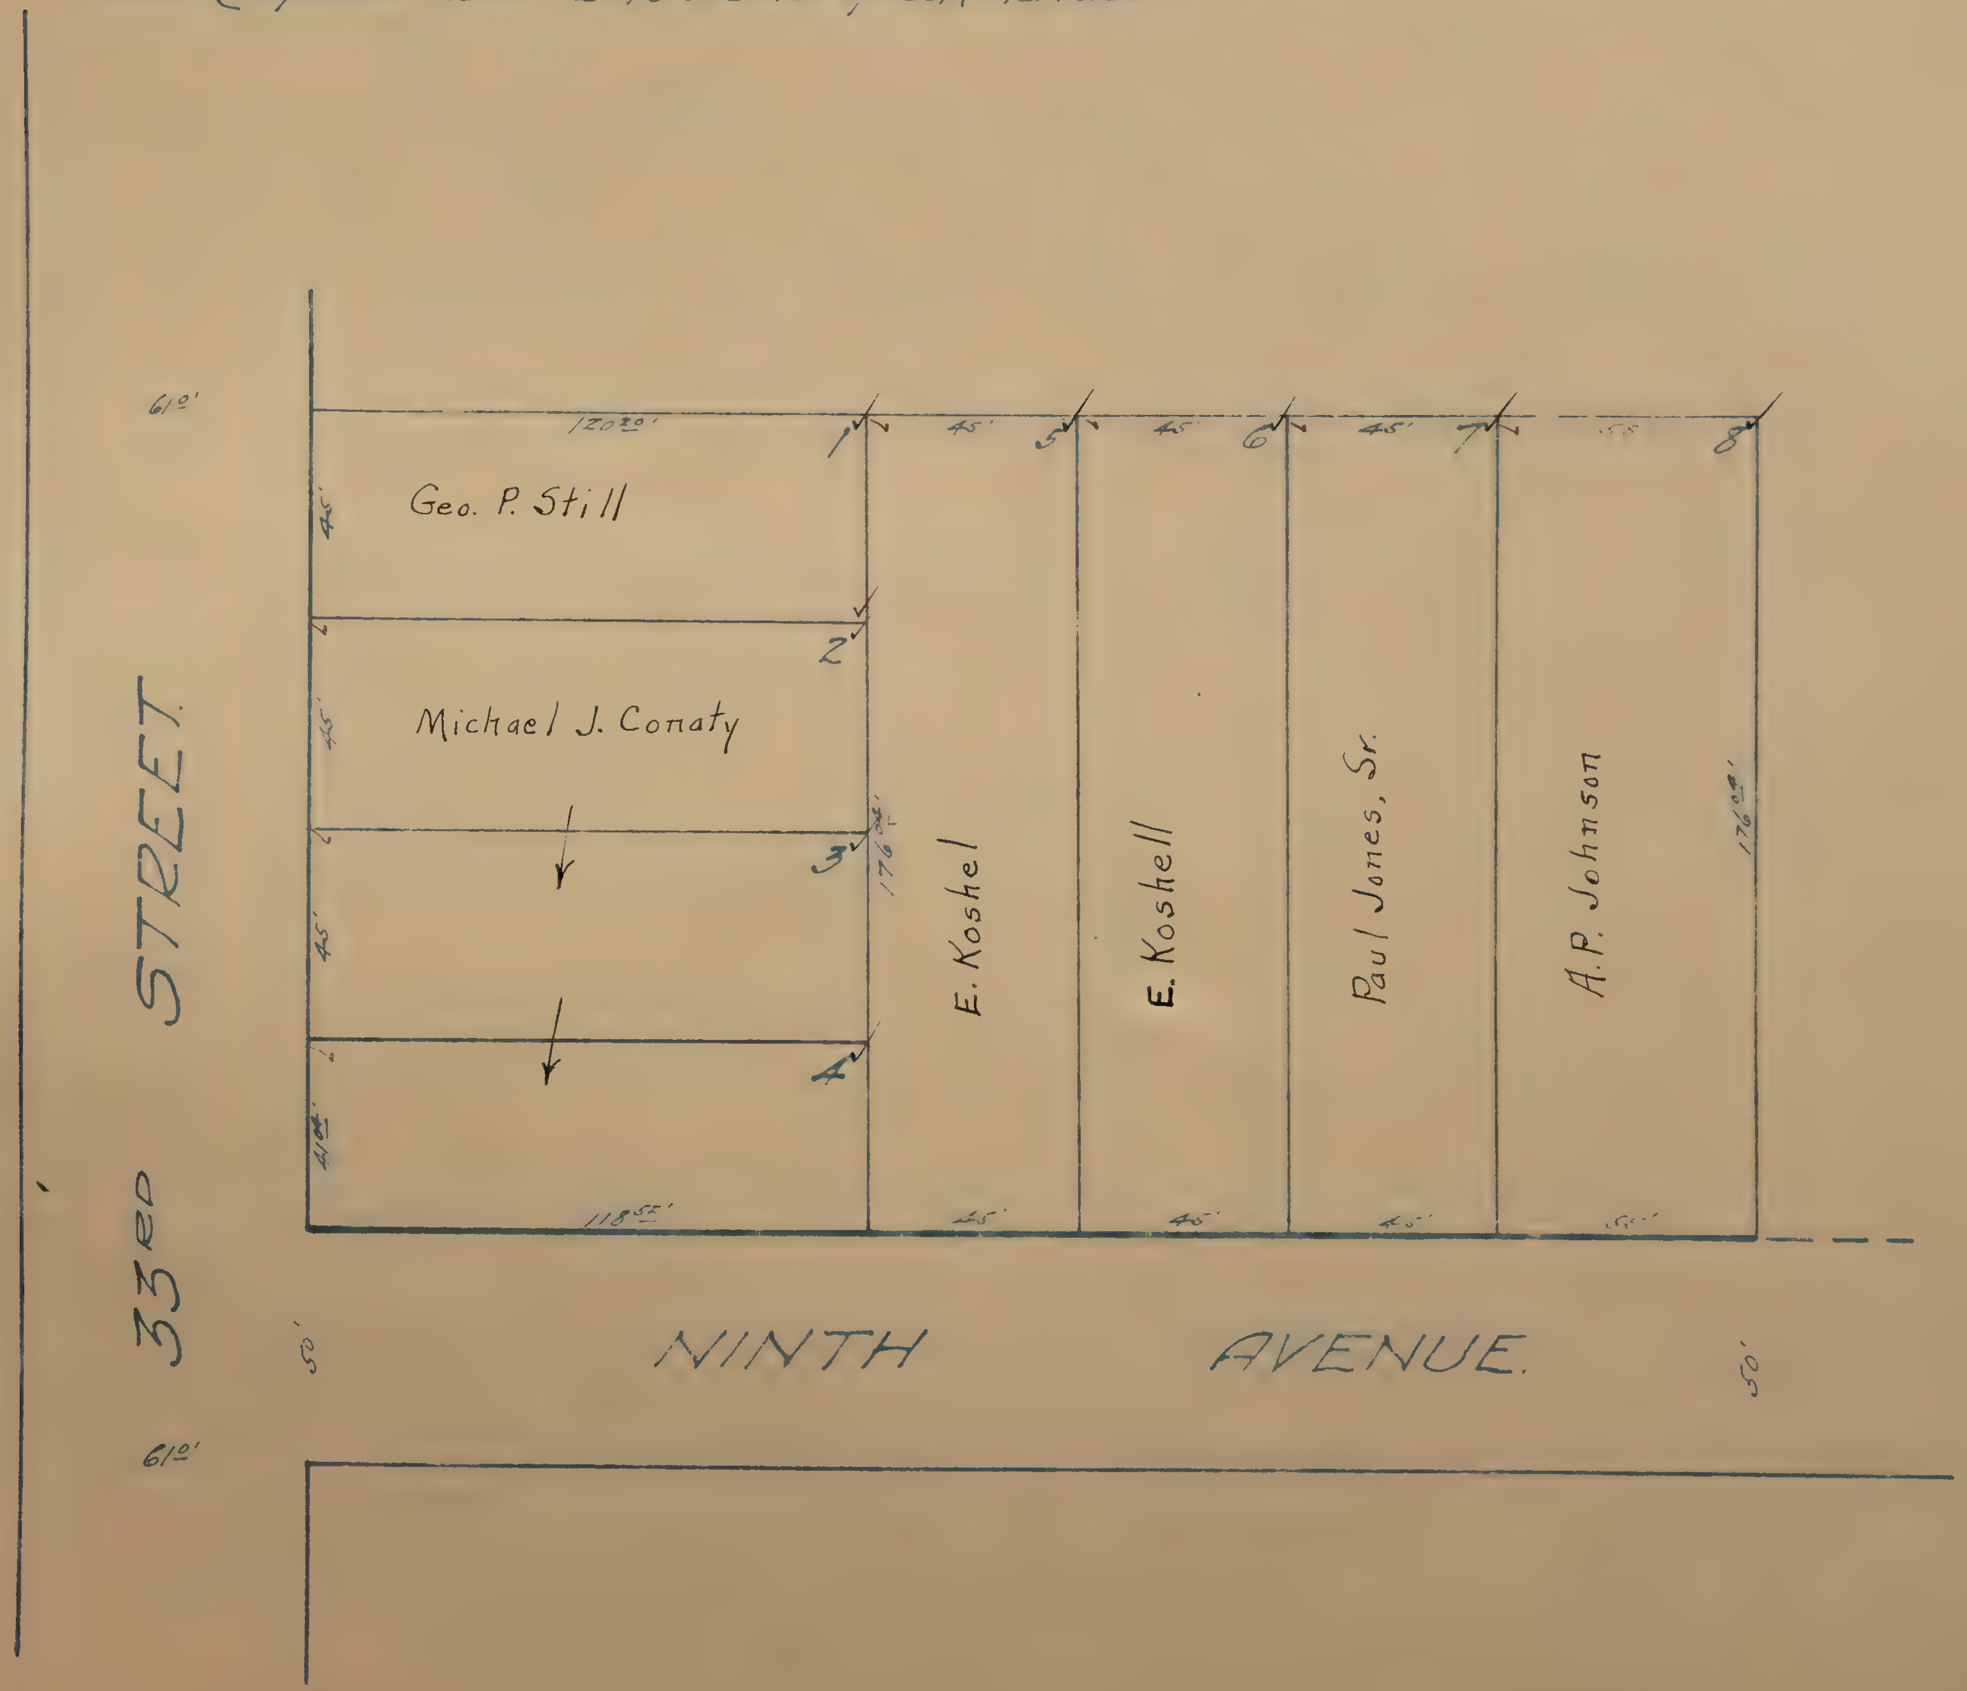
61^{0}'
120^{20}'
1
45'
5
45'
6
45'
7
55'
8
Geo. P. Still
45'
2
Michael J. Conaty
45'
3
176^{04}'
45'
4
41^{00}'
118^{55}'
45'
45'
45'
55'
E. Koshel
E. Koshell
Paul Jones, Sr.
A.P. Johnson
176^{04}'
33RD STREET
NINTH AVENUE.
50'
50'
61^{0}'

East Ave.

EASTEND ADDITION ✓

Scale: 1 Inch = 40 feet.

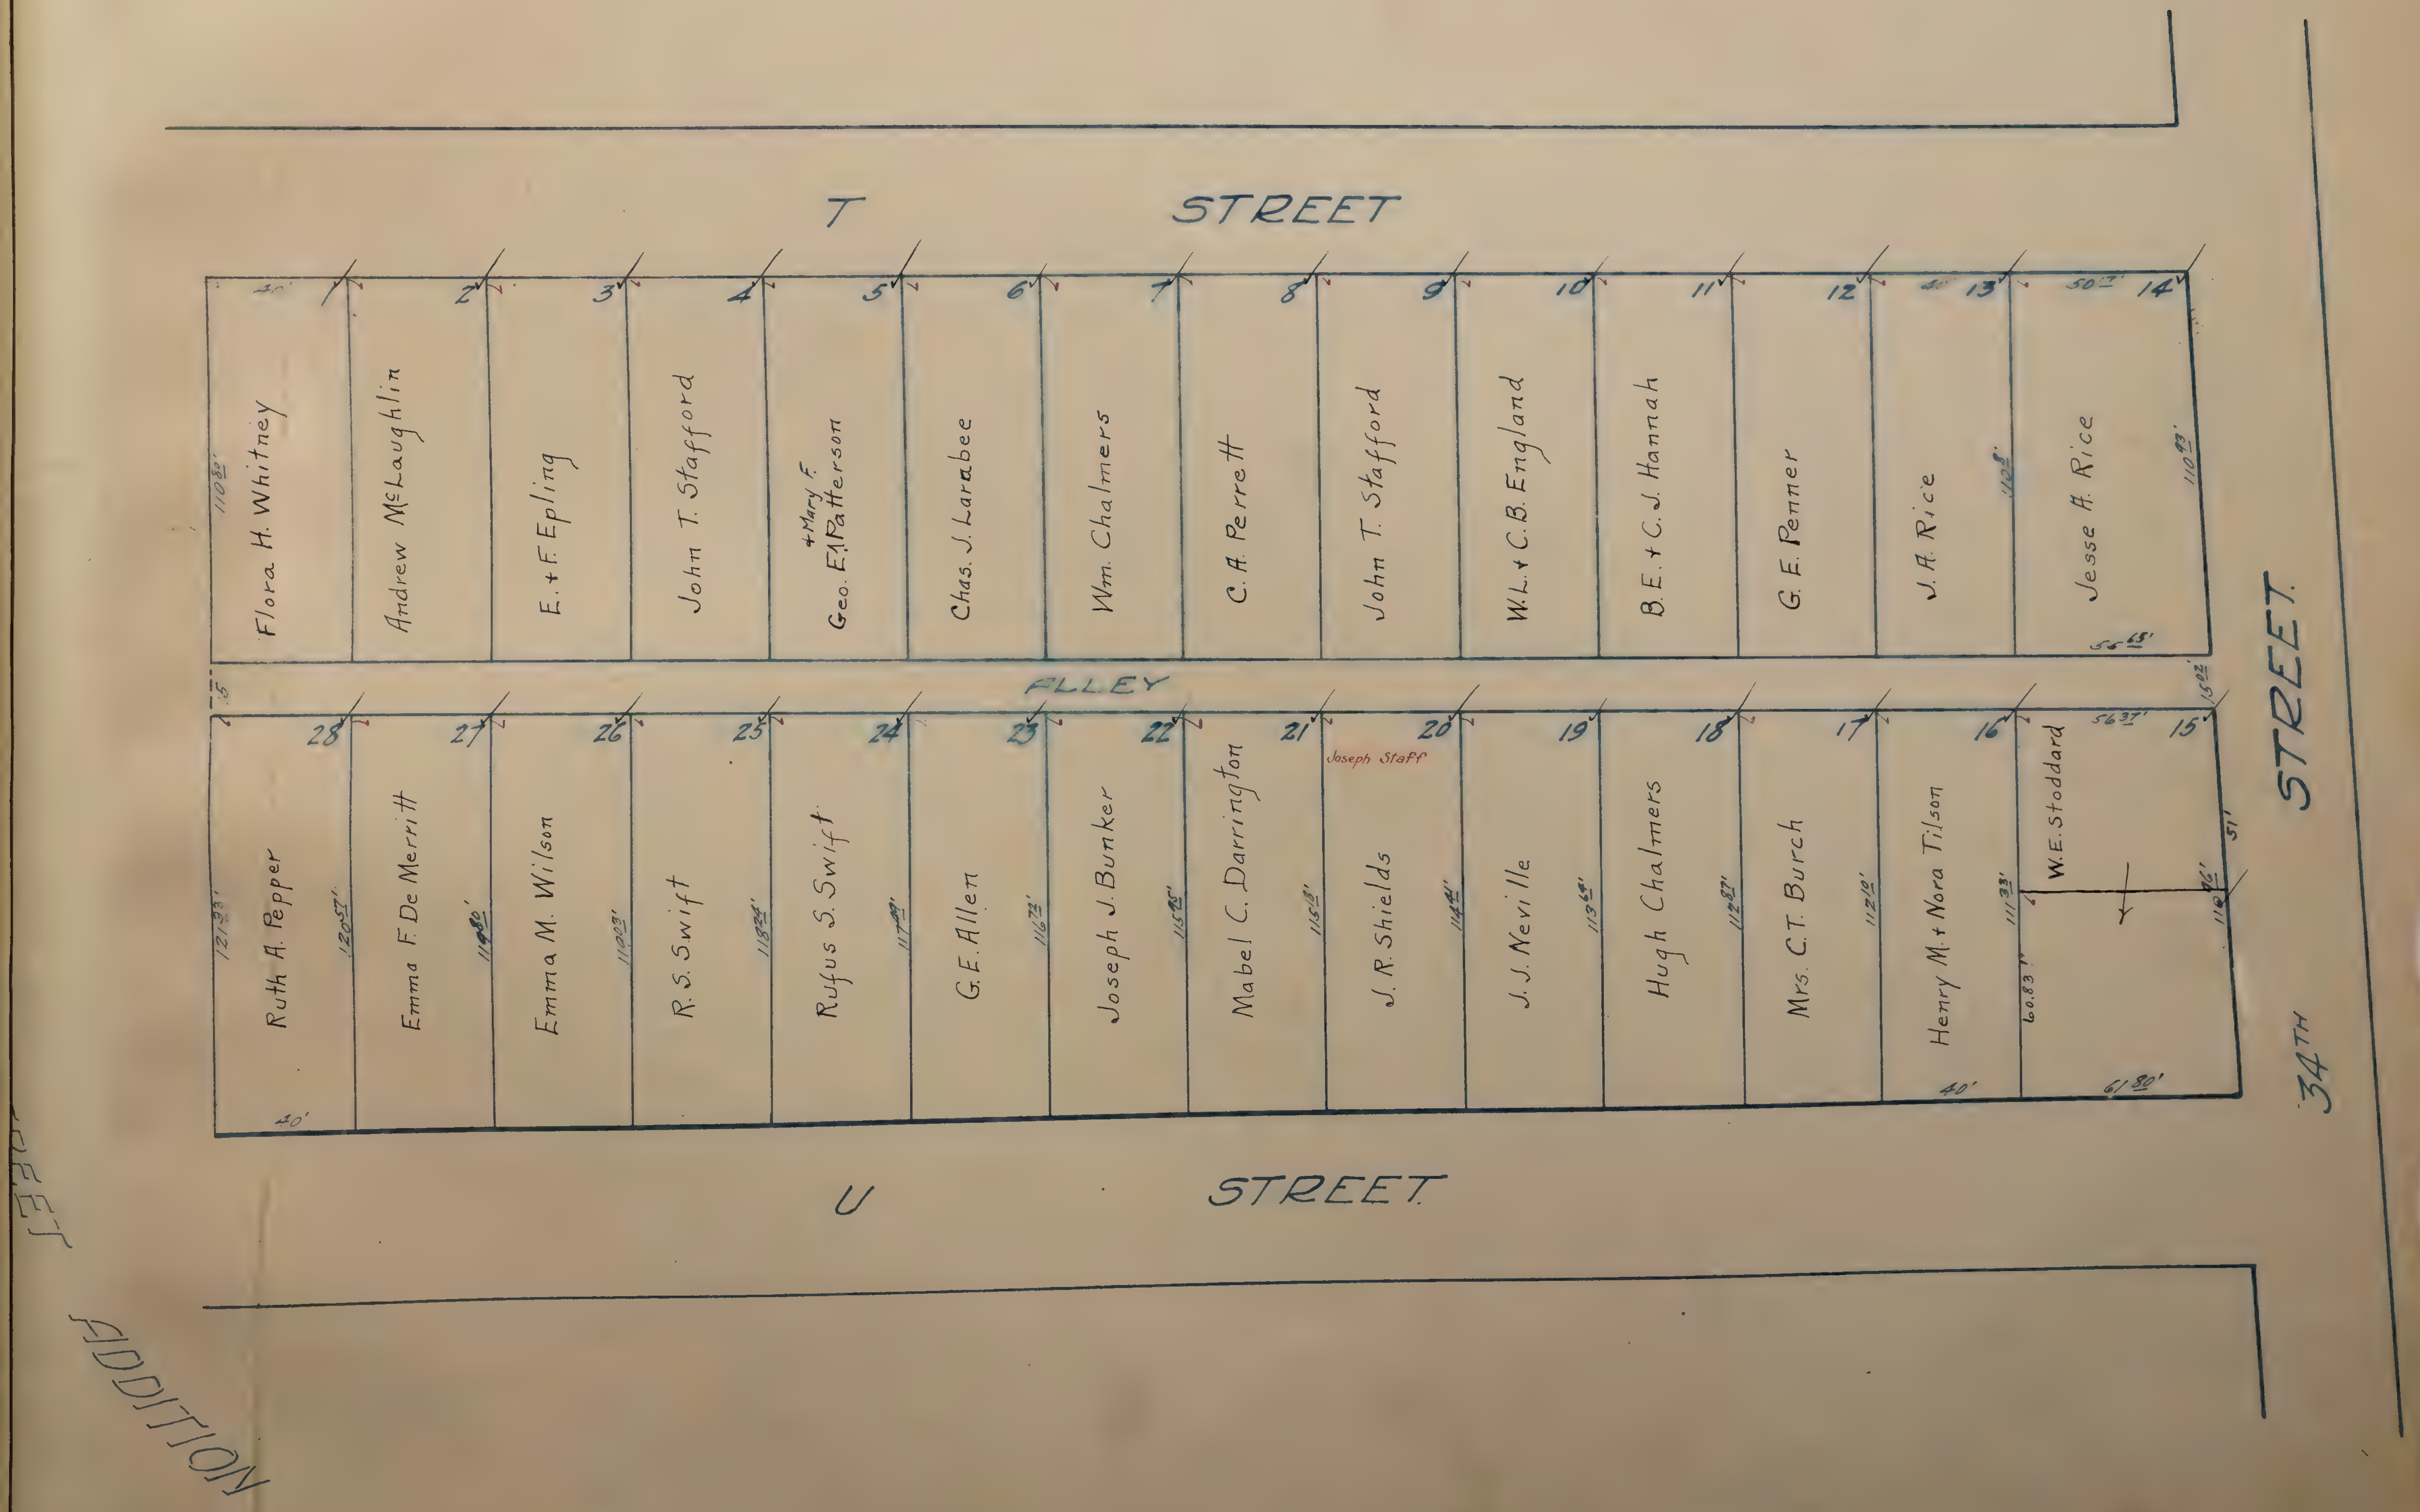
T STREET
U STREET
34TH STREET
ALLEY
REET ADDITION
1
Flora H. Whitney
40'
11080'
2
Andrew McLaughlin
3
E. + F. Epling
4
John T. Stafford
5
+Mary F.
Geo. E. Patterson
6
Chas. J. Larabee
7
Wm. Chalmers
8
C. A. Perrett
9
John T. Stafford
10
W.L. + C.B. England
11
B.E. + C.J. Hannah
12
G. E. Penner
13
40'
J. A. Rice
1108'
14
50 17'
Jesse A. Rice
11093'
55 65'
15
1502'
28
Ruth A. Pepper
12133'
12057'
40'
27
Emma F. De Merritt
11980'
26
Emma M. Wilson
11003'
25
R. S. Swift
11824'
24
Rufus S. Swift
117 59'
23
G. E. Allen
11672'
22
Joseph J. Bunker
11525'
21
Mabel C. Darrington
11518'
20
Joseph Staff
J. R. Shields
11441'
19
J. J. Neville
11364'
18
Hugh Chalmers
11287'
17
Mrs. C. T. Burch
11210'
16
Henry M. + Nora Tilson
40'
11133'
60.83'
W. E. Stoddard
5637'
51'
110 76'
6180'
15

6

EASTMONT

SCALE 80'=1"

Blanks to Hickman-Jones + Brand

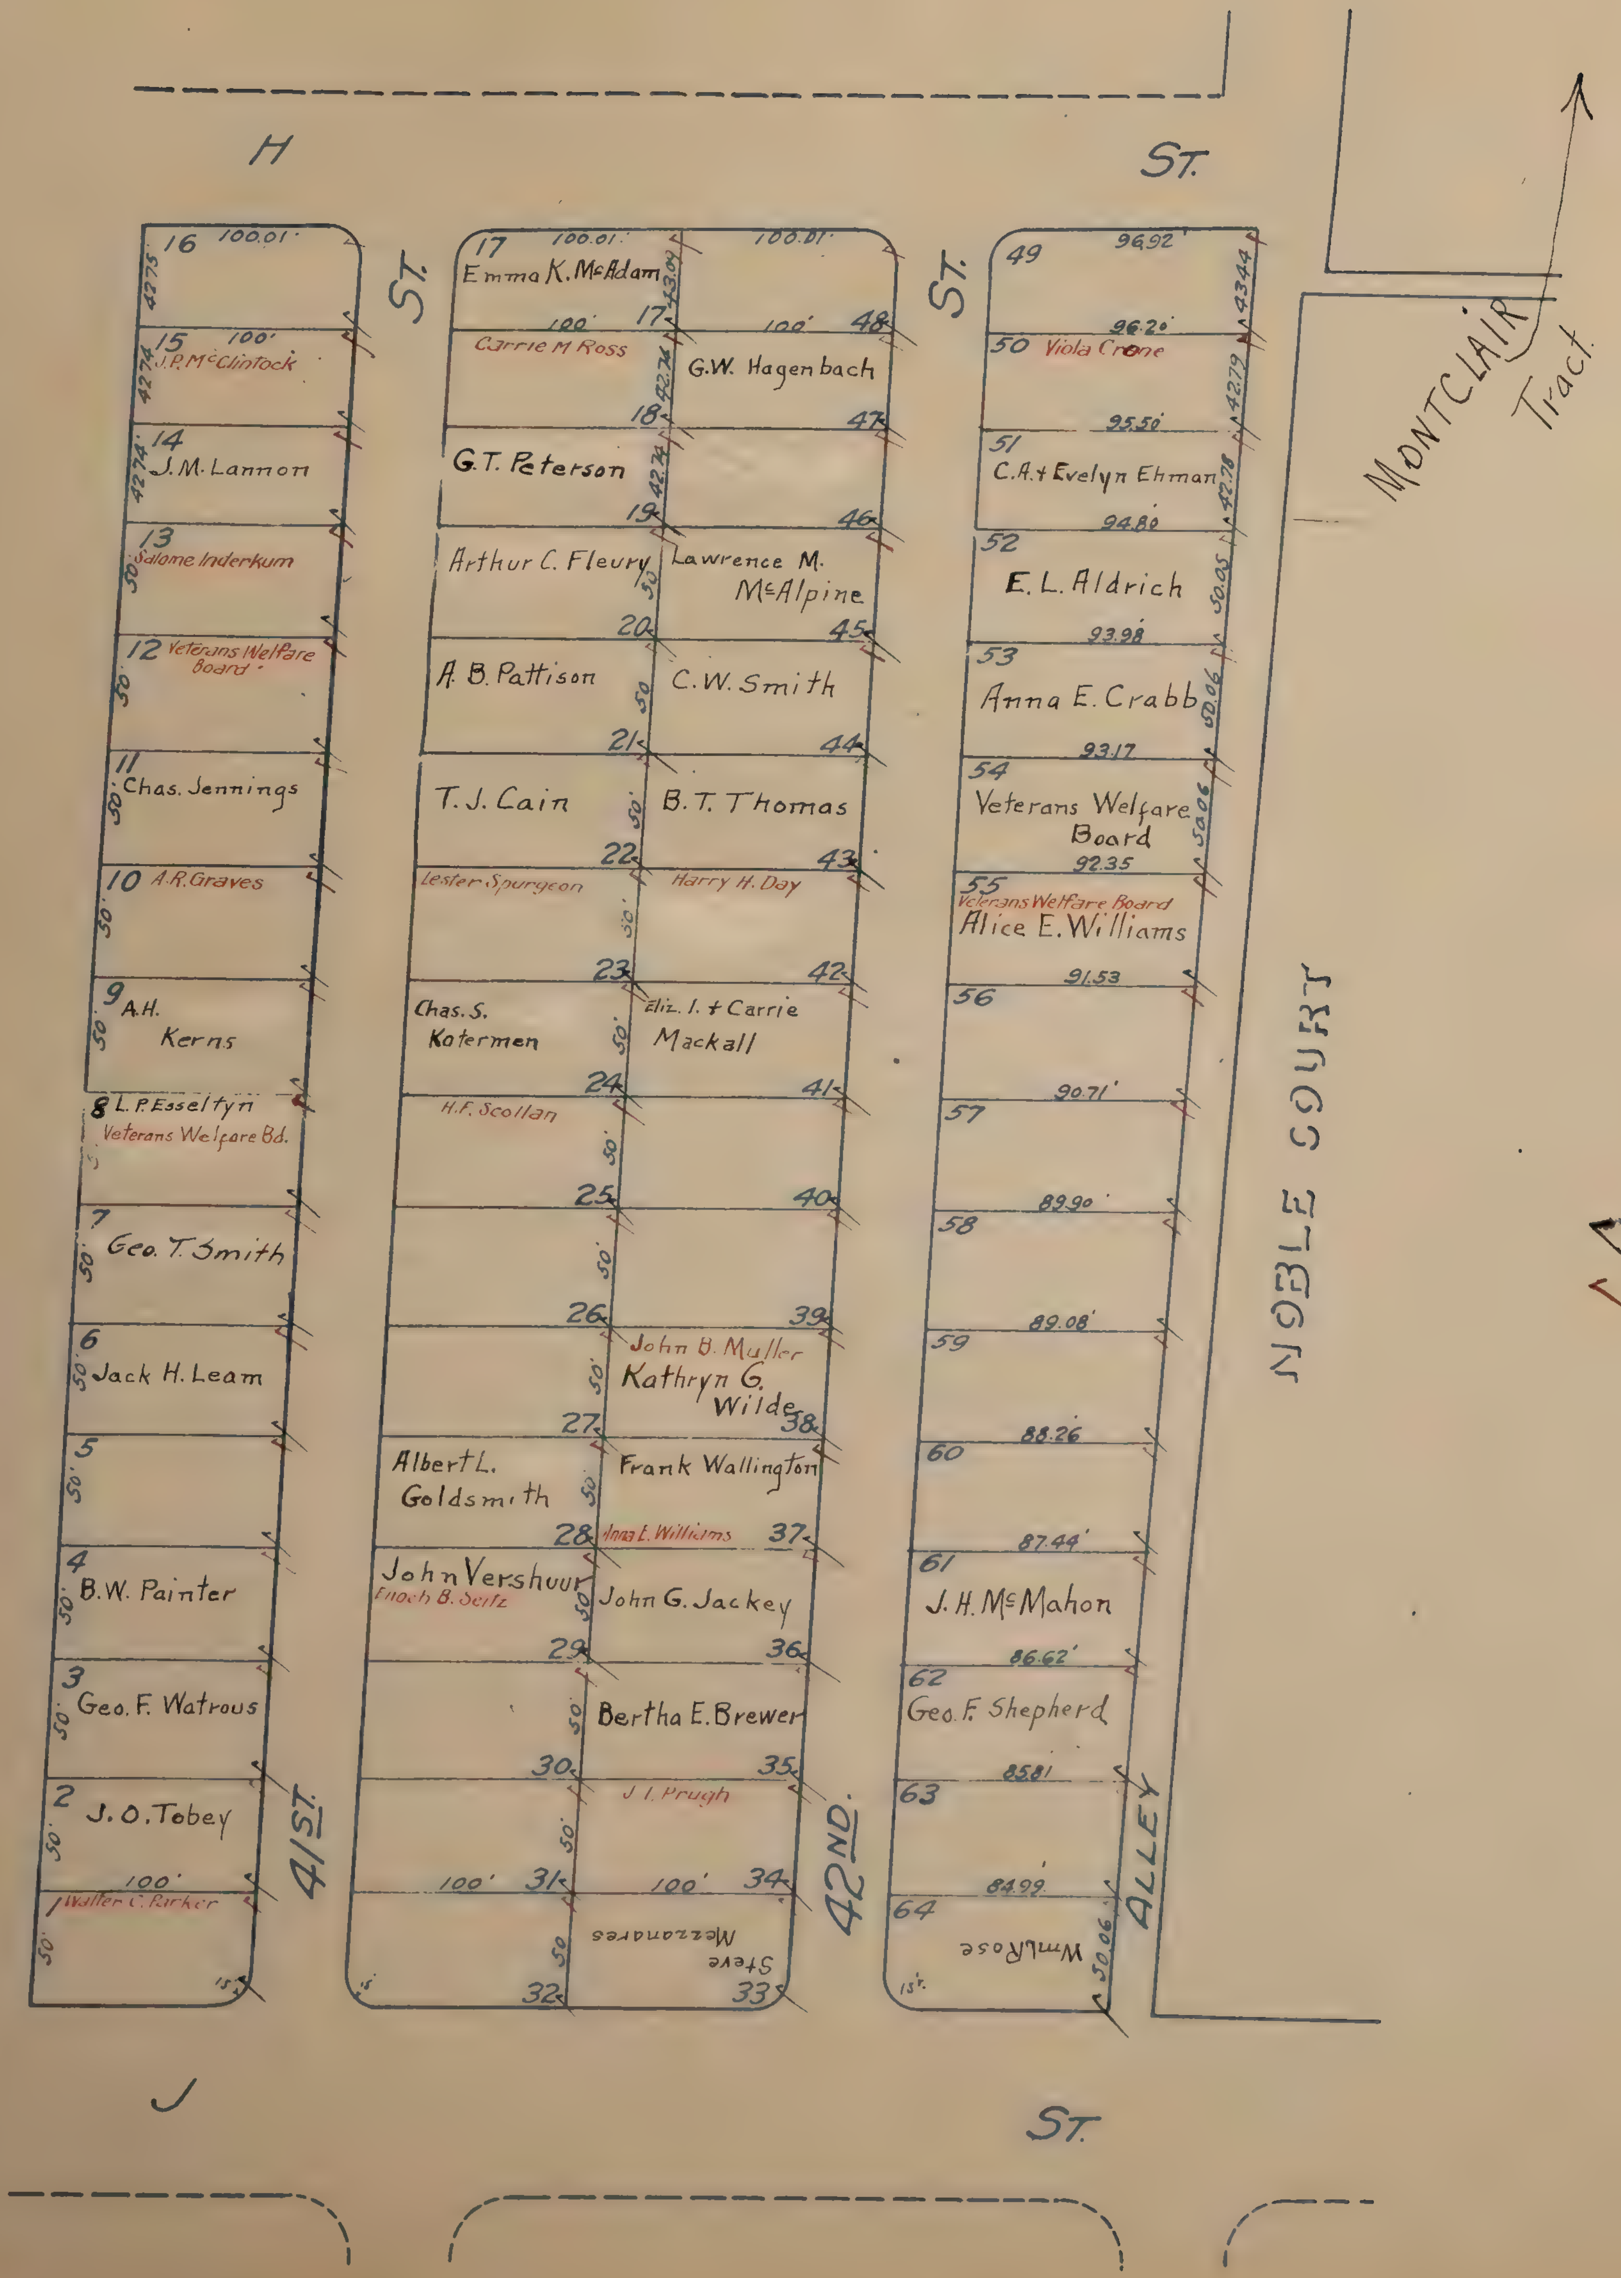
H ST.
J ST.
41ST
42ND.
ALLEY
NOBLE COURT
MONTCLAIR Tract
16 100.01'
15 100' J.R. McClintock
14 J.M. Lannon
13 Salome Inderkum
12 Veterans Welfare Board
11 Chas. Jennings
10 A.R. Graves
9 A.H. Kerns
8 L.P. Esseltyn Veterans Welfare Bd.
7 Geo. T. Smith
6 Jack H. Leam
5
4 B.W. Painter
3 Geo. F. Watrous
2 J.O. Tobey
1 Walter C. Parker
17 100.01' Emma K. McAdam
100.01'
100' Carrie M Ross
18 G.T. Peterson
19 Arthur C. Fleury
20 A.B. Pattison
21 T.J. Cain
22 Lester Spurgeon
23 Chas. S. Katermen
24 H.F. Scollan
25
26
27 Albert L. Goldsmith
28 John Vershuur Enoch B. Seitz
29
30
31 100'
32
48 100' G.W. Hagenbach
47
46 Lawrence M. McAlpine
45 C.W. Smith
44 B.T. Thomas
43 Harry H. Day
42 Eliz. I. + Carrie Mackall
41
40
39 John B. Muller Kathryn G. Wilde
38 Frank Wallington
37 Anna L. Williams
36 John G. Jackey
35 Bertha E. Brewer
34 J.I. Prugh
100'
33 Steve Mezzanares
49 96.92'
50 96.20' Viola Crone
51 95.50' C.A. + Evelyn Ehman
52 94.80' E.L. Aldrich
53 93.98' Anna E. Crabb
54 93.17' Veterans Welfare Board
55 92.35' Veterans Welfare Board Alice E. Williams
56 91.53'
57 90.71'
58 89.90'
59 89.08'
60 88.26'
61 87.44' J.H. McMahon
62 86.62' Geo. F. Shepherd
63 85.81'
64 84.99' Wm. Rose
50.06
43.44
42.79
42.78
50.05
50.06
50'
15'

WRIGHT & KIMBROUGH TRACT NO. 24

Eastmont

6

EAST RIDGEWAY ✓✓

Scale: 1 Inch = 80 feet.

NOTE: Comprises the North 2.845 Ac. of Lot C of McIntyre Tract.

Blanks to G.A. White Est.

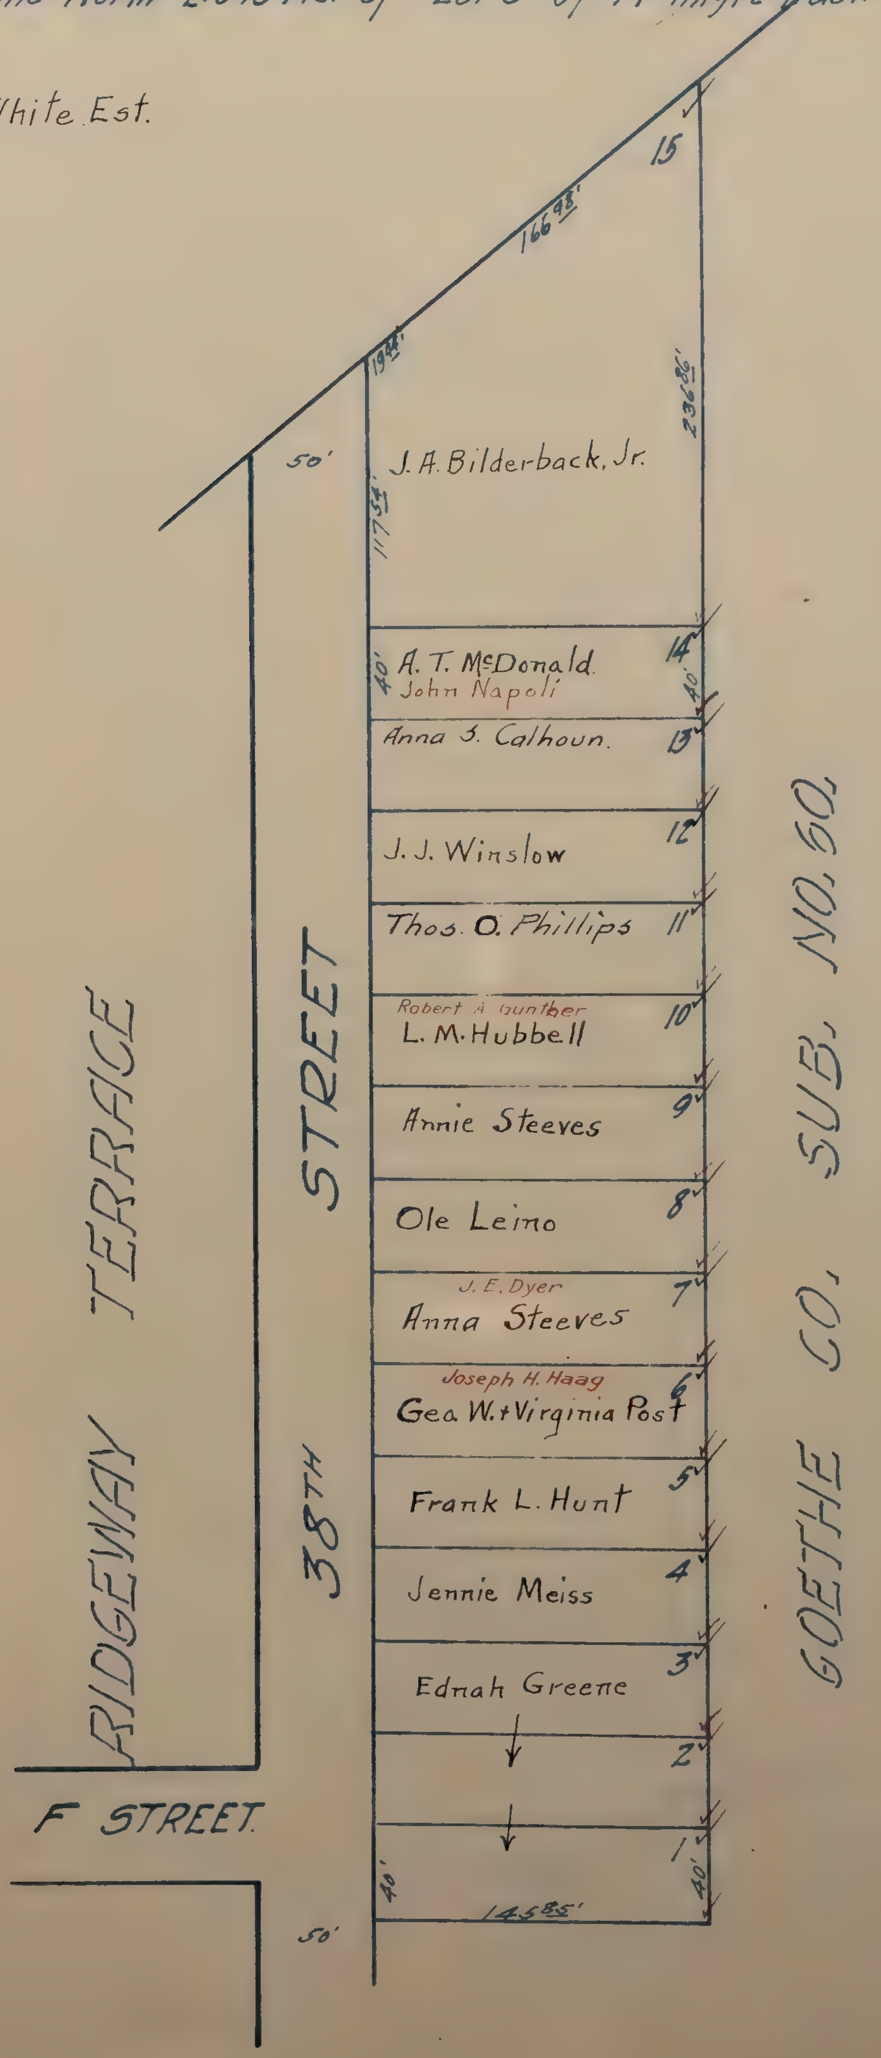

166.98'
19.44'
236.86'
50'
117.54'
15
J. A. Bilderback, Jr.
14
40'
A. T. McDonald.
John Napoli
13
Anna S. Calhoun.
12
J. J. Winslow
11
Thos. O. Phillips
10
Robert A Gunther
L. M. Hubbell
9
Annie Steeves
8
Ole Leino
7
J. E. Dyer
Anna Steeves
6
Joseph H. Haag
Geo. W. + Virginia Post
5
Frank L. Hunt
4
Jennie Meiss
3
Ednah Greene
2
1
40'
145.85'
50'
RIDGEWAY TERRACE
38TH STREET
F STREET
GOETHE CO. SUB. NO. 50.

6

EAST SACRAMENTO

Scale: 1 Inch = 80 feet.

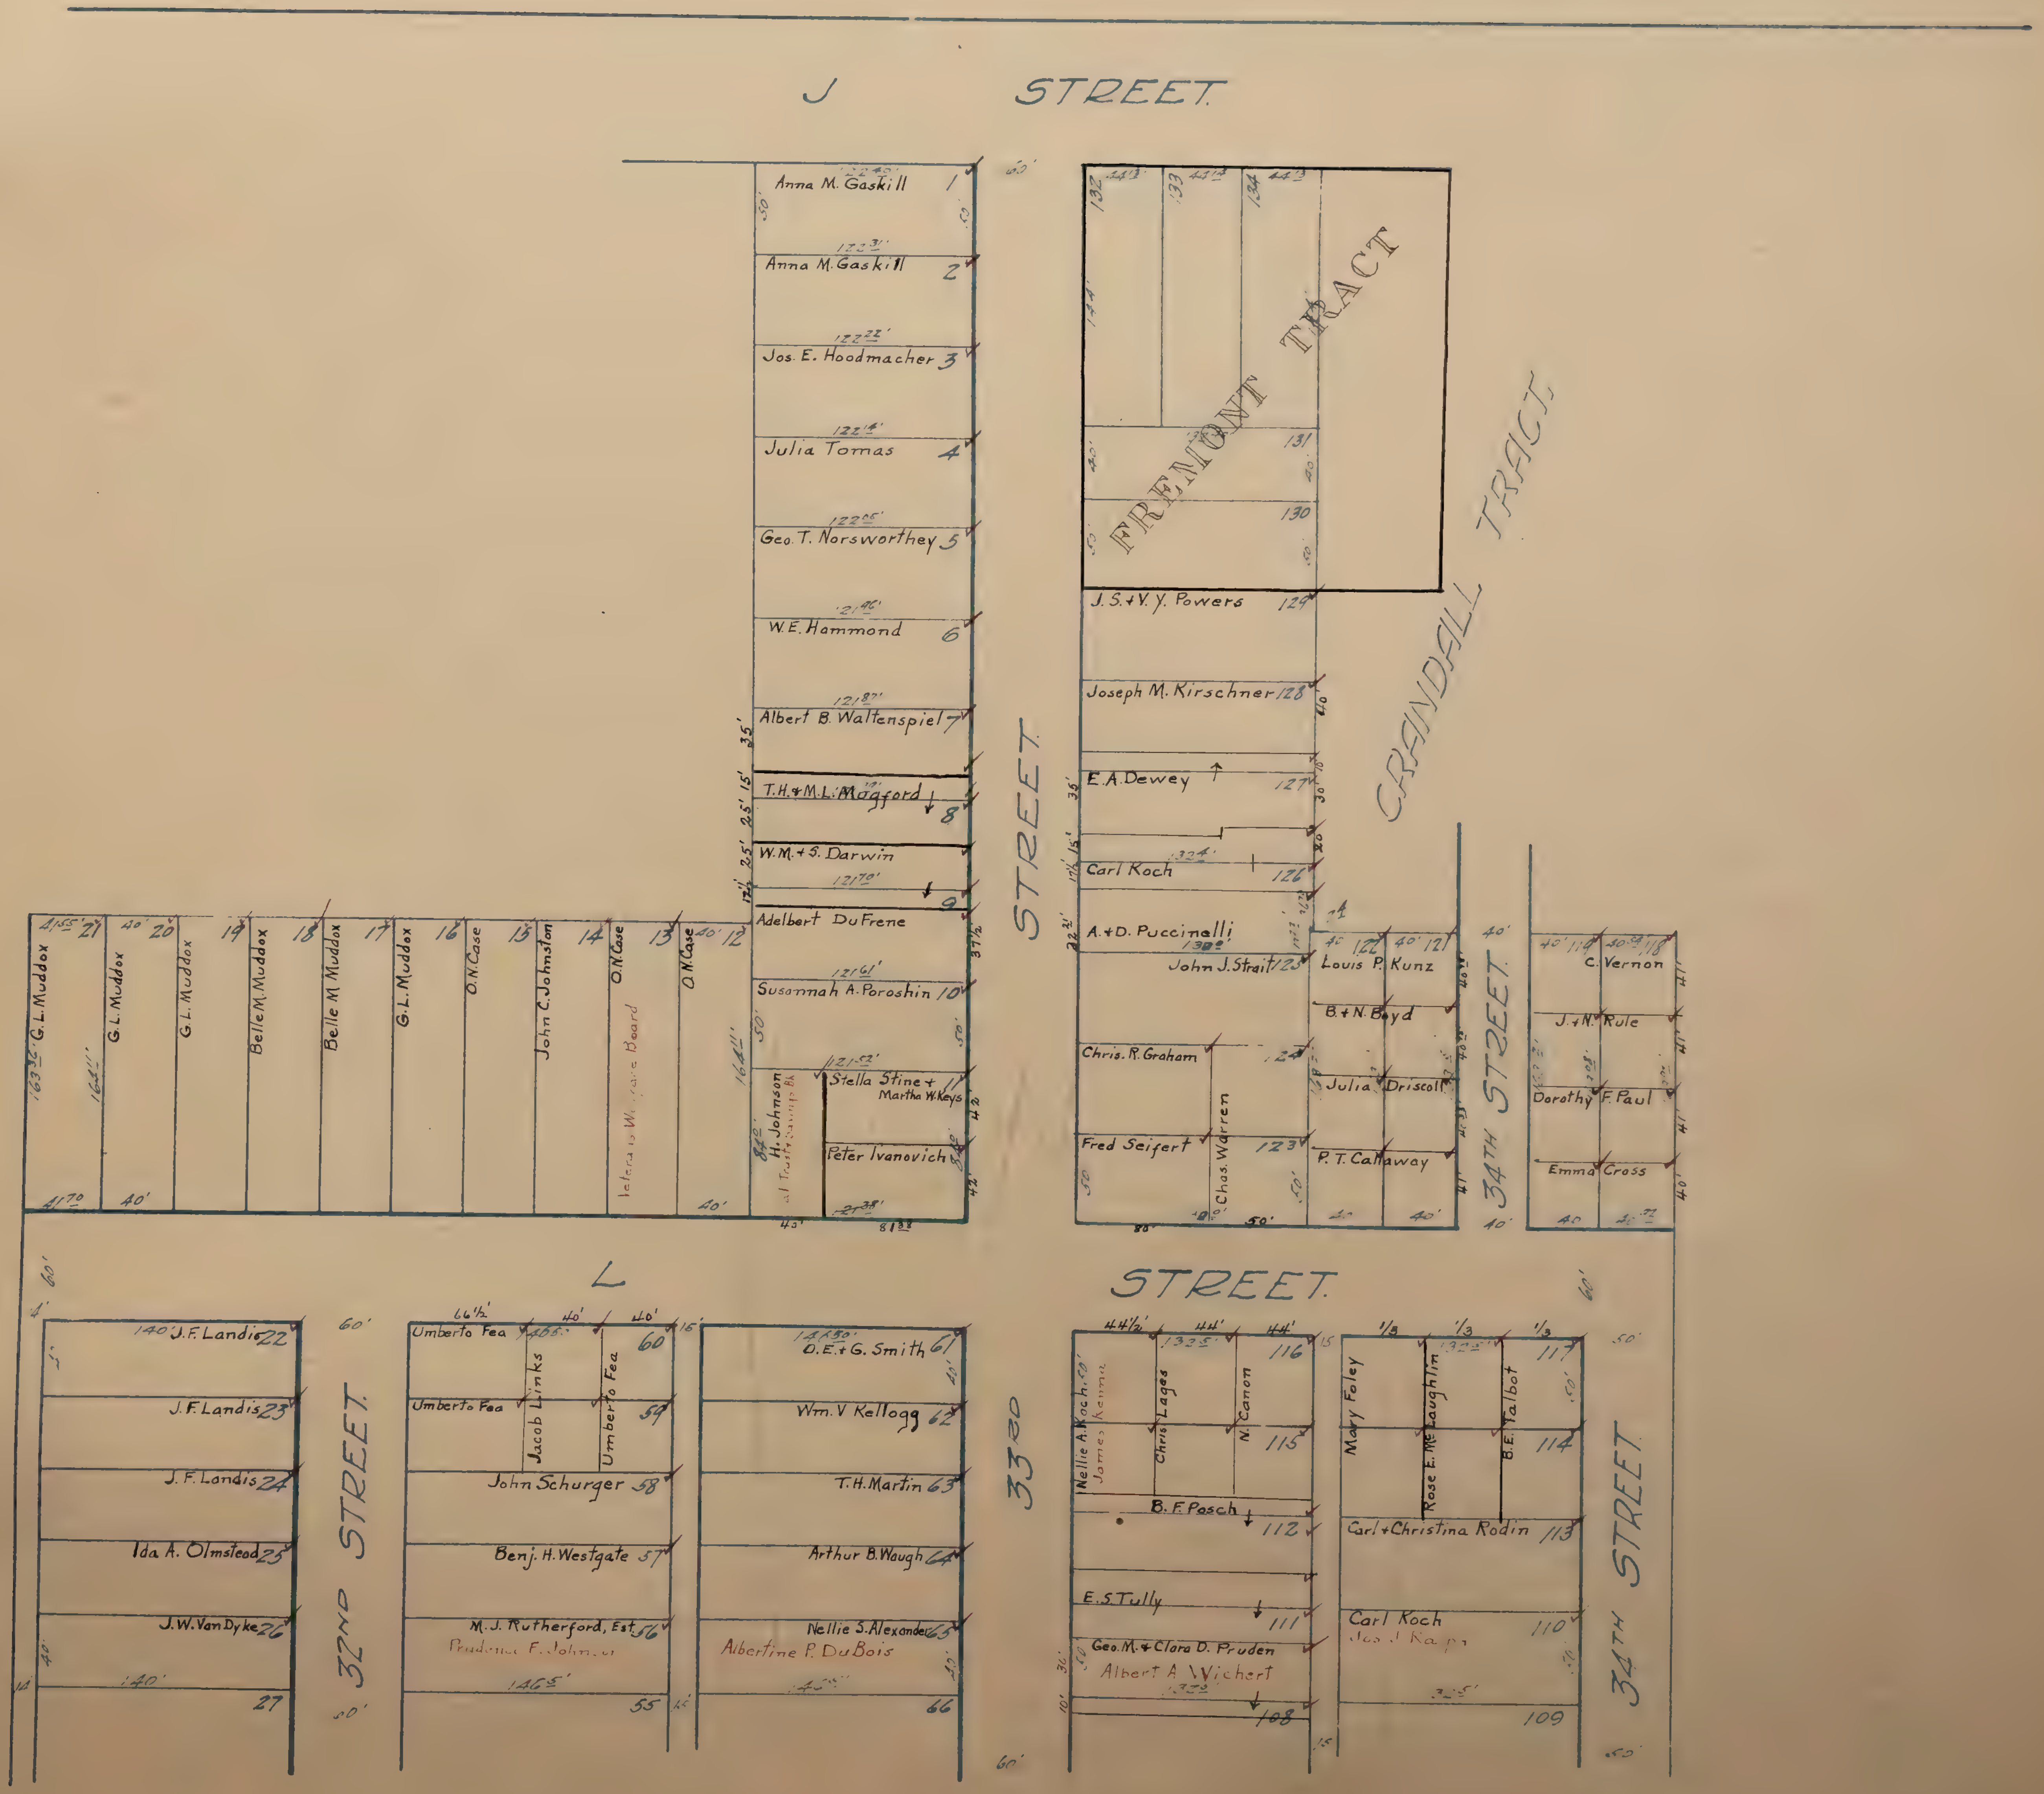
J STREET
L STREET
STREET
32ND STREET
33RD STREET
34TH STREET
34TH STREET
FREMONT TRACT
CRANDALL TRACT
Anna M. Gaskill 1
Anna M. Gaskill 2
Jos. E. Hoodmacher 3
Julia Tomas 4
Geo. T. Norsworthey 5
W.E. Hammond 6
Albert B. Waltenspiel 7
T.H. + M.L. Mogford 8
W.M. + S. Darwin
9
Adelbert DuFrene
Susannah A. Poroshin 10
Stella Stine + Martha W. Keys
Peter Ivanovich
H. Johnson
12
13 O.N. Case
14 O.N. Case
15 John C. Johnston
16 O.N. Case
17 G.L. Muddox
18 Belle M. Muddox
19 Belle M. Muddox
20 G.L. Muddox
21 G.L. Muddox
G.L. Muddox
132
133
134
131
130
J. S. + V. Y. Powers 129
Joseph M. Kirschner 128
E. A. Dewey 127
Carl Koch 126
A. + D. Puccinelli
John J. Strait 125
Chris. R. Graham 124
Fred Seifert 123
Chas. Warren
122
121
Louis P. Kunz
B. + N. Boyd
Julia Driscoll
P. T. Callaway
119
118
C. Vernon
J. + N. Rule
Dorothy F. Paul
Emma Cross
J. F. Landis 22
J. F. Landis 23
J. F. Landis 24
Ida A. Olmstead 25
J. W. Van Dyke 26
27
Umberto Fea 60
Umberto Fea 59
Jacob Links
Umberto Fea
John Schurger 58
Benj. H. Westgate 57
M. J. Rutherford, Est. 56
55
D. E. + G. Smith 61
Wm. V. Kellogg 62
T. H. Martin 63
Arthur B. Waugh 64
Nellie S. Alexander 65
Albertine P. DuBois
66
116
115
Nellie A. Koch
James Keane
Chris Lages
N. Canon
B. F. Pasch 112
E. S. Tully 111
Geo. M. + Clara D. Pruden
Albert A. Wichert
108
117
114
Mary Foley
Rose E. McLaughlin
B. E. Talbot
Carl + Christina Rodin 113
Carl Koch 110
109
60'
40'
50'
140'
132.5'

6

EAST SACRAMENTO ✓

Scale: 1 Inch = 80 feet.

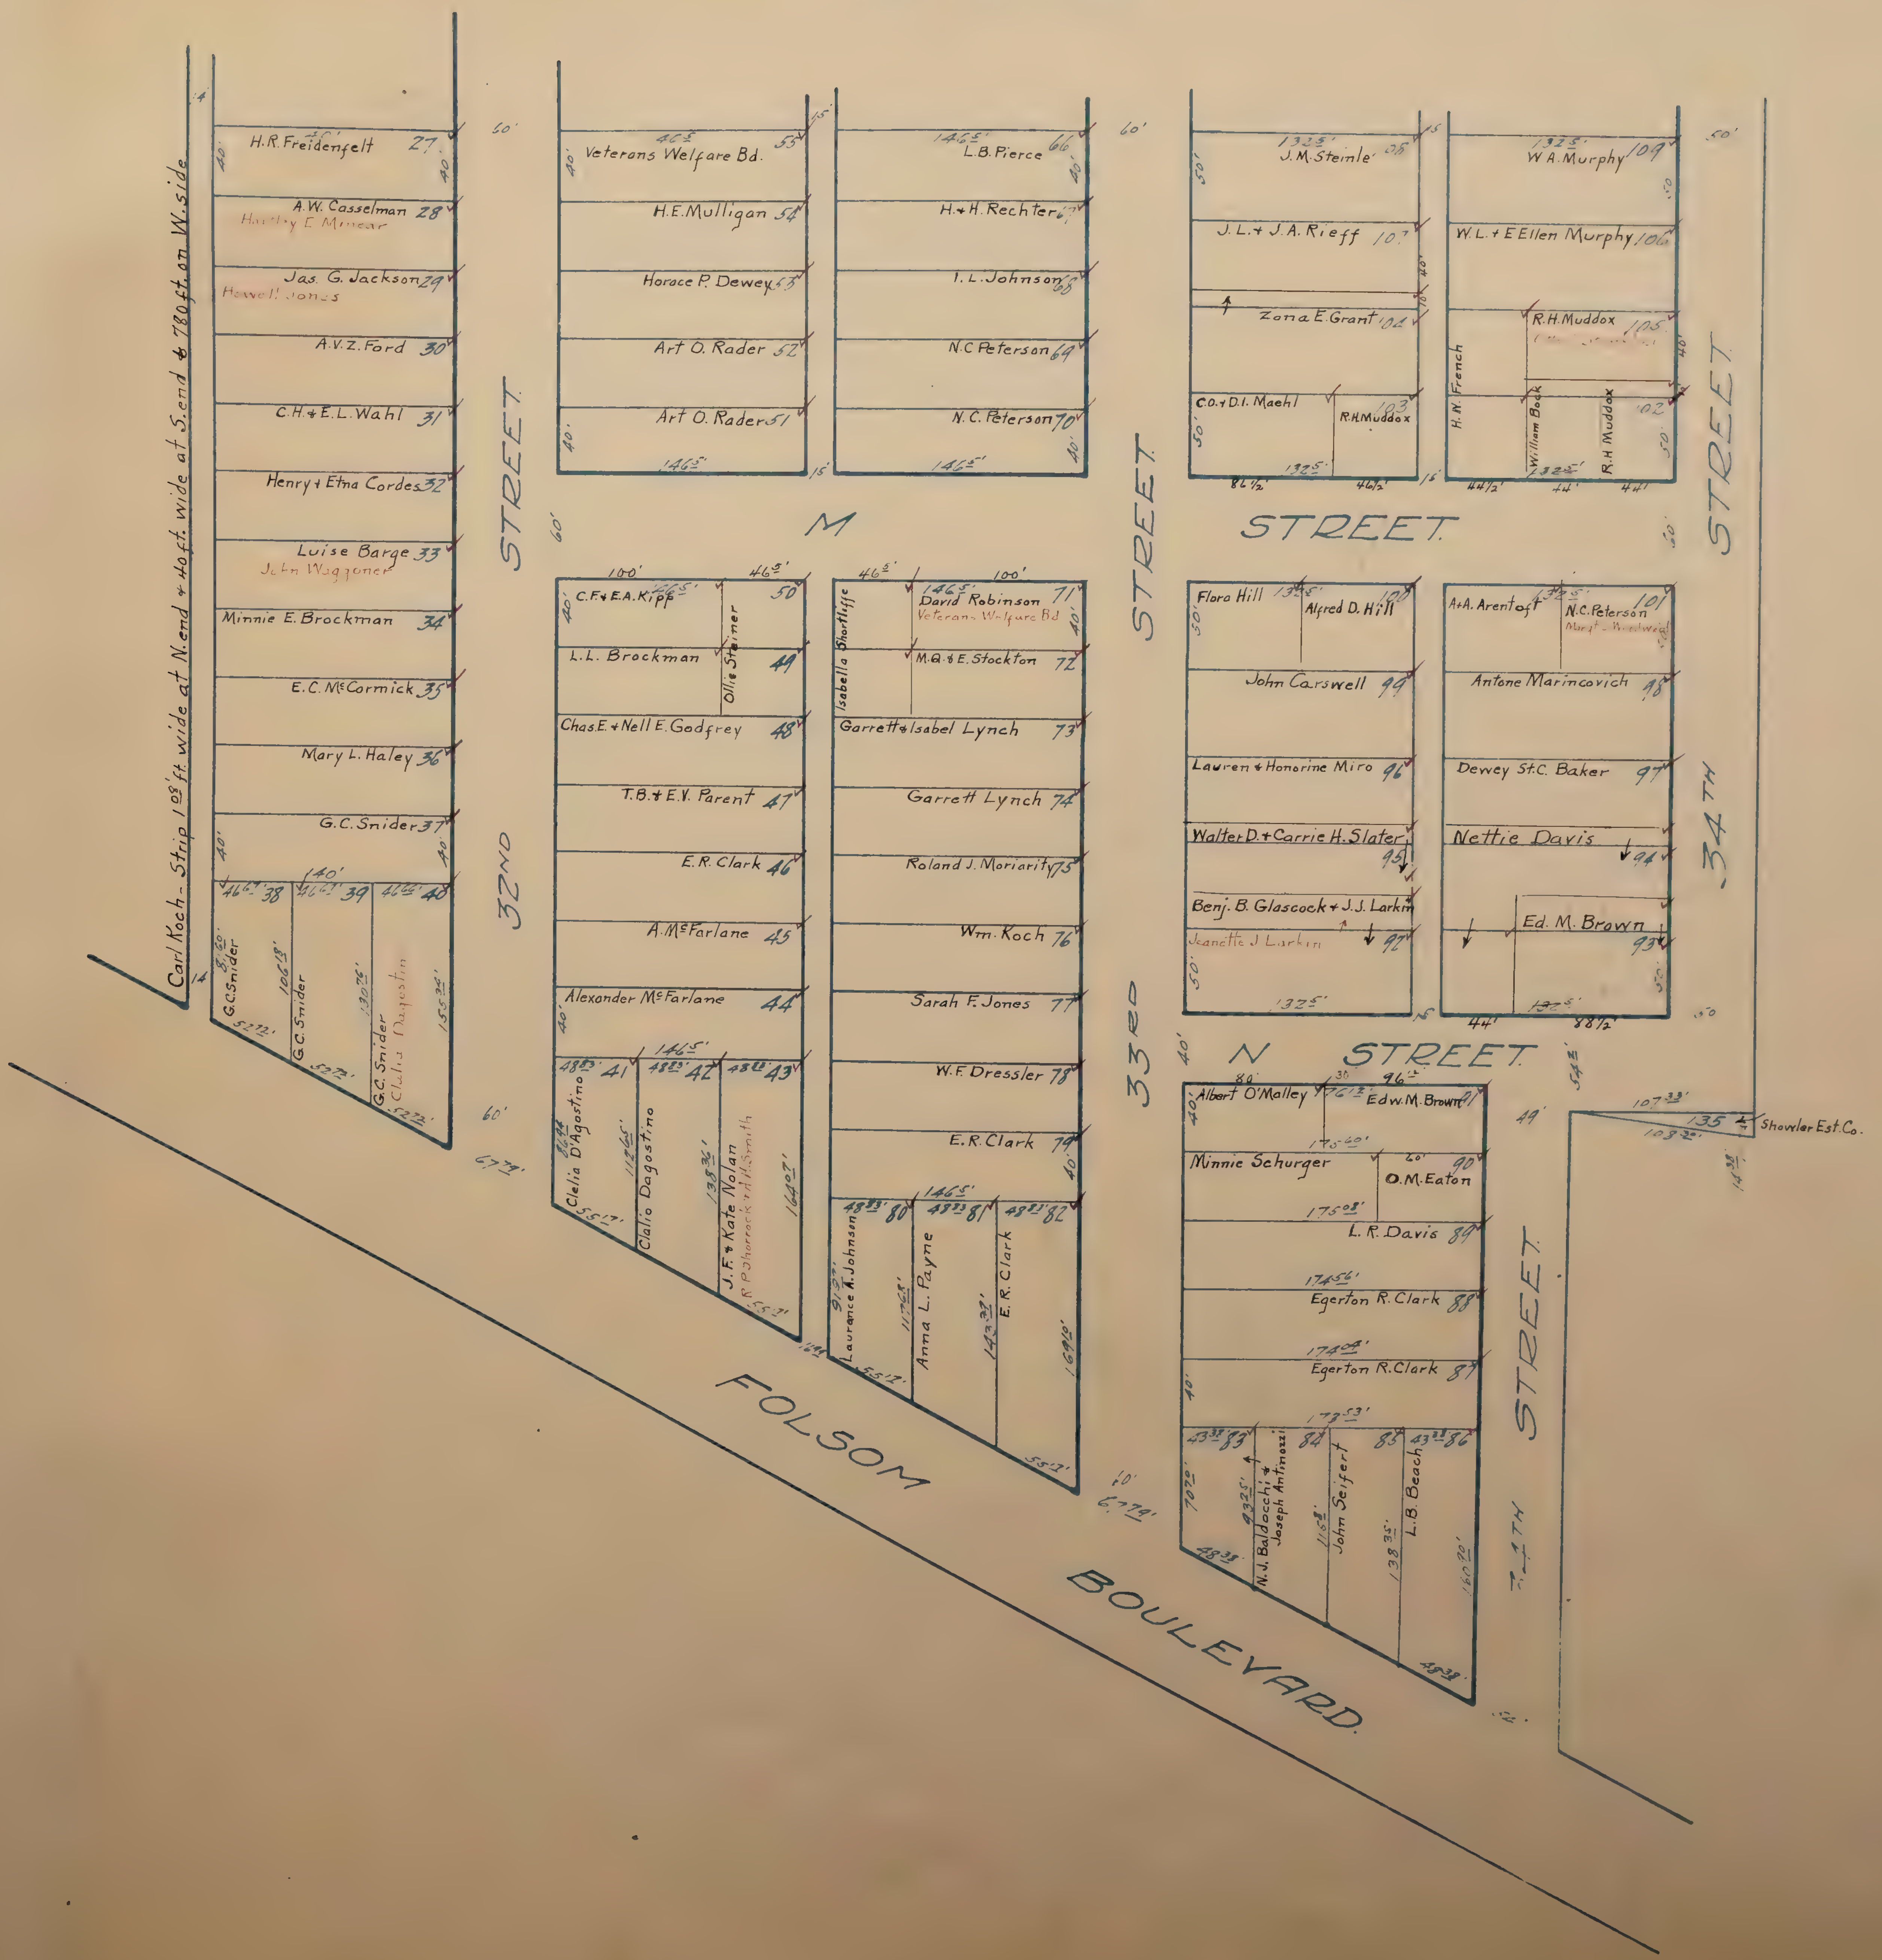

H.R. Freidenfelt 27
A.W. Casselman 28
Hartley E Minear
Jas. G. Jackson 29
Howell Jones
A.V.Z. Ford 30
C.H. + E.L. Wahl 31
Henry + Etna Cordes 32
Luise Barge 33
John Waggoner
Minnie E. Brockman 34
E.C. McCormick 35
Mary L. Haley 36
G.C. Snider 37
38
39
40
G.C. Snider
G.C. Snider
G.C. Snider
Clelia Dagostino
Carl Koch - Strip 1 9/10 ft wide at N. end + 4 ft. wide at S. end & 780 ft. on W. side
32ND STREET
Veterans Welfare Bd. 55
H.E. Mulligan 54
Horace P. Dewey 53
Art O. Rader 52
Art O. Rader 51
L.B. Pierce 66
H + H. Rechter 67
I.L. Johnson 68
N.C. Peterson 69
N.C. Peterson 70
M STREET
C.F. + E.A. Kipp 50
L.L. Brockman 49
Ollie Steiner
Chas. E + Nell E. Godfrey 48
T.B. + E.V. Parent 47
E.R. Clark 46
A. McFarlane 45
Alexander McFarlane 44
41
42
43
Clelia D'Agostino
Clelia Dagostino
J.F. + Kate Nolan
Isabella Shortliffe
David Robinson 71
Veterans Welfare Bd
M.Q. + E. Stockton 72
Garrett + Isabel Lynch 73
Garrett Lynch 74
Roland J. Moriarity 75
Wm. Koch 76
Sarah F. Jones 77
W.F. Dressler 78
E.R. Clark 79
80
81
82
Laurence A. Johnson
Anna L. Payne
E.R. Clark
33RD STREET
J.M. Stemle 105
J.L. + J.A. Rieff 104
Zona E. Grant 102
C.O. + D.I. Maehl
R.H. Muddox 103
W.A. Murphy 109
W.L. + E Ellen Murphy 106
R.H. Muddox 105
H.N. French
William Bock
R.H. Muddox
102
Flora Hill
Alfred D. Hill 100
John Carswell 99
Lauren + Honorine Miro 96
Walter D. + Carrie H. Slater 95
Benj. B. Glascock + J.J. Larkin 92
Jeanette J. Larkin
A + A. Arentoft
N.C. Peterson 101
Antone Marincovich 98
Dewey St.C. Baker 97
Nettie Davis 94
Ed. M. Brown 93
N STREET
Albert O'Malley 91
Edw. M. Brown
Minnie Schurger
O.M. Eaton 90
L.R. Davis 89
Egerton R. Clark 88
Egerton R. Clark 87
83
84
85
86
N.J. Baldocchi + Joseph Antinozzi
John Seifert
L.B. Beach
34TH STREET
Showler Est. Co.
135
FOLSOM BOULEVARD

6

ADDITION "A" TO EAST SACRAMENTO ✓✓

Scale 1 Inch = 80 Feet.

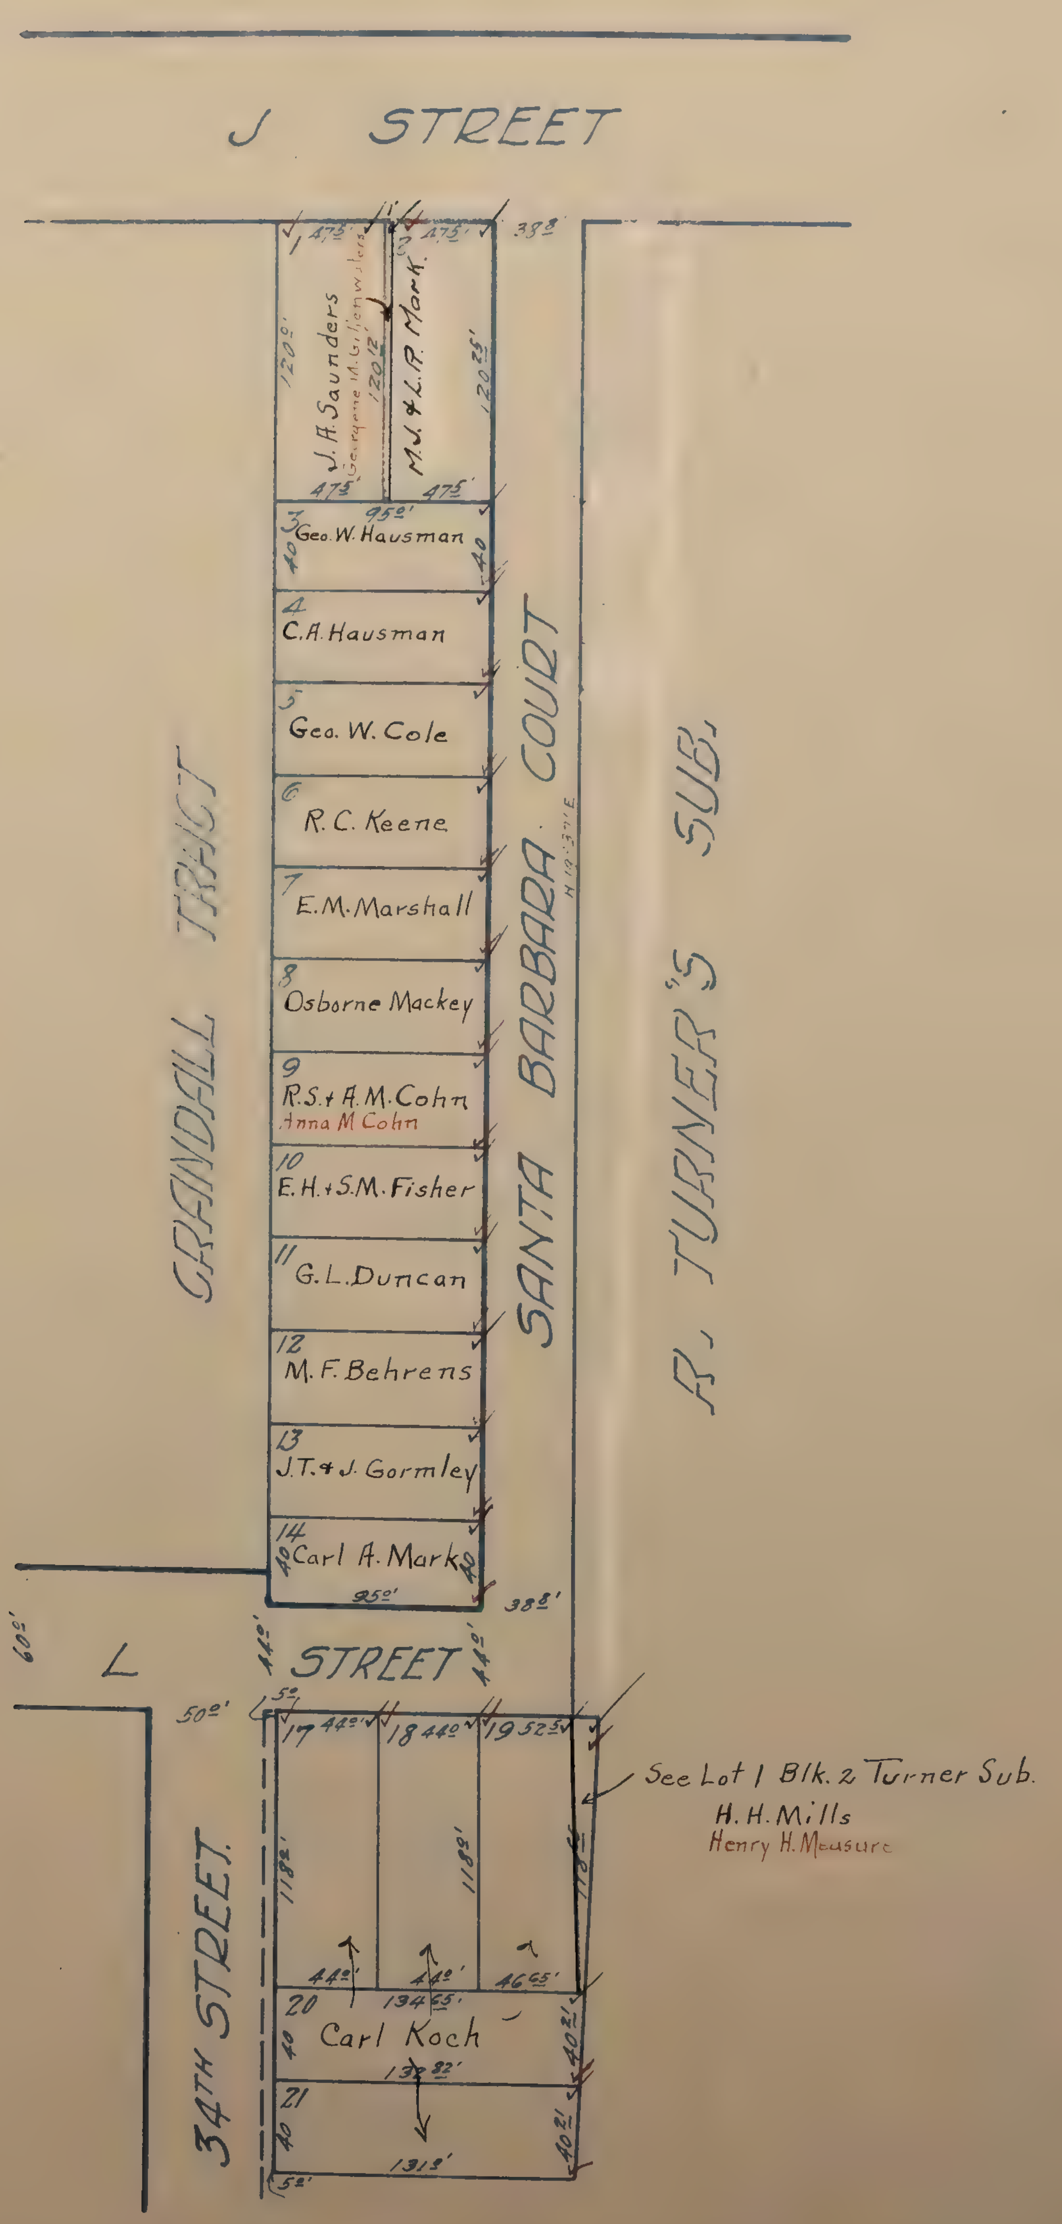
J STREET
1 47.5' 47.5' 120.0' 47.5'
J. A. Saunders
Georgene M. Gillenwaters
120.12'
M.J. & L.R. Mark.
2 47.5' 120.25' 47.5'
38.8'
95.0'
3 Geo. W. Hausman 40 40
4 C.A. Hausman
5 Geo. W. Cole
6 R.C. Keene
7 E.M. Marshall
8 Osborne Mackey
9 R.S. & A.M. Cohn
Anna M. Cohn
10 E.H. & S.M. Fisher
11 G.L. Duncan
12 M.F. Behrens
13 J.T. & J. Gormley
14 Carl A. Mark 40 40
95.0'
38.8'
CRANDALL TRACT
SANTA BARBARA COURT
R. TURNER'S SUB.
60'
L STREET
44.0' 44.0'
50.0'
5.0
17 44.0' 18 44.0' 19 52.5'
118.2' 118.9' 118.6'
44.0' 44.0' 46.65'
20 134.65'
Carl Koch
40 40.21'
132.82'
21
40 40.21'
131.3'
5.2'
34TH STREET.
See Lot 1 Blk. 2 Turner Sub.
H. H. Mills
Henry H. Measure

6

ADDITION "B" TO EAST SACRAMENTO ✓

Scale: 1 Inch= 40 feet.

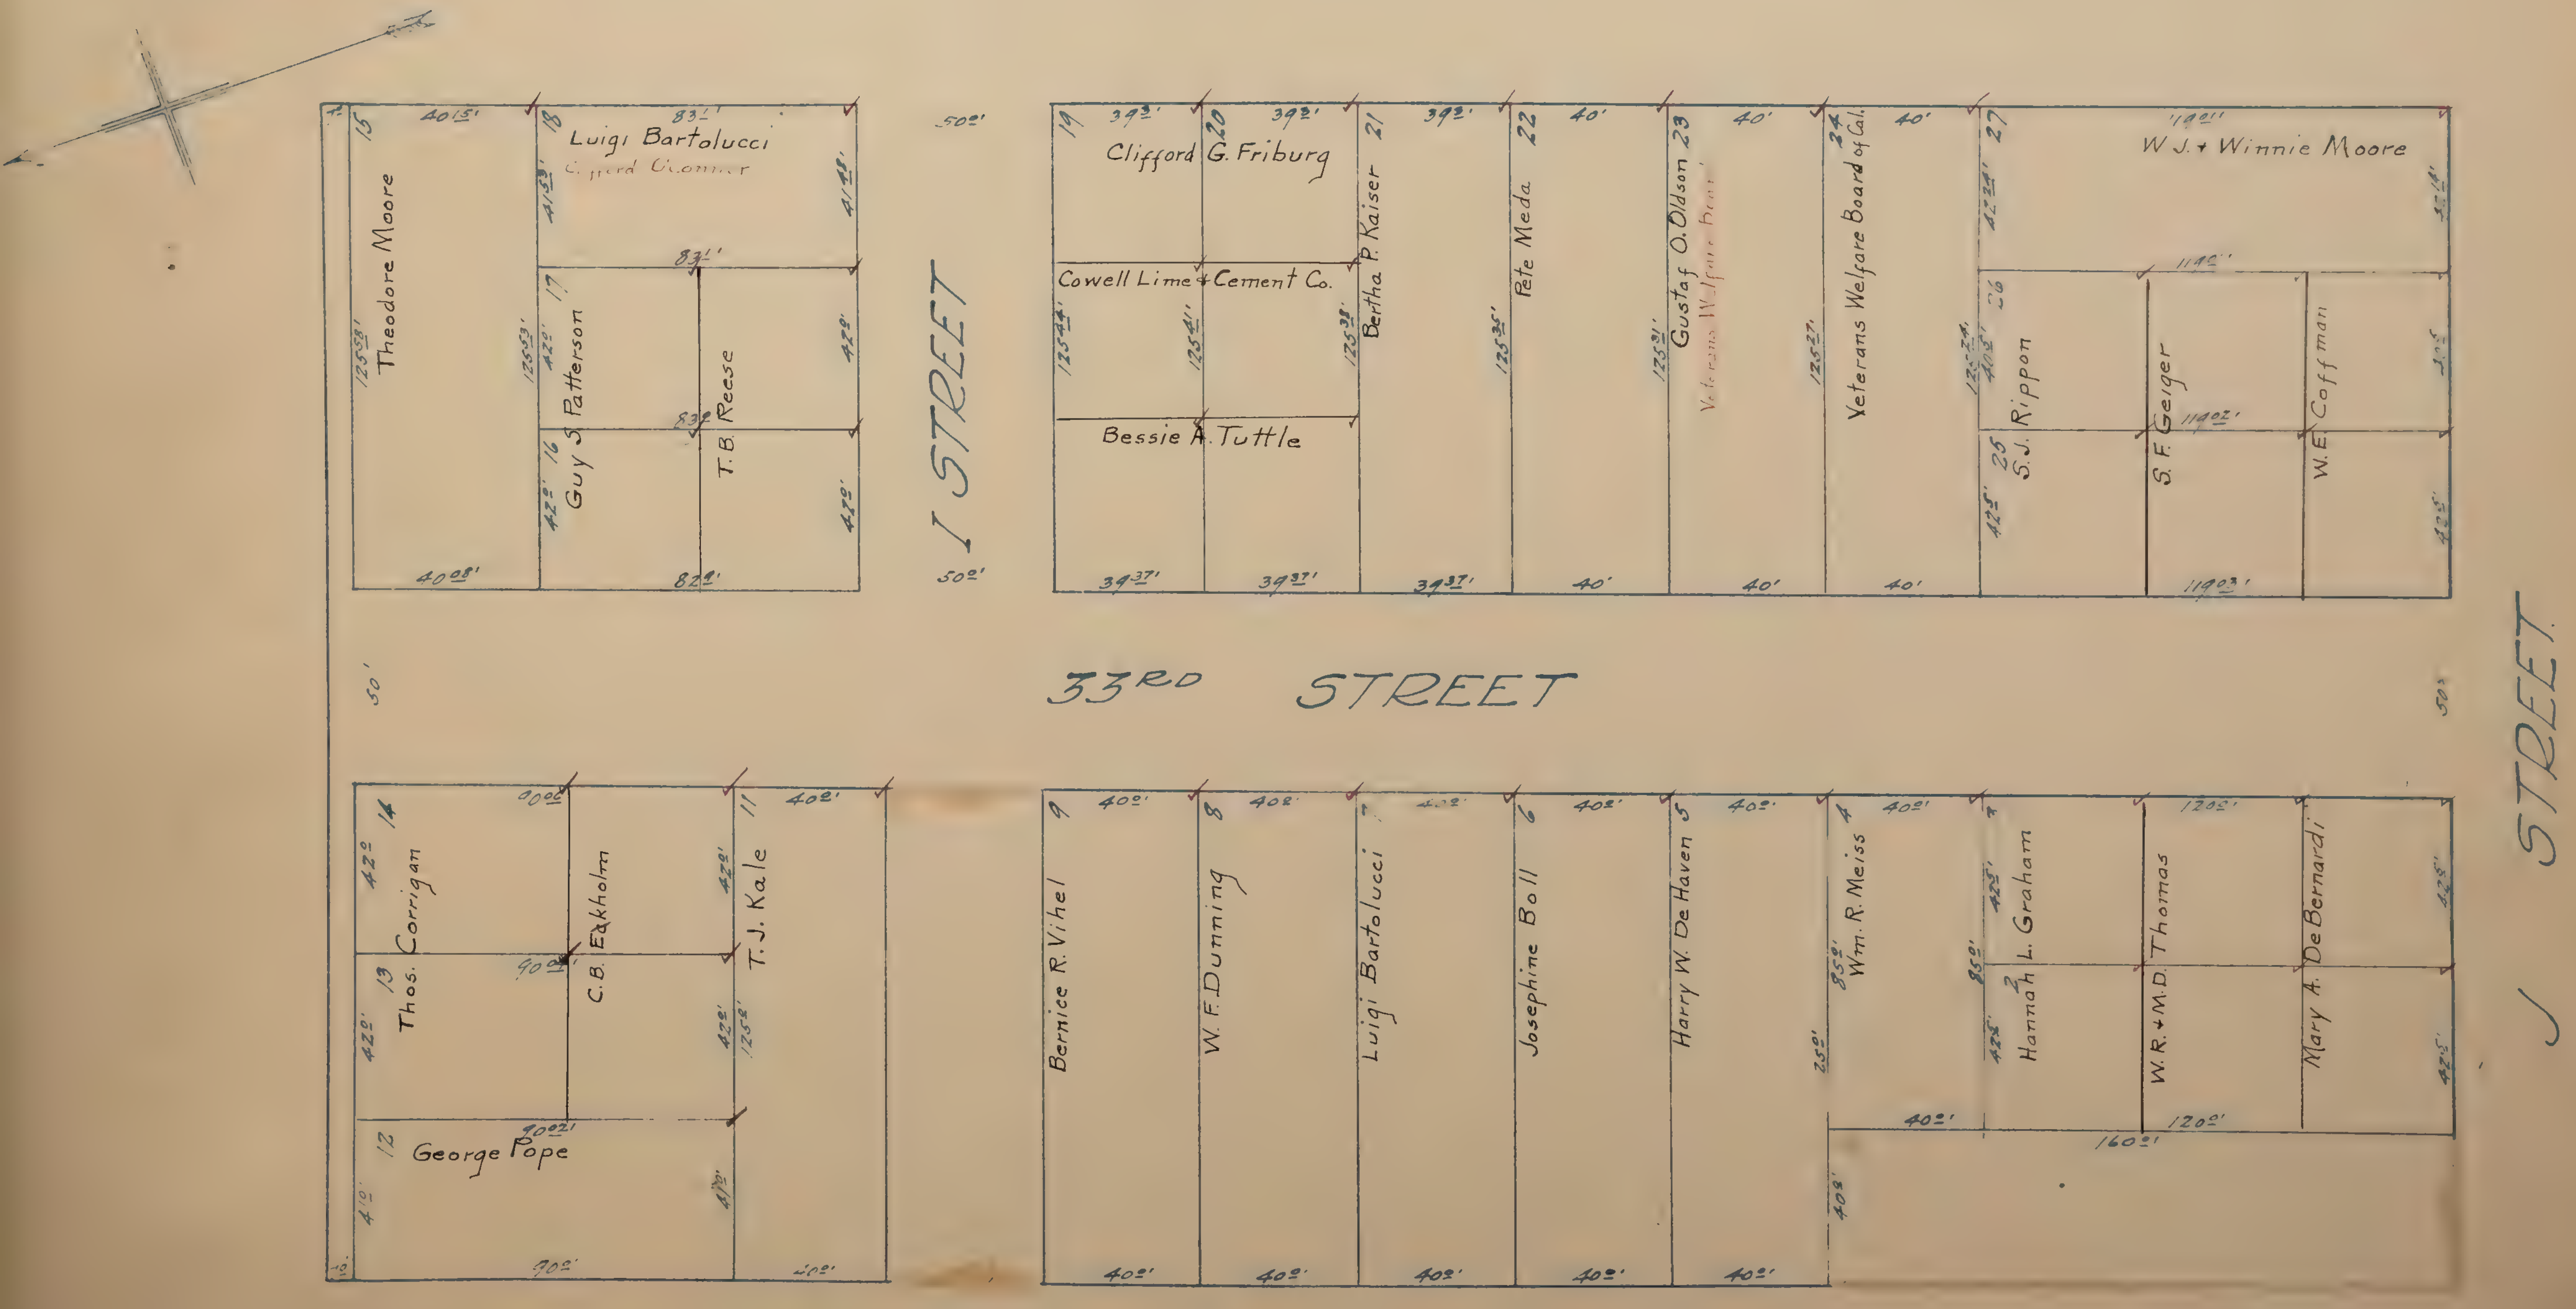
I STREET
33RD STREET
J STREET
50'
50'
50'
15 Theodore Moore
40.15'
125.58'
40.08'
18 Luigi Bartolucci
Clifford O'Connor
83.1'
41.53'
41.48'
17 Guy S. Patterson
16
T. B. Reese
42.0'
82.9'
19 Clifford G. Friburg
20
39.2'
Cowell Lime & Cement Co.
Bessie A. Tuttle
125.44'
125.41'
39.37'
21 Bertha P. Kaiser
125.38'
22 Pete Meda
125.35'
40'
23 Gustaf O. Oldson
Veterans Welfare Board
125.31'
24 Veterans Welfare Board of Cal.
125.27'
27 W. J. + Winnie Moore
119.11'
42.24'
26
25 S. J. Rippon
S. F. Geiger
W. E. Coffman
119.02'
119.03'
42.5'
14 Thos. Corrigan
13
C. B. Eckholm
12 George Pope
90.0'
90.02'
42.0'
41.0'
11 T. J. Kale
40.0'
125.0'
9 Bernice R. Vihel
8 W. F. Dunning
7 Luigi Bartolucci
6 Josephine Boll
5 Harry W. De Haven
4 Wm. R. Meiss
3 Hannah L. Graham
2
W. R. + M. D. Thomas
Mary A. DeBernardi
40.0'
85.0'
25.0'
40.8'
120.0'
160.0'
42.5'

ADDITION "C" TO EAST SAC.

located in
SACRAMENTO CITY.

Scale: 1" = 50'.

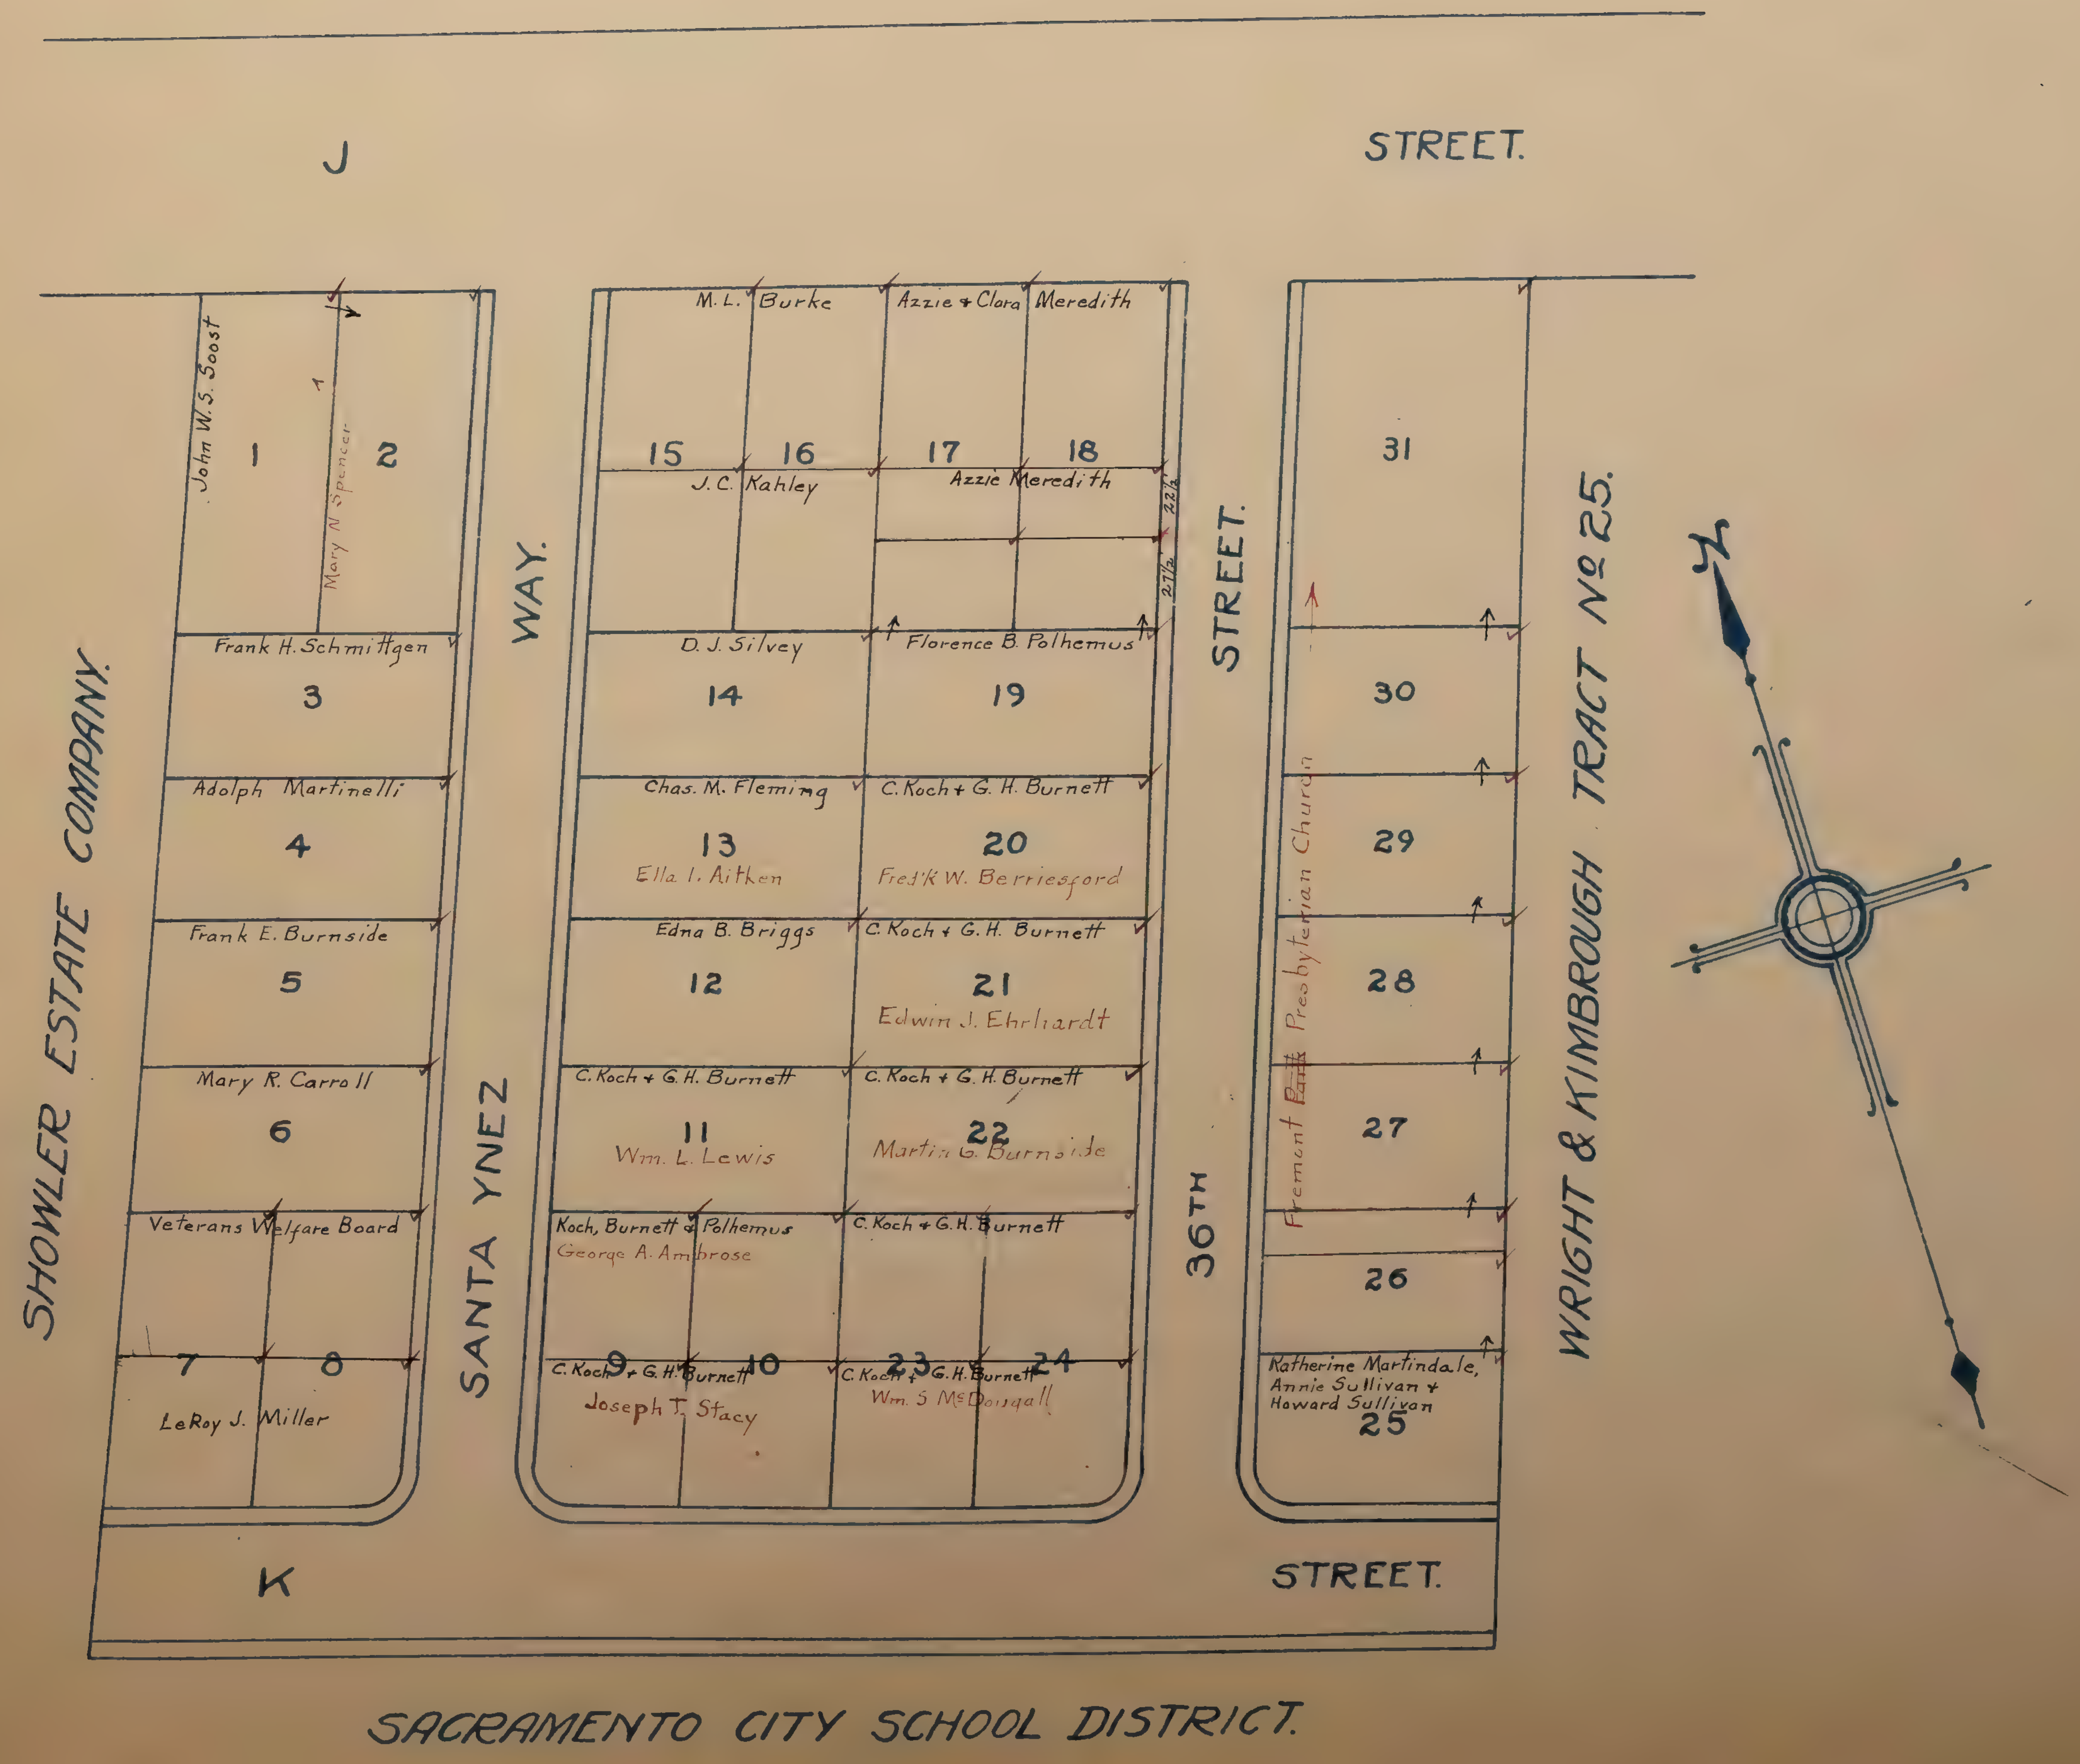
J STREET.
K STREET.
SANTA YNEZ WAY.
36TH STREET.
SHOWLER ESTATE COMPANY.
WRIGHT & KIMBROUGH TRACT No 25.
SACRAMENTO CITY SCHOOL DISTRICT.
1
John W. S. Soost
2
Mary N. Spencer
Frank H. Schmittgen
3
Adolph Martinelli
4
Frank E. Burnside
5
Mary R. Carroll
6
Veterans Welfare Board
7
8
LeRoy J. Miller
M. L. Burke
Azzie & Clora Meredith
15
16
17
18
J. C. Kahley
Azzie Meredith
22½
27½
D. J. Silvey
14
Florence B. Polhemus
19
Chas. M. Fleming
13
Ella I. Aitken
C. Koch & G. H. Burnett
20
Fred'k W. Berriesford
Edna B. Briggs
12
C. Koch & G. H. Burnett
21
Edwin J. Ehrhardt
C. Koch & G. H. Burnett
11
Wm. L. Lewis
C. Koch & G. H. Burnett
22
Martin G. Burnside
Koch, Burnett & Polhemus
George A. Ambrose
C. Koch & G. H. Burnett
9
10
C. Koch & G. H. Burnett
Joseph T. Stacy
23
24
C. Koch & G. H. Burnett
Wm. S McDougall
31
30
29
28
27
26
Fremont ~~Park~~ Presbyterian Church
Katherine Martindale, Annie Sullivan & Howard Sullivan
25

EAST SIDE ADDITION TO OAK PARK.

Scale: 1 Inch = 40 feet.

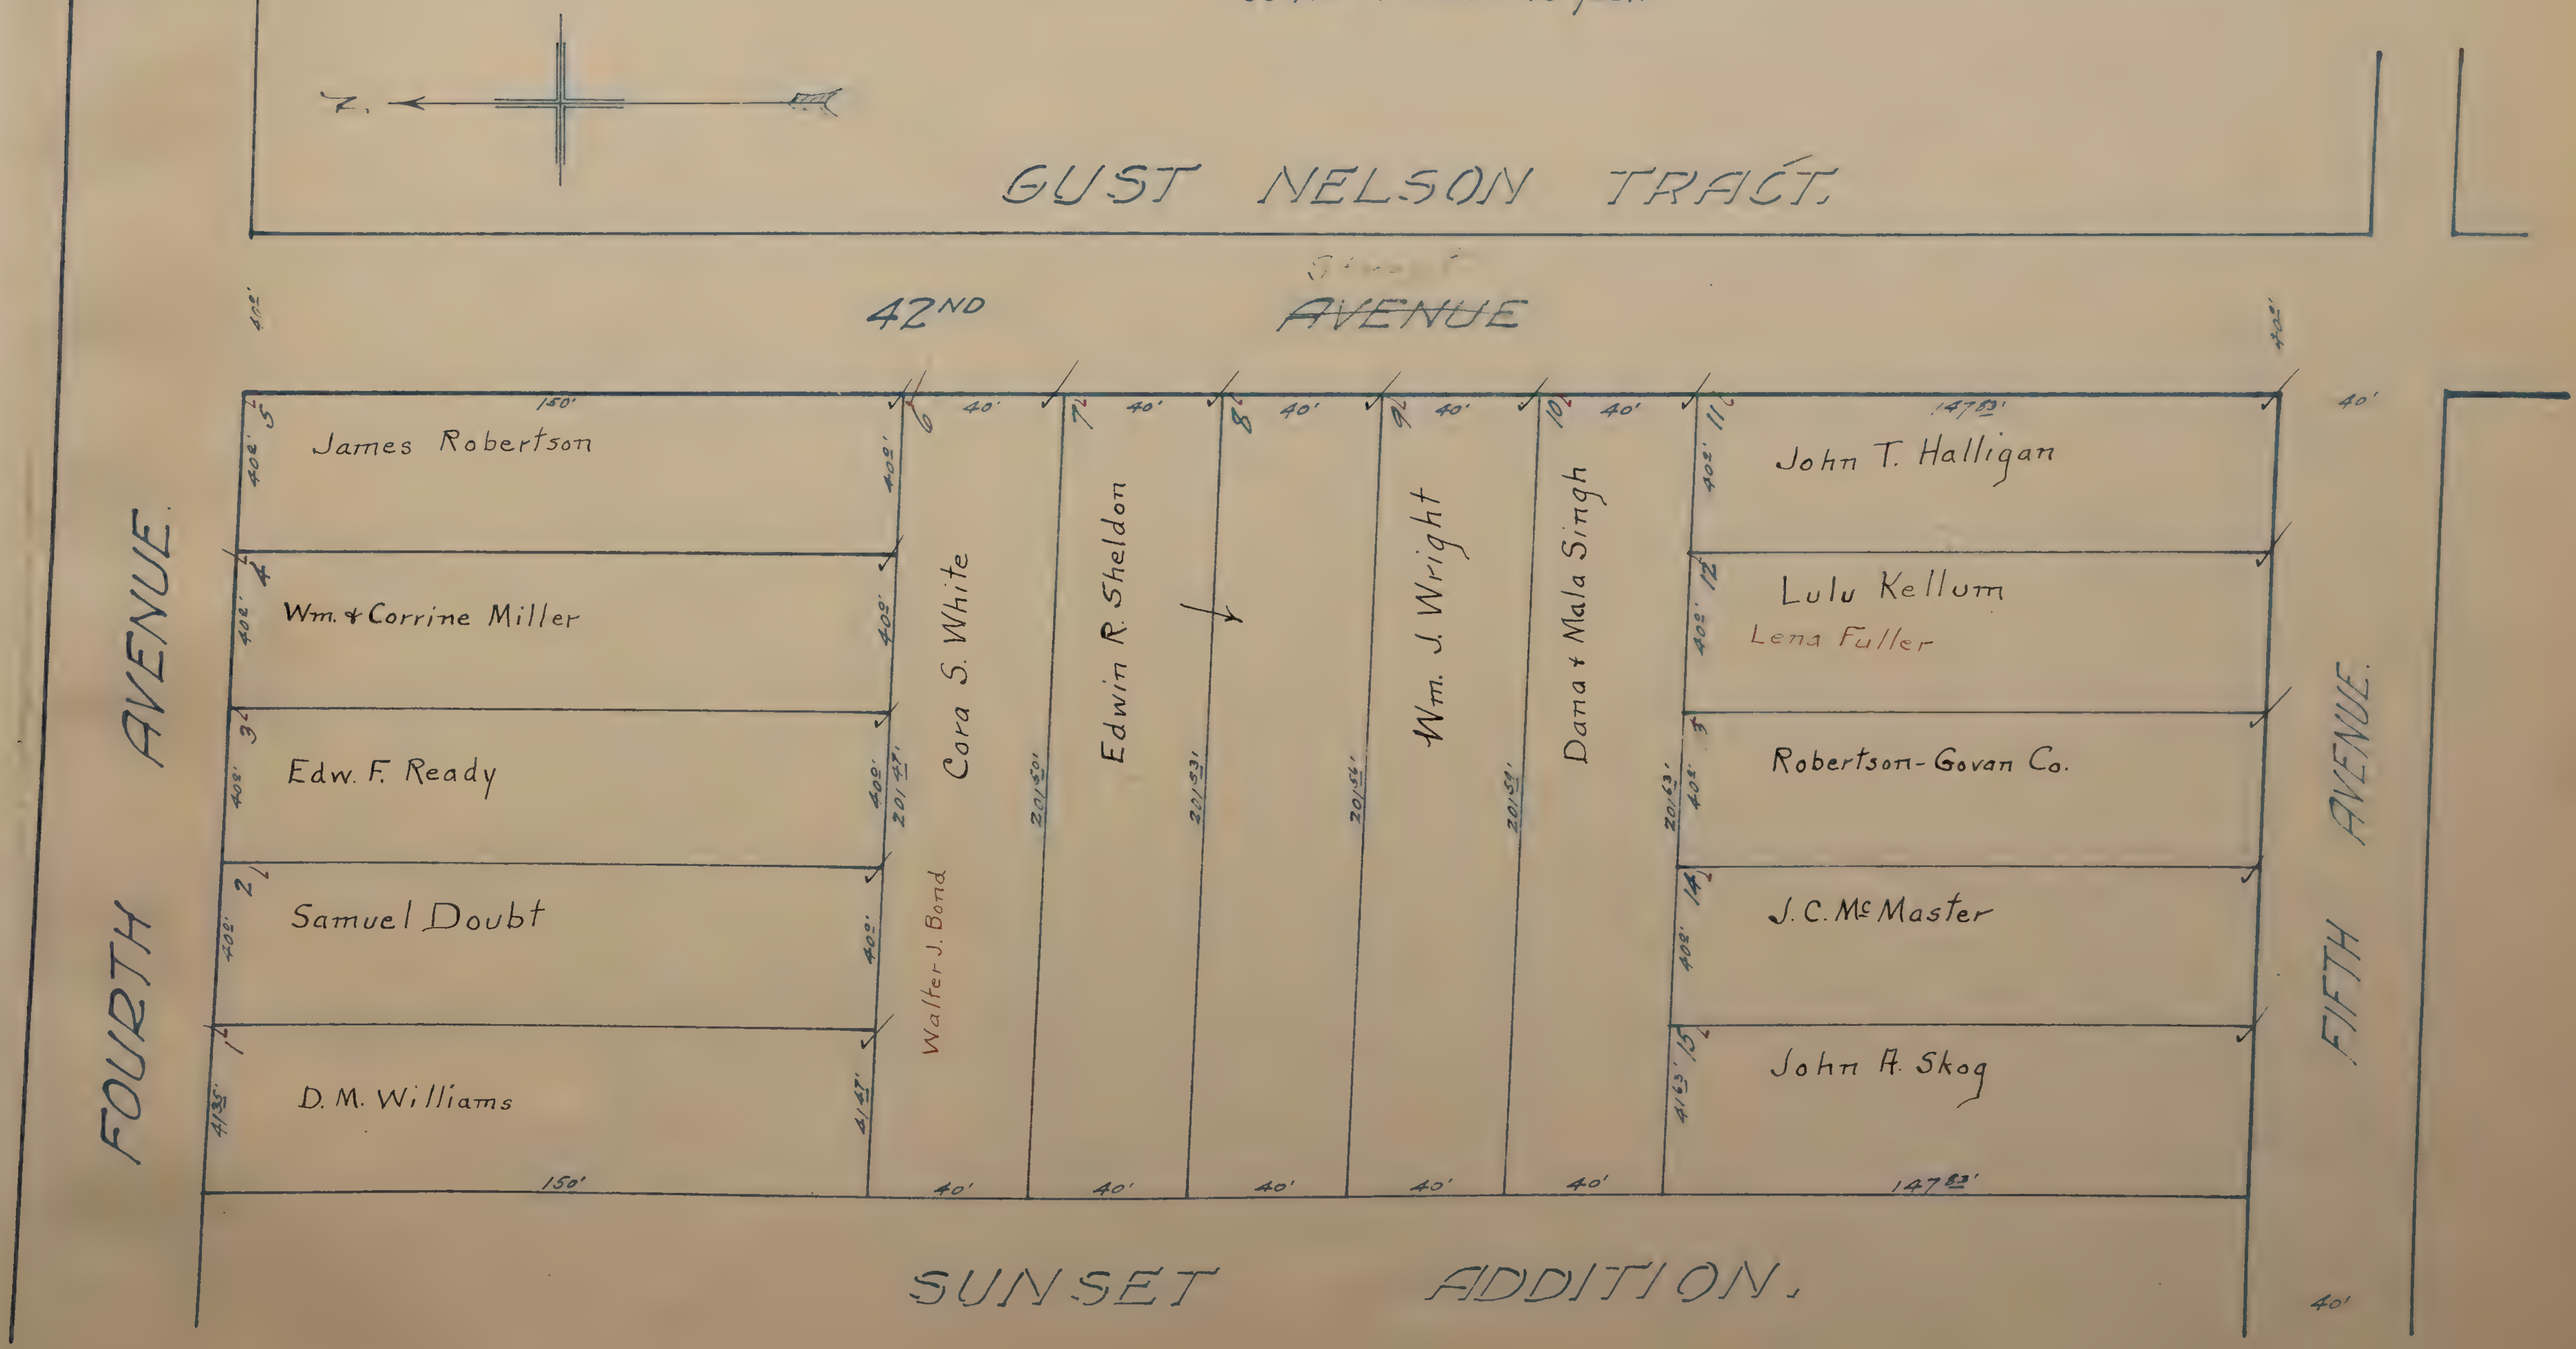
N.
GUST NELSON TRACT.
Street
42ND ~~AVENUE~~
FOURTH AVENUE.
FIFTH AVENUE.
SUNSET ADDITION.
150'
5 James Robertson
4 Wm. & Corrine Miller
3 Edw. F. Ready
2 Samuel Doubt
1 D. M. Williams
402'
4135'
4147'
150'
6 Cora S. White
Walter J. Bond
7 Edwin R. Sheldon
8
9 Wm. J. Wright
10 Dana & Mala Singh
20147'
20150'
20153'
20156'
20159'
20163'
40'
11 John T. Halligan
12 Lulu Kellum
Lena Fuller
13 Robertson-Govan Co.
14 J. C. McMaster
15 John A. Skog
14783'
4163'
40'

E. Terrace

6

PLAT OF

EAST TERRACE

CITY OF SACRAMENTO

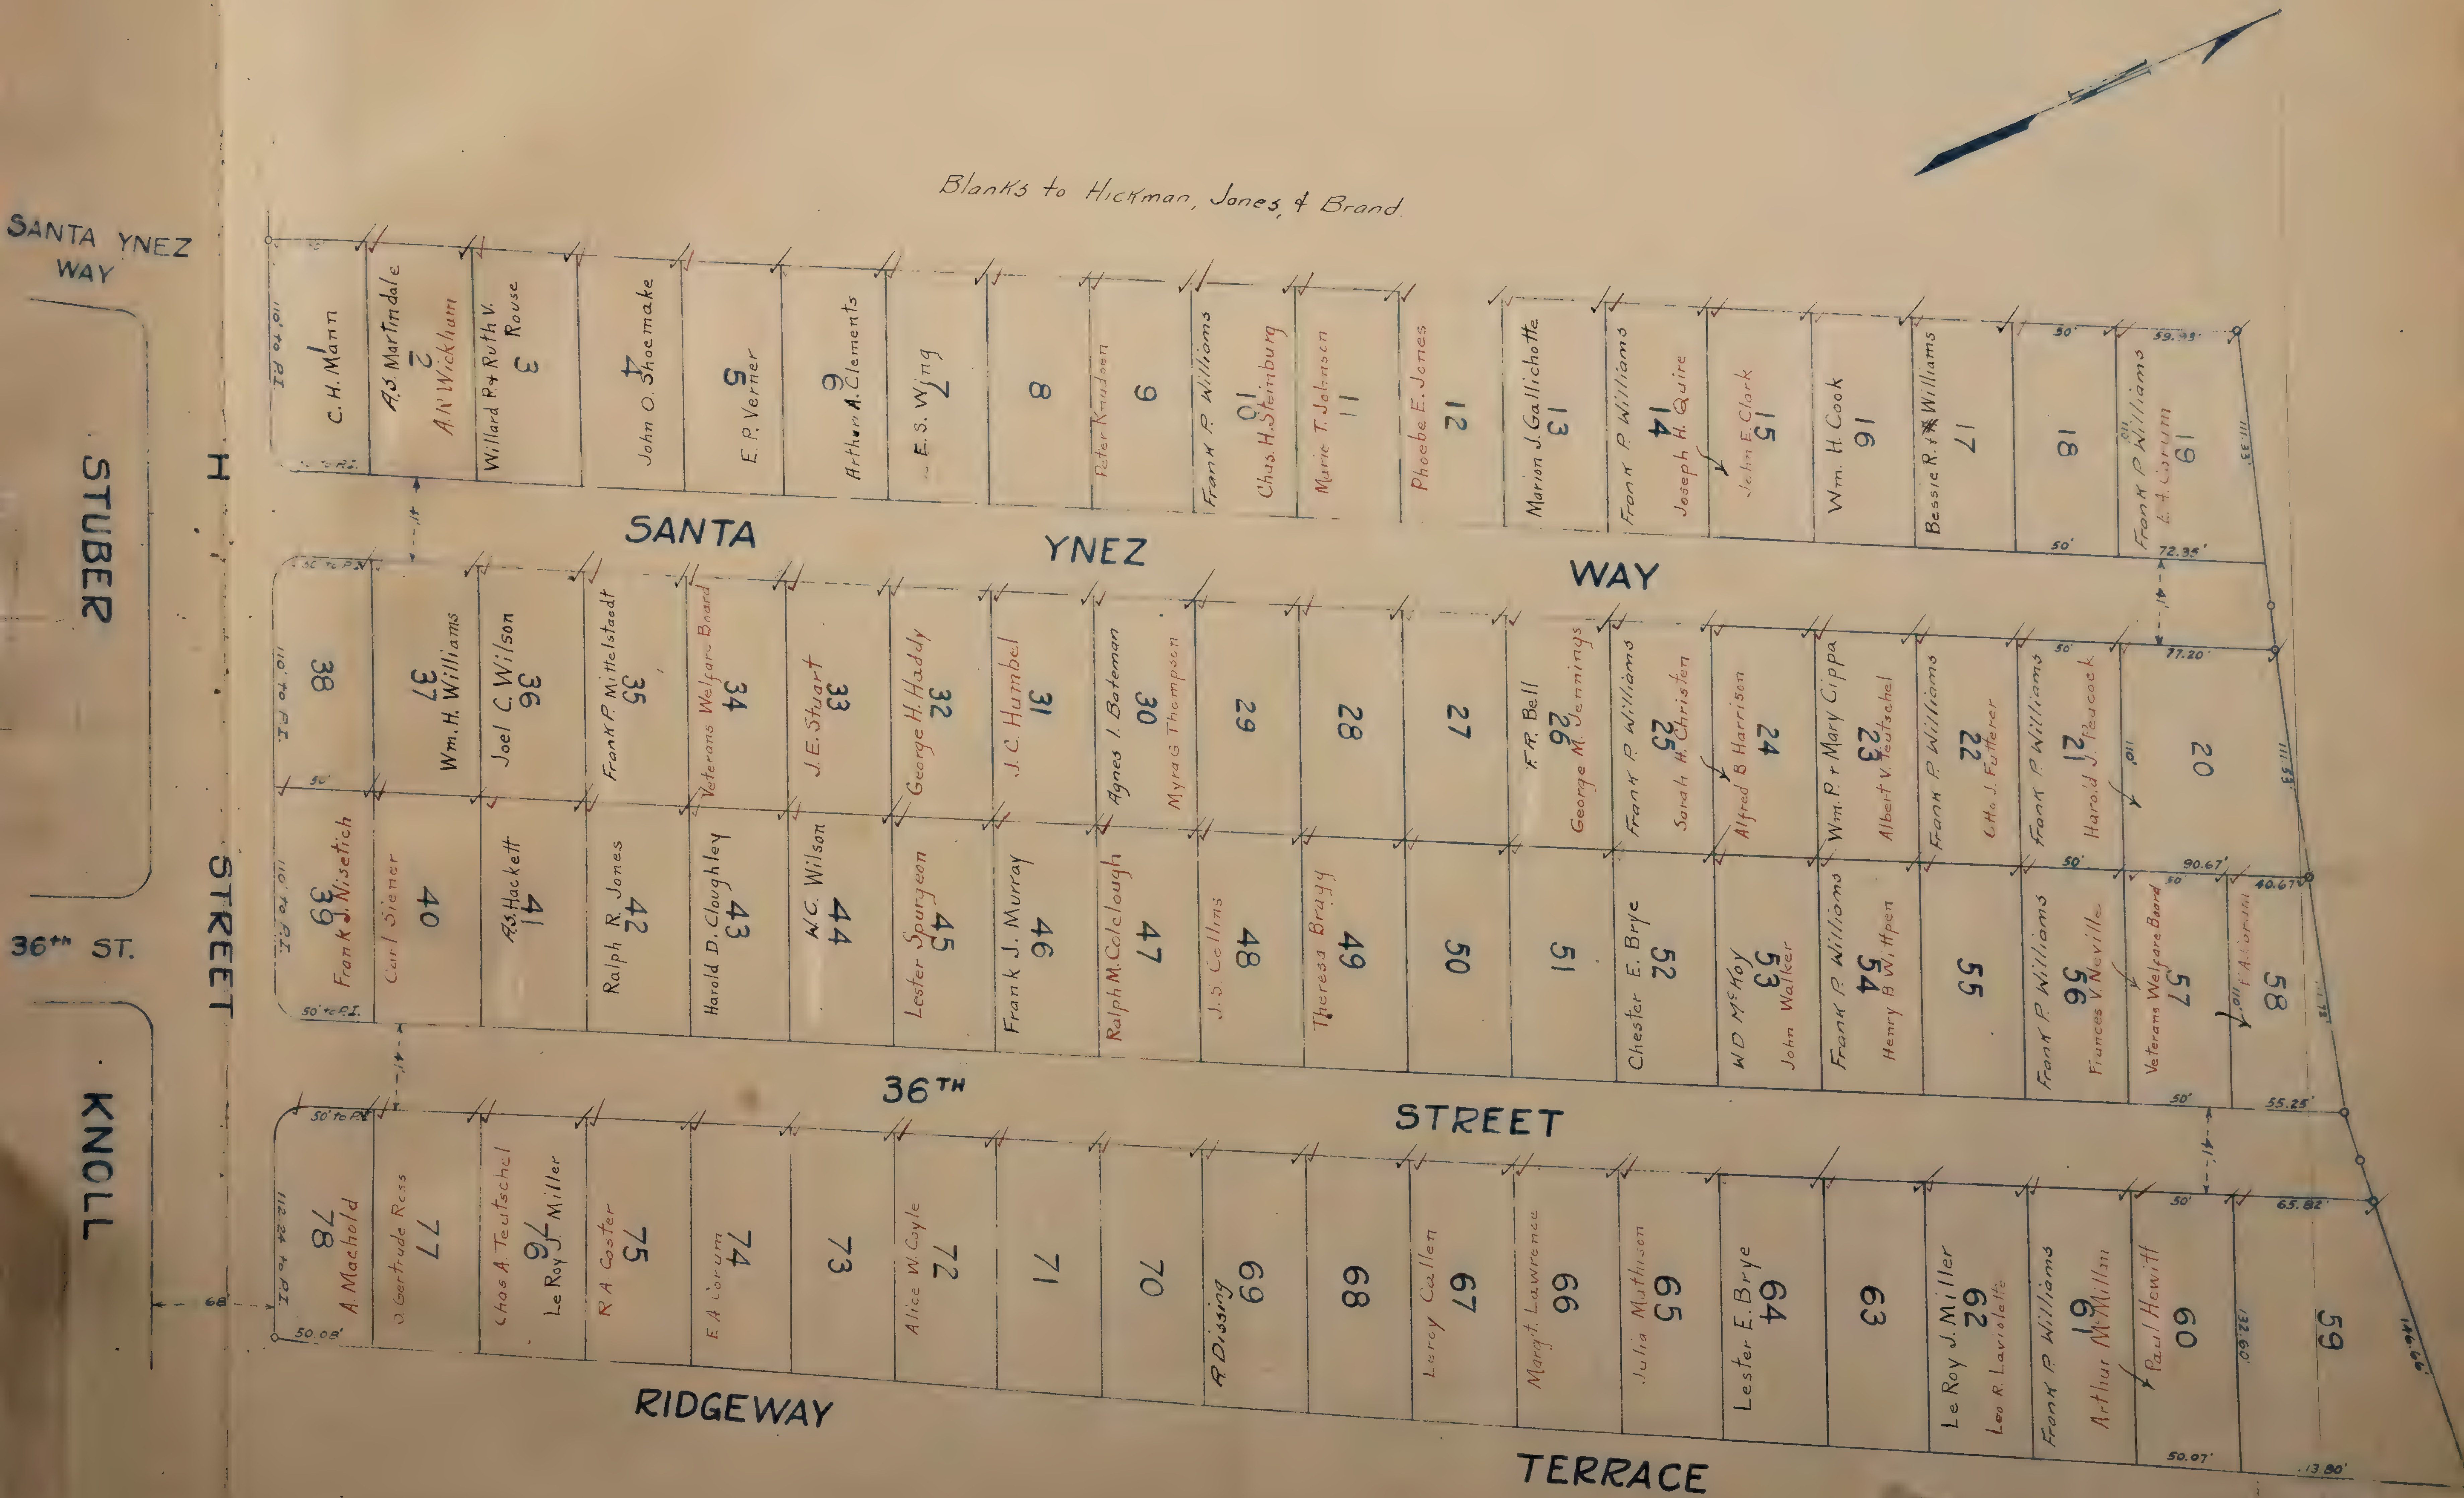
Blanks to Hickman, Jones, & Brand.
SANTA YNEZ WAY
STUBER
H STREET
36th ST.
KNOLL
SANTA YNEZ WAY
36TH STREET
RIDGEWAY TERRACE
110' to P.I.
1 C. H. Mann
2 A.S. Martindale A. N. Wickham
3 Willard P. & Ruth V. Rouse
4 John O. Shoemake
5 E. P. Verner
6 Arthur A. Clements
7 E. S. Wing
8
9 Peter Knudsen
10 Frank P. Williams Chas. H. Steinburg
11 Marie T. Johnsen
12 Phoebe E. Jones
13 Marion J. Gallichotte
14 Frank P. Williams Joseph H. Quire
15 John E. Clark
16 Wm. H. Cook
17 Bessie R. & Williams
18
19 Frank P. Williams E. A. Corum
50'
59.93'
111.33'
72.35'
14'
77.20'
20
21 Frank P. Williams Harold J. Peacock
22 Frank P. Williams C. Ho J. Futterer
23 Wm. P. & Mary Cippa Albert V. Teutschel
24 Alfred B Harrison
25 Frank P. Williams Sarah H. Christen
26 F. R. Bell George M. Jennings
27
28
29
30 Agnes I. Bateman Myra G Thompson
31 J. C. Humbel
32 George H. Haddy
33 J. E. Stuart
34 Veterans Welfare Board
35 Frank P. Mittelstaedt
36 Joel C. Wilson
37 Wm. H. Williams
38
50' to P.I.
39 Frank J. Nisetich
40 Carl Siener
41 A.S. Hackett
42 Ralph R. Jones
43 Harold D. Cloughley
44 W. C. Wilson
45 Lester Spurgeon
46 Frank J. Murray
47 Ralph M. Colclough
48 J. S. Collins
49 Theresa Bragg
50
51
52 Chester E. Brye
53 W D McKoy John Walker
54 Frank P. Williams Henry B Wittpen
55
56 Frank P. Williams Frances V. Neville
57 Veterans Welfare Board
58 F. A. Corum
90.67'
40.67'
110'
55.25'
65.82'
59
60 Paul Hewitt
61 Frank P. Williams Arthur McMillan
62 Le Roy J. Miller Leo R. Laviolette
63
64 Lester E. Brye
65 Julia Mathison
66 Marg't. Lawrence
67 Leroy Callen
68
69 R. Dissing
70
71
72 Alice W. Coyle
73
74 E. A. Corum
75 R. A. Coster
76 Chas. A. Teutschel Le Roy J. Miller
77 J. Gertrude Ross
78 A. Machold
112.24 to P.I.
50.08'
68'
132.60'
146.66'
50.07'
13.80'

EDGEMONT ✓✓

Scale: 1 Inch = 80 feet

Blanks to W. J. Taylor, J. H. Feldhusen + Frank Tade

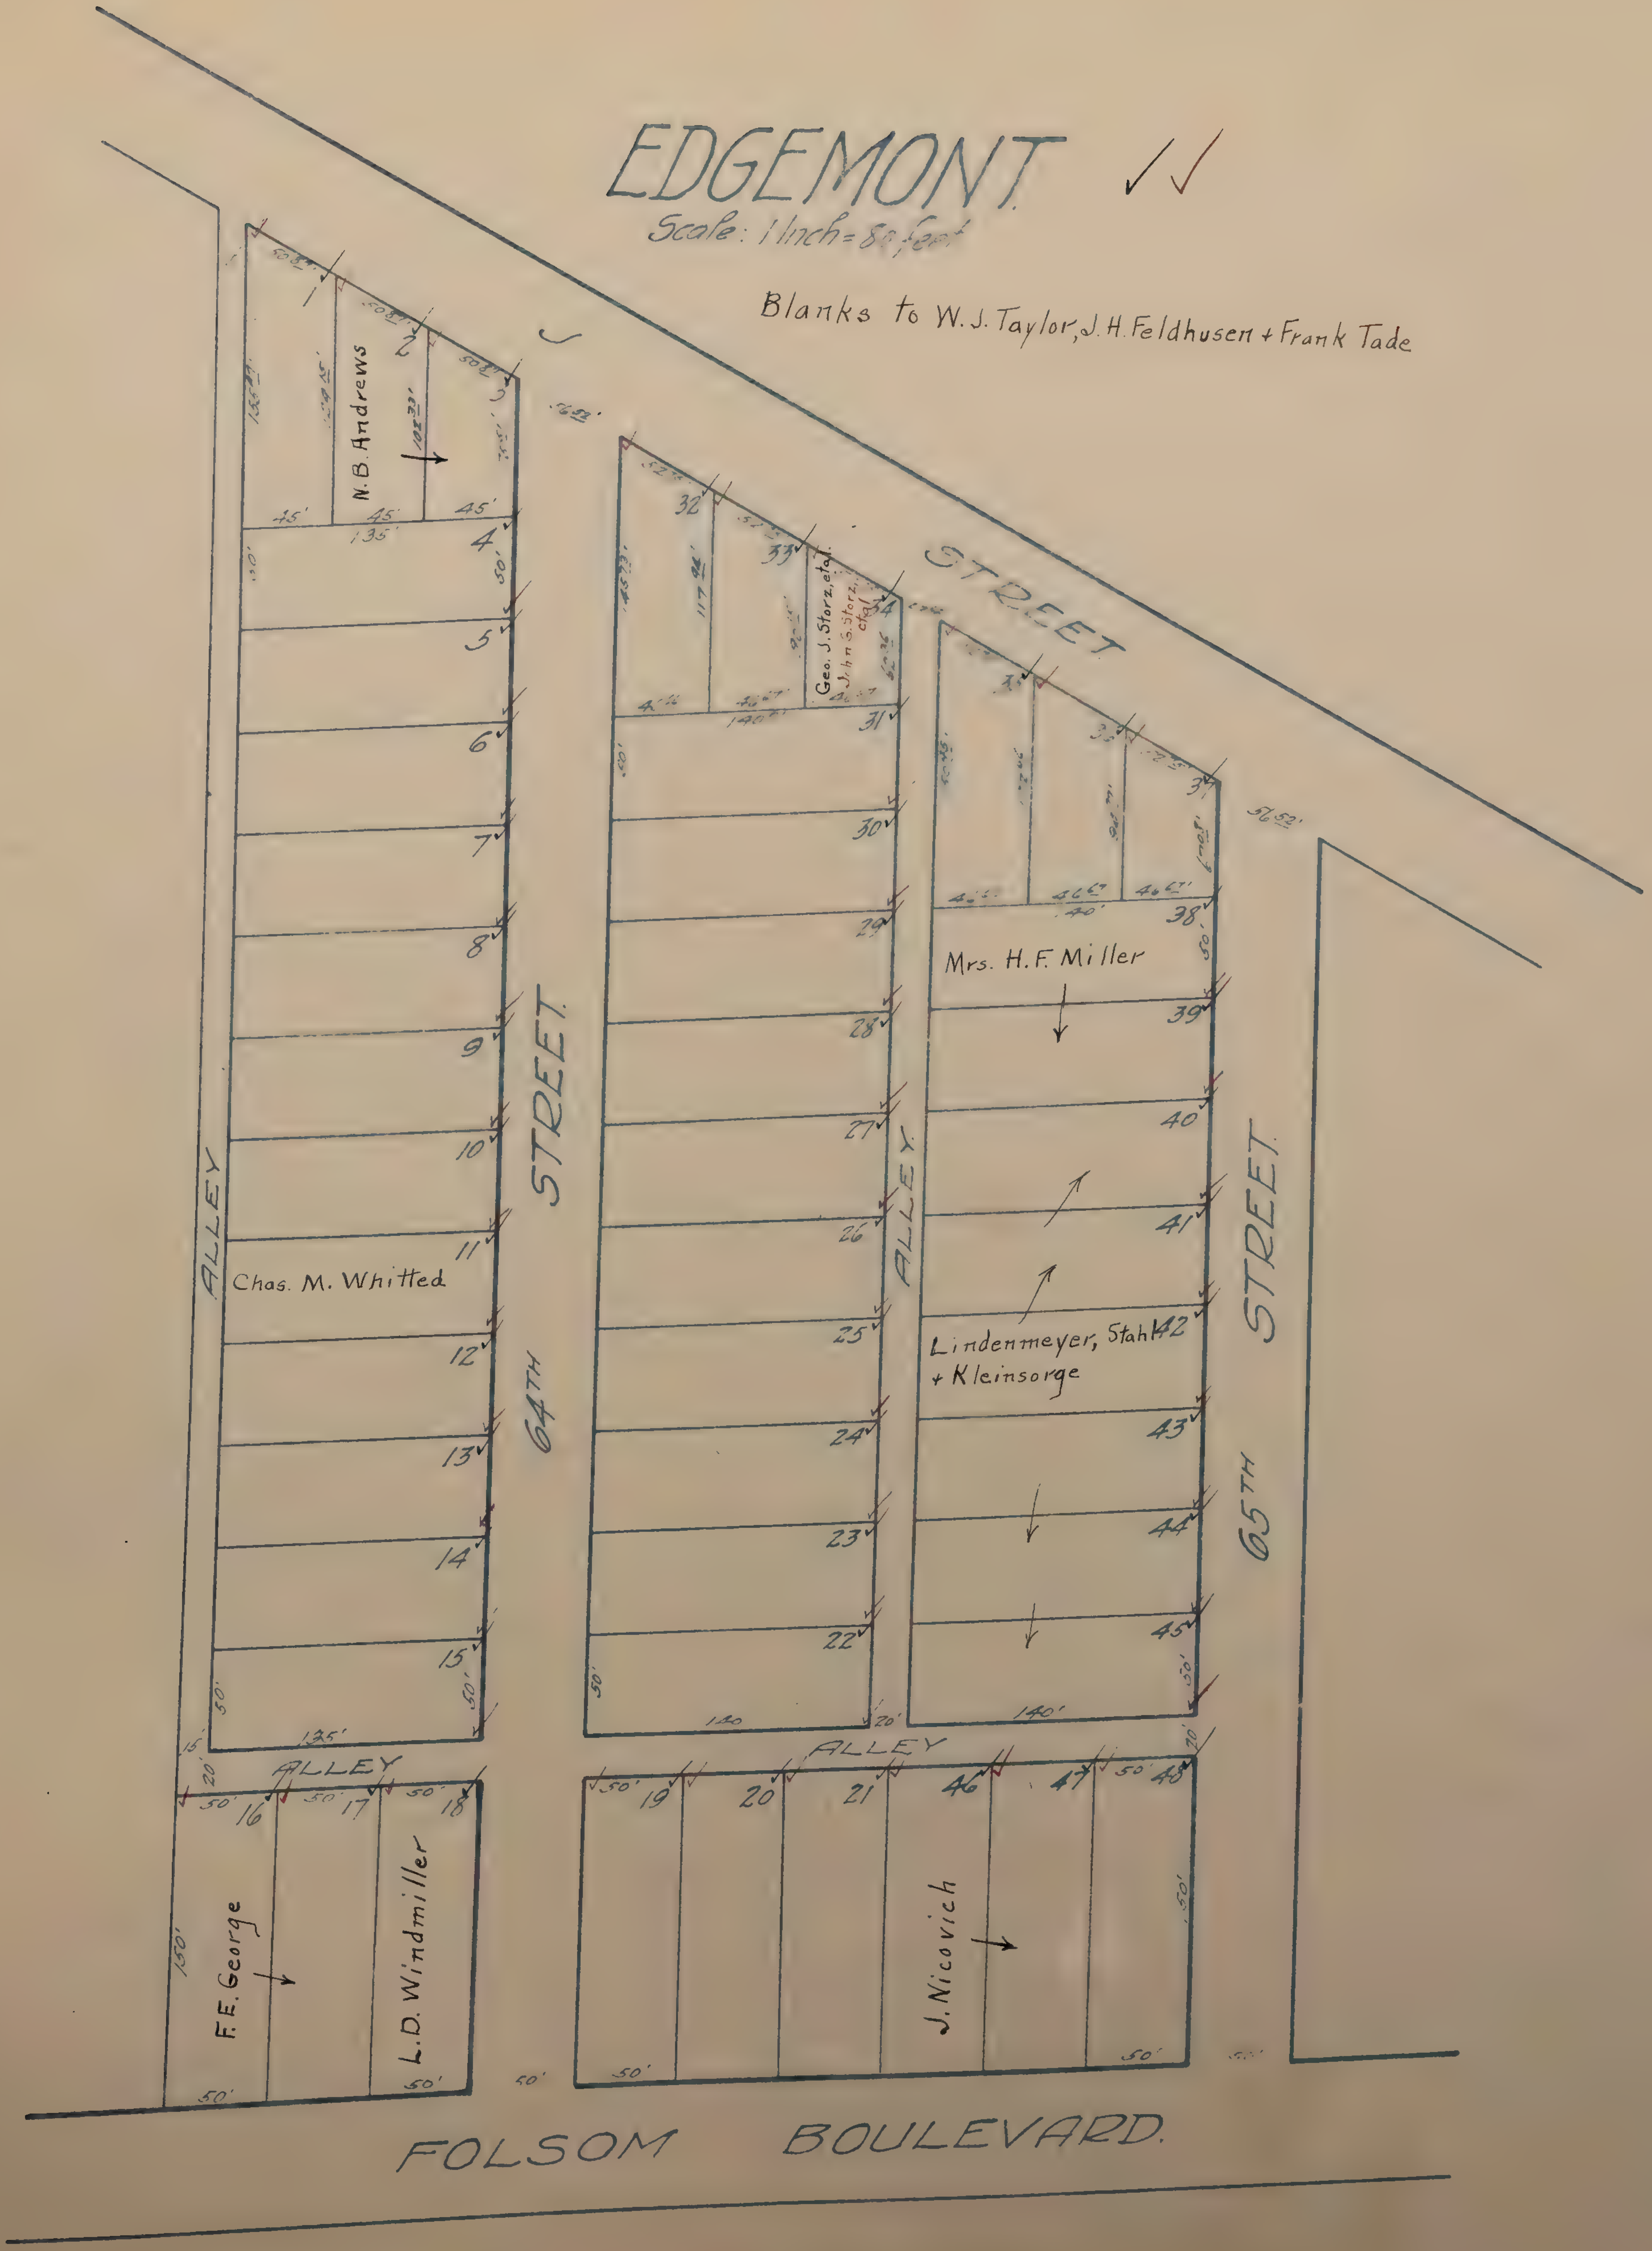
STREET
64TH STREET
65TH STREET
ALLEY
ALLEY
ALLEY
ALLEY
FOLSOM BOULEVARD
N. B. Andrews
Geo. J. Storz, et al.
John G. Storz, et al
Chas. M. Whitted
Mrs. H. F. Miller
Lindenmeyer, Stahl + Kleinsorge
F. E. George
L. D. Windmiller
J. Nicovich
1
2
3
4
5
6
7
8
9
10
11
12
13
14
15
16
17
18
19
20
21
22
23
24
25
26
27
28
29
30
31
32
33
34
35
36
37
38
39
40
41
42
43
44
45
46
47
48
45'
135'
125'
140'
50'
150'

6

ELLWOOD ✓

Scale: 1 Inch = 120 feet.

NOTE: Comprises all of Lots 7-10-11-14-15 of the Gage Tract.

Blanks to Emma Newsham

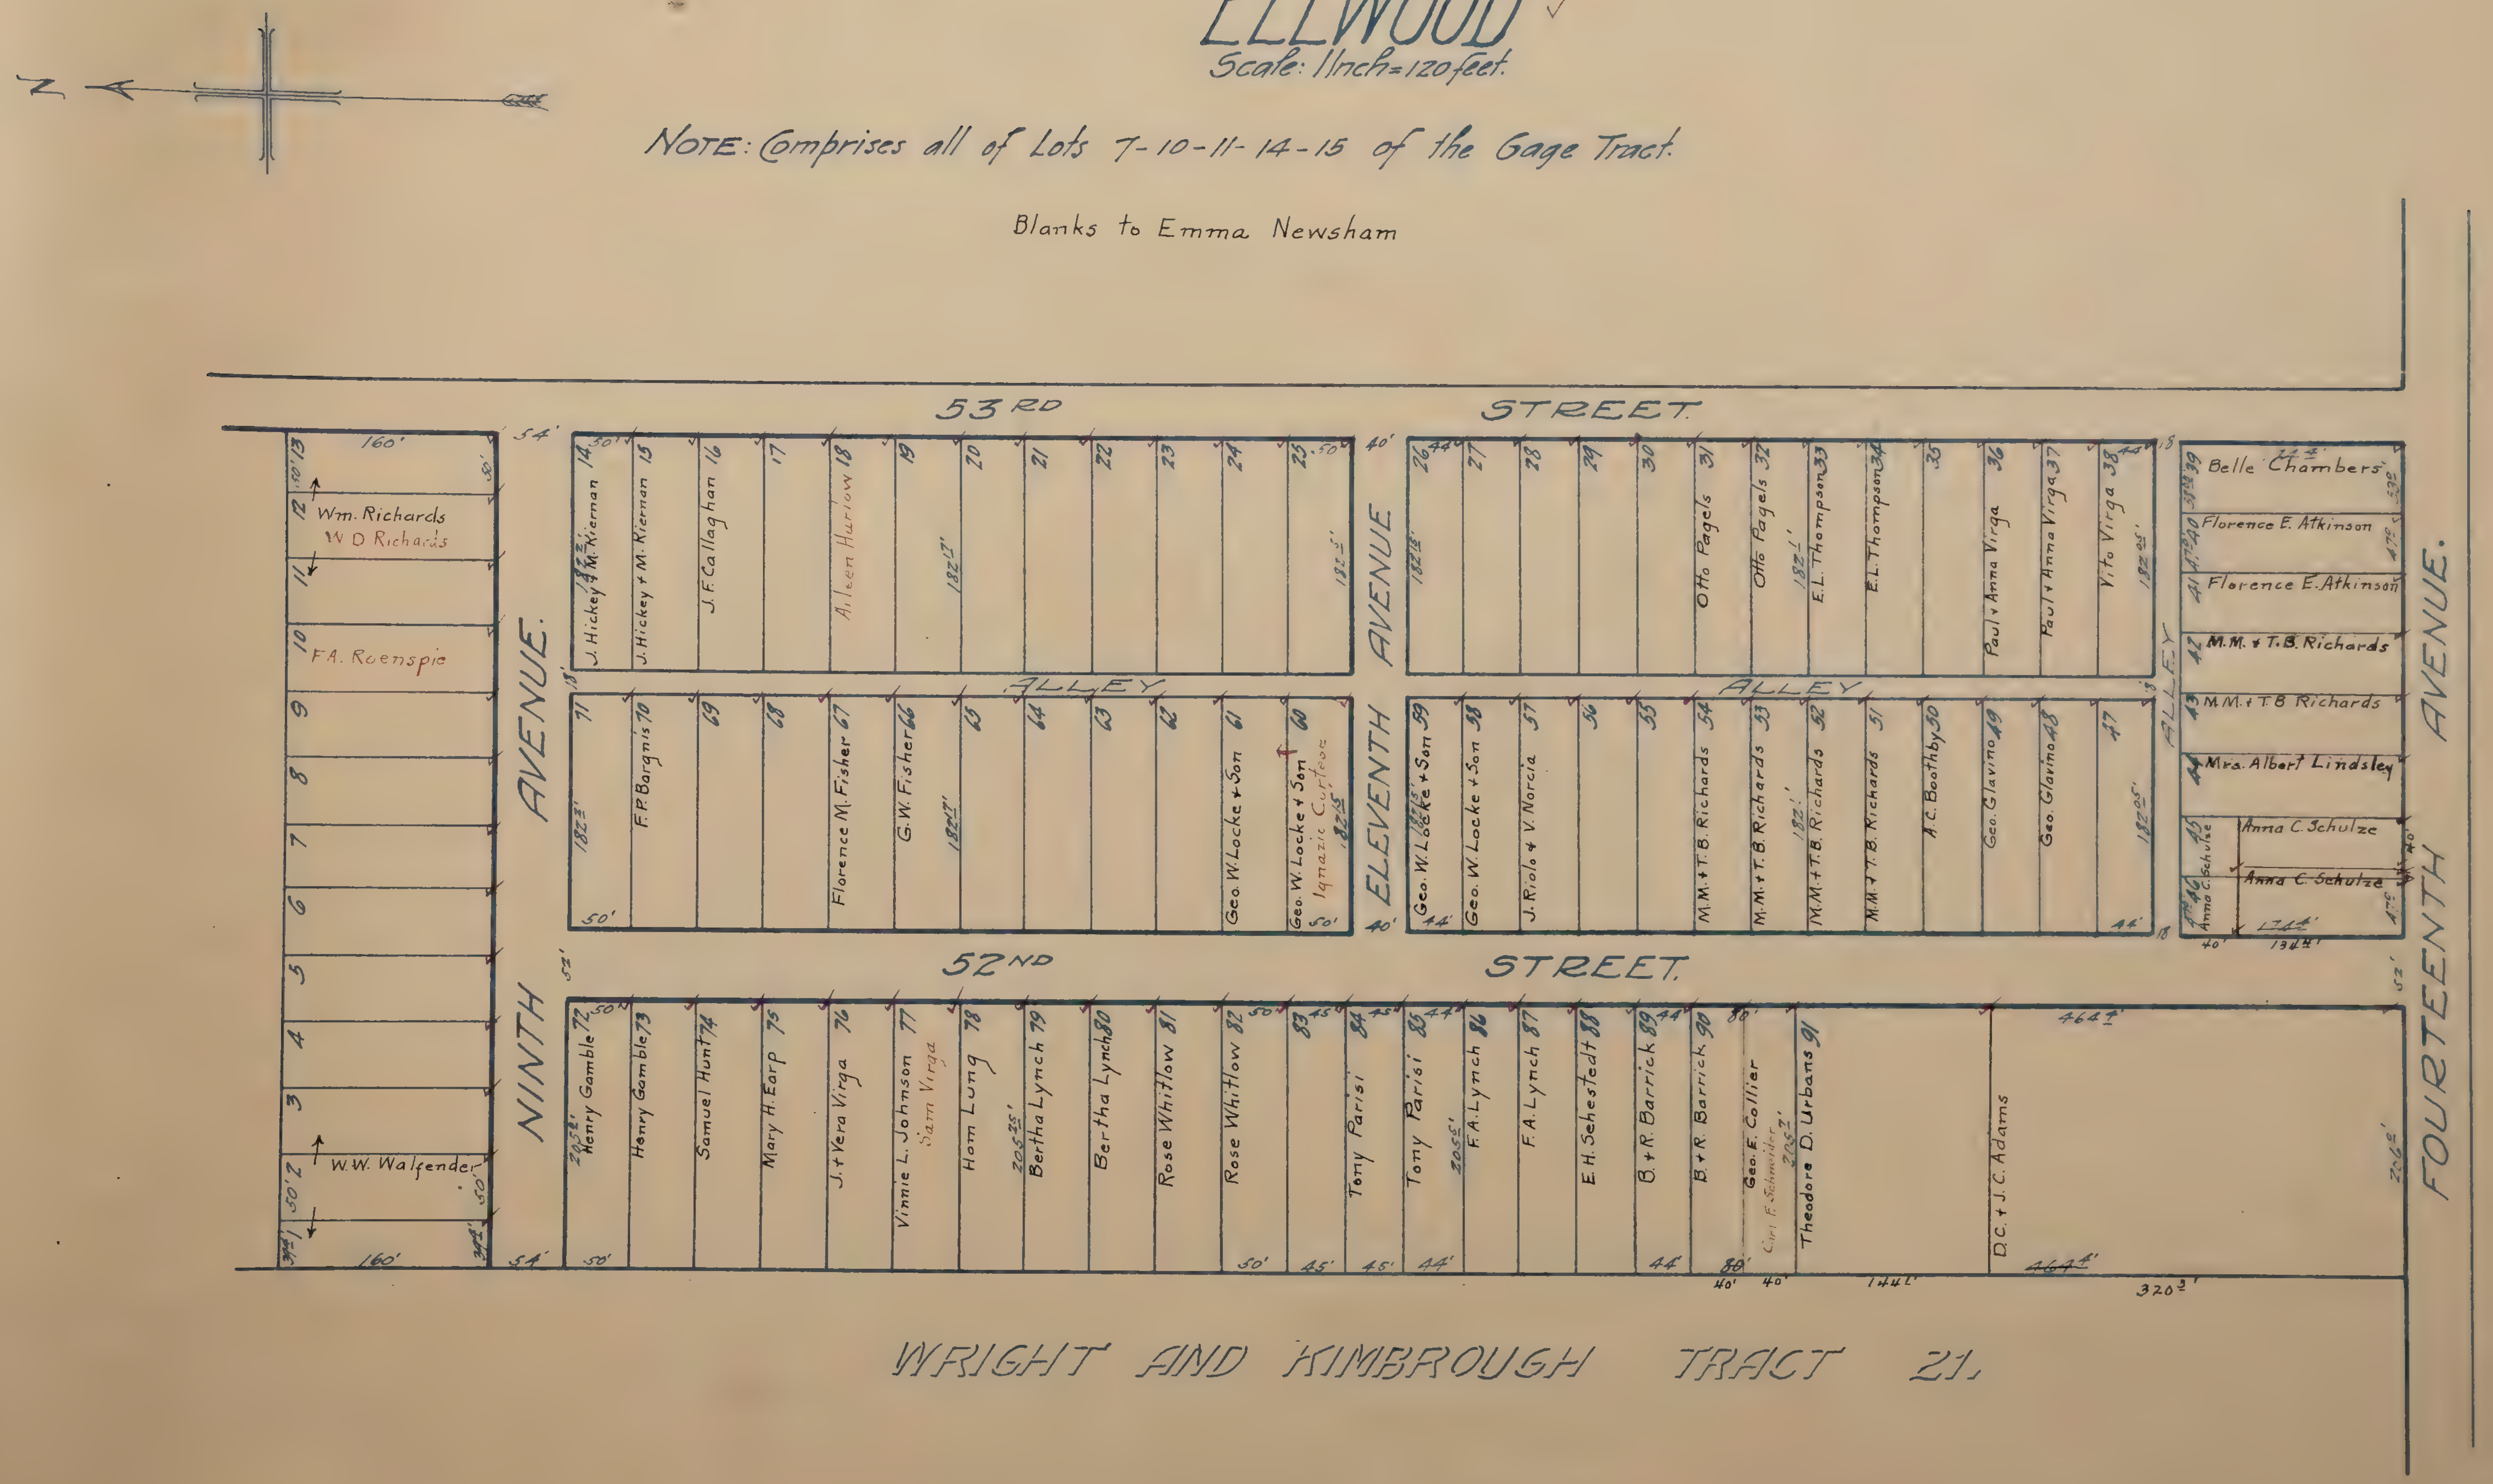

N
53RD STREET
52ND STREET
NINTH AVENUE.
ELEVENTH AVENUE
FOURTEENTH AVENUE.
ALLEY
ALLEY
ALLEY
WRIGHT AND KIMBROUGH TRACT 21.
160'
13
10'
50'
12 Wm. Richards
W D Richards
11
10 F.A. Roenspie
9
8
7
6
5
4
3
2 W.W. Walfender
50'
50'
1
37½'
37½'
160'
54'
54'
52'
18'
14 J. Hickey + M. Kiernan
15 J. Hickey + M. Kiernan
16 J. F. Callaghan
17
18 Aileen Hurlow
19
20
21
22
23
24
25
50'
182½'
182½'
182½'
71
70 F.P. Bargnis
69
68
67 Florence M. Fisher
66 G.W. Fisher
65
64
63
62
61 Geo. W. Locke + Son
60 Geo. W. Locke + Son
Ignazio Curtoso
182½'
182½'
182½'
50'
50'
40'
40'
26
27
28
29
30
31 Otto Pagels
32 Otto Pagels
33 E.L. Thompson
34 E.L. Thompson
35
36 Paul + Anna Virga
37 Paul + Anna Virga
38 Vito Virga
44'
44'
182½'
182¼'
182.05'
59 Geo. W. Locke + Son
58 Geo. W. Locke + Son
57 J. Riolo + V. Norcia
56
55
54 M.M. + T.B. Richards
53 M.M. + T.B. Richards
52 M.M. + T.B. Richards
51 M.M. + T.B. Richards
50 A.C. Boothby
49 Geo. Glavino
48 Geo. Glavino
47
182½'
182¼'
182.05'
44'
44'
18
18
18
39 Belle Chambers
40 Florence E. Atkinson
41 Florence E. Atkinson
42 M.M. + T.B. Richards
43 M.M. + T.B. Richards
44 Mrs. Albert Lindsley
45 Anna C. Schulze
Anna C. Schulze
46 Anna C. Schulze
Anna C. Schulze
174½'
134½'
40'
40'
47½'
47½'
53½'
72 Henry Gamble
73 Henry Gamble
74 Samuel Hunt
75 Mary H. Earp
76 J. + Vera Virga
77 Vinnie L. Johnson
Sam Virga
78 Hom Lung
79 Bertha Lynch
80 Bertha Lynch
81 Rose Whitlow
82 Rose Whitlow
83
84 Tony Parisi
85 Tony Parisi
86 F.A. Lynch
87 F.A. Lynch
88 E.H. Schestedt
89 B. + R. Barrick
90 B. + R. Barrick
Geo. E. Collier
Carl F. Schneider
91 Theodore D. Urbans
D.C. + J.C. Adams
205½'
205.25'
205½'
205½'
206'
50'
50'
50'
50'
45'
45'
45'
45'
44'
44'
44'
44
80'
80'
40'
40'
144'
464½'
464½'
320¾'

6

ELMHURST

Scale: 1 Inch = 120 feet.

Lots - 1 to 33
101 to 127

Lots marked H.J.G. to H.J.Goethe
" " C.M.G. .. C.M.Goethe

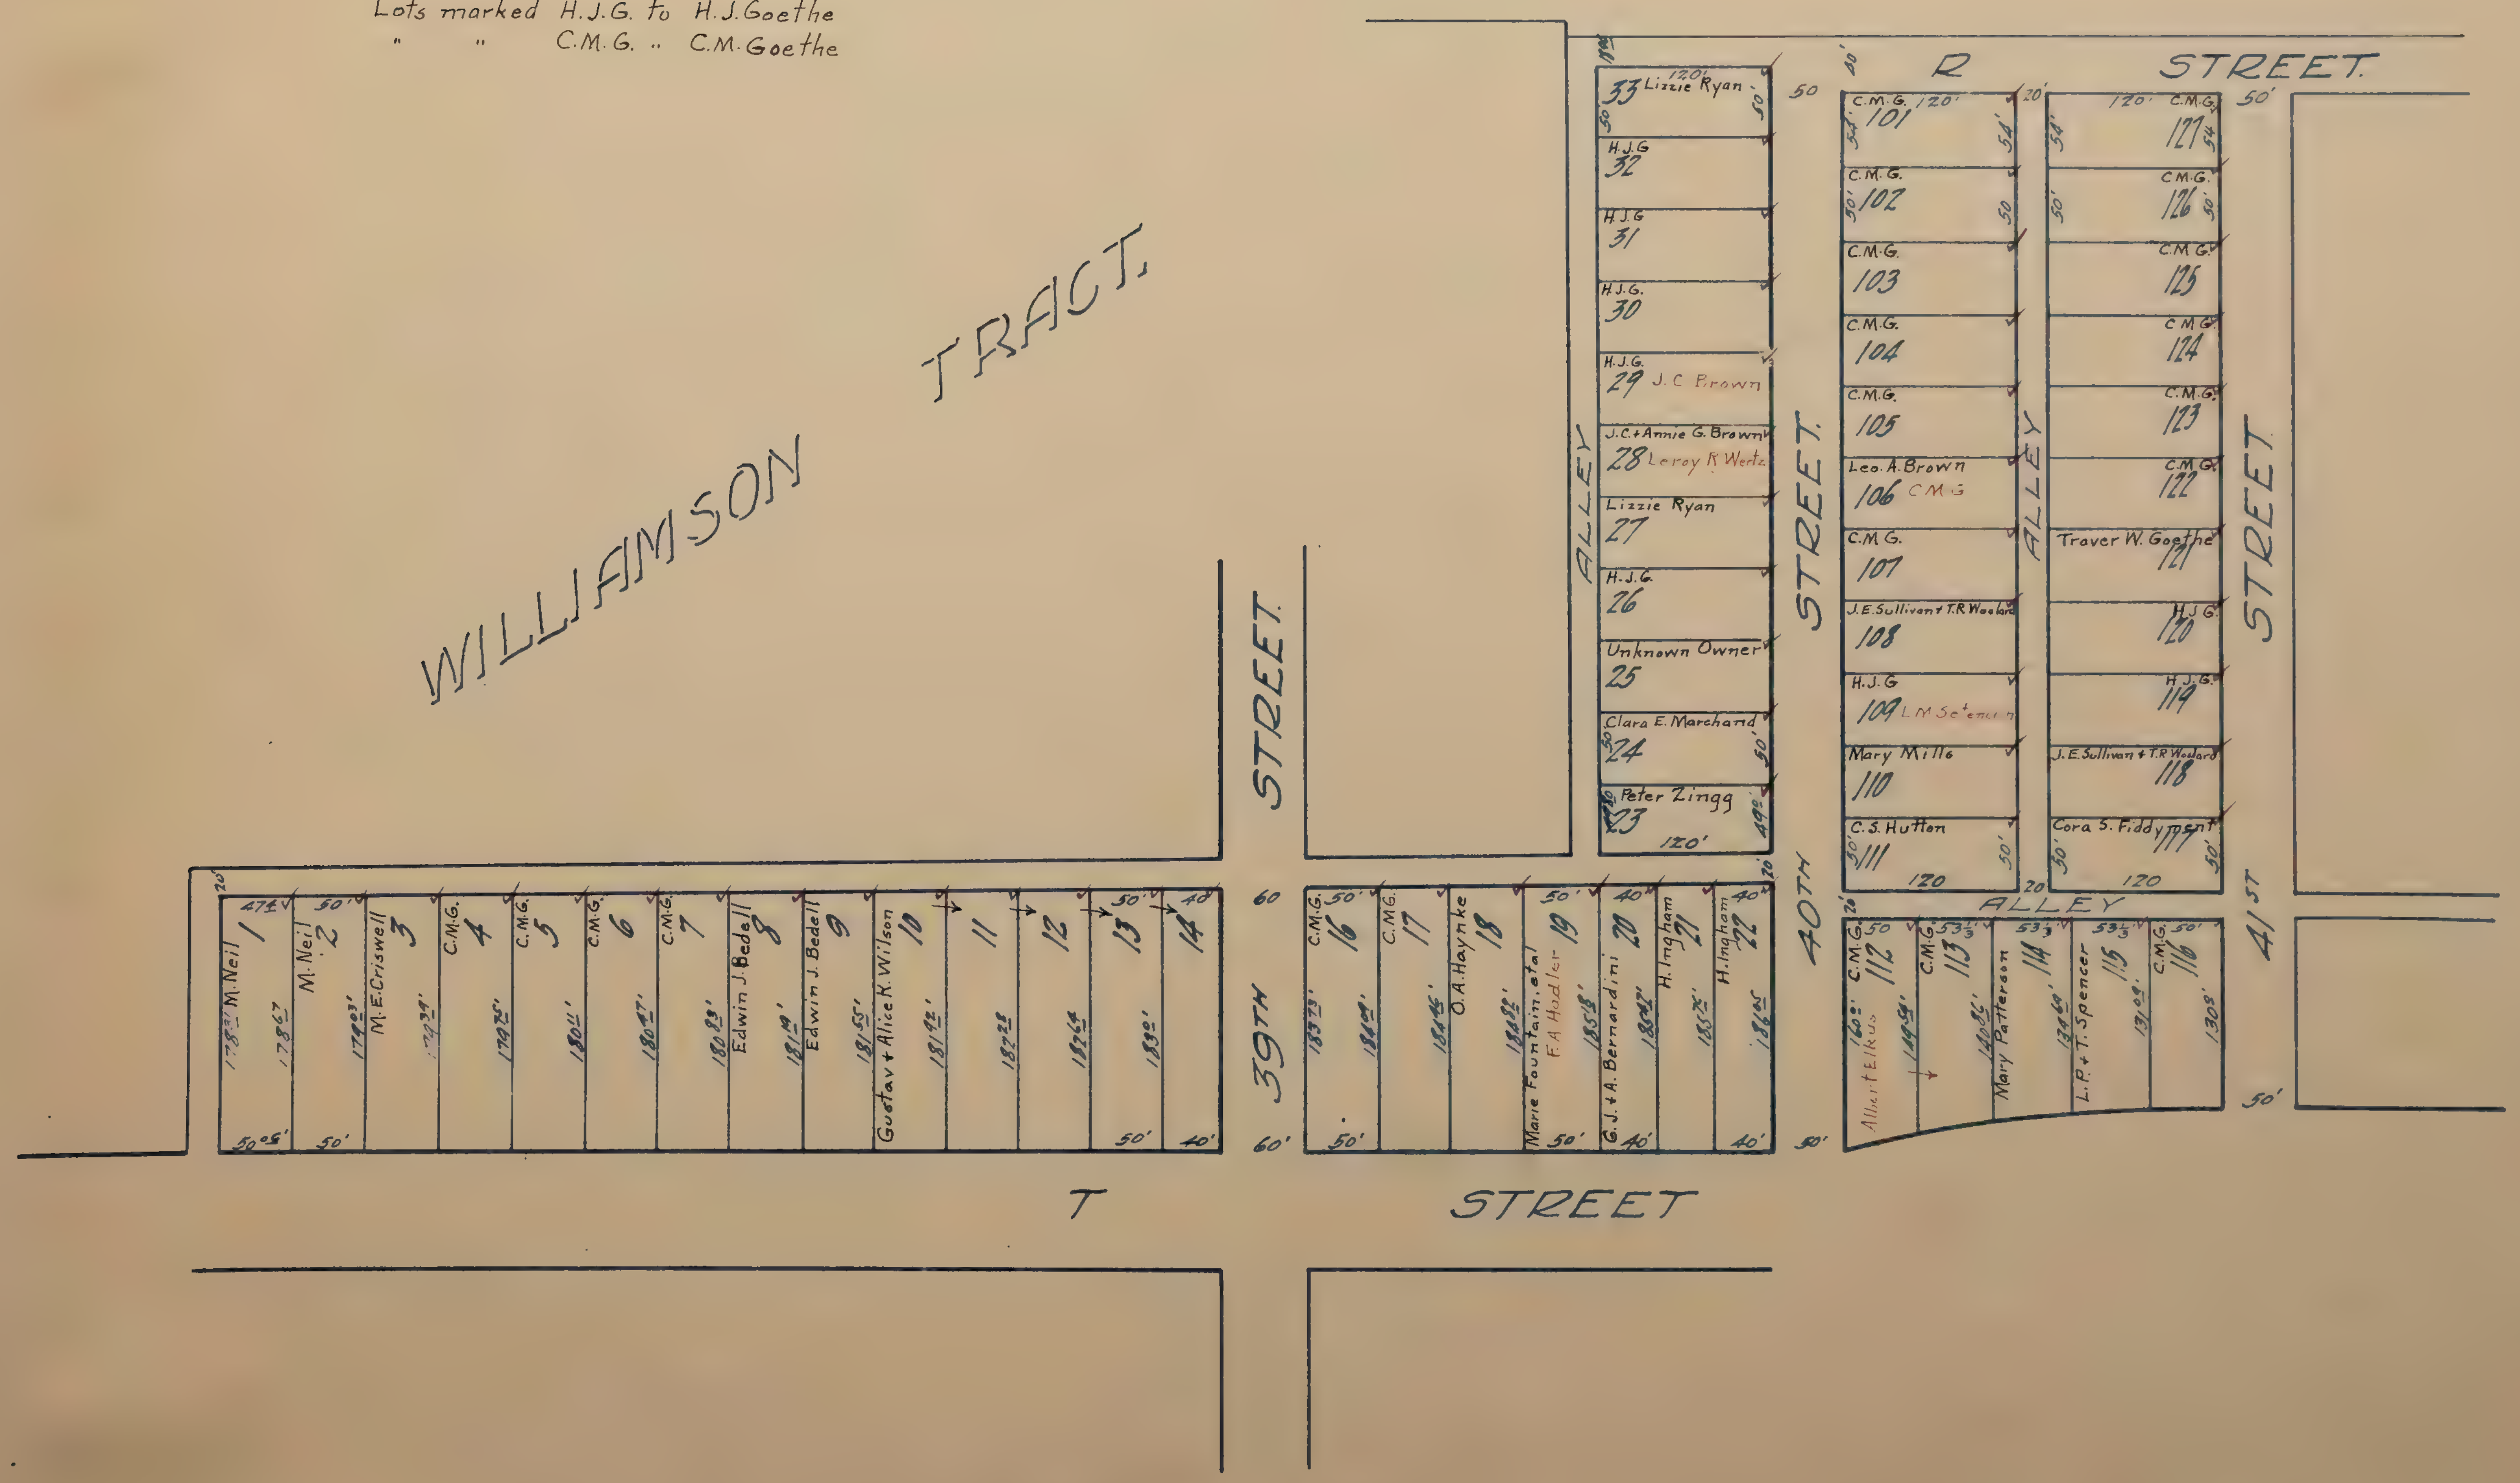

WILLIAMSON TRACT.
R STREET.
T STREET
39TH STREET.
40TH STREET
41ST STREET
ALLEY
ALLEY
ALLEY
M.Neil 1 178^{21}' 178^{67} $47\frac{1}{2}$ 50^{05}'
M.Neil 2 50' 179^{03}'
M.E.Criswell 3 179^{39}'
C.M.G. 4 179^{75}'
C.M.G. 5 180^{11}'
C.M.G. 6 180^{47}'
C.M.G. 7 180^{83}'
Edwin J. Bedell 8 181^{19}'
Edwin J. Bedell 9 181^{55}'
Gustav + Alice K. Wilson 10 181^{92}'
11 182^{28}
12 182^{64}
13 183^{00}' 50'
14 40'
60 60'
C.M.G. 16 50' 183^{73}' 184^{09}'
C.M.G. 17 184^{45}'
O.A.Haynke 18 184^{82}'
Marie Fountain, et al F.A.Hadler 19 50' 185^{18}'
G.J. + A. Bernardini 20 40' 185^{54}'
H.Ingham 21 185^{90}
H.Ingham 22 40' 186^{26}
Peter Zingg 23 120' 49'
Clara E. Marchand 24 50'
Unknown Owner 25
H.J.G. 26
Lizzie Ryan 27
J.C. + Annie G. Brown 28 Leroy R Wertz
H.J.G. 29 J.C Brown
H.J.G. 30
H.J.G 31
H.J.G 32
33 Lizzie Ryan 120' 50 50'
C.M.G. 101 120' 54' 54'
C.M.G. 102 50' 50
C.M.G. 103
C.M.G. 104
C.M.G. 105
Leo. A. Brown 106 C.M.G
C.M.G. 107
J.E.Sullivan + T.R.Woolard 108
H.J.G 109 L.M.Seterun
Mary Mills 110
C.S.Hutton 111 30' 50' 120
Albert Elkus C.M.G. 112 50 160^{00} 149^{59}
C.M.G. 113 $53\frac{1}{3}$ 140^{86}'
Mary Patterson 114 $53\frac{1}{3}$ 134^{69}'
L.P. + T. Spencer 115 $53\frac{1}{3}$ 131^{09}
C.M.G. 116 50' 130^{8}'
Cora S. Fiddyment 117 30' 50' 120
J.E.Sullivan + T.R.Woolard 118
H.J.G. 119
H.J.G. 120
Traver W. Goethe 121
C.M.G. 122
C.M.G. 123
C.M.G. 124
C.M.G. 125
C.M.G. 126 50' 50'
C.M.G. 127 120' 54' 54
20' 20 50 50' 20 70 60 60'

6

ELMHURST. ✓

Scale. 1 Inch = 120 feet.

Lots marked H. J. G. to H. J Goethe
" " C. M. G. " C. M. Goethe
" " C. S. G. " C. S. Goethe
" " T. W. G. " T. W. Goethe

Lots: 201 to 527

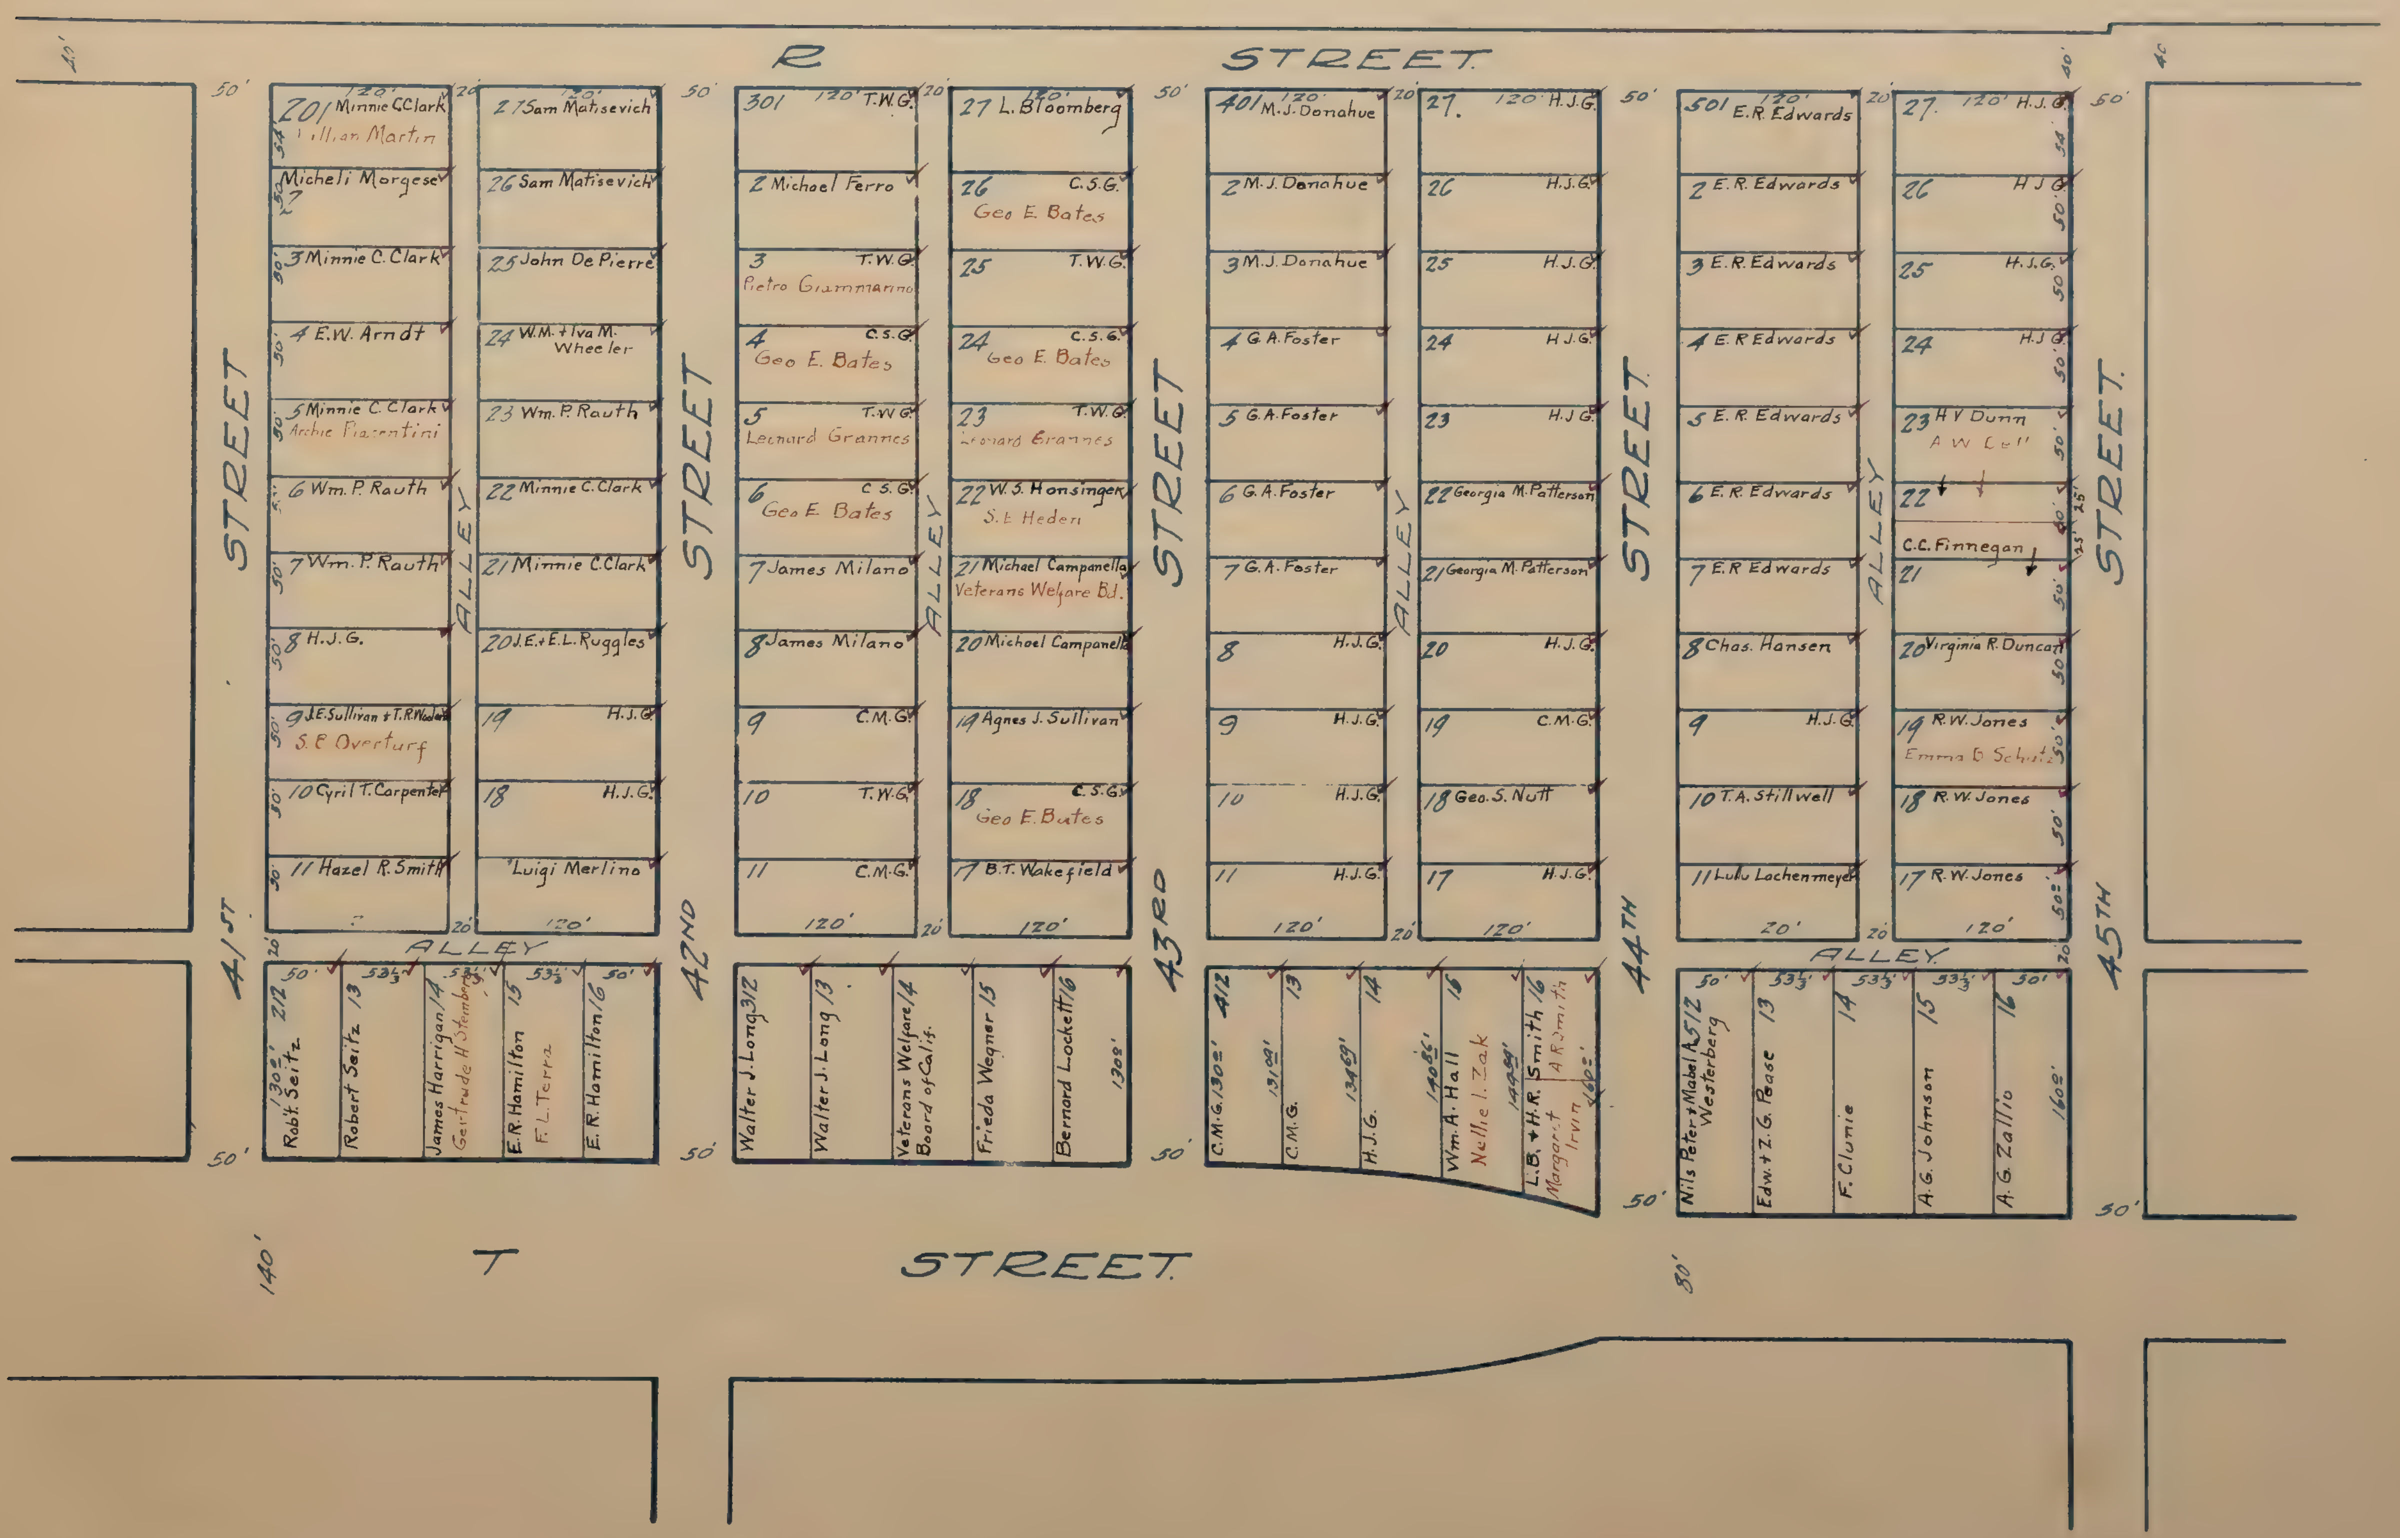
R STREET
T STREET
41ST STREET
42ND STREET
43RD STREET
44TH STREET
45TH STREET
ALLEY
201 Minnie C. Clark
Lillian Martin
Micheli Morgese
3 Minnie C. Clark
4 E. W. Arndt
5 Minnie C. Clark
Archie Piacentini
6 Wm. P. Rauth
7 Wm. P. Rauth
8 H. J. G.
9 J. E. Sullivan + T. R. Woodard
S. E. Overturf
10 Cyril T. Carpenter
11 Hazel R. Smith
27 Sam Matisevich
26 Sam Matisevich
25 John De Pierre
24 W. M. + Iva M. Wheeler
23 Wm. P. Rauth
22 Minnie C. Clark
21 Minnie C. Clark
20 J. E. + E. L. Ruggles
19 H. J. G.
18 H. J. G.
Luigi Merlino
212 Rob't. Seitz
13 Robert Seitz
James Harrigan 14
Gertrude H. Stemberg
15 E. R. Hamilton
F. L. Terra
E. R. Hamilton 16
301 T. W. G.
2 Michael Ferro
3 T. W. G.
Pietro Giammarino
4 C. S. G.
Geo E. Bates
5 T. W. G.
Leonard Grannes
6 C. S. G.
Geo E. Bates
7 James Milano
8 James Milano
9 C. M. G.
10 T. W. G.
11 C. M. G.
27 L. Bloomberg
26 C. S. G.
Geo E. Bates
25 T. W. G.
24 C. S. G.
Geo E. Bates
23 T. W. G.
Leonard Grannes
22 W. S. Honsinger
S. E. Heden
21 Michael Campanella
Veterans Welfare Bd.
20 Michael Campanella
19 Agnes J. Sullivan
18 C. S. G.
Geo E. Bates
17 B. T. Wakefield
Walter J. Long 312
Walter J. Long 13
Veterans Welfare 14
Board of Calif.
Frieda Wegner 15
Bernard Lockett 16
401 M. J. Donahue
2 M. J. Donahue
3 M. J. Donahue
4 G. A. Foster
5 G. A. Foster
6 G. A. Foster
7 G. A. Foster
8 H. J. G.
9 H. J. G.
10 H. J. G.
11 H. J. G.
27 H. J. G.
26 H. J. G.
25 H. J. G.
24 H. J. G.
23 H. J. G.
22 Georgia M. Patterson
21 Georgia M. Patterson
20 H. J. G.
19 C. M. G.
18 Geo. S. Nutt
17 H. J. G.
412 C. M. G.
13 C. M. G.
14 H. J. G.
15 Wm. A. Hall
Nellie I. Zak
16 L. B. + H. R. Smith
A R Smith
Margaret Irvin
501 E. R. Edwards
2 E. R. Edwards
3 E. R. Edwards
4 E. R. Edwards
5 E. R. Edwards
6 E. R. Edwards
7 E. R. Edwards
8 Chas. Hansen
9 H. J. G.
10 T. A. Stillwell
11 Lulu Lachenmeyer
27 H. J. G.
26 H. J. G.
25 H. J. G.
24 H. J. G.
23 H. V. Dunn
A. W. Cell
22
C. C. Finnegan
21
20 Virginia R. Duncan
19 R. W. Jones
Emma B. Schutz
18 R. W. Jones
17 R. W. Jones
Nils Peter + Mabel A. 512
Westerberg
13 Edw. + Z. G. Pease
14 F. Clunie
15 A. G. Johnson
16 A. G. Zallio
120'
20'
50'
53⅓'
130'
131'
134'
140'
144'
160'
130'
25'
80'
140'
40'

6

ELMHURST

Scale: 1 Inch = 120 feet.

Lots marked H. J. G. to H. J. Goethe
" " C. M. G. " C. M. Goethe

Lots:- 601 to 627
701 " 727
801 " 827
901 " 927

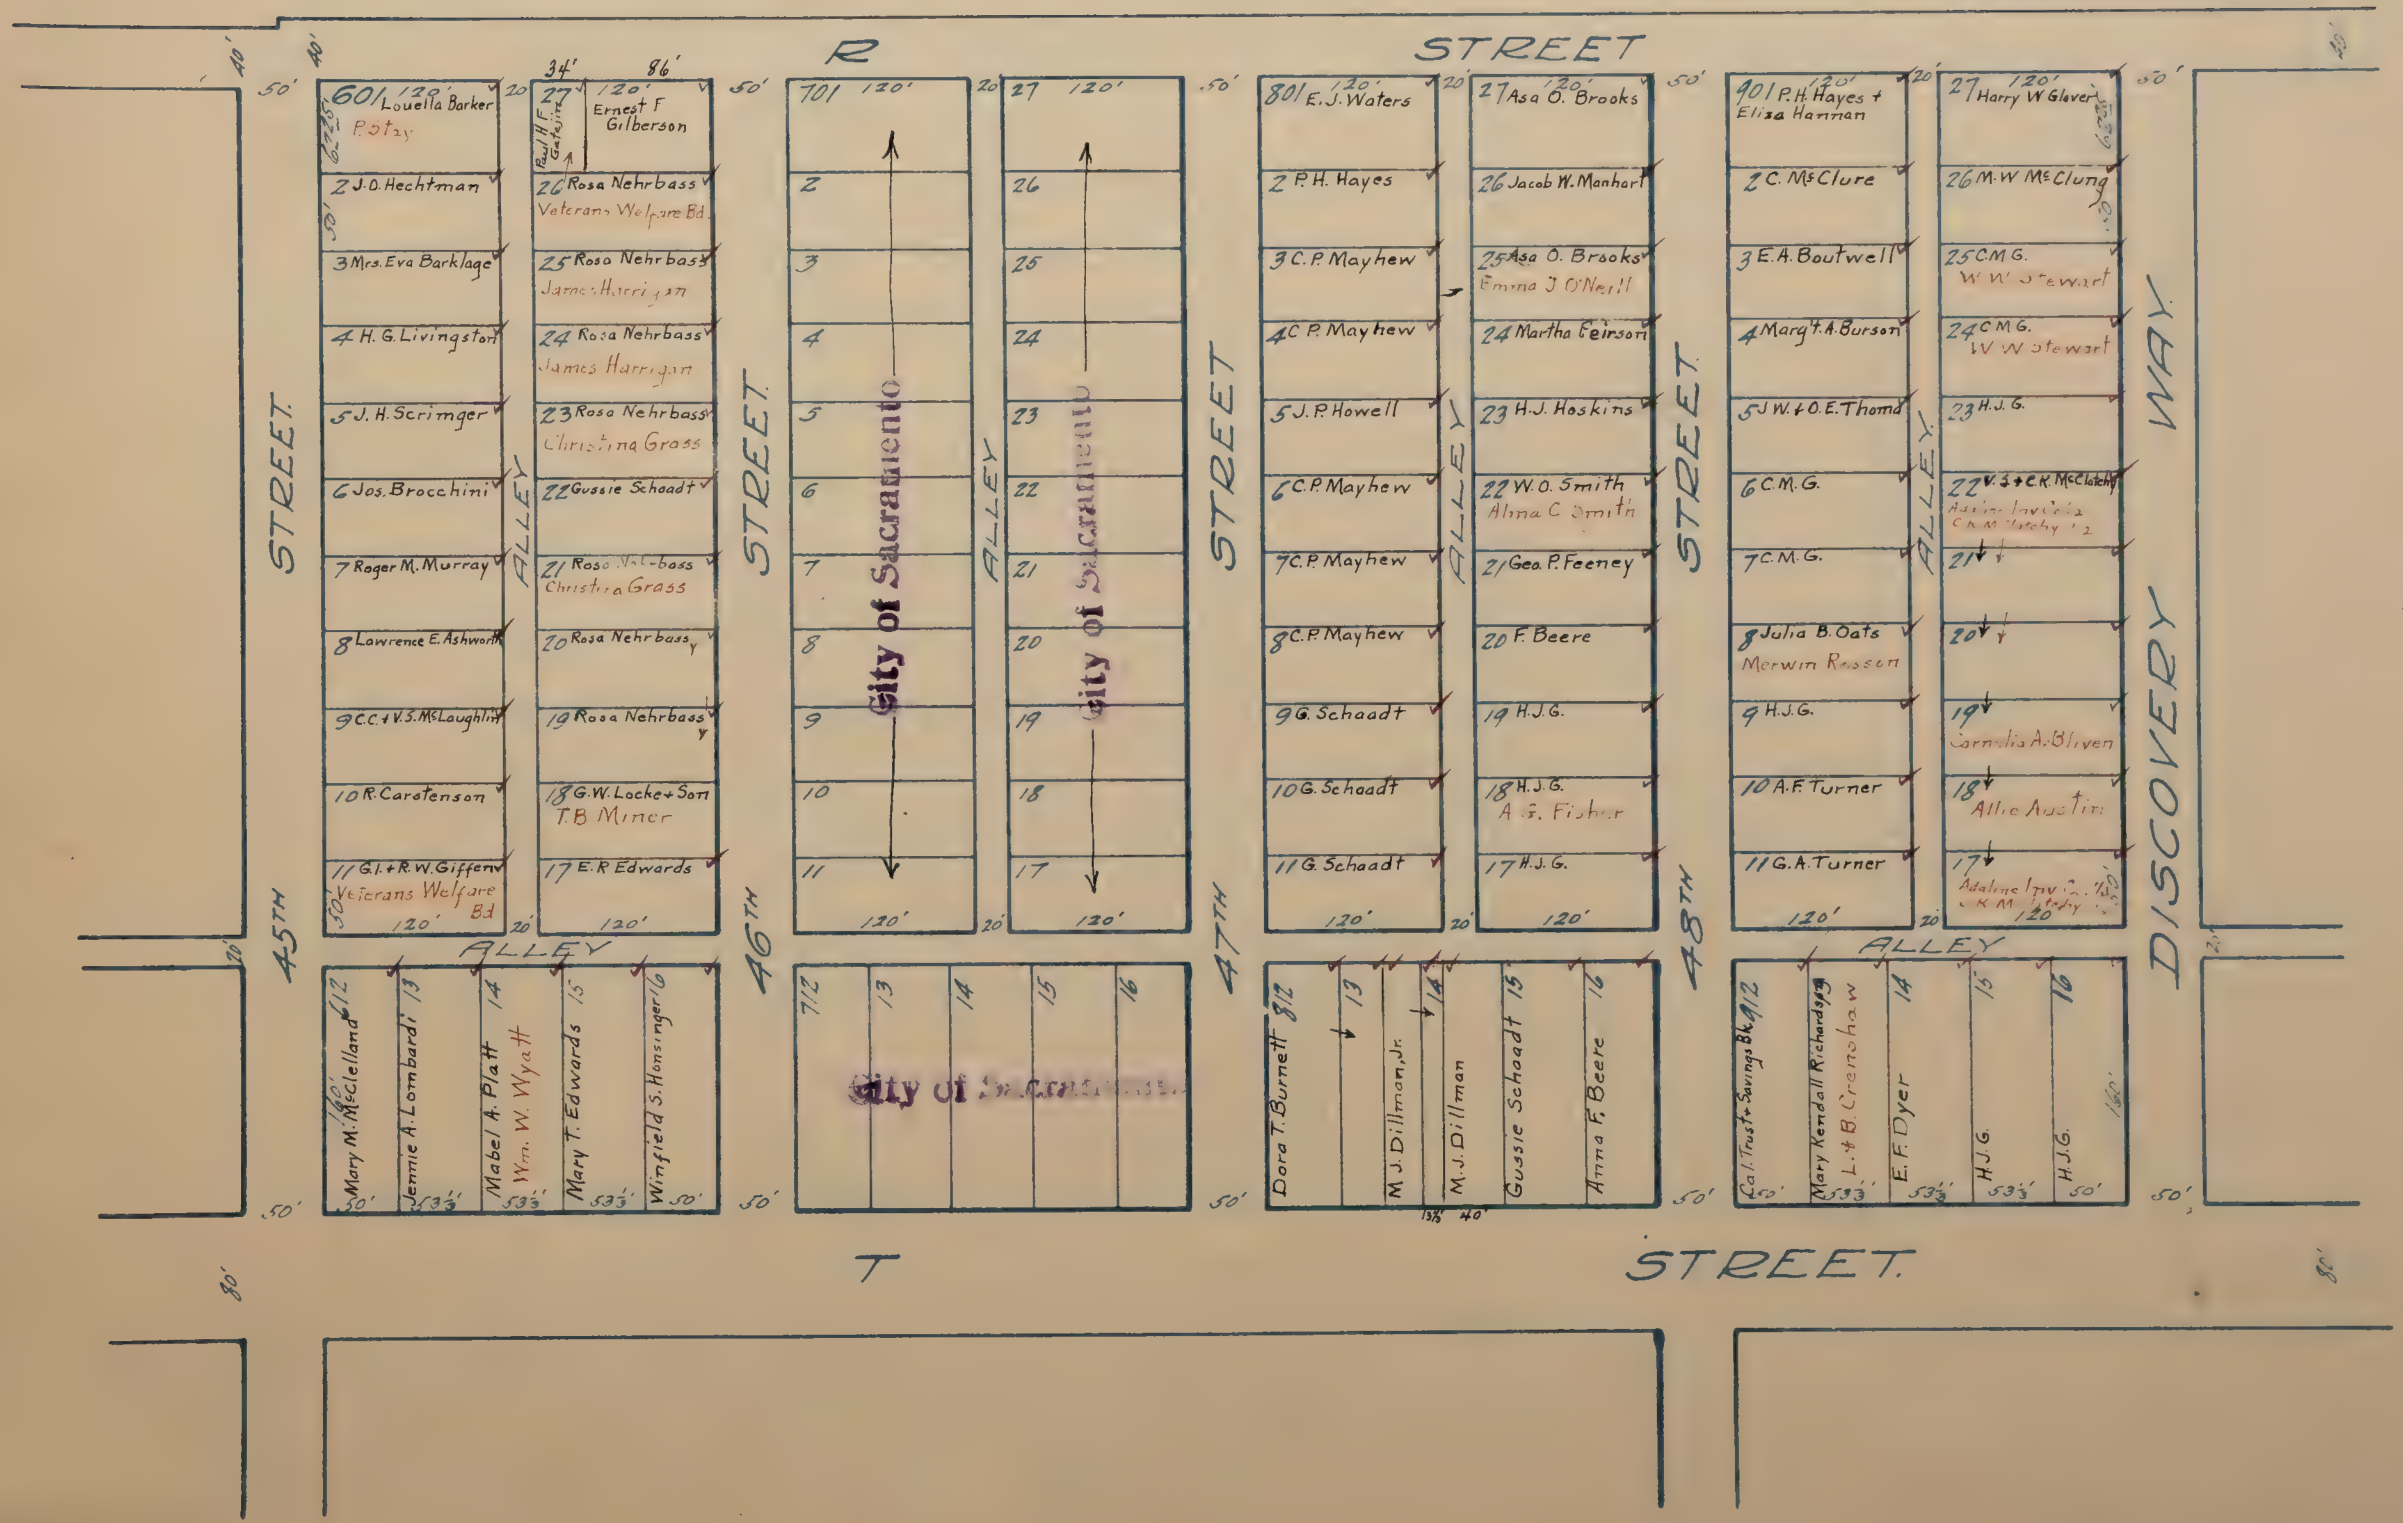

R STREET
T STREET.
45TH STREET.
46TH STREET.
47TH STREET
48TH STREET.
DISCOVERY WAY
ALLEY
City of Sacramento
601 Louella Barker P. Stay
2 J. O. Hechtman
3 Mrs. Eva Barklage
4 H. G. Livingston
5 J. H. Scrimger
6 Jos. Brocchini
7 Roger M. Murray
8 Lawrence E. Ashworth
9 C.C. + V.S. McLaughlin
10 R. Carstenson
11 G.I. + R.W. Giffen Veterans Welfare Bd
27 Paul H. F. Gatejen
Ernest F Gilberson
26 Rosa Nehrbass Veterans Welfare Bd.
25 Rosa Nehrbass James Harrigan
24 Rosa Nehrbass James Harrigan
23 Rosa Nehrbass Christina Grass
22 Gussie Schaadt
21 Rosa Nehrbass Christina Grass
20 Rosa Nehrbass
19 Rosa Nehrbass
18 G.W. Locke + Son T.B. Miner
17 E.R Edwards
612 Mary M. McClelland
13 Jennie A. Lombardi
14 Mabel A. Platt Wm. W. Wyatt
15 Mary T. Edwards
16 Winfield S. Honsinger
701
712
801 E. J. Waters
2 P.H. Hayes
3 C.P. Mayhew
4 C.P. Mayhew
5 J.P. Howell
6 C.P. Mayhew
7 C.P. Mayhew
8 C.P. Mayhew
9 G. Schaadt
10 G. Schaadt
11 G. Schaadt
27 Asa O. Brooks
26 Jacob W. Manhart
25 Asa O. Brooks Emma J O'Neill
24 Martha Feirson
23 H.J. Hoskins
22 W.O. Smith Alma C Smith
21 Geo. P. Feeney
20 F. Beere
19 H.J.G.
18 H.J.G. A. G. Fisher
17 H.J.G.
812 Dora T. Burnett
13 M. J. Dillman, Jr.
14 M. J. Dillman
15 Gussie Schaadt
16 Anna F. Beere
901 P.H. Hayes + Eliza Hannan
2 C. McClure
3 E.A. Boutwell
4 Marg't. A. Burson
5 J.W. + O.E. Thomd
6 C.M.G.
7 C.M.G.
8 Julia B. Oats Merwin Rosson
9 H.J.G.
10 A.F. Turner
11 G.A. Turner
27 Harry W Glover
26 M.W McClung
25 C.M.G. W. W. Stewart
24 C.M.G. W. W. Stewart
23 H.J.G.
22 V.S. + C.K. McClatchy
21
20
19 Cornelia A. Bliven
18 Allie Austin
17 Adaline Inv Co. ½ C.K. McClatchy ½
912 Cal. Trust + Savings Bk.
13 Mary Kendall Richardson L. + B. Crenshaw
14 E.F. Dyer
15 H.J.G.
16 H.J.G.
120'
50'
20'
40'
34'
86'
53⅓'
160'
80'

6

ELMHURST

Scale: 1 Inch=120 feet.

Lots marked H.J.G. to H.J. Goethe
" " C.M.G. " C.M. Goethe

Lots:- 1001 to 1027
" 1101 " 1127
1201 " 1227

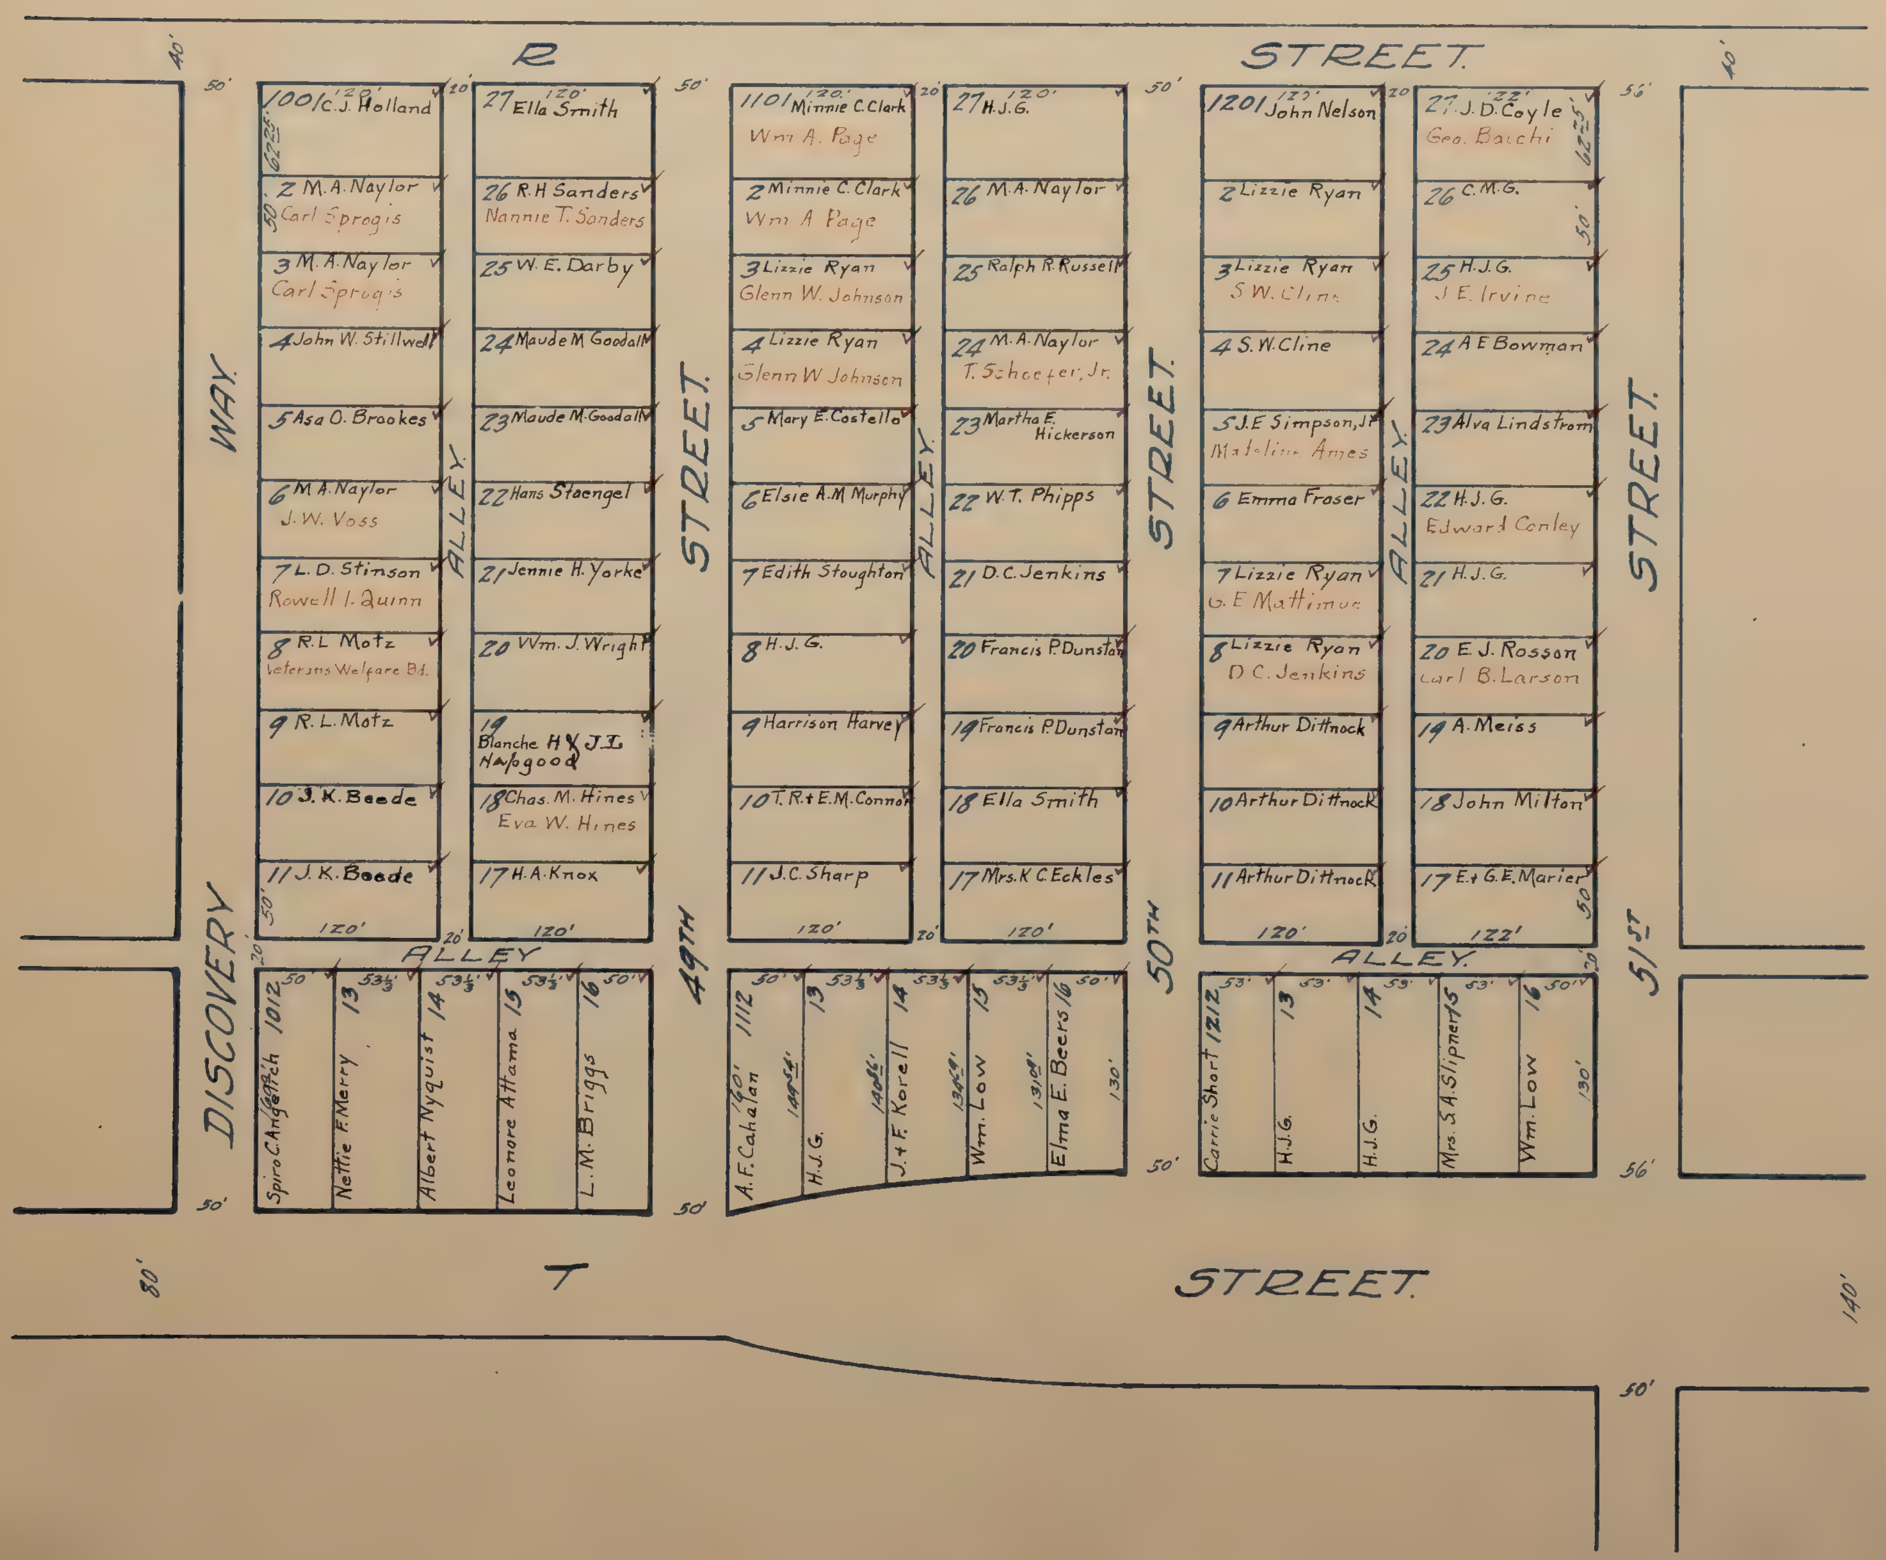

R STREET
T STREET
DISCOVERY WAY
49TH STREET
50TH STREET
51ST STREET
ALLEY
1001 C.J. Holland
2 M.A. Naylor Carl Sprogis
3 M.A. Naylor Carl Sprogis
4 John W. Stillwell
5 Asa O. Brookes
6 M.A. Naylor J.W. Voss
7 L.D. Stinson Rowell I. Quinn
8 R.L. Motz Veterans Welfare Bd.
9 R.L. Motz
10 J.K. Beede
11 J.K. Beede
27 Ella Smith
26 R.H Sanders Nannie T. Sanders
25 W.E. Darby
24 Maude M Goodall
23 Maude M. Goodall
22 Hans Staengel
21 Jennie H. Yorke
20 Wm. J. Wright
19 Blanche H & J.L. Hapgood
18 Chas. M. Hines Eva W. Hines
17 H.A. Knox
1012 Spiro C. Angelich
13 Nettie F. Merry
14 Albert Nyquist
15 Leonore Attama
16 L.M. Briggs
1101 Minnie C. Clark Wm A. Page
2 Minnie C. Clark Wm A Page
3 Lizzie Ryan Glenn W. Johnson
4 Lizzie Ryan Glenn W Johnson
5 Mary E. Costello
6 Elsie A.M Murphy
7 Edith Stoughton
8 H.J.G.
9 Harrison Harvey
10 T.R. + E.M. Connor
11 J.C. Sharp
27 H.J.G.
26 M.A. Naylor
25 Ralph R. Russell
24 M.A. Naylor T. Schaefer, Jr.
23 Martha E. Hickerson
22 W.T. Phipps
21 D.C. Jenkins
20 Francis P. Dunstan
19 Francis P. Dunstan
18 Ella Smith
17 Mrs. K C. Eckles
1112 A.F. Cahalan
13 H.J.G.
14 J. + F. Korell
15 Wm. Low
16 Elma E. Beers
1201 John Nelson
2 Lizzie Ryan
3 Lizzie Ryan S.W. Cline
4 S.W. Cline
5 J.E Simpson, Jr Madeline Ames
6 Emma Fraser
7 Lizzie Ryan G.E Mattimoe
8 Lizzie Ryan D.C. Jenkins
9 Arthur Dittnock
10 Arthur Dittnock
11 Arthur Dittnock
27 J.D. Coyle Geo. Bacchi
26 C.M.G.
25 H.J.G. J.E. Irvine
24 A E Bowman
23 Alva Lindstrom
22 H.J.G. Edward Conley
21 H.J.G.
20 E.J. Rosson Carl B. Larson
19 A. Meiss
18 John Milton
17 E. + G.E. Marier
1212 Carrie Short
13 H.J.G.
14 H.J.G.
15 Mrs. S.A. Slipners
16 Wm. Low
120'
122'
50'
53 1/3'
53'
56'
20'
40'
80'
130'
140'

6

ELMHURST ✓

Scale: 1 Inch = 120 feet.

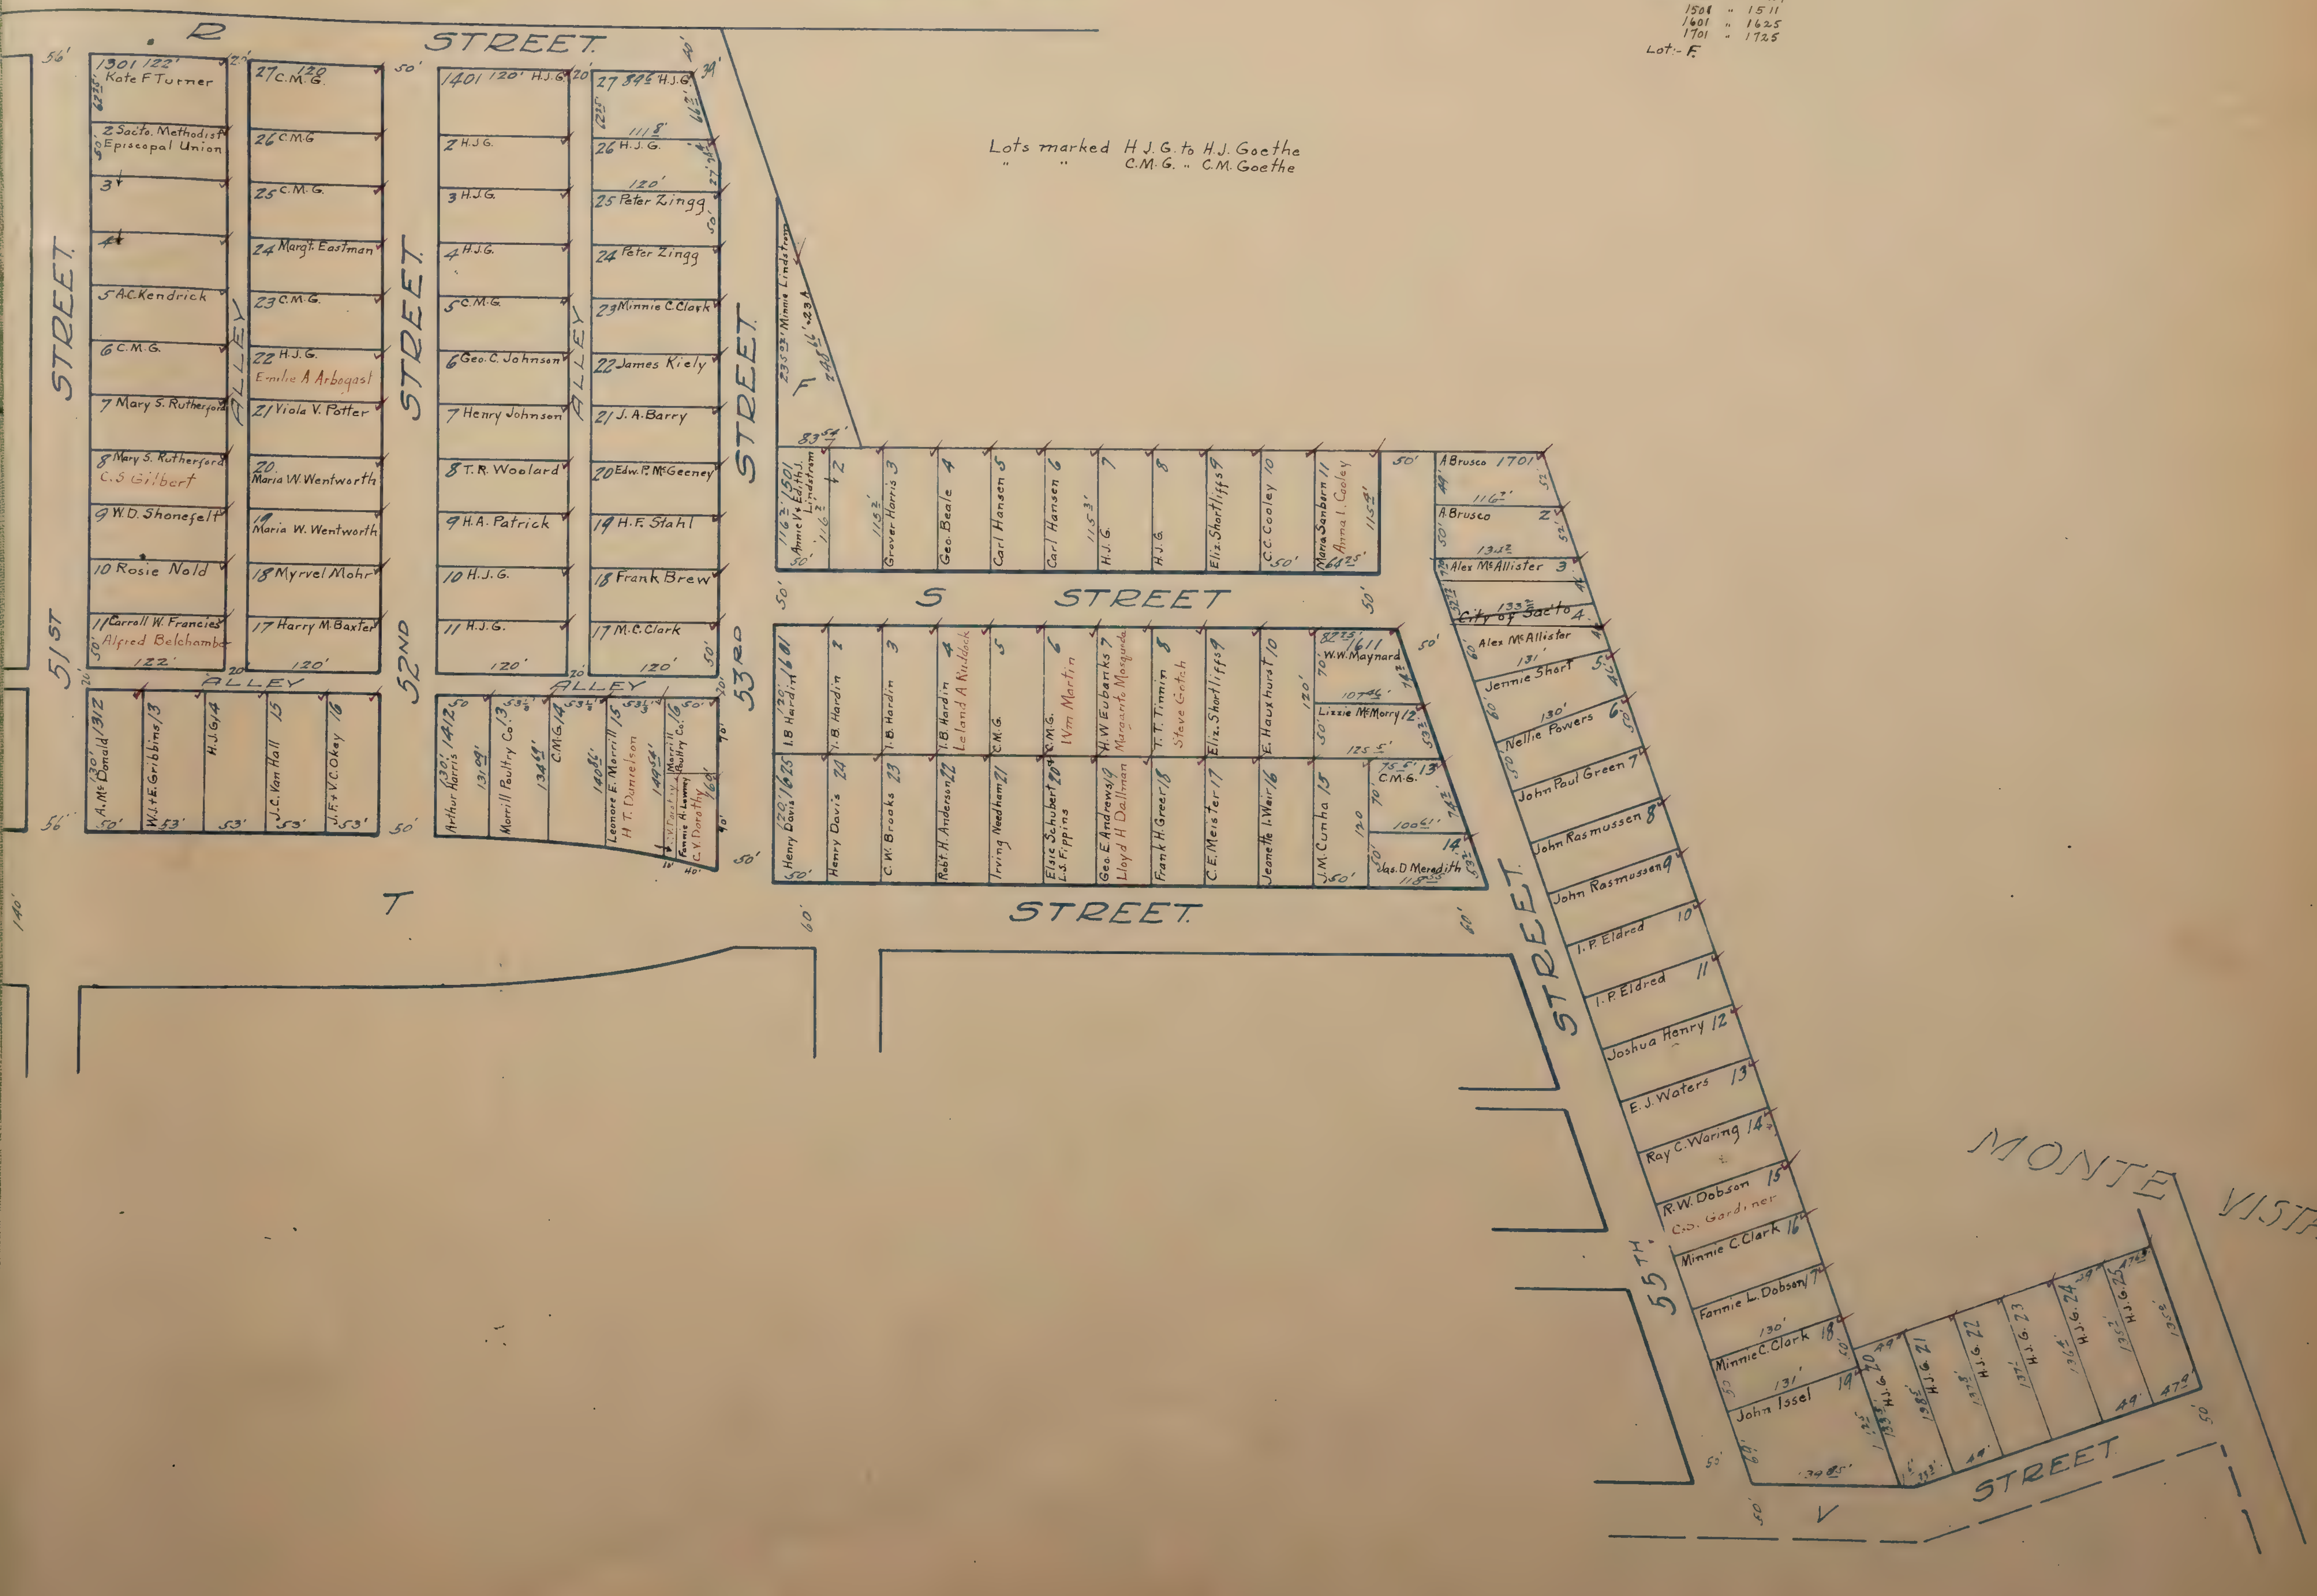

Lots:- 1301 to 1327
1401 " 1427
1501 " 1511
1601 " 1625
1701 " 1725
Lot:- F.

Lots marked H.J.G. to H.J. Goethe
" " C.M.G. " C.M. Goethe

R STREET
51ST STREET
52ND STREET
53RD STREET
55TH STREET
S STREET
T STREET
V STREET
MONTE VISTA
ALLEY
ALLEY
ALLEY
ALLEY
1301 122' Kate F Turner
2 Sacto. Methodist Episcopal Union
3
4
5 A.C. Kendrick
6 C.M.G.
7 Mary S. Rutherford
8 Mary S. Rutherford
C.S. Gilbert
9 W.D. Shonefelt
10 Rosie Nold
11 Carroll W. Francies
Alfred Belchamber
122'
27 C.M.G. 120
26 C.M.G.
25 C.M.G.
24 Margt. Eastman
23 C.M.G.
22 H.J.G.
Emilie A Arbogast
21 Viola V. Potter
20 Maria W. Wentworth
19 Maria W. Wentworth
18 Myrvel Mohr
17 Harry M. Baxter
120'
A. McDonald 1312
W.J.+E. Gribbins 13
H.J.G. 14
J.C. Van Hall 15
J.F.+V.C. Okey 16
1401 120' H.J.G.
2 H.J.G.
3 H.J.G.
4 H.J.G.
5 C.M.G.
6 Geo. C. Johnson
7 Henry Johnson
8 T.R. Woolard
9 H.A. Patrick
10 H.J.G.
11 H.J.G.
27 H.J.G.
26 H.J.G.
25 Peter Zingg
24 Peter Zingg
23 Minnie C. Clark
22 James Kiely
21 J.A. Barry
20 Edw. P. McGeeney
19 H.F. Stahl
18 Frank Brew
17 M.C. Clark
Arthur Harris 1412
Morrill Poultry Co. 13
C.M.G. 14
Leonore E. Morrill 15
H.T. Danielson
Morrill Poultry Co. 16
Fannie H. Lowney
C.V. Dorothy
Minnie Lindstrom
F
1501 Annie V.+Edith J. Lindstrom
2
Grover Harris 3
Geo. Beale 4
Carl Hansen 5
Carl Hansen 6
H.J.G. 7
H.J.G. 8
Eliz. Shortliffs 9
C.C. Cooley 10
Maria Sanborn 11
Anna I. Cooley
I.B. Hardin 1601
I.B. Hardin 2
I.B. Hardin 3
I.B. Hardin 4
Leland A Ruddock
C.M.G. 5
C.M.G. 6
Wm Martin
H.W. Eubanks 7
Margarito Mosqueda
T.T. Timmin 8
Steve Gotch
Eliz. Shortliffs 9
E. Hauxhurst 10
1611 W.W. Maynard
Lizzie McMorry 12
C.M.G. 13
Jas. D Meredith 14
Henry Davis 1625
Henry Davis 24
C.W. Brooks 23
Robt. H. Anderson 22
Irving Needham 21
Elsie Schubert 20
L.S. Fippins
Geo. E. Andrews 19
Lloyd H Dallman
Frank H. Greer 18
C.E. Meister 17
Jeanette I. Weir 16
J.M. Cunha 15
A Brusco 1701
A. Brusco 2
Alex McAllister 3
~~City of Sacto~~ 4
Alex McAllister
Jennie Short 5
Nellie Powers 6
John Paul Green 7
John Rasmussen 8
John Rasmussen 9
I.P. Eldred 10
I.P. Eldred 11
Joshua Henry 12
E.J. Waters 13
Ray C. Waring 14
R.W. Dobson 15
C.S. Gardiner
Minnie C. Clark 16
Fannie L. Dobson 17
Minnie C. Clark 18
John Issel 19
H.J.G. 20
H.J.G. 21
H.J.G. 22
H.J.G. 23
H.J.G. 24
H.J.G. 25
56'
50'
20'
140'
60'

6

ELMHURST ✓

Scale: 1 Inch = 120 feet.

Lots:- 2301 to 2311
2324 " 2334
2401 " 2430
2501 " 2508
2601 " 2611
2624 " 2634
Lots:- A, W, X, Y, Z.

Lots marked H.J.G. to H.J. Goethe
" " C.M.G. " C.M. Goethe

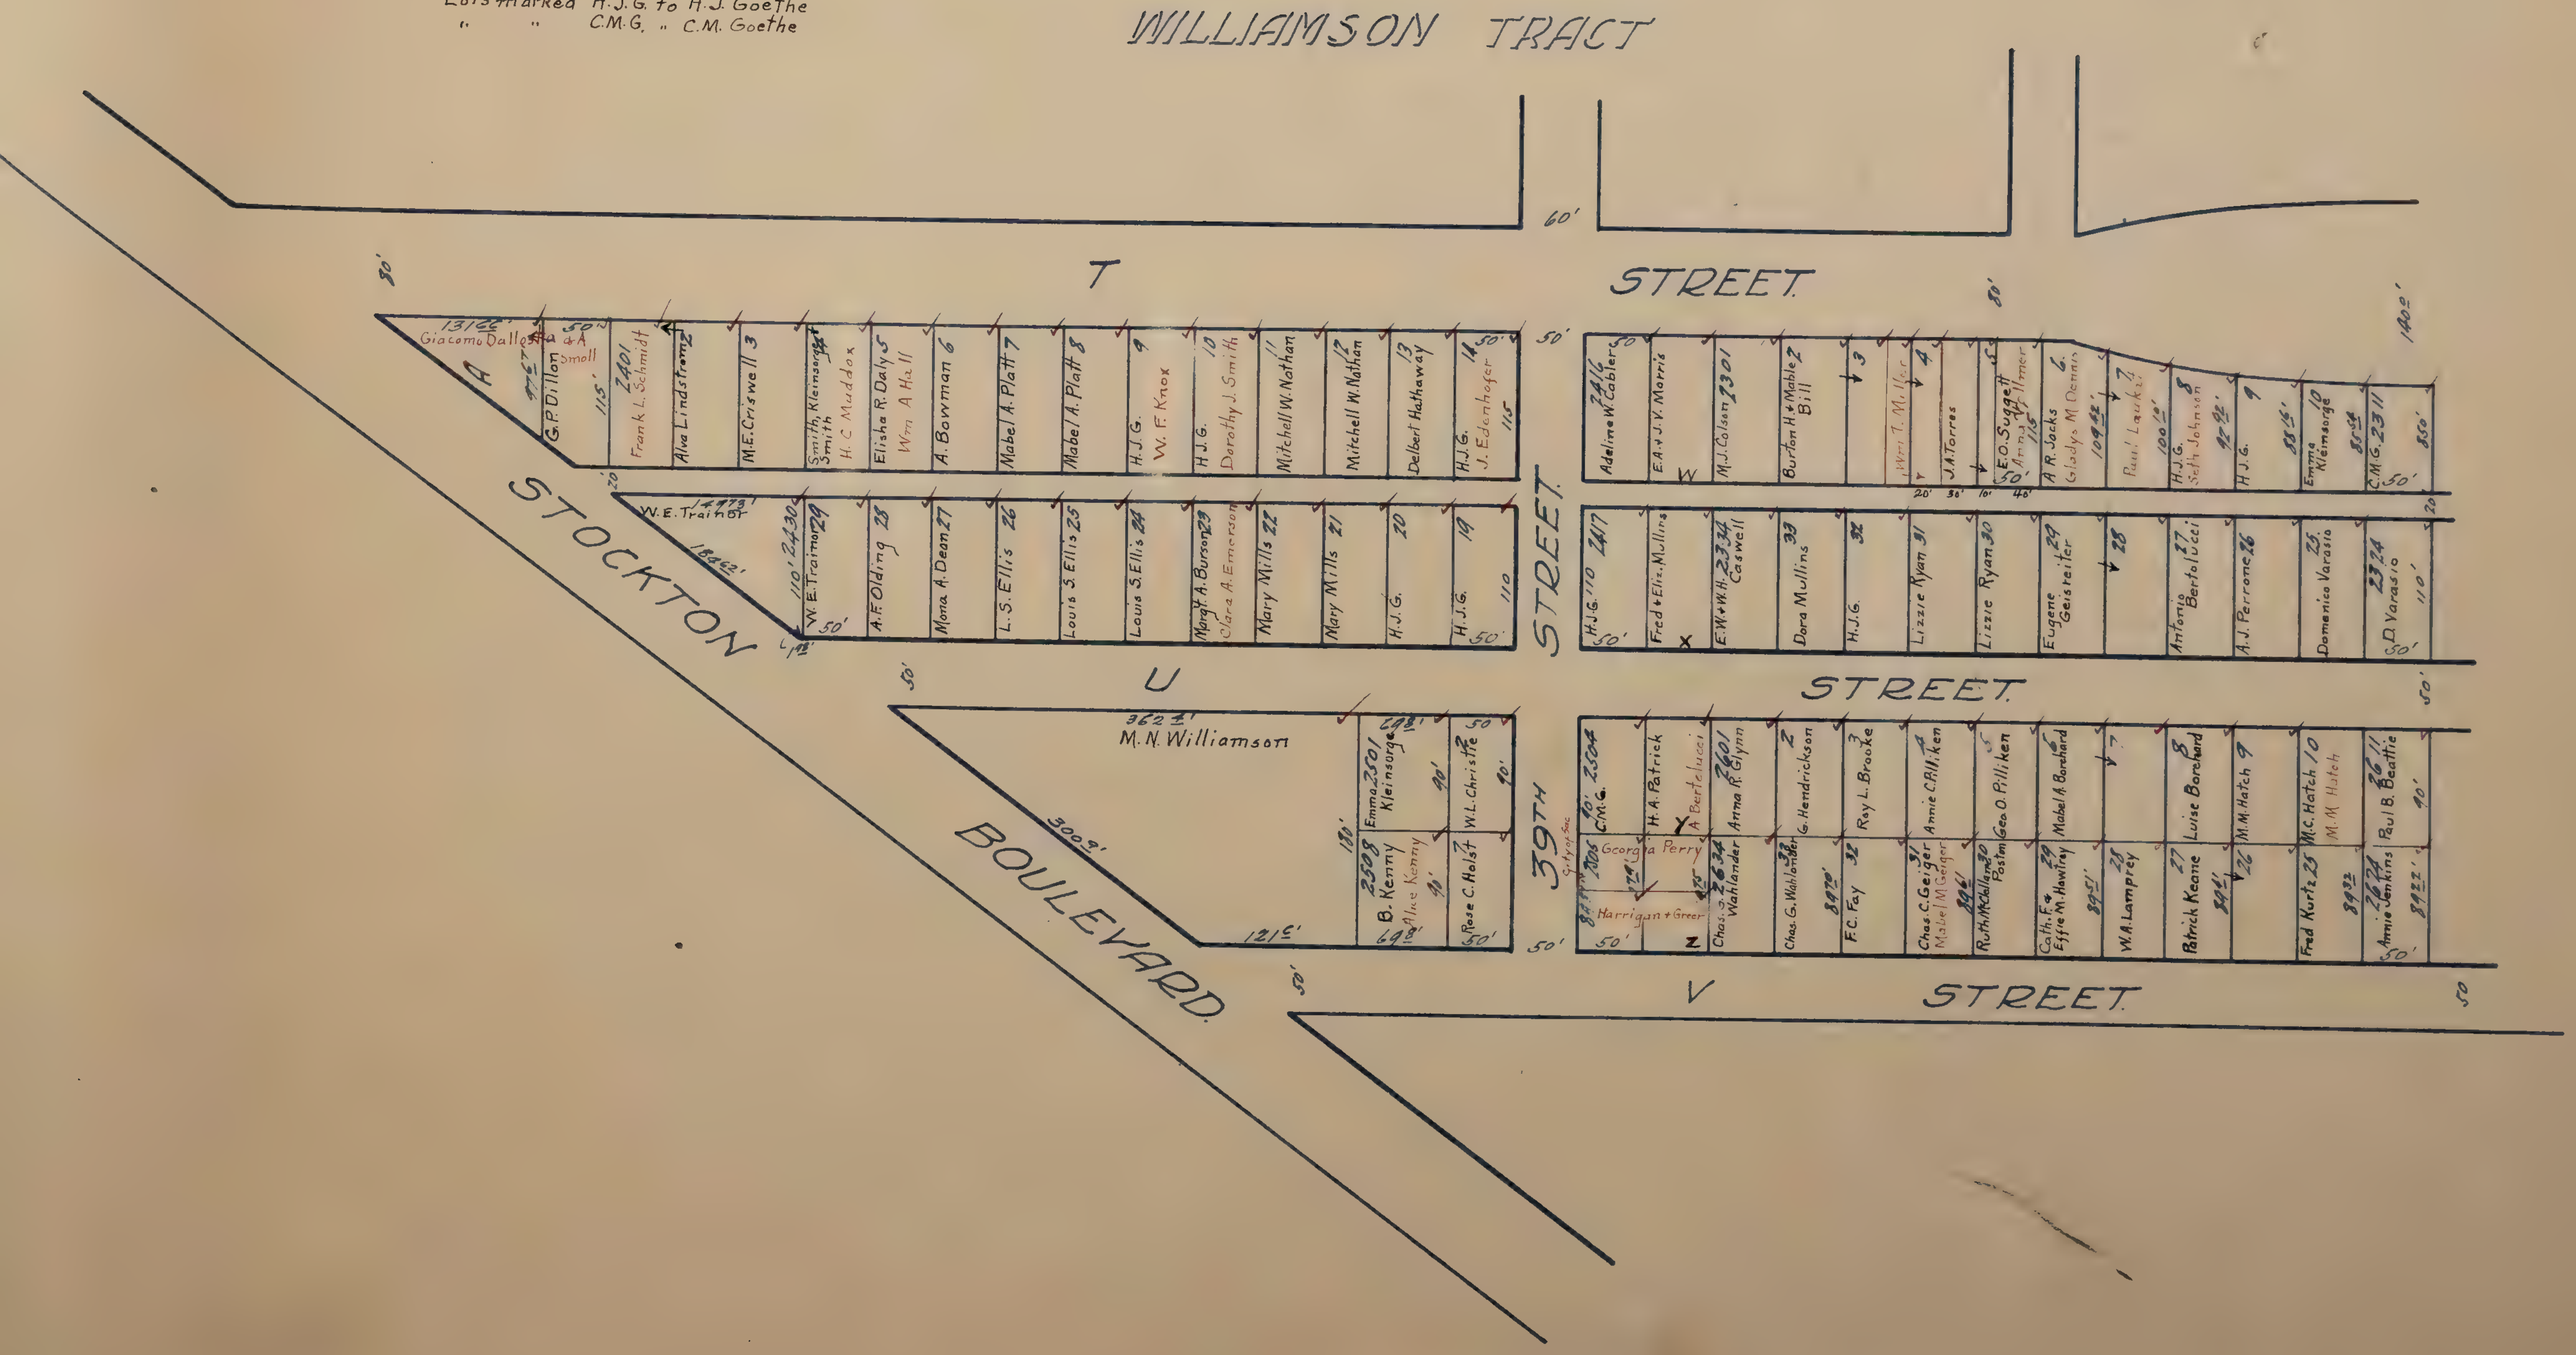
WILLIAMSON TRACT
T STREET
U STREET
V STREET
39TH STREET
STOCKTON BOULEVARD
60'
80'
50'
131.66'
Giacomo Dallesta & A Smoll
A
97.67'
G.P. Dillon
115'
2401
Frank L. Schmidt
Alva Lindstrom 2
M.E. Criswell 3
Smith, Kleinsorge Smith 4
H.C. Muddox
Elisha R. Daly 5
Wm A. Hall
A. Bowman 6
Mabel A. Platt 7
Mabel A. Platt 8
H.J.G. 9
W.F. Knox
H.J.G. 10
Dorothy J. Smith
Mitchell W. Nathan 11
Mitchell W. Nathan 12
Delbert Hathaway 13
H.J.G. 14
J. Edenhofer
115
20
W.E. Trainor
149.73'
184.62'
110'
2430
W.E. Trainor 29
A.F. Olding 28
Mona A. Dean 27
L.S. Ellis 26
Louis S. Ellis 25
Louis S. Ellis 24
Marg't A. Burson 23
Clara A. Emerson
Mary Mills 22
Mary Mills 21
H.J.G. 20
H.J.G. 19
110
362.1'
M.N. Williamson
300.9'
121.5'
180'
69.8'
Emma 2501 Kleinsorge
90'
W.L. Christie 2
2508
B. Kenny
Alice Kenny
Rose C. Holst 7
2416
Adeline W. Cabler
E.A. & J.V. Morris
W
M.J. Colson 2301
Burton H. & Mable Bill 2
3
Wm T. Miller
4
J.A. Torres
5
E.O. Suggett
Anna Ullmer
A.R. Sacks 6
Gladys M. Dennis
109.42'
Paul Laukat 7
100.10'
H.J.G. 8
Seth Johnson
92.92'
H.J.G. 9
88.16'
Emma Kleinsorge 10
85.54'
C.M.G. 2311
85.0'
140.0'
20'
30'
10'
40'
2417
H.J.G.
Fred & Eliz. Mullins
X
E.W. & W.H. 2334 Caswell
Dora Mullins 33
H.J.G. 32
Lizzie Ryan 31
Lizzie Ryan 30
Eugene Geisreiter 29
28
Antonio Bertolucci 27
A.J. Perrone 26
Domenico Varasio 25
2324
D. Varasio
City of Sac
C.M.G. 2504
2305
Georgia Perry
84.71'
Harrigan & Greer
H.A. Patrick
Y
A. Bertelucci
Z
2601
Anna R. Glynn
2634
Chas. J. Wahlander
G. Hendrickson 2
Chas. G. Wahlander 33
89.70'
Roy L. Brooke 3
F.C. Fay 32
Annie C. Pilliken 4
Chas. C. Geiger 31
Mabel M. Geiger
89.61'
Geo. O. Pilliken 5
Ruth McClelland 30
Postm
Mabel A. Borchard 6
Cath. F. & Effie M. Hawtrey 29
89.51'
7
W.A. Lamprey 28
Luise Borchard 8
Patrick Keane 27
89.41'
M.M. Hatch 9
26
M.C. Hatch 10
M.M. Hatch
Fred Kurtz 25
89.32'
Paul B. Beattie 2611
2624
Annie Jenkins
89.22'

6

ELMHURST ✓

Scale: 1 Inch=120 feet.

Lots marked H.J.G. to H.J. Goethe
" " C.M.G. " C.M. Goethe

Lots:- 2201 to 2236
2312 " 2323
2612 - 2623
2701 - 2736

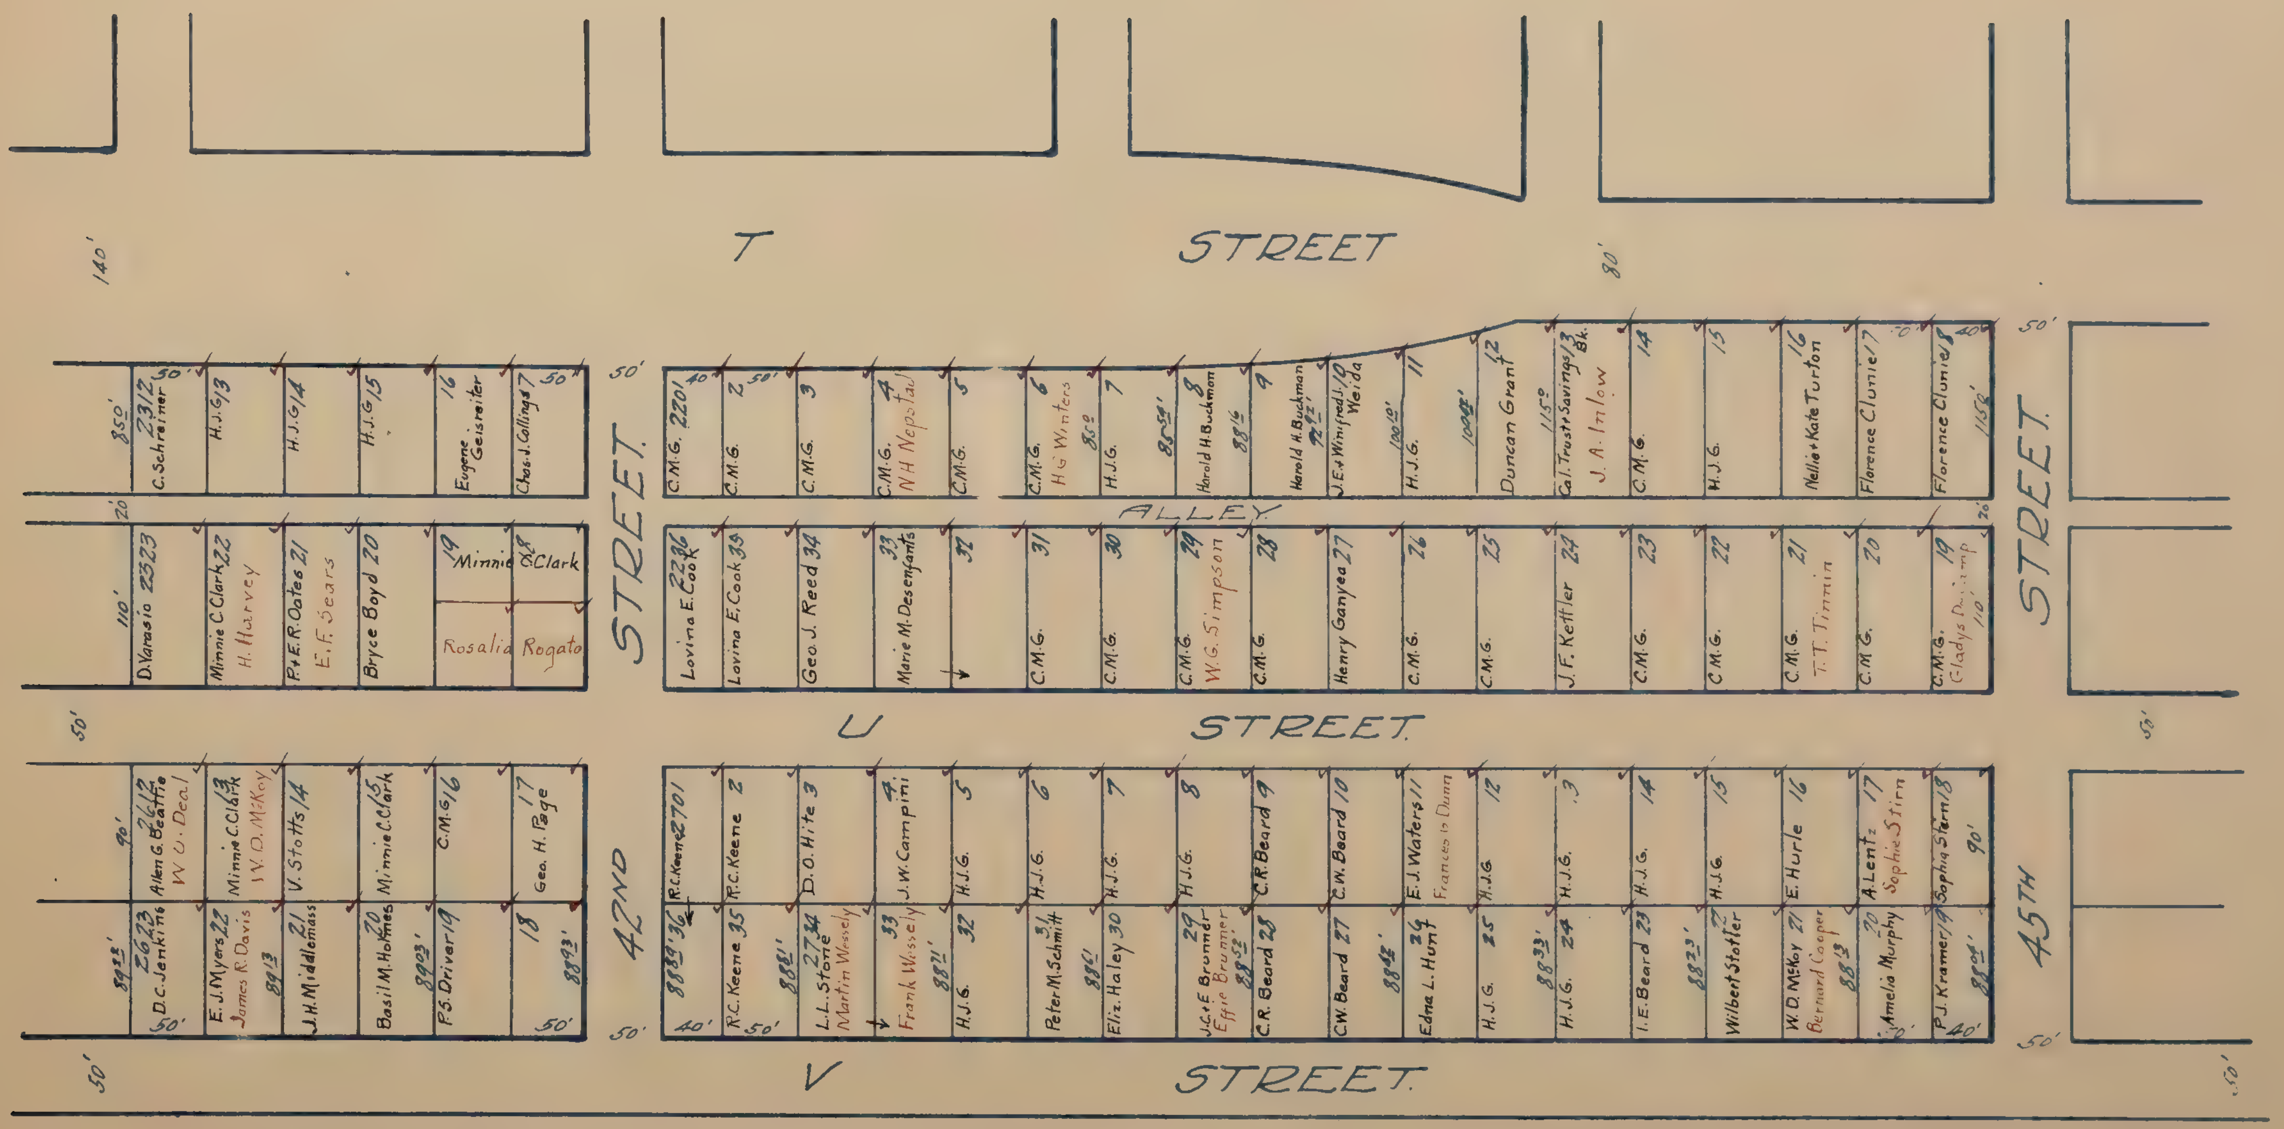
T STREET
U STREET
V STREET
42ND STREET
45TH STREET
ALLEY
140'
80'
50'
20'
110'
90'
85'
C. Schreiner 2312
H.J.G. 13
H.J.G. 14
H.J.G. 15
Eugene Geisreiter 16
Chas. J. Collings 17
D. Varasio 2323
Minnie C. Clark 22
H. Harvey
P.+E.R. Oates 21
E.F. Sears
Bryce Boyd 20
Minnie C. Clark 19 18
Rosalia Rogato
C.M.G. 2201
C.M.G. 2
C.M.G. 3
C.M.G. 4
N.H. Nepstad
C.M.G. 5
C.M.G. 6
H.G. Winters
H.J.G. 7
Harold H. Buckman 8
Harold H. Buckman 9
J.E.+Winifred J. Weida 10
H.J.G. 11
Duncan Grant 12
Cal. Trust+Savings Bk. 13
J.A. Inlow
C.M.G. 14
H.J.G. 15
Nellie+Kate Turton 16
Florence Clunie 17
Florence Clunie 18
Lovina E. Cook 2236
Lovina E. Cook 35
Geo. J. Reed 34
Marie M. Desenfants 33
32
C.M.G. 31
C.M.G. 30
C.M.G. 29
W.G. Simpson
C.M.G. 28
Henry Ganyea 27
C.M.G. 26
C.M.G. 25
J.F. Kettler 24
C.M.G. 23
C.M.G. 22
C.M.G. 21
T.T. Timmin
C.M.G. 20
C.M.G. 19
Gladys D.
Allen G. Beattie 2612
W.U. Deal
Minnie C. Clark 13
W.D. McKoy
V. Stotts 14
Minnie C. Clark 15
C.M.G. 16
Geo. H. Page 17
D.C. Jenkins 2623
E.J. Myers 22
James R. Davis
J.H. Middlemass 21
Basil M. Holmes 20
P.S. Driver 19
18
R.C. Keene 2701
R.C. Keene 2
D.O. Hite 3
J.W. Campini 4
H.J.G. 5
H.J.G. 6
H.J.G. 7
H.J.G. 8
C.R. Beard 9
C.W. Beard 10
E.J. Waters 11
Frances b Dunn
H.J.G. 12
H.J.G. 13
H.J.G. 14
H.J.G. 15
E. Hurle 16
A. Lentz 17
Sophie Stirn
Sophia Stern 18
2736
R.C. Keene 35
L.L. Stone 2734
Martin Wessely
Frank Wessely 33
H.J.G. 32
Peter M. Schmitt 31
Eliz. Haley 30
J.C.+E. Brunner 29
Effie Brunner
C.R. Beard 28
C.W. Beard 27
Edna L. Hunt 26
H.J.G. 25
H.J.G. 24
I.E. Beard 23
Wilbert Stotler 22
W.D. McKoy 21
Bernard Cooper
Amelia Murphy 20
P.J. Kramer 19
40'
88'

ELMHURST

Scale: 1Inch=120feet.

Lots:- 2101 to 2136
2801 " 2836

Lots marked H.J.G. to H.J. Goethe
" " C.M.G. " C.M Goethe

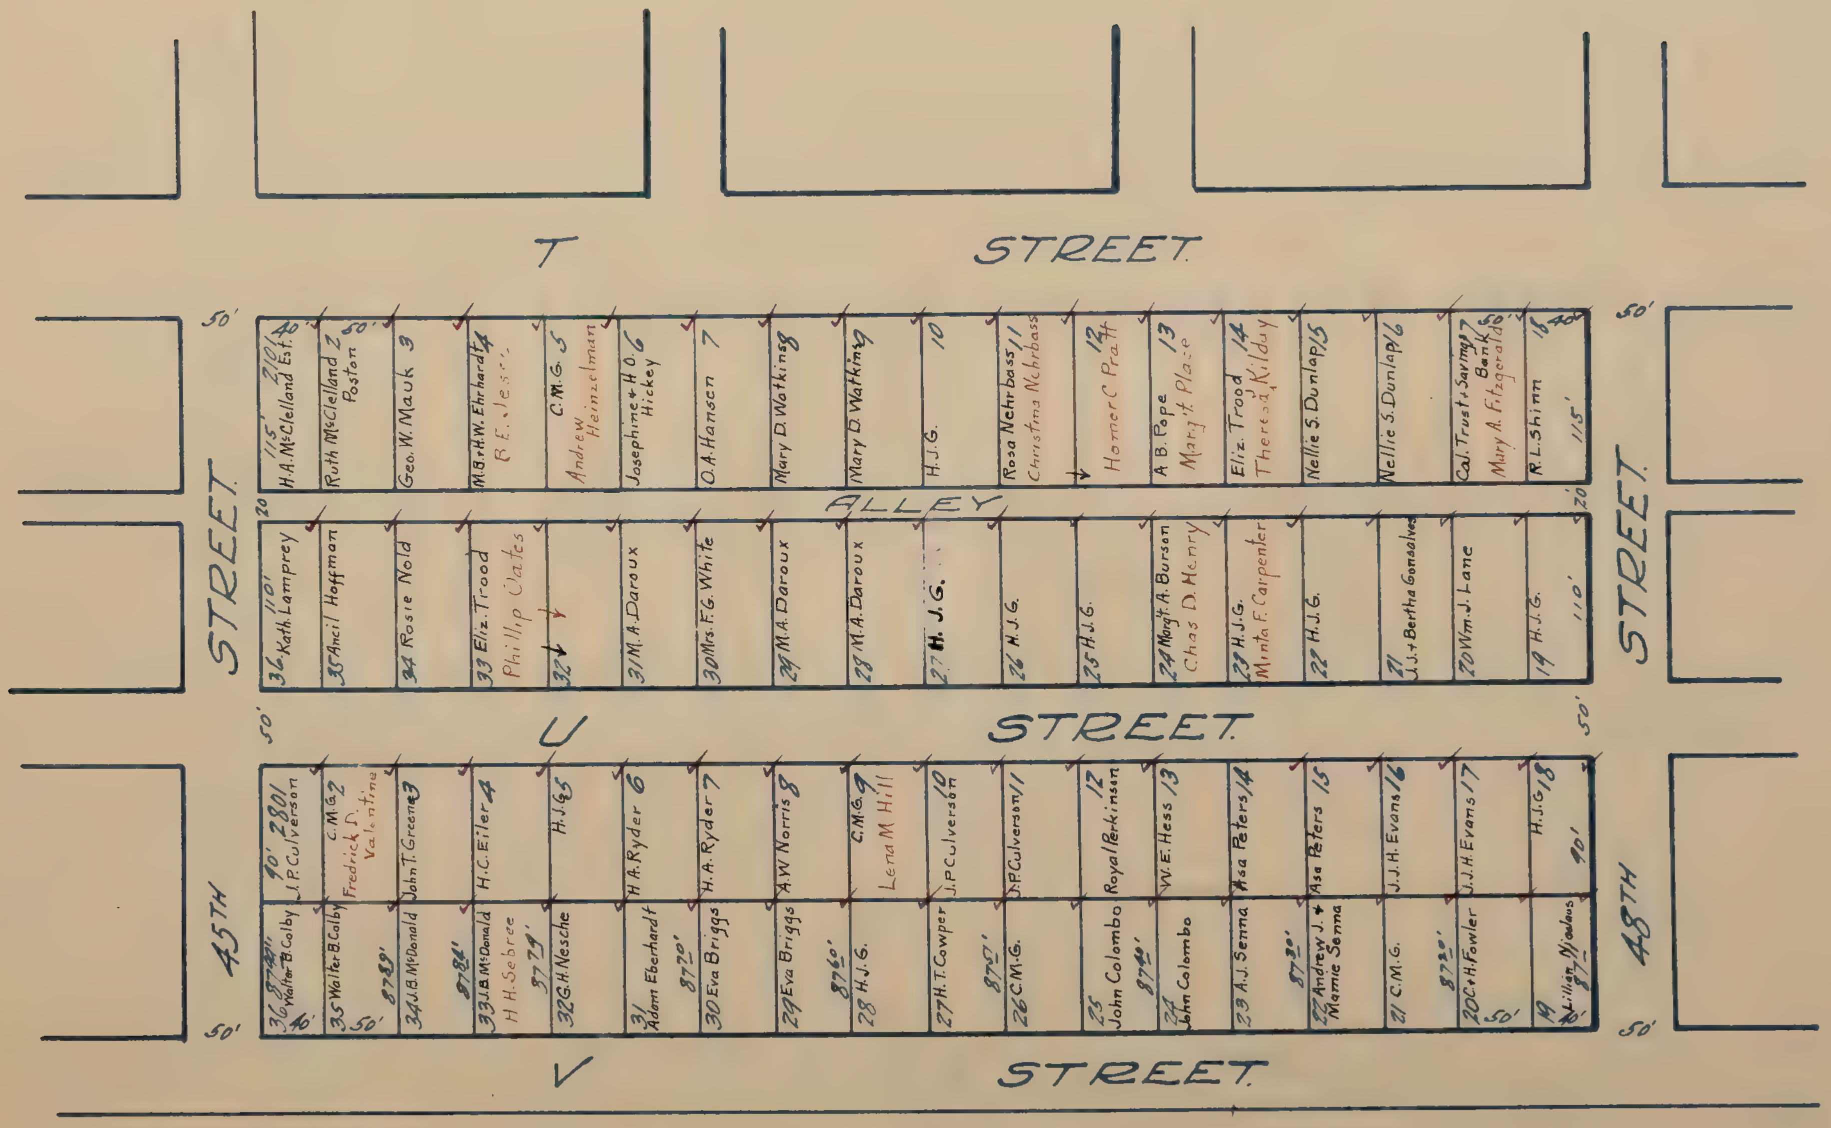
T STREET
U STREET
V STREET
45TH STREET
48TH STREET
ALLEY
50'
20
115'
110'
90'
1 H.A. McClelland Est. 2101 40'
2 Ruth McClelland Poston 50'
3 Geo. W. Mauk
4 M.B.+H.W. Ehrhardt R.E. Jess
5 C.M.G. Andrew Heinzelman
6 Josephine + H.O. Hickey
7 O.A. Hansen
8 Mary D. Watkins
9 Mary D. Watkins
10 H.J.G.
11 Rosa Nehrbass Christina Nehrbass
12 Homer C Pratt
13 A B. Pope Marg't. Place
14 Eliz. Trood Theresa Kilday
15 Nellie S. Dunlap
16 Nellie S. Dunlap
17 Cal. Trust + Savings Bank Mary A. Fitzgerald 50'
18 R.L. Shinn 40'
36 Kath. Lamprey 110'
35 Ancil Hoffman
34 Rosie Nold
33 Eliz. Trood Phillip Oates
32
31 M.A. Daroux
30 Mrs. F.G. White
29 M.A. Daroux
28 M.A. Daroux
27 H. J. G.
26 H.J.G.
25 H.J.G.
24 Marg't. A. Burson Chas D. Henry
23 H.J.G. Minta F. Carpenter
22 H.J.G.
21 J.J.+ Bertha Gonsalves
20 Wm. J. Lane
19 H.J.G.
1 J.P. Culverson 2801 90'
2 C.M.G. Fredrick D. Valentine
3 John T. Greene
4 H.C. Eiler
5 H.J.G.
6 H.A. Ryder
7 H.A. Ryder
8 A.W. Norris
9 C.M.G. Lena M Hill
10 J.P. Culverson
11 J.P. Culverson
12 Royal Perkinson
13 W.E. Hess
14 Asa Peters
15 Asa Peters
16 J.J.H. Evans
17 J.J.H. Evans
18 H.J.G.
36 Walter B. Colby 87.40' 40'
35 Walter B. Colby 87.89' 50'
34 J.B. McDonald 87.84'
33 J.B. McDonald H.H. Sebree 87.79'
32 G.H. Nesche
31 Adam Eberhardt 87.70'
30 Eva Briggs
29 Eva Briggs 87.60'
28 H.J.G.
27 H.T. Cowper 87.51'
26 C.M.G.
25 John Colombo 87.40'
24 John Colombo
23 A.J. Senna 87.30'
22 Andrew J. + Mamie Senna
21 C.M.G. 87.20'
20 C.+H. Fowler 50'
19 Lillian Njaulous 87'

ELMHURST ✓

Scale: 1 inch = 120 feet.

Lots: - 2001 to 2046
" 2901 - 2946
" B, C, D, E.

Lots marked H. J. G. to H. J. Goethe

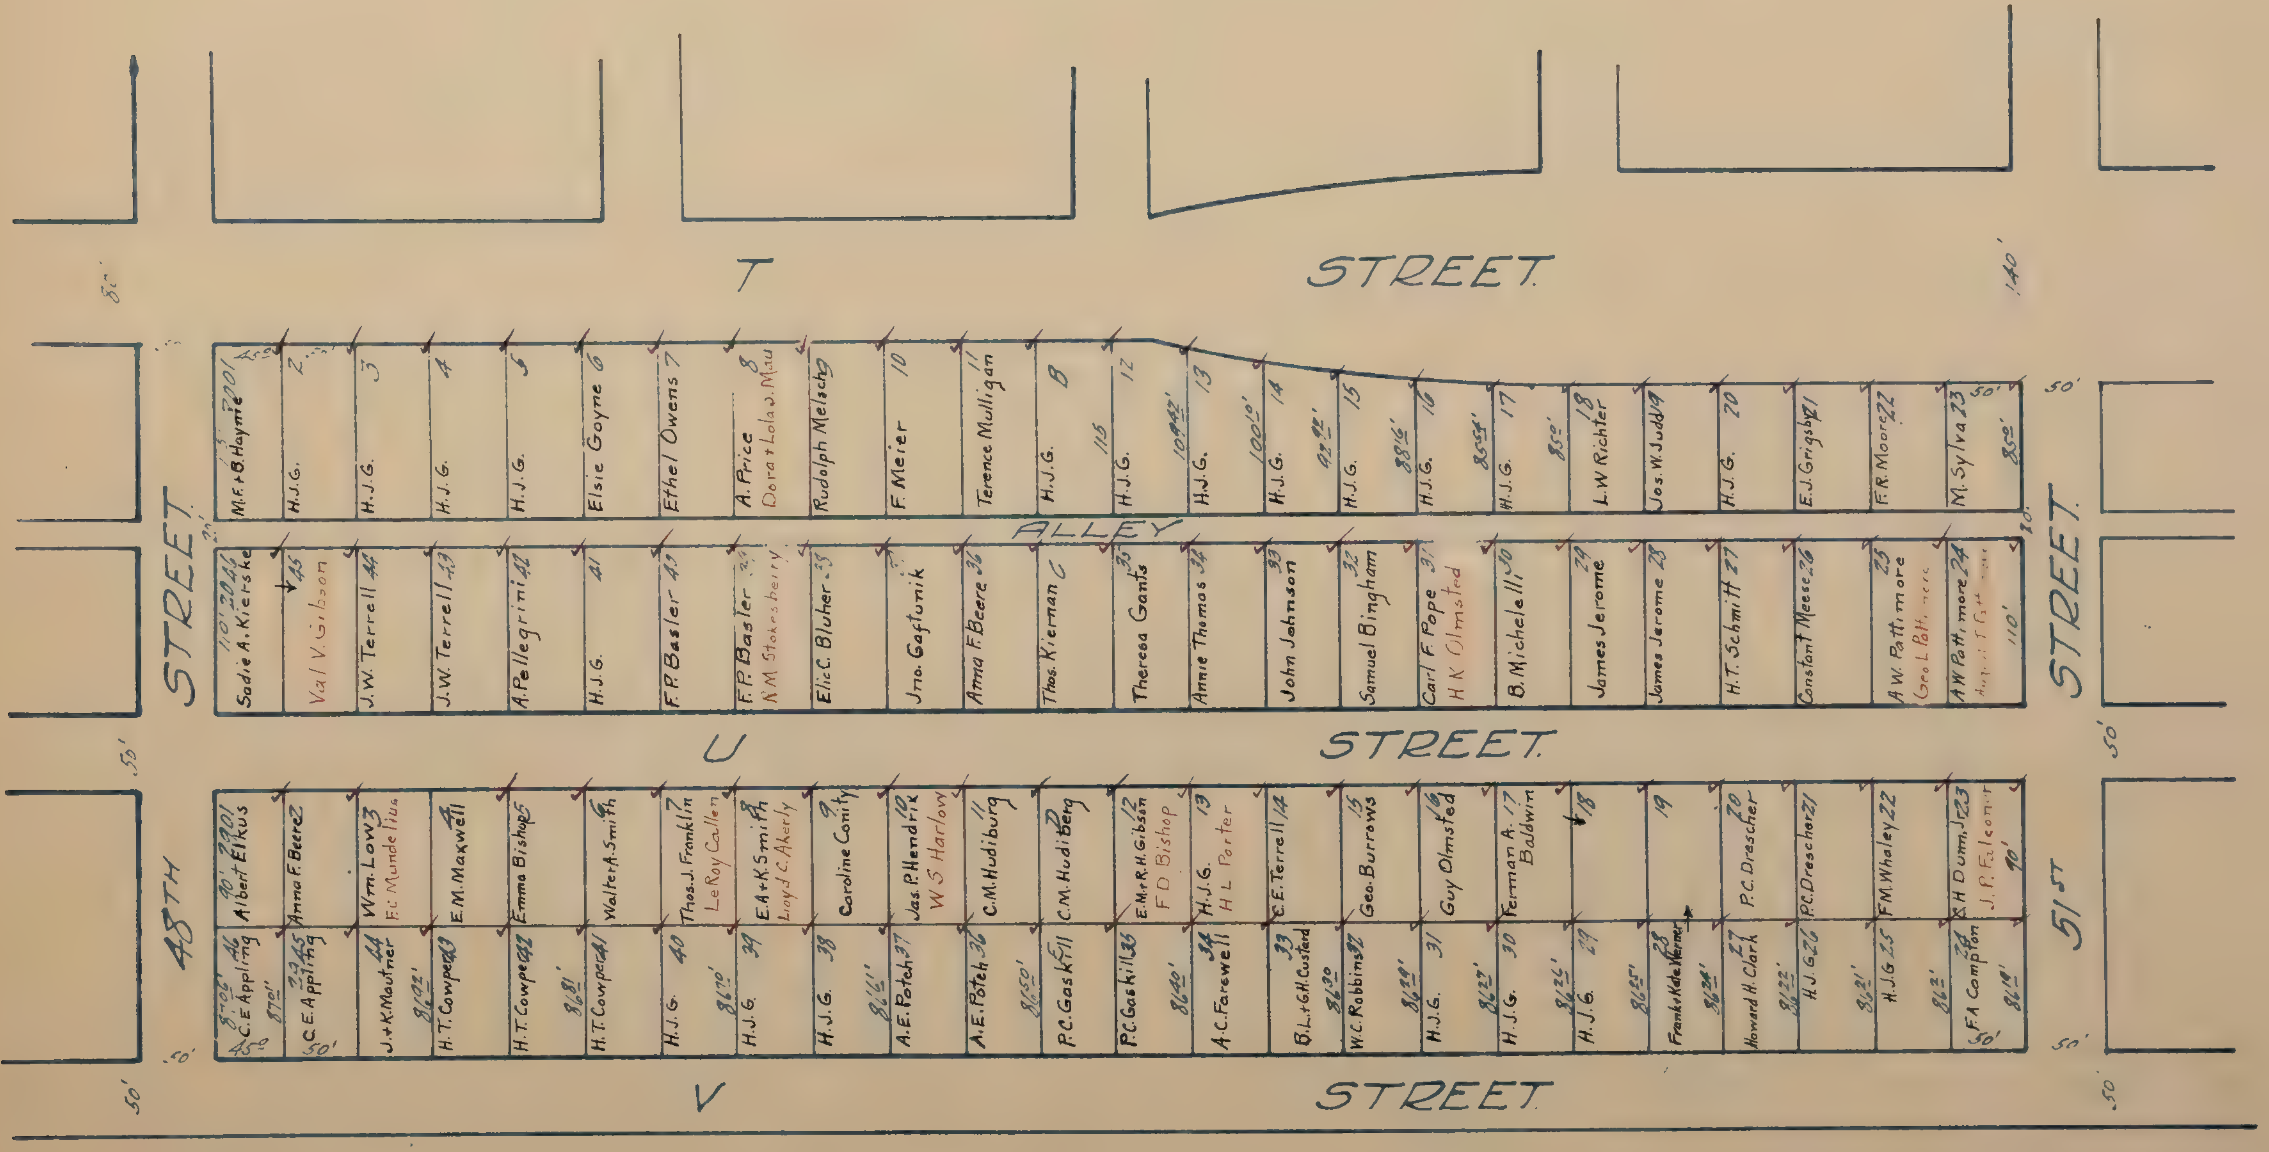
T STREET.
U STREET.
V STREET.
48TH STREET.
51ST STREET.
ALLEY
50'
140'
30'
20'
M.F. + B. Haymie 2001
H.J.G. 2
H.J.G. 3
H.J.G. 4
H.J.G. 5
Elsie Goyne 6
Ethel Owens 7
A. Price 8
Dora + Lola J. Mau
Rudolph Melsch 9
F. Meier 10
Terence Mulligan 11
H.J.G. B
115
H.J.G. 12
109.42'
H.J.G. 13
100.10'
H.J.G. 14
92.92'
H.J.G. 15
88.16'
H.J.G. 16
85.54'
H.J.G. 17
85.0'
L.W. Richter 18
Jos. W. Judd 19
H.J.G. 20
E.J. Grigsby 21
F.R. Moore 22
M. Sylva 23
50'
85.0'
110' 2046
Sadie A. Kierske
Val V. Gibson 45
J.W. Terrell 44
J.W. Terrell 43
A. Pellegrini 42
H.J.G. 41
F.P. Basler 40
F.P. Basler 39
K.M. Stokesberry
Elic C. Bluher 38
Jno. Gaftunik
Anna F. Beere 36
Thos. Kiernan C
Theresa Gants 35
Annie Thomas 34
John Johnson 33
Samuel Bingham 32
Carl F. Pope 31
H.K. Olmsted
B. Michelelli 30
James Jerome 29
James Jerome 28
H.T. Schmitt 27
Constant Meese 26
A.W. Pattimore 25
Geo. L. Pattimore
A.W. Pattimore 24
110'
90' 2901
Albert Elkus
Anna F. Beere 2
Wm. Low 3
F. C. Mundelius
E.M. Maxwell 4
Emma Bishop 5
Walter A. Smith 6
Thos. J. Franklin 7
LeRoy Callen
E.A. + K. Smith 8
Lloyd C. Akerly
Caroline Conity 9
Jas. P. Hendrik 10
W.S. Harlow
C.M. Hudiburg 11
C.M. Hudiberg D
E.M. + R.H. Gibson 12
F.D. Bishop
H.J.G. 13
H.L. Porter
C.E. Terrell 14
Geo. Burrows 15
Guy Olmsted 16
Ferman A. Baldwin 17
18
19
P.C. Drescher 20
P.C. Drescher 21
F.M. Whaley 22
S.H. Dunn, Jr. 23
J.P. Falconer
90'
2946
C.E. Appling
87.0'
45.0
C.E. Appling 45
50'
J. + K. Mautner 44
86.92'
H.T. Cowper 43
H.T. Cowper 42
86.81'
H.T. Cowper 41
H.J.G. 40
86.70'
H.J.G. 39
H.J.G. 38
86.61'
A.E. Potch 37
A.E. Potch 36
86.50'
P.C. Gaskill E
P.C. Gaskill 35
86.40'
A.C. Farewell 34
B.L. + G.H. Custard 33
86.30'
W.C. Robbins 32
86.29'
H.J.G. 31
86.27'
H.J.G. 30
86.26'
H.J.G. 29
86.25'
Frank + Kate Werner 28
86.24'
Howard H. Clark 27
86.22'
H.J.G. 26
86.21'
H.J.G. 25
86.2'
F.A. Compton 24
86.19'
50'

ELMHURST.

Scale: 1 Inch = 120 feet.

Lots marked H.J.G. to H.J. Goethe
" " C.M.G. " C.M. Goethe

Lots:- 1801 to 1825
1901 " 1928
3001 " 3028
3101 " 3129

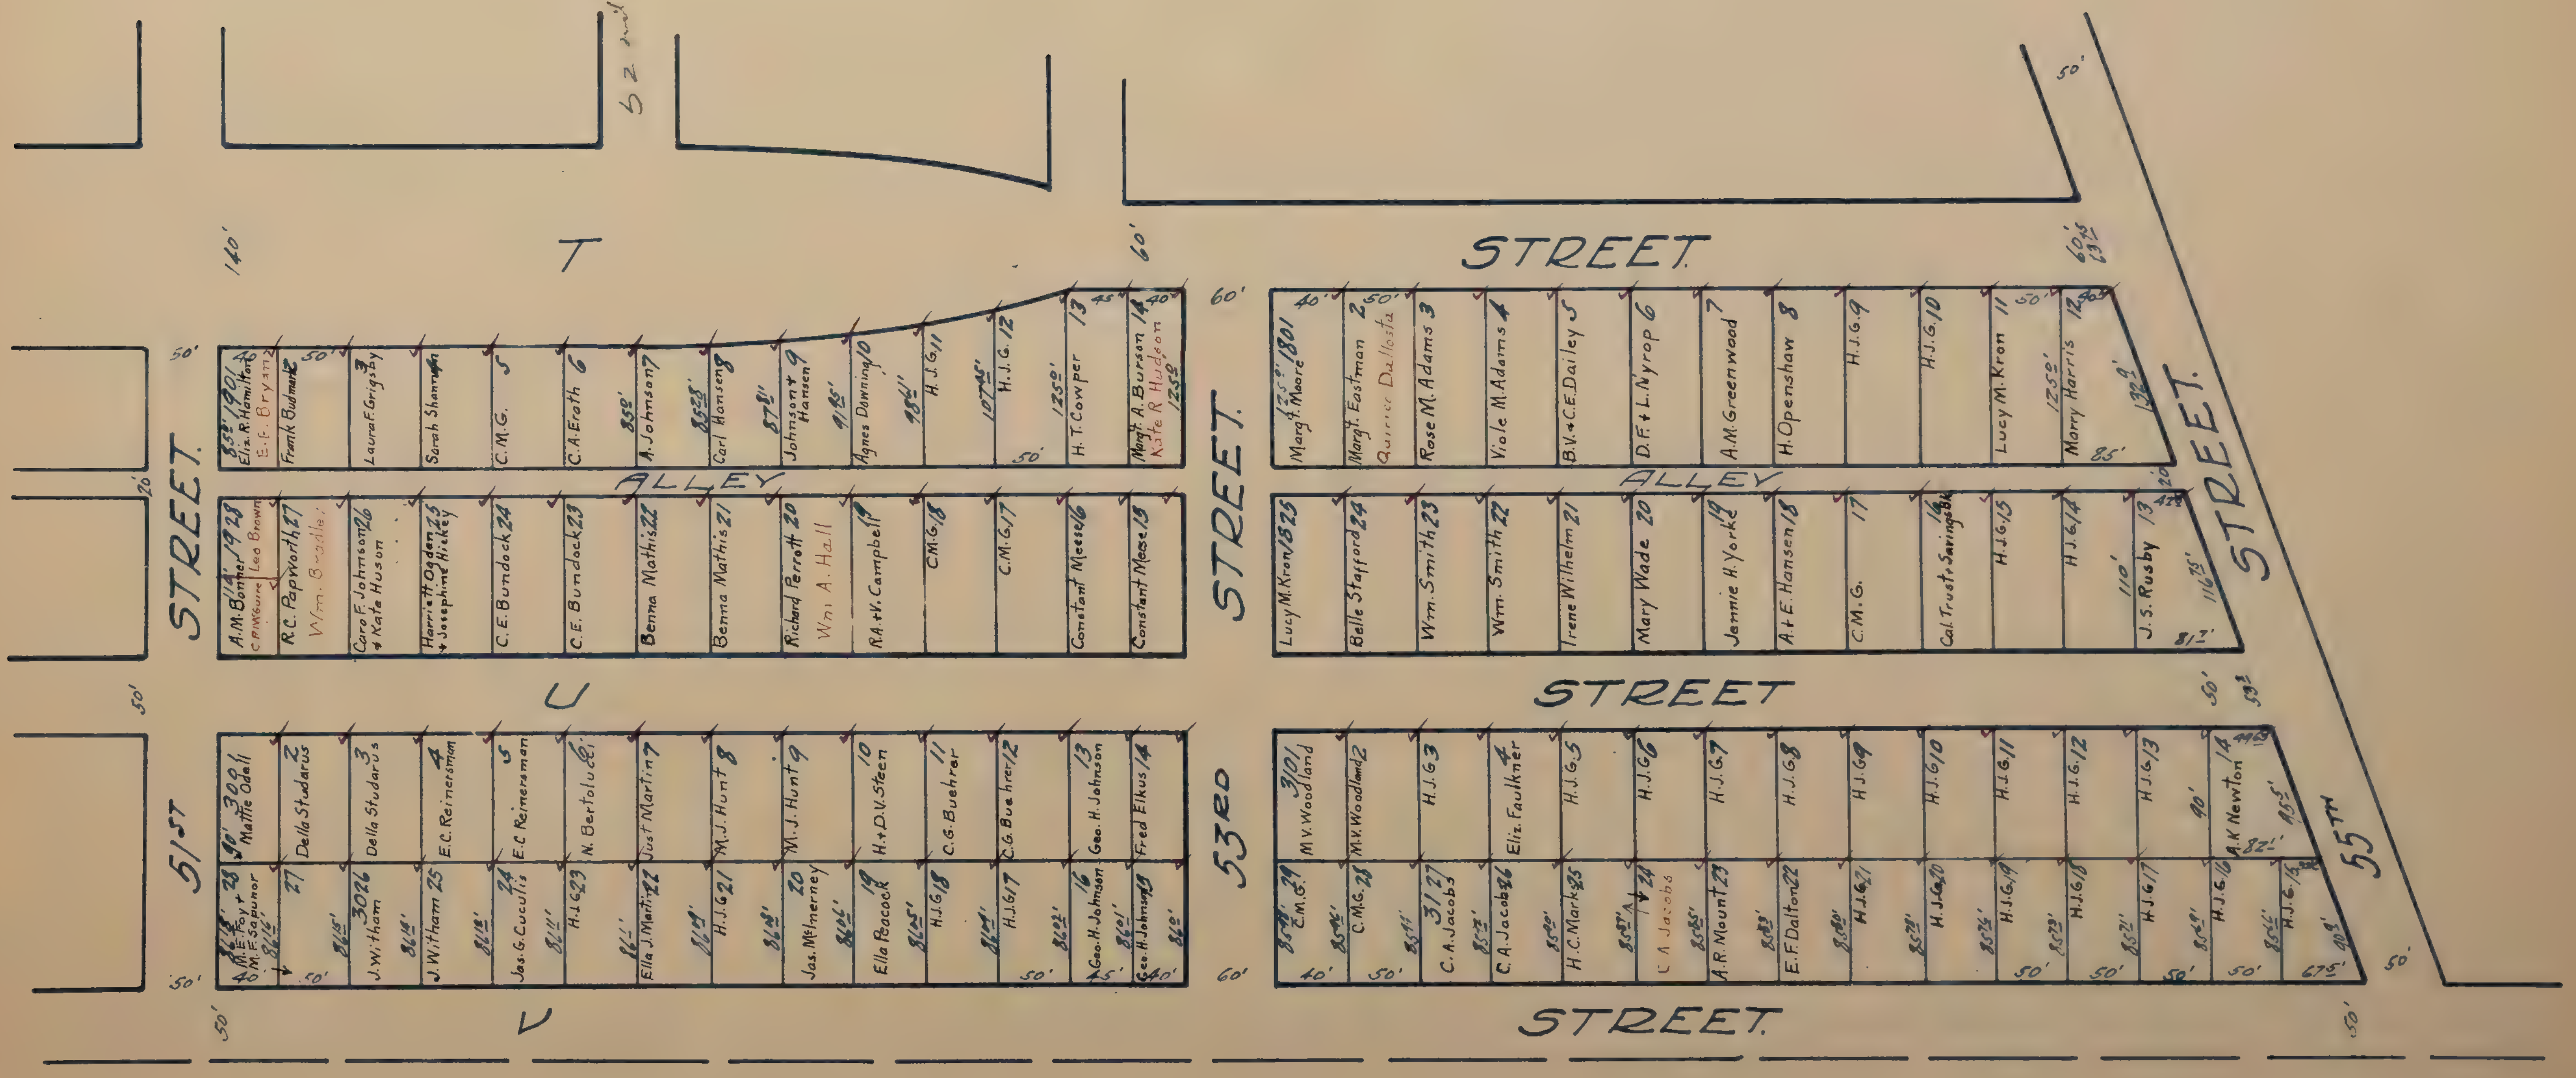

T STREET
U STREET
V STREET
51ST STREET
53RD STREET
55TH STREET
52 1/2
ALLEY
ALLEY
140'
60'
50'
1901 Eliz. R. Hamilton E. F. Bryant
2 Frank Budman
3 Laura F. Grigsby
4 Sarah Shannon
5 C.M.G.
6 C.A. Erath
7 A. Johnson
8 Carl Hansen
9 Johnson + Hansen
10 Agnes Downing
11 H.J.G.
12 H.J.G.
13 H.T. Cowper
14 Margt. A. Burson Kate R. Hudson
1928 A.M. Bonner C. Pinkguire Leo Brown
27 R.C. Papworth Wm. Bradley
26 Caro F. Johnson + Kate Huson
25 Harriett Ogden + Josephine Hickey
24 C.E. Bundock
23 C.E. Bundock
22 Benna Mathis
21 Benna Mathis
20 Richard Perrott Wm. A. Hall
19 R.A. + V. Campbell
18 C.M.G.
17 C.M.G.
16 Constant Meese
15 Constant Meese
1801 Margt. Moore
2 Margt. Eastman Quirico Dellosta
3 Rose M. Adams
4 Viole M. Adams
5 B.V. + C.E. Dailey
6 D.F. + L. Nyrop
7 A.M. Greenwood
8 H. Openshaw
9 H.J.G.
10 H.J.G.
11 Lucy M. Kron
12 Marry Harris
1825 Lucy M. Kron
24 Belle Stafford
23 Wm. Smith
22 Wm. Smith
21 Irene Wilhelm
20 Mary Wade
19 Jennie H. Yorke
18 A. + E. Hansen
17 C.M.G.
16 Cal. Trust + Savings Bk.
15 H.J.G.
14 H.J.G.
13 J.S. Rusby
3001 Mattie Odell
2 Della Studarus
3 Della Studarus
4 E.C. Reimersman
5 E.C. Reimersman
6 N. Bertolucci
7 Just Martin
8 M.J. Hunt
9 M.J. Hunt
10 H. + D.V. Steen
11 C.G. Buehrer
12 C.G. Buehrer
13 Geo. H. Johnson
14 Fred Elkus
28 M.E. Foy + M.F. Sapunor
27
3026 J. Witham
25 J. Witham
24 Jas. G. Cuculis
23 H.J.G.
22 Ella J. Martin
21 H.J.G.
20 Jas. McInerney
19 Ella Peacock
18 H.J.G.
17 H.J.G.
16 Geo. H. Johnson
15 Geo. H. Johnson
3101 M.V. Woodland
2 M.V. Woodland
3 H.J.G.
4 Eliz. Faulkner
5 H.J.G.
6 H.J.G.
7 H.J.G.
8 H.J.G.
9 H.J.G.
10 H.J.G.
11 H.J.G.
12 H.J.G.
13 H.J.G.
14 A.K. Newton
29 C.M.G.
28 C.M.G.
3127 C.A. Jacobs
26 C.A. Jacobs
25 H.C. Marks
24 C.A. Jacobs
23 A.R. Mount
22 E.F. Dalton
21 H.J.G.
20 H.J.G.
19 H.J.G.
18 H.J.G.
17 H.J.G.
16 H.J.G.
15 H.J.G.

ELMHURST.

Scale: 1 Inch = 120 feet.

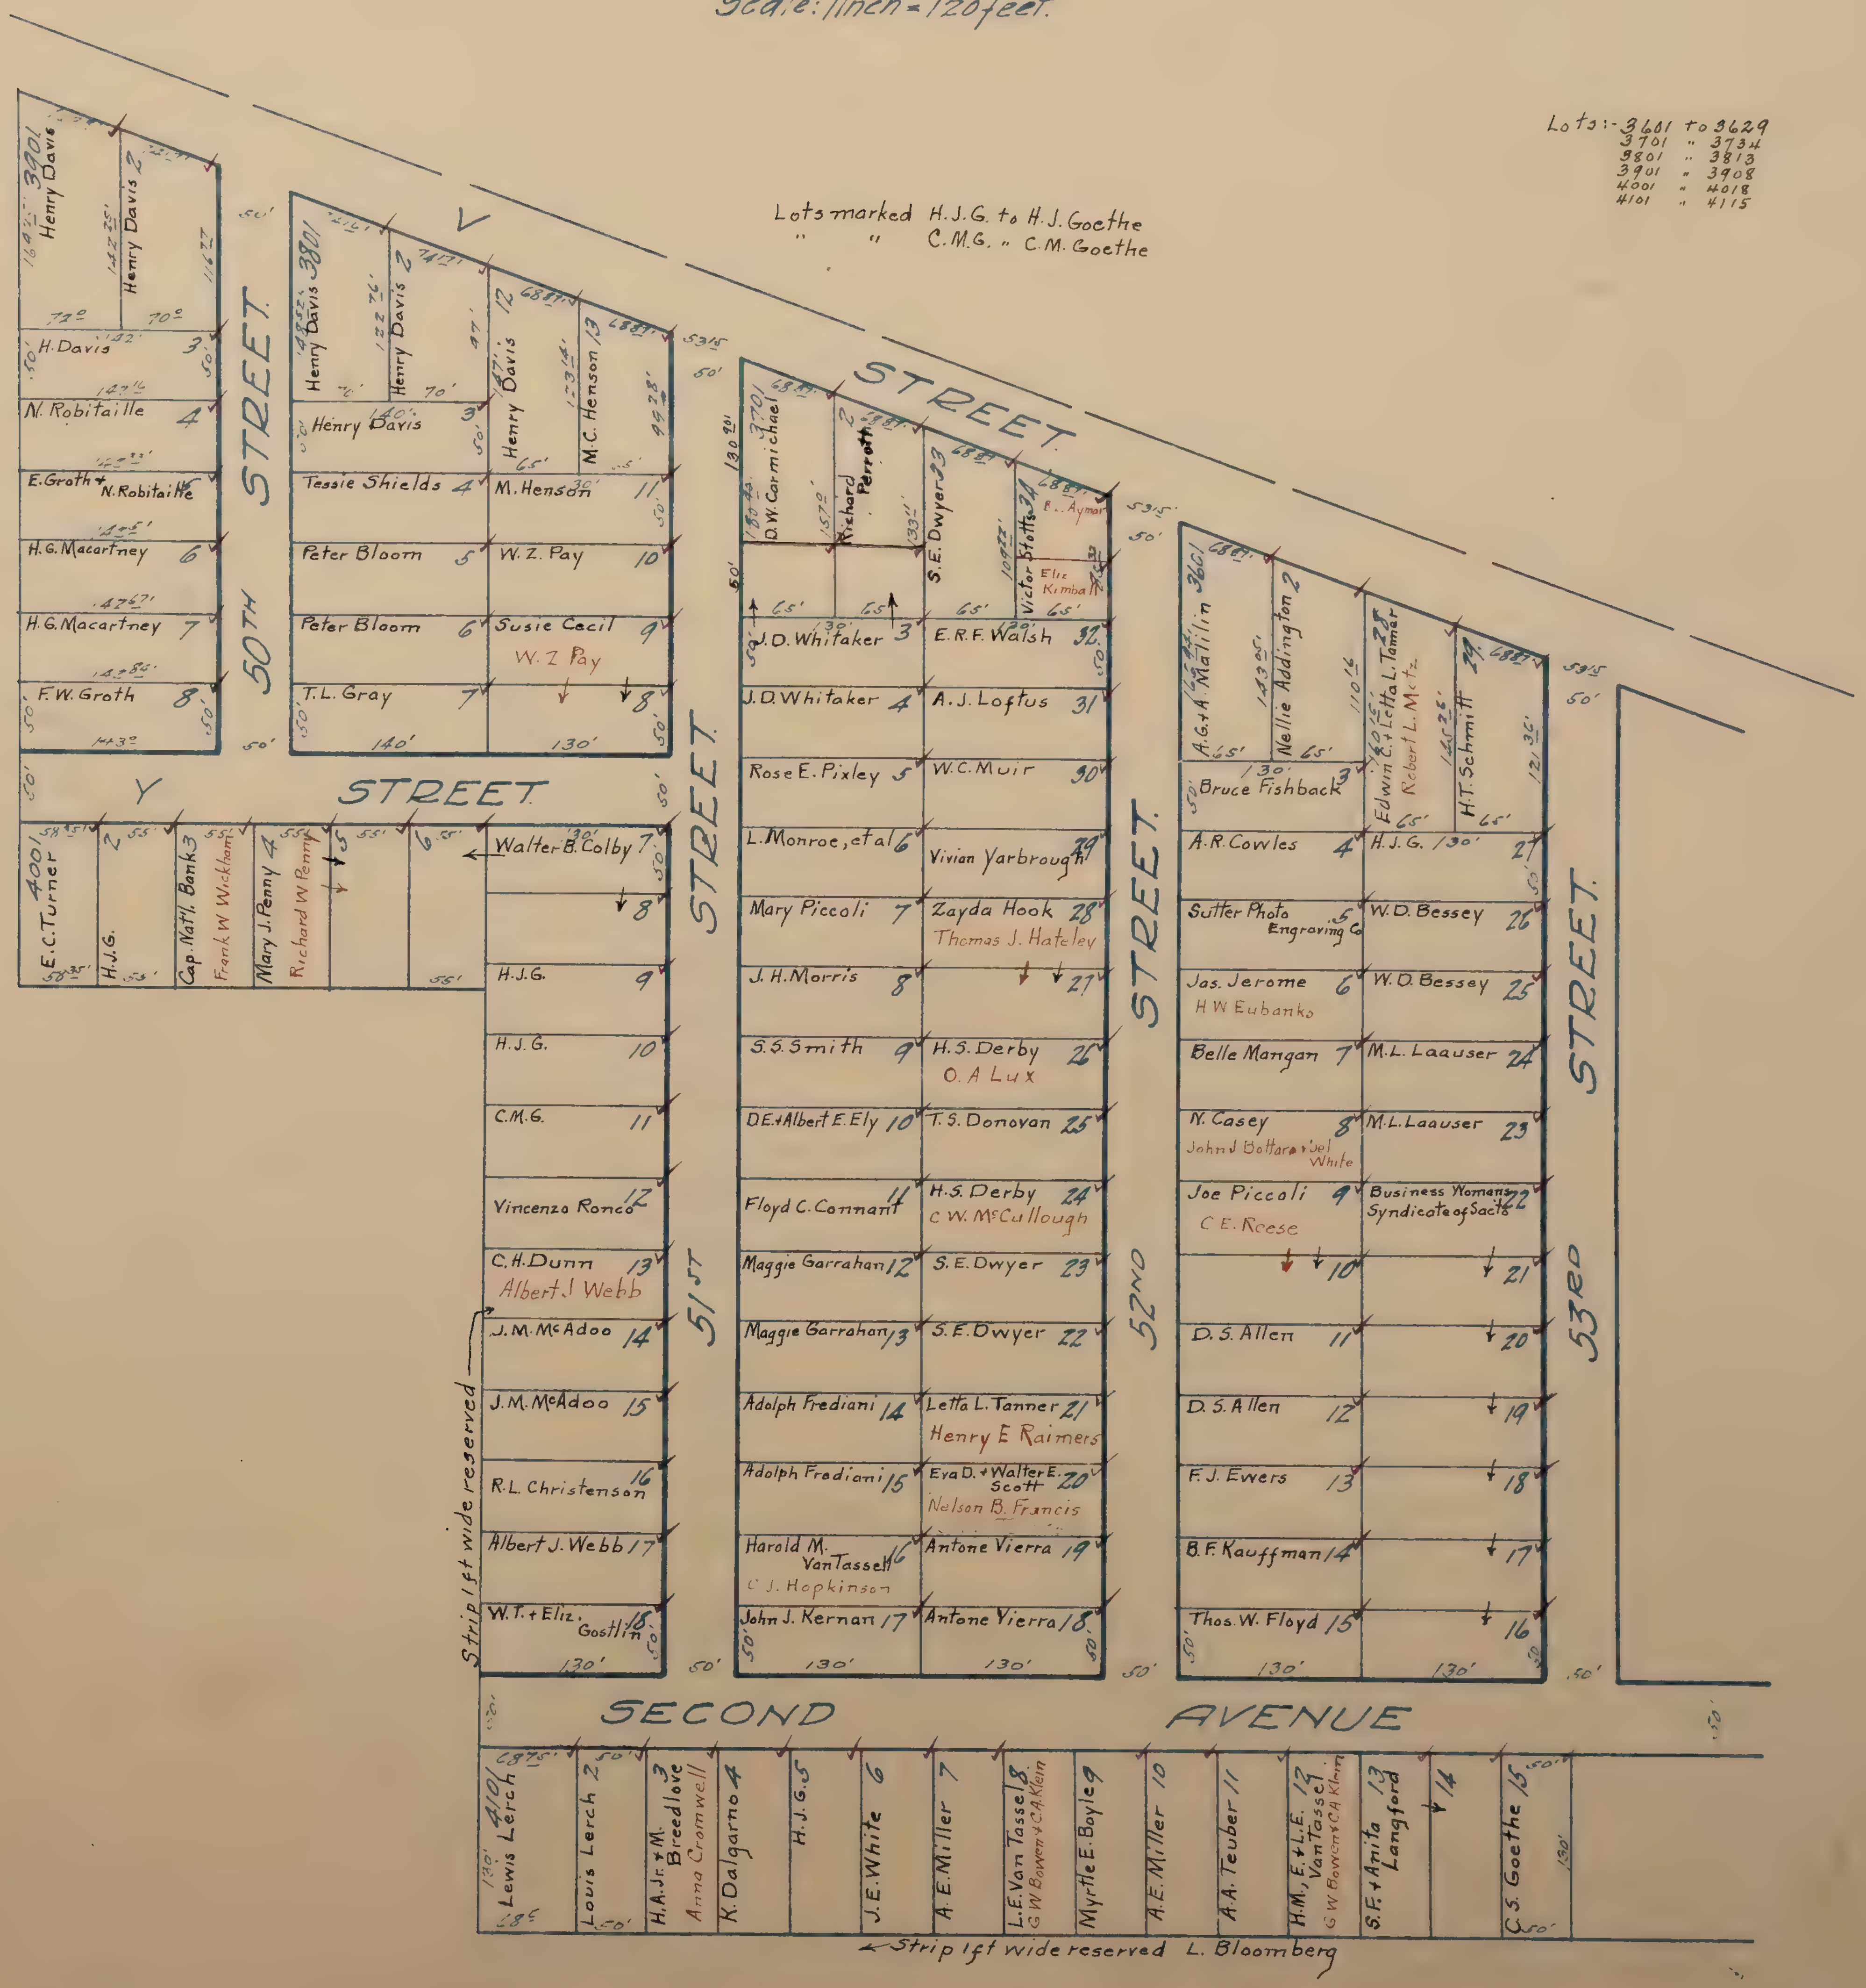
Lots marked H.J.G. to H.J. Goethe
" " C.M.G. " C.M. Goethe

Lots:- 3601 to 3629
3701 " 3734
3801 " 3813
3901 " 3908
4001 " 4018
4101 " 4115

V STREET.
50TH STREET.
51ST STREET.
52ND STREET.
53RD STREET.
Y STREET.
SECOND AVENUE
3901 Henry Davis
Henry Davis 2
H. Davis 3
N. Robitaille 4
E. Groth + N. Robitaille 5
H.G. Macartney 6
H.G. Macartney 7
F.W. Groth 8
3801 Henry Davis
Henry Davis 2
Henry Davis 3
Tessie Shields 4
Peter Bloom 5
Peter Bloom 6
T.L. Gray 7
8
W.Z. Pay
Susie Cecil 9
W.Z. Pay 10
M. Henson 11
Henry Davis 12
M.C. Henson 13
4001 E.C. Turner
H.J.G. 2
Cap. Nat'l. Bank 3
Frank W Wickham
Mary J. Penny 4
Richard W Penny
5
6
Walter B. Colby 7
8
H.J.G. 9
H.J.G. 10
C.M.G. 11
Vincenzo Ronco 12
C.H. Dunn 13
Albert J Webb
J.M. McAdoo 14
J.M. McAdoo 15
R.L. Christenson 16
Albert J. Webb 17
W.T. + Eliz. Gostlin 18
Strip 1ft wide reserved
3701 D.W. Carmichael
Richard Perrott 2
J.D. Whitaker 3
J.D. Whitaker 4
Rose E. Pixley 5
L. Monroe, et al 6
Mary Piccoli 7
J.H. Morris 8
S.S. Smith 9
D.E. + Albert E. Ely 10
Floyd C. Connant 11
Maggie Garrahan 12
Maggie Garrahan 13
Adolph Frediani 14
Adolph Frediani 15
Harold M. VanTassell 16
C.J. Hopkinson
John J. Kernan 17
Antone Vierra 18
Antone Vierra 19
Eva D. + Walter E. Scott 20
Nelson B. Francis
Letta L. Tanner 21
Henry E Raimers
S.E. Dwyer 22
S.E. Dwyer 23
H.S. Derby 24
C.W. McCullough
T.S. Donovan 25
H.S. Derby 26
O.A Lux
27
Zayda Hook 28
Thomas J. Hateley
Vivian Yarbrough 29
W.C. Muir 30
A.J. Loftus 31
E.R.F. Walsh 32
S.E. Dwyer 33
Victor Stotts 34
B. Aymar
Eliz Kimball
3601 A.G. + A. Malilin
Nellie Addington 2
Bruce Fishback 3
A.R. Cowles 4
Sutter Photo Engraving Co 5
Jas. Jerome 6
H W Eubanks
Belle Mangan 7
N. Casey 8
John J Bottara + Del White
Joe Piccoli 9
C E. Reese
10
D.S. Allen 11
D.S. Allen 12
F.J. Ewers 13
B.F. Kauffman 14
Thos. W. Floyd 15
16
17
18
19
20
21
Business Womans Syndicate of Sacto 22
M.L. Laauser 23
M.L. Laauser 24
W.D. Bessey 25
W.D. Bessey 26
H.J.G. 27
Edwin C. + Letta L. Tanner 28
Robert L. Metz
H.T. Schmitt 29
4101 Lewis Lerch
Louis Lerch 2
H.A. Jr. + M. Breedlove 3
Anna Cromwell
K. Dalgarno 4
H.J.G. 5
J.E. White 6
A.E. Miller 7
L.E. Van Tassel 8
G.W. Bowen + C.A. Klein
Myrtle E. Boyle 9
A.E. Miller 10
A.A. Teuber 11
H.M., E. + L.E. VanTassel 12
G.W. Bowen + C.A. Klein
S.F. + Anita Langford 13
14
C.S. Goethe 15
Strip 1ft wide reserved L. Bloomberg
50'
130'
65'

6

ELMHURST ✓

Scale: 1 Inch = 120 feet.

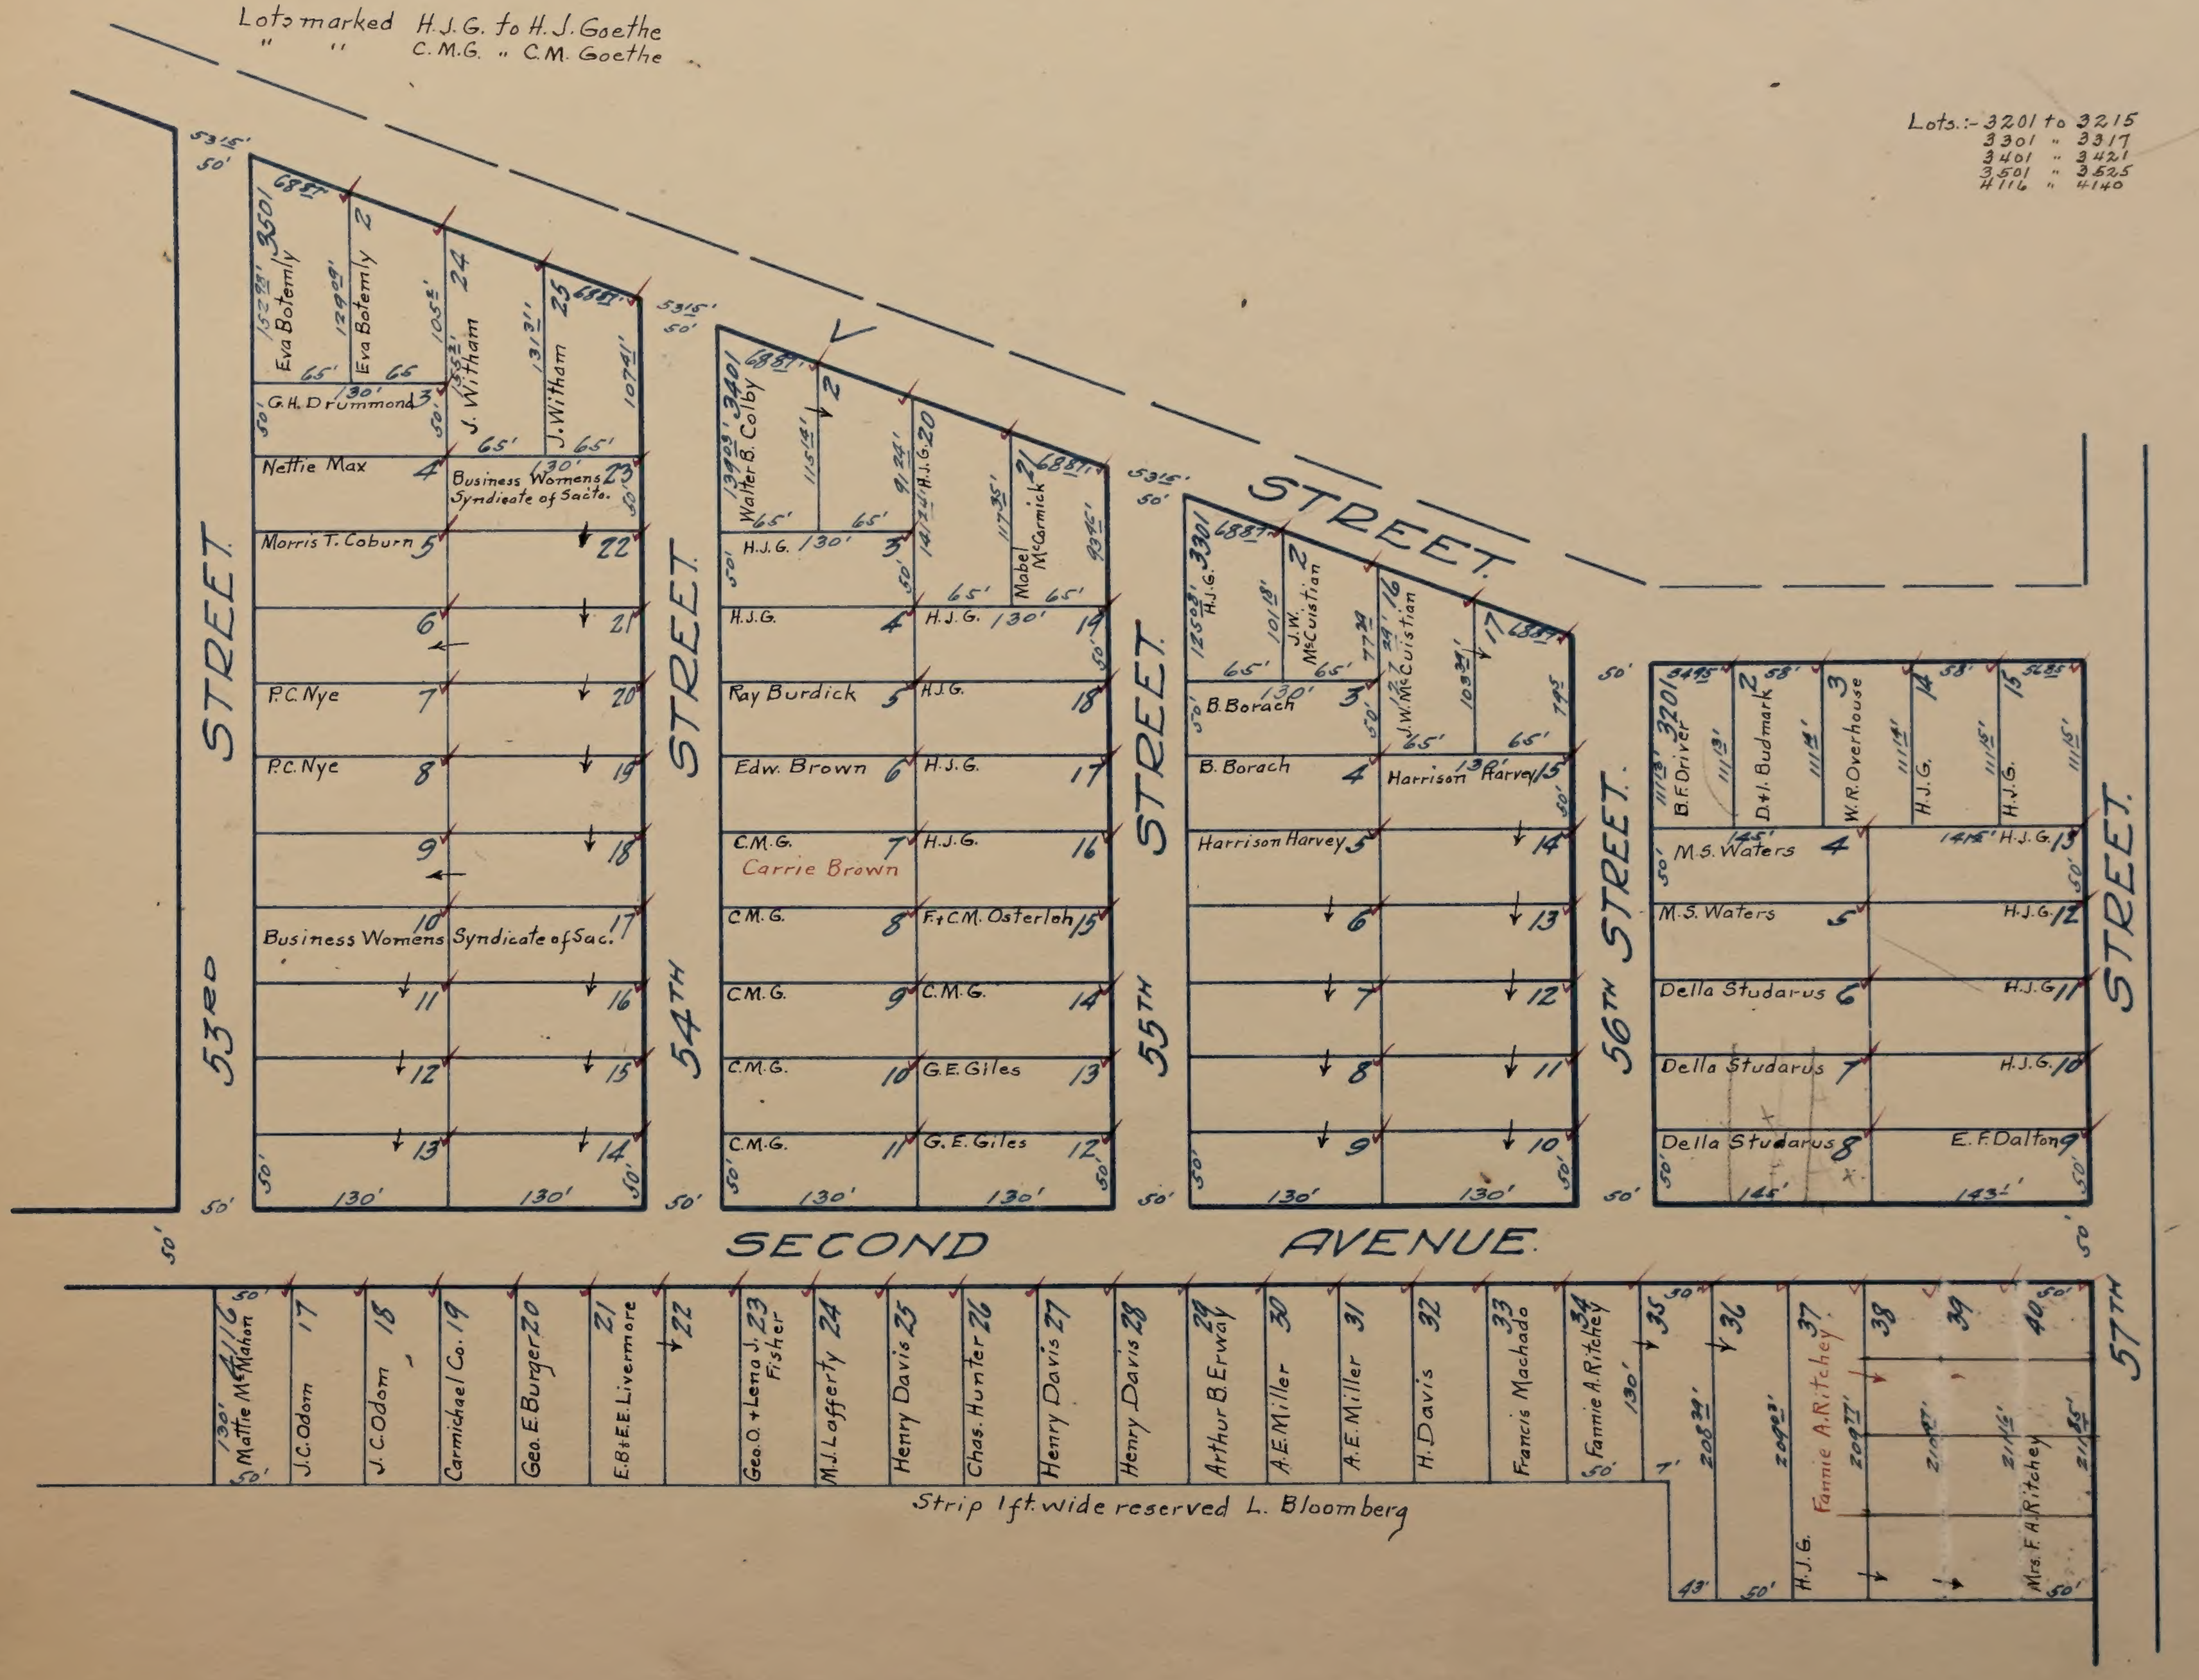

Lots marked H.J.G. to H.J. Goethe
" " C.M.G. " C.M. Goethe

Lots:- 3201 to 3215
3301 " 3317
3401 " 3421
3501 " 3525
4116 " 4140

53RD STREET
54TH STREET
55TH STREET
56TH STREET
57TH STREET
STREET
SECOND AVENUE
3501
Eva Botemly
Eva Botemly 2
J. Witham 24
J. Witham 25
G.H. Drummond 3
Nettie Max 4
Business Womens Syndicate of Sacto. 23
Morris T. Coburn 5
22
6
21
P.C. Nye 7
20
P.C. Nye 8
19
9
18
10
Business Womens Syndicate of Sac. 17
11
16
12
15
13
14
3401
Walter B. Colby
H.J.G. 20
Mabel McCarmick 21
H.J.G. 3
H.J.G. 4
H.J.G. 19
Ray Burdick 5
H.J.G. 18
Edw. Brown 6
H.J.G. 17
C.M.G. 7
Carrie Brown
H.J.G. 16
C.M.G. 8
F. & C.M. Osterloh 15
C.M.G. 9
C.M.G. 14
C.M.G. 10
G.E. Giles 13
C.M.G. 11
G.E. Giles 12
3301
H.J.G.
J.W. McCuistian 2
J.W. McCuistian 16
17
B. Borach 3
B. Borach 4
Harrison Harvey 15
Harrison Harvey 5
14
6
13
7
12
8
11
9
10
3201
B.F. Driver
D. & I. Budmark 2
W.R. Overhouse 3
H.J.G. 14
H.J.G. 15
M.S. Waters 4
H.J.G. 13
M.S. Waters 5
H.J.G. 12
Della Studarus 6
H.J.G. 11
Della Studarus 7
H.J.G. 10
Della Studarus 8
E.F. Dalton 9
4116 Mattie McMahon
J.C. Odom 17
J.C. Odom 18
Carmichael Co. 19
Geo. E. Burger 20
E.B. & E.E. Livermore 21
22
Geo. O. & Lena J. Fisher 23
M.J. Lafferty 24
Henry Davis 25
Chas. Hunter 26
Henry Davis 27
Henry Davis 28
Arthur B. Erway 29
A.E. Miller 30
A.E. Miller 31
H. Davis 32
Francis Machado 33
Fannie A. Ritchey 34
35
36
H.J.G.
37
Fannie A. Ritchey
38
39
40
Mrs. F.A. Ritchey
Strip 1 ft. wide reserved L. Bloomberg
130'
50'
65'

5380
1760